


| FED. ROAD REG. NO. | STATE | FEDERAL AID PROJECT NO. | SHEET NO. | TOTAL SHEETS |
|--------------------|-------|-------------------------|-----------|--------------|
| 1 | N.Y. | | 1R | 15 |

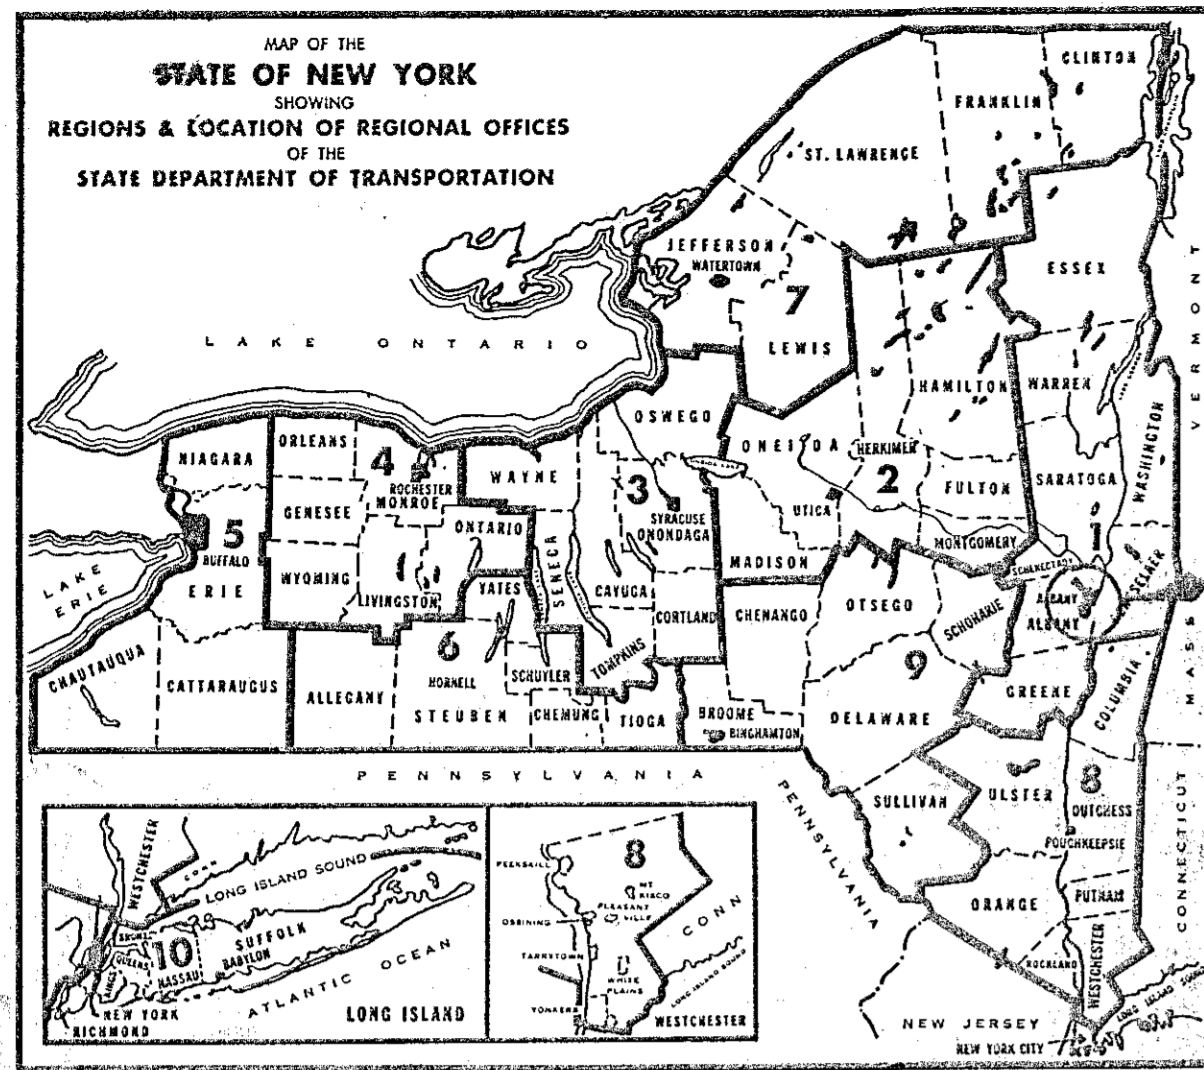

STATE OF NEW YORK
DEPARTMENT OF TRANSPORTATION
DESIGN AND CONSTRUCTION DIVISION

PLANS FOR RECONSTRUCTING A PORTION OF THE
DELAWARE, PART 2
State Highway No. 41

Between Station 101+30 and Station 121+89, a length of 0.39 mile in the Town of Bethlehem
15 SHEETS
ALBANY COUNTY
CONTRACT No. RCR 75-82

TYPE OF CONSTRUCTION
Drainage and Asphalt Concrete Resurfacing

STANDARD SHEETS
203-2, 203-4R1, 203-5R1 607-2, 609-1, 619-2, 625-1, 655-3, 655-7

All work contemplated under this contract to be covered by and in conformity with the specifications of January 2, 1973, as amended by Addenda Nos. 1 and 2, except as modified on these plans and in the itemized Proposal.

RECORD PLANS

CONTRACT NO. RCR 75-82
CONTRACTORS NAME CALLANAN, Inc. Inc.
DATE OF CONTRACT July 10, 1975
AWARD DATE August 1st 1975
COMPLETION DATE January 30th 1976
FINAL ACCEPTANCE November 25th 1975
DISTRICT ENGINEER C.E. Carlson
ENGINEER IN CHARGE Anthony N. Galea
SIGNATURE Anthony N. Galea
CONTRACT COST \$ 289,240.18
FISCAL SHARE COSTS

LOCATION OF CONTRACT


THIS CONTRACT BEGINS ON ROUTE 443, 150' WEST OF KENWARE AVENUE AND EXTENDS 0.39 MILES EASTERLY ALONG ROUTE 443, TERMINATING 100' EAST OF ROWELAND AVENUE IN THE TOWN OF BETHLEHEM.

NOTE: THE CONTRACTOR WILL BE REQUIRED TO FURNISH WATCHMAN SERVICE UNDER ITEM 15619.12 IN ACCORDANCE WITH REQUIREMENT C OF THE STANDARD SPECIFICATIONS.

NOTE: THE CONTRACTOR'S ATTENTION IS DIRECTED TO THE FACT THAT THIS HIGHWAY WILL BE DESIGNATED AS A RESTRICTED HIGHWAY UNDER THIS CONTRACT.

INDEX ON SHEET 3

TOWN OF BETHLEHEM

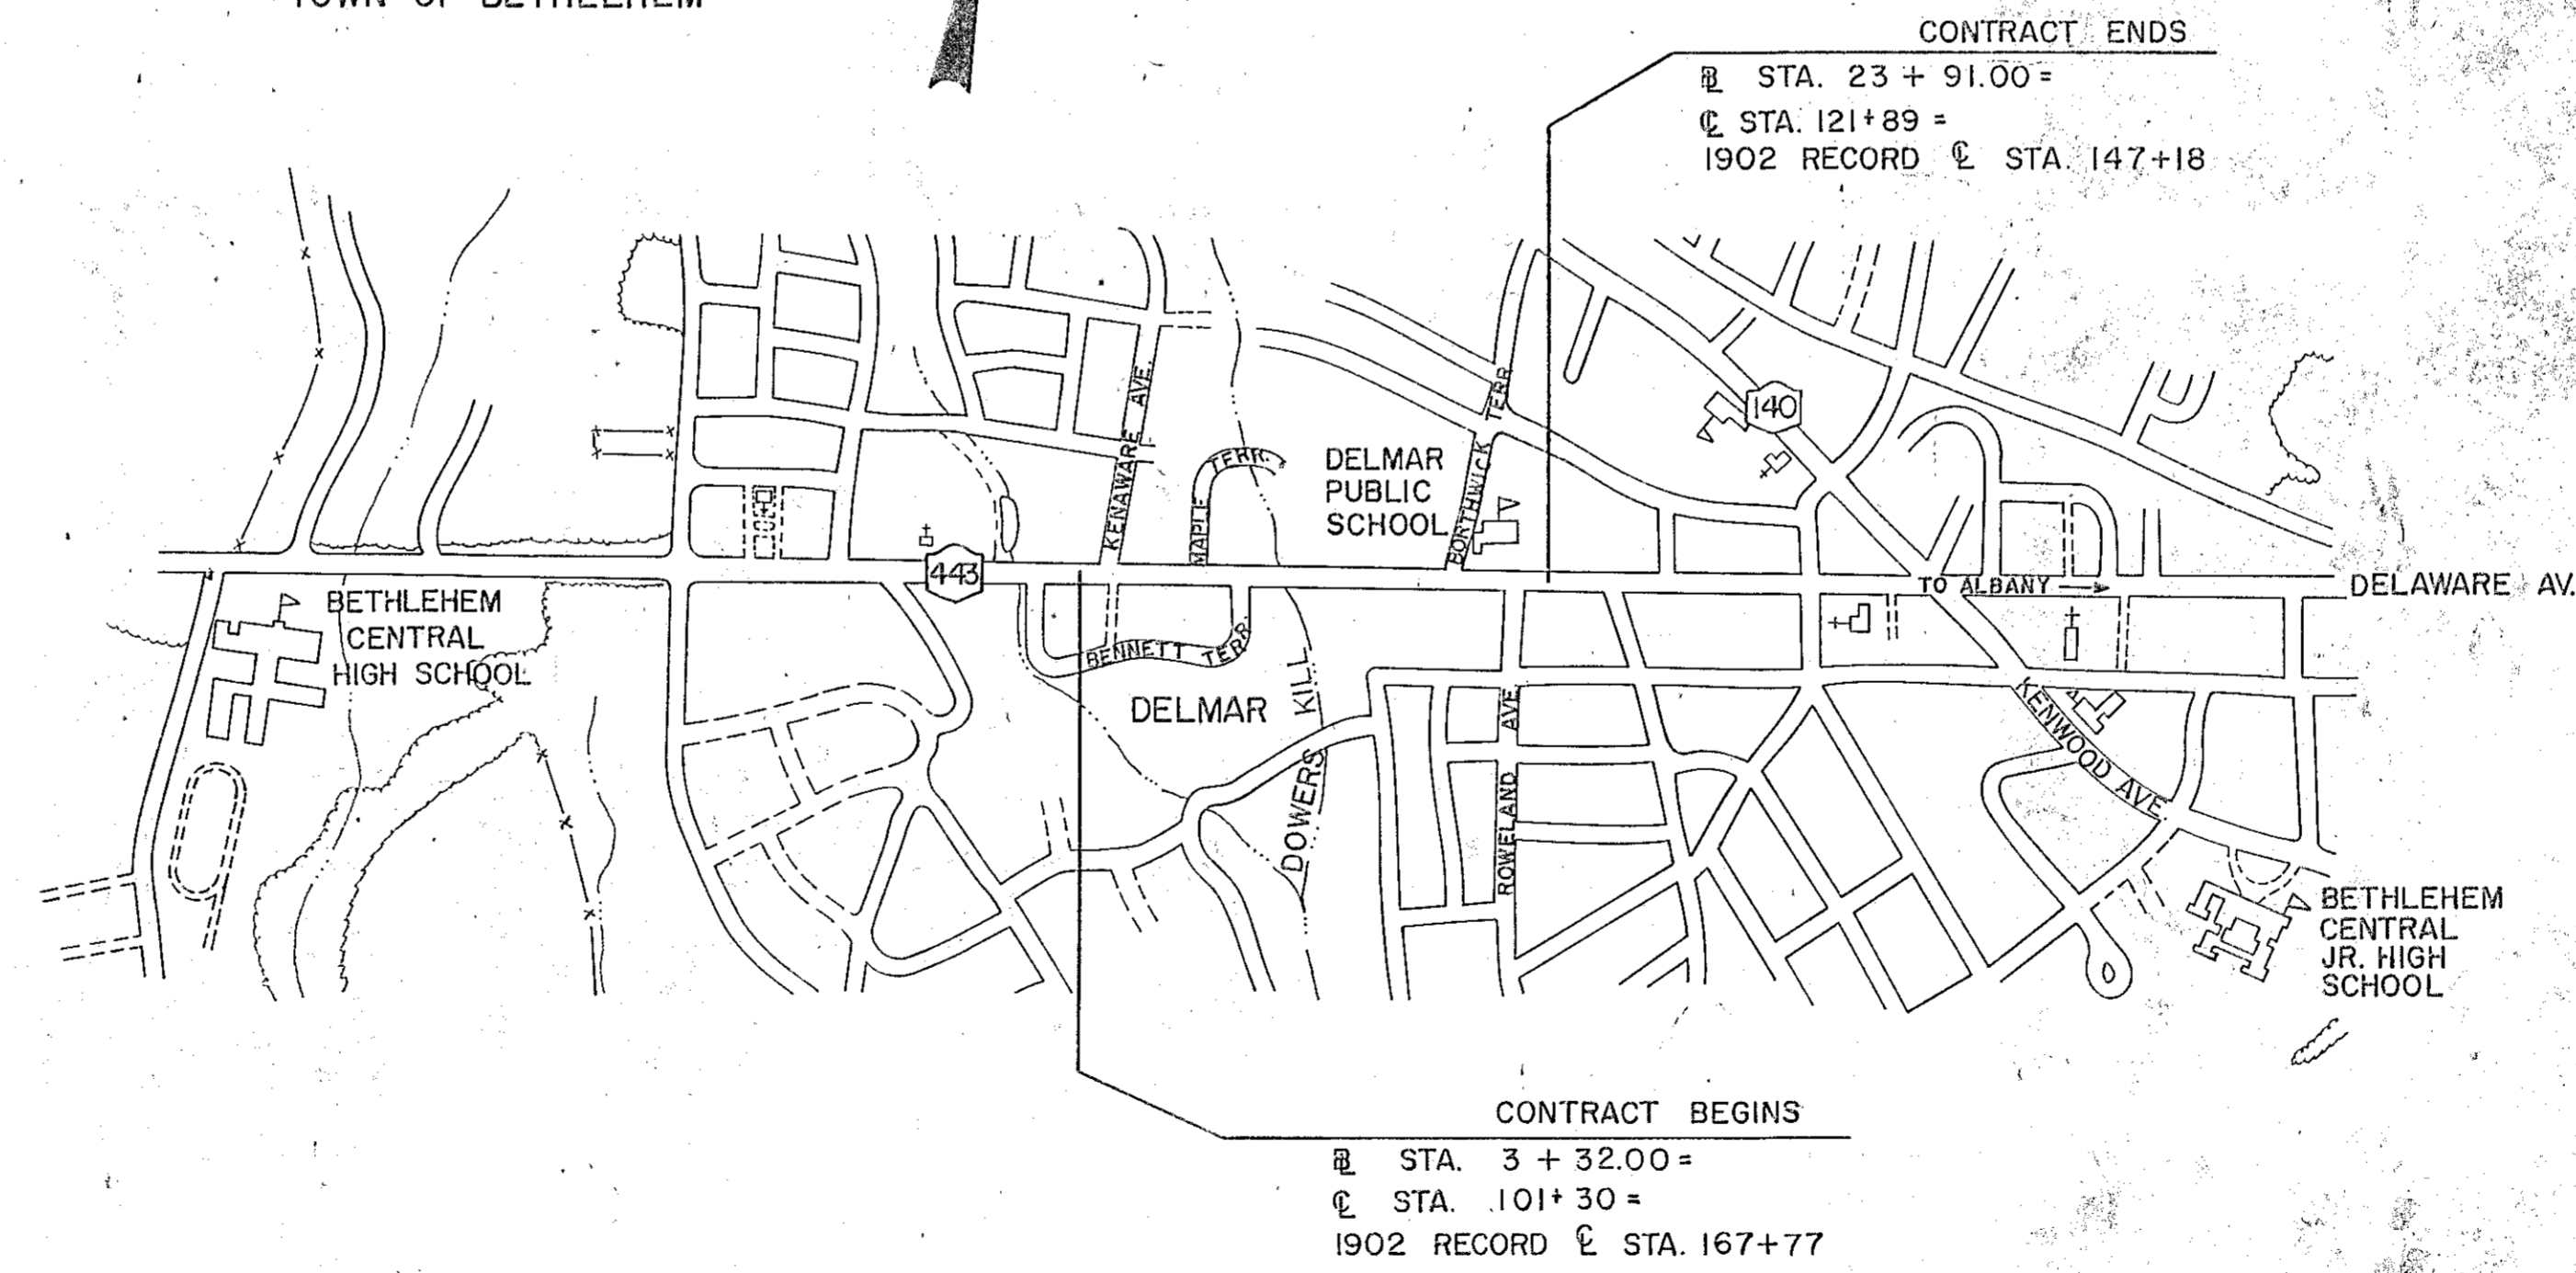

LOCATION PLAN

SCALE 1" = 800'

TOWN OF BETHLEHEM, NEW YORK
DEPARTMENT OF PUBLIC WORKS
- OFFICE COPY -
0 1 2 INCHES

NEW YORK STATE DEPARTMENT OF TRANSPORTATION

Approved: Malcolm D. Graham 1975
JACK STERNBACH Deputy Chief Engineer (Construction)

Approved: Roger H. Edwards 1975
ROGER H. EDWARDS Deputy Chief Engineer (Facilities Design)

Approved: Malcolm D. Graham May 13 1975
MALCOLM D. GRAHAM Chief Engineer

DELAWARE PT. 2, S.H. 41
ALBANY COUNTY

DESIGNED BY Ray D. Callahan CHECKED BY Samuel P. Kelly DATED 3-27-75 REVIEWED BY J. J. Metcher DATED 4/8/75

RECOMMENDED BY R. A. Deane 4/9/75 REGIONAL DESIGN ENGINEER DATE
RECOMMENDED BY K. P. Stewart 4/10/75 REGIONAL CONSTRUCTION ENGINEER DATE
RECOMMENDED BY James P. Thomas 4-10-75 REGIONAL HIGHWAY MAINTENANCE ENGINEER DATE
RECOMMENDED BY L. W. Kelly 4/9/75 REGIONAL TRAFFIC ENGINEER DATE
RECOMMENDED BY R. H. Edwards 4/13/75 REGIONAL DIRECTOR DATE