


MATCH LINE SEE SHEET C4


MATCH LINE SEE SHEET C4

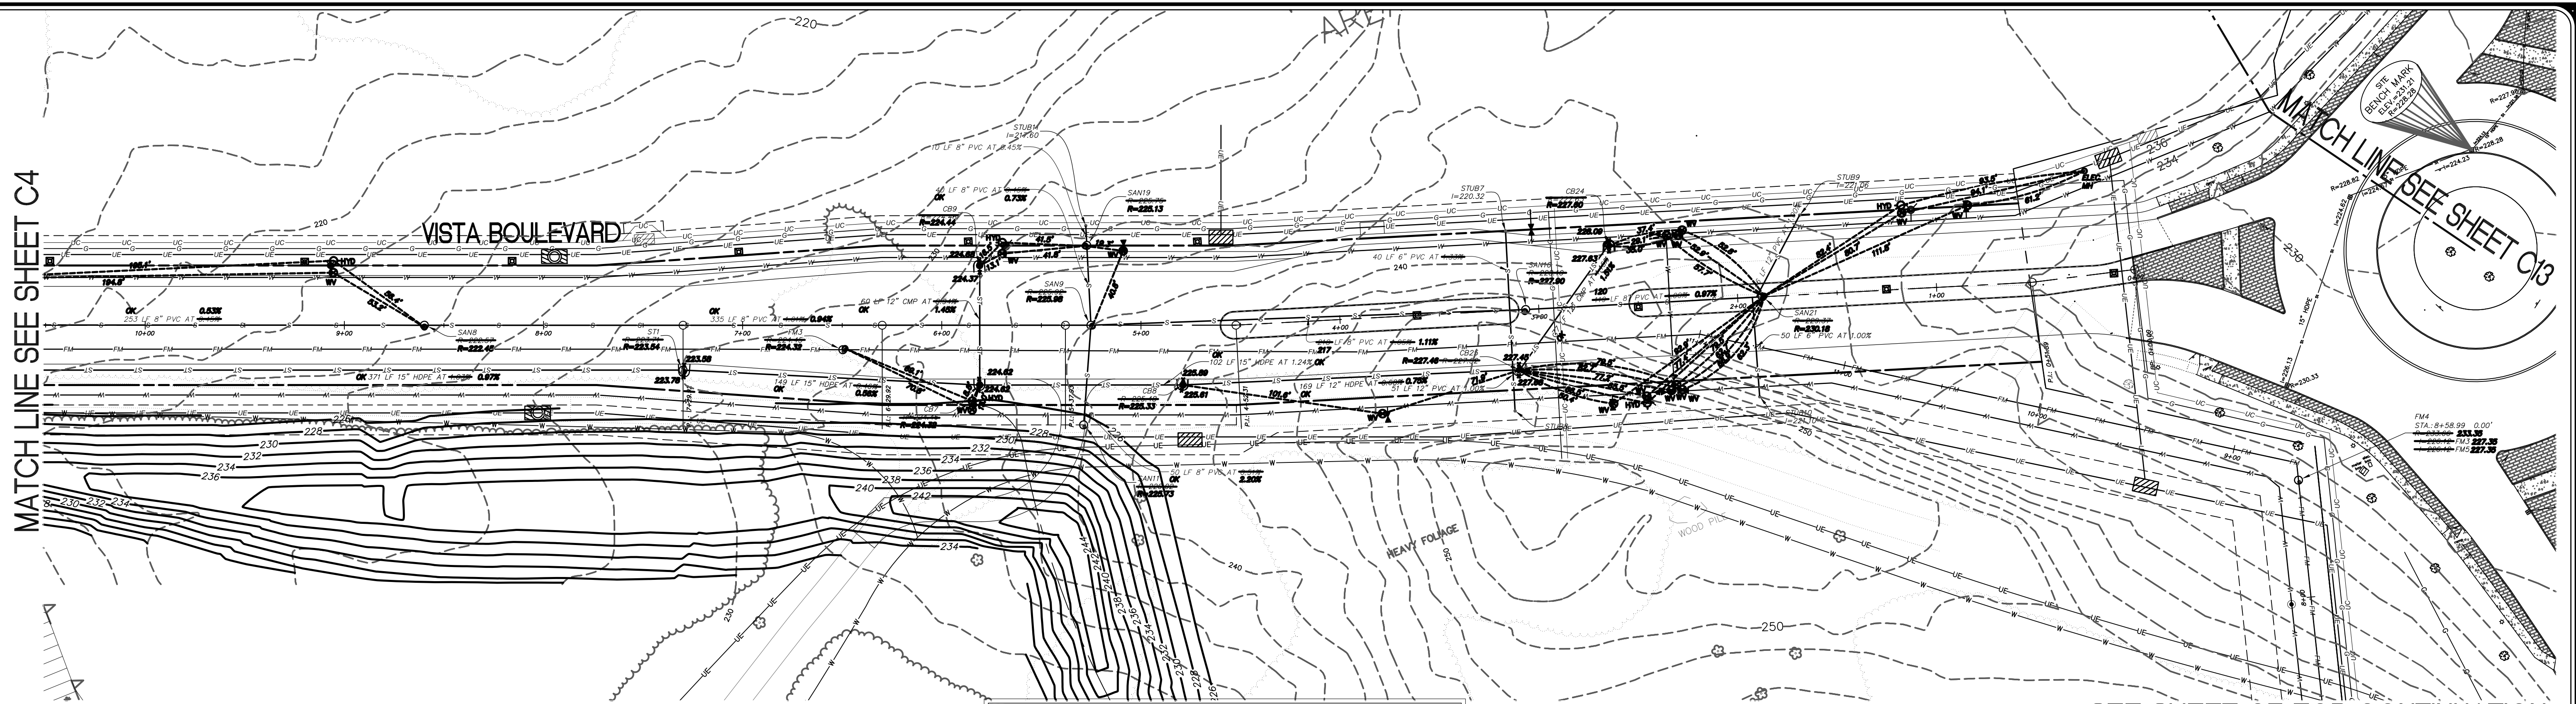

VISTA BOULEVARD PLAN

NOTE: ASPHALT SPOT ELEVATIONS SHOWN HEREON ARE TOP OF ASPHALT BINDER ELEVATION.

SEE SHEET C7 FOR CONTINUATION

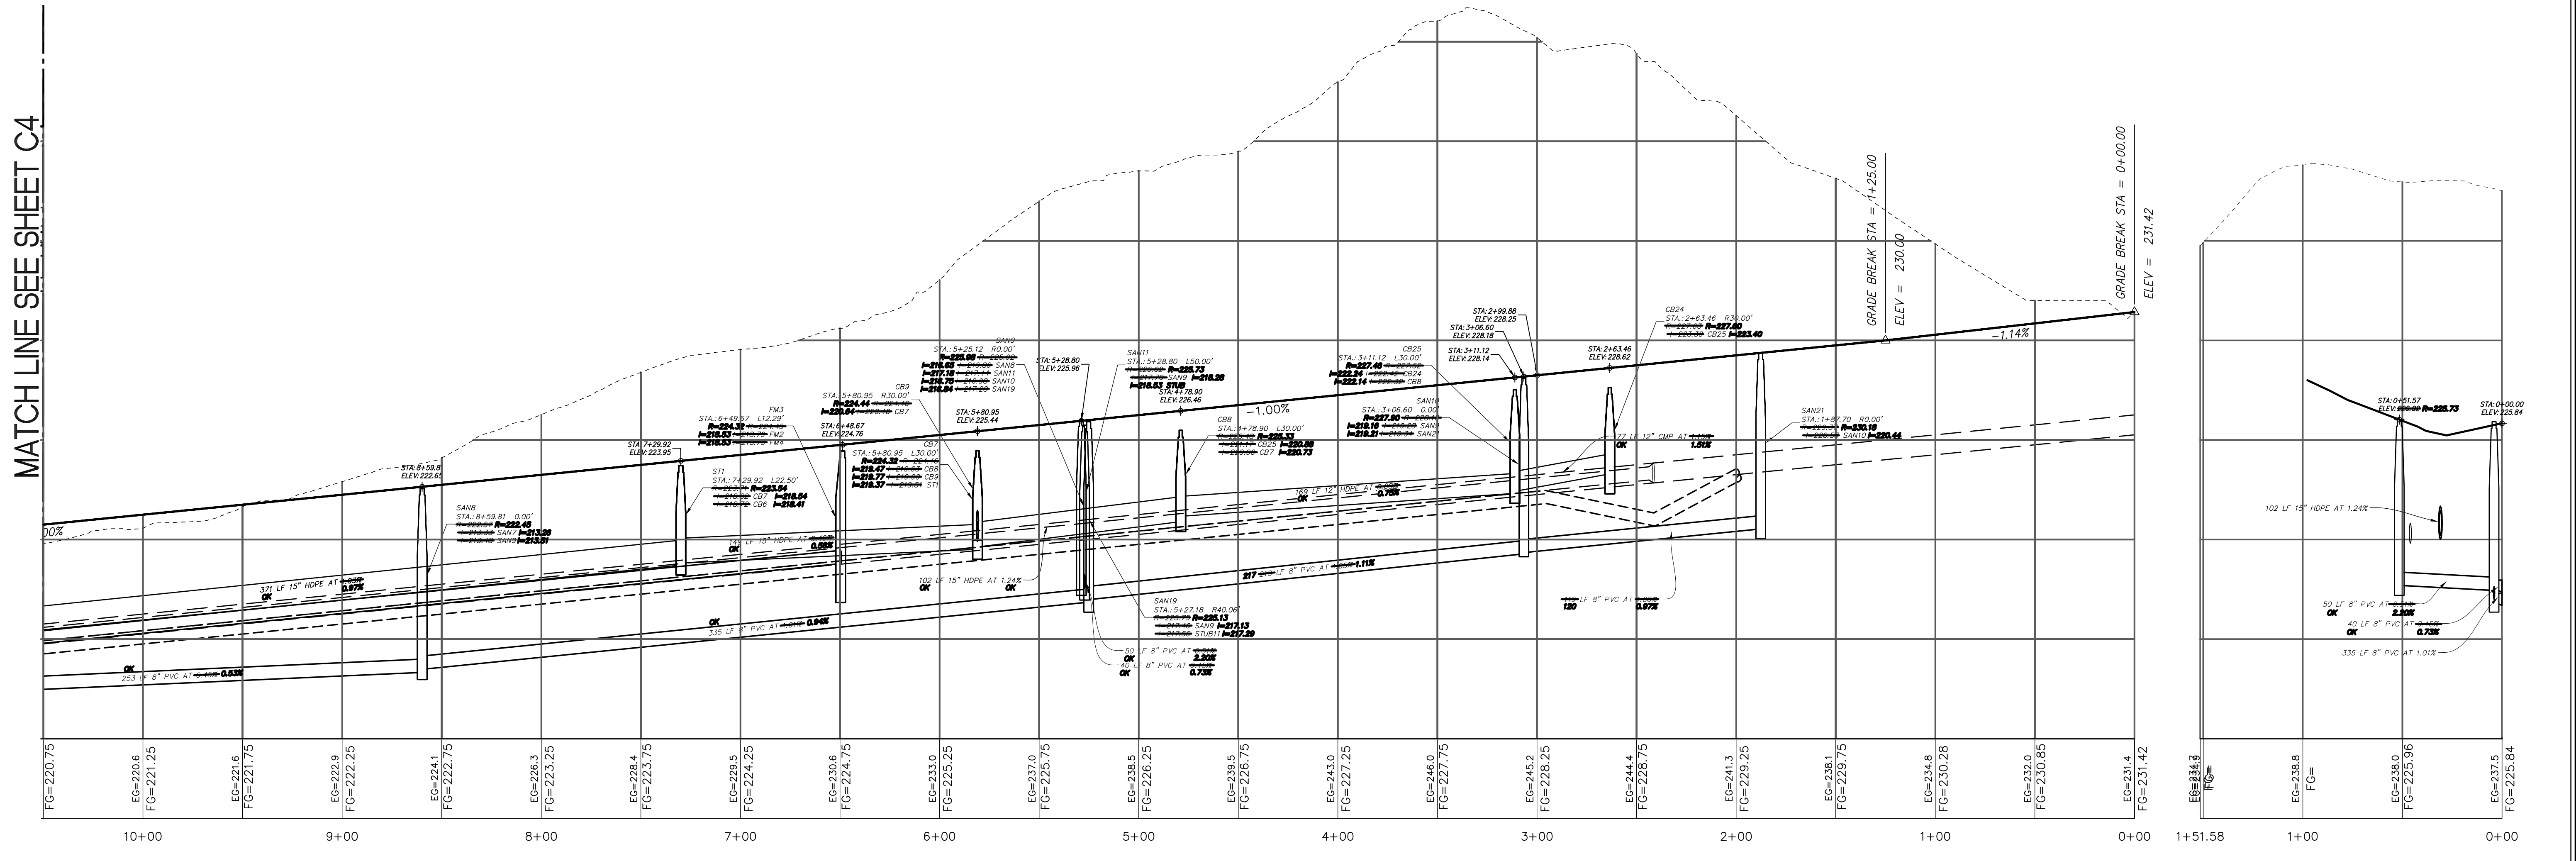

VISTA BOULEVARD PROFILE

SEWER TO JONES HOUSE PROFILE

SANITARY SEWER, STORM SEWER AND HYDRANT & WATER VALVE TIE RECORD PLAN (LAST REVISED 11-7-12)

NOTE: RECORD INFORMATION SHOWN HEREON OBTAINED BY INGALLS & ASSOCIATES LLP FROM A FIELD SURVEY CONDUCTED AUGUST 8, 2012 THROUGH AUGUST 13, AND REFLECTS CONDITIONS EXISTING AT THOSE OCCASIONS.

HERSHBERG & HERSHBERG
Consulting Engineers and Land Surveyors
18 Locust Street
Albany, New York 12203

ALTERATION OF THIS DOCUMENT EXCEPT BY A LICENSED PROFESSIONAL ENGINEER OR LAND SURVEYOR, IS ILLEGAL.

REVISIONS	DATE	REMARKS
1	11/1/11	ELECTRIC SWITCH GEARS
2	12/8/11	ELECTRIC SWITCH GEARS
3	4/12/12	COMMUNICATIONS
4	4/17/12	ELECTRIC SWITCH GEAR STA 5+00
5	5/10/12	ELECTRIC SWITCH GEAR STA 4+60
6	5/16/12	MEDIAN FROM PHASE 1B

PUBLIC INFRASTRUCTURE CONSTRUCTION
VISTA TECHNOLOGY CAMPUS
TOWN OF BETHLEHEM
ALBANY COUNTY, STATE OF NEW YORK

SCALE: H1=40' H1=C' (BY: WM)
DATE: 2/18/11
CHK: DRH
FILE: 110027
110027-1.dwg

