


PROFILE - SANDY LANE
 SCALE: HORIZONTAL - 1" = 50'
 VERTICAL - 1" = 5'

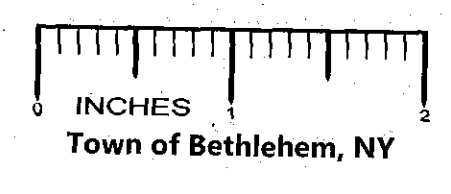

NO.	DATE	REVISIONS	BY
1	1/11/08	MISC REVISIONS AND PROFILE FOR F-3 ADDED	RDG

UNAUTHORIZED ALTERATION OR ADDITION TO THIS DRAWING IS A VIOLATION OF SECTION 7209 SUBDIVISION 2, OF THE NEW YORK STATE EDUCATION LAW. ONLY COPIES MADE FROM THE ORIGINAL OF THIS DRAWING BEARING AN ORIGINAL INKED OR EMBOSSED SEAL AND SIGNATURE SHALL BE CONSIDERED TO BE VALID TRUE COPIES.

GERALD R. GRAY, L.S.
 N.Y.S. LIC. NO. 050513

ingalls & associates, LLP
 engineers / surveyors
 2603 GUILDFORD AVENUE
 SCHENECTADY, N.Y. 12306
 PHONE: (518) 393-7725
 FAX: (518) 393-3761

RECORD PROFILES
 SANDY LANE - SICILIA STREET
 TRINITY MANOR SUBDIVISION
 TOWN OF BETHELEHEM
 COUNTY OF ALBANY STATE OF NEW YORK
 DRAWN BY: RDG CHECKED BY: CRG
 CADD: 04-016REC JOB NO. 05-099
 DATE: NOVEMBER 21, 2005
 SCALE: 1" = 50'
 SHEET 1 OF 2