


GENERAL PLAN - TROTTER RD.
 CENTERLINE STATIONING 0+00 - 6+20
 SCALE: 1" = 40'

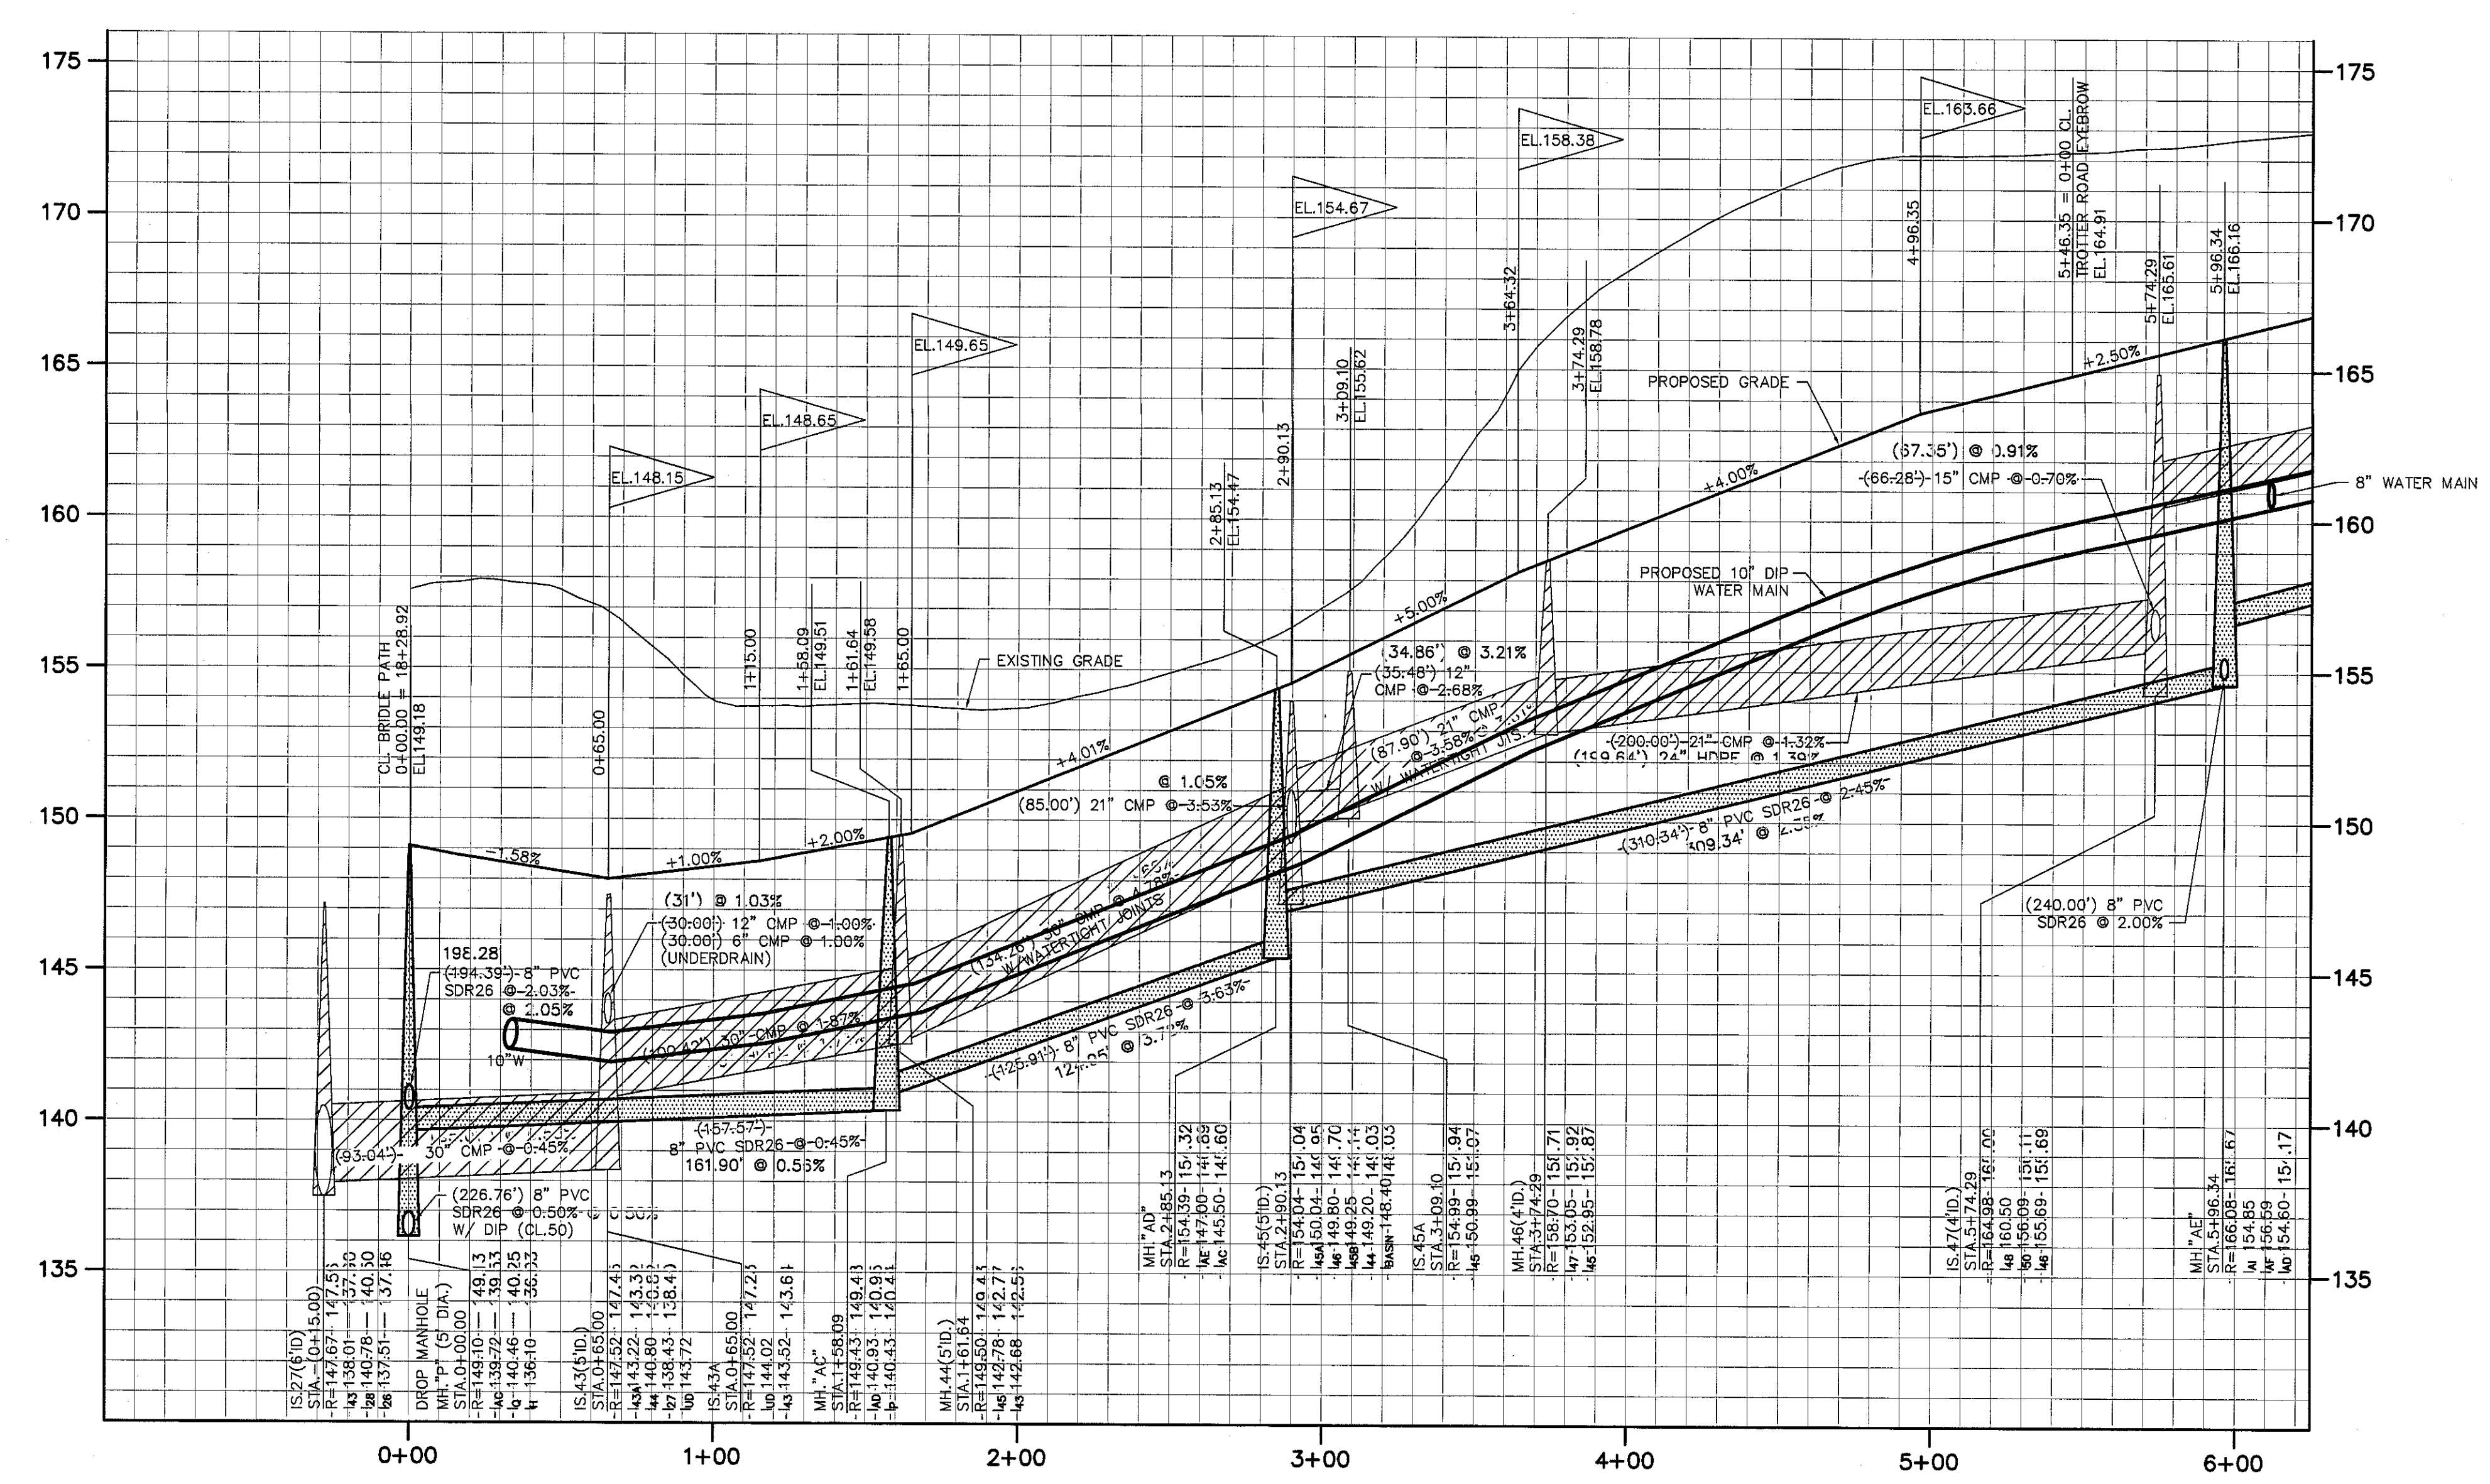

PROFILE - TROTTER RD.
 SCALE: 1" = 4' VERT. \ 1" = 40' HORIZ.

UNAUTHORIZED ALTERATIONS OR ADDITIONS TO THIS DOCUMENT IS A VIOLATION OF SECTION 7209 SUBDIVISION 2 OF THE NEW YORK STATE EDUCATION LAW

REVISIONS			
DATE	BY	DESCRIPTION	SYMBOL
6/99	CHJ	FINAL PLAN REVISIONS	△
10/99	CHJ	FINAL PLAN REVISIONS	△
5/00	CHJ	FINAL PLAN REVISIONS	△
12/00	CHJ	FINAL PLAN REVISIONS	△
1/28/01	CHJ	FINAL PLAN REVISIONS	△
10/04	CHJ	FINAL PLAN REVISIONS	△
5/05	CHJ	LOT LINE CHANGES	△
1/06	CHJ	MISCELLANEOUS REVISIONS	△
3/06	CHJ	MISCELLANEOUS REVISIONS	△
4/06	CHJ	MISCELLANEOUS REVISIONS	△

EDWARD W. BOUTELLE AND SON
 CIVIL ENGINEERS AND SURVEYORS
 423 KENWOOD AVENUE
 DELMAR, NEW YORK
 TEL.(518) 439-9981 FAX.(518) 439-9982
 A DIVISION OF J. KENNETH FRASER AND ASSOCIATES, P.E., L.L.P.C.

FINAL PLAN AMENDED
 CARRIAGE HILL SUBDIVISION
 MAP OF LANDS OF CHARLEW CONSTRUCTION CORP.

TOWN OF BETHELEM COUNTY OF ALBANY
 STATE OF NEW YORK

SCALE: AS NOTED

RECORD DRAWING

ALL INFORMATION SHOWN IN RED ON THESE DRAWINGS REPRESENT RECORD INFORMATION OBTAINED BY THE FIELD CREWS OF C.T. MALE ASSOCIATES, P.C. DURING THE MONTH OF OCTOBER 2008.

PROJ. SURVEYOR: CHJ
 DRAWN BY: TWK
 ASSEMBLED BY: TWK
 CHECKED BY: CHJ

PROJECT NO.: 99-020
 CAD FILE NAME: 4103-018

SHEET TITLE: PLAN & PROFILE
 TROTTER ROAD STA. 0+00 - 6+20
 DATE: NOVEMBER 1995 SHEET 16 OF 31

