

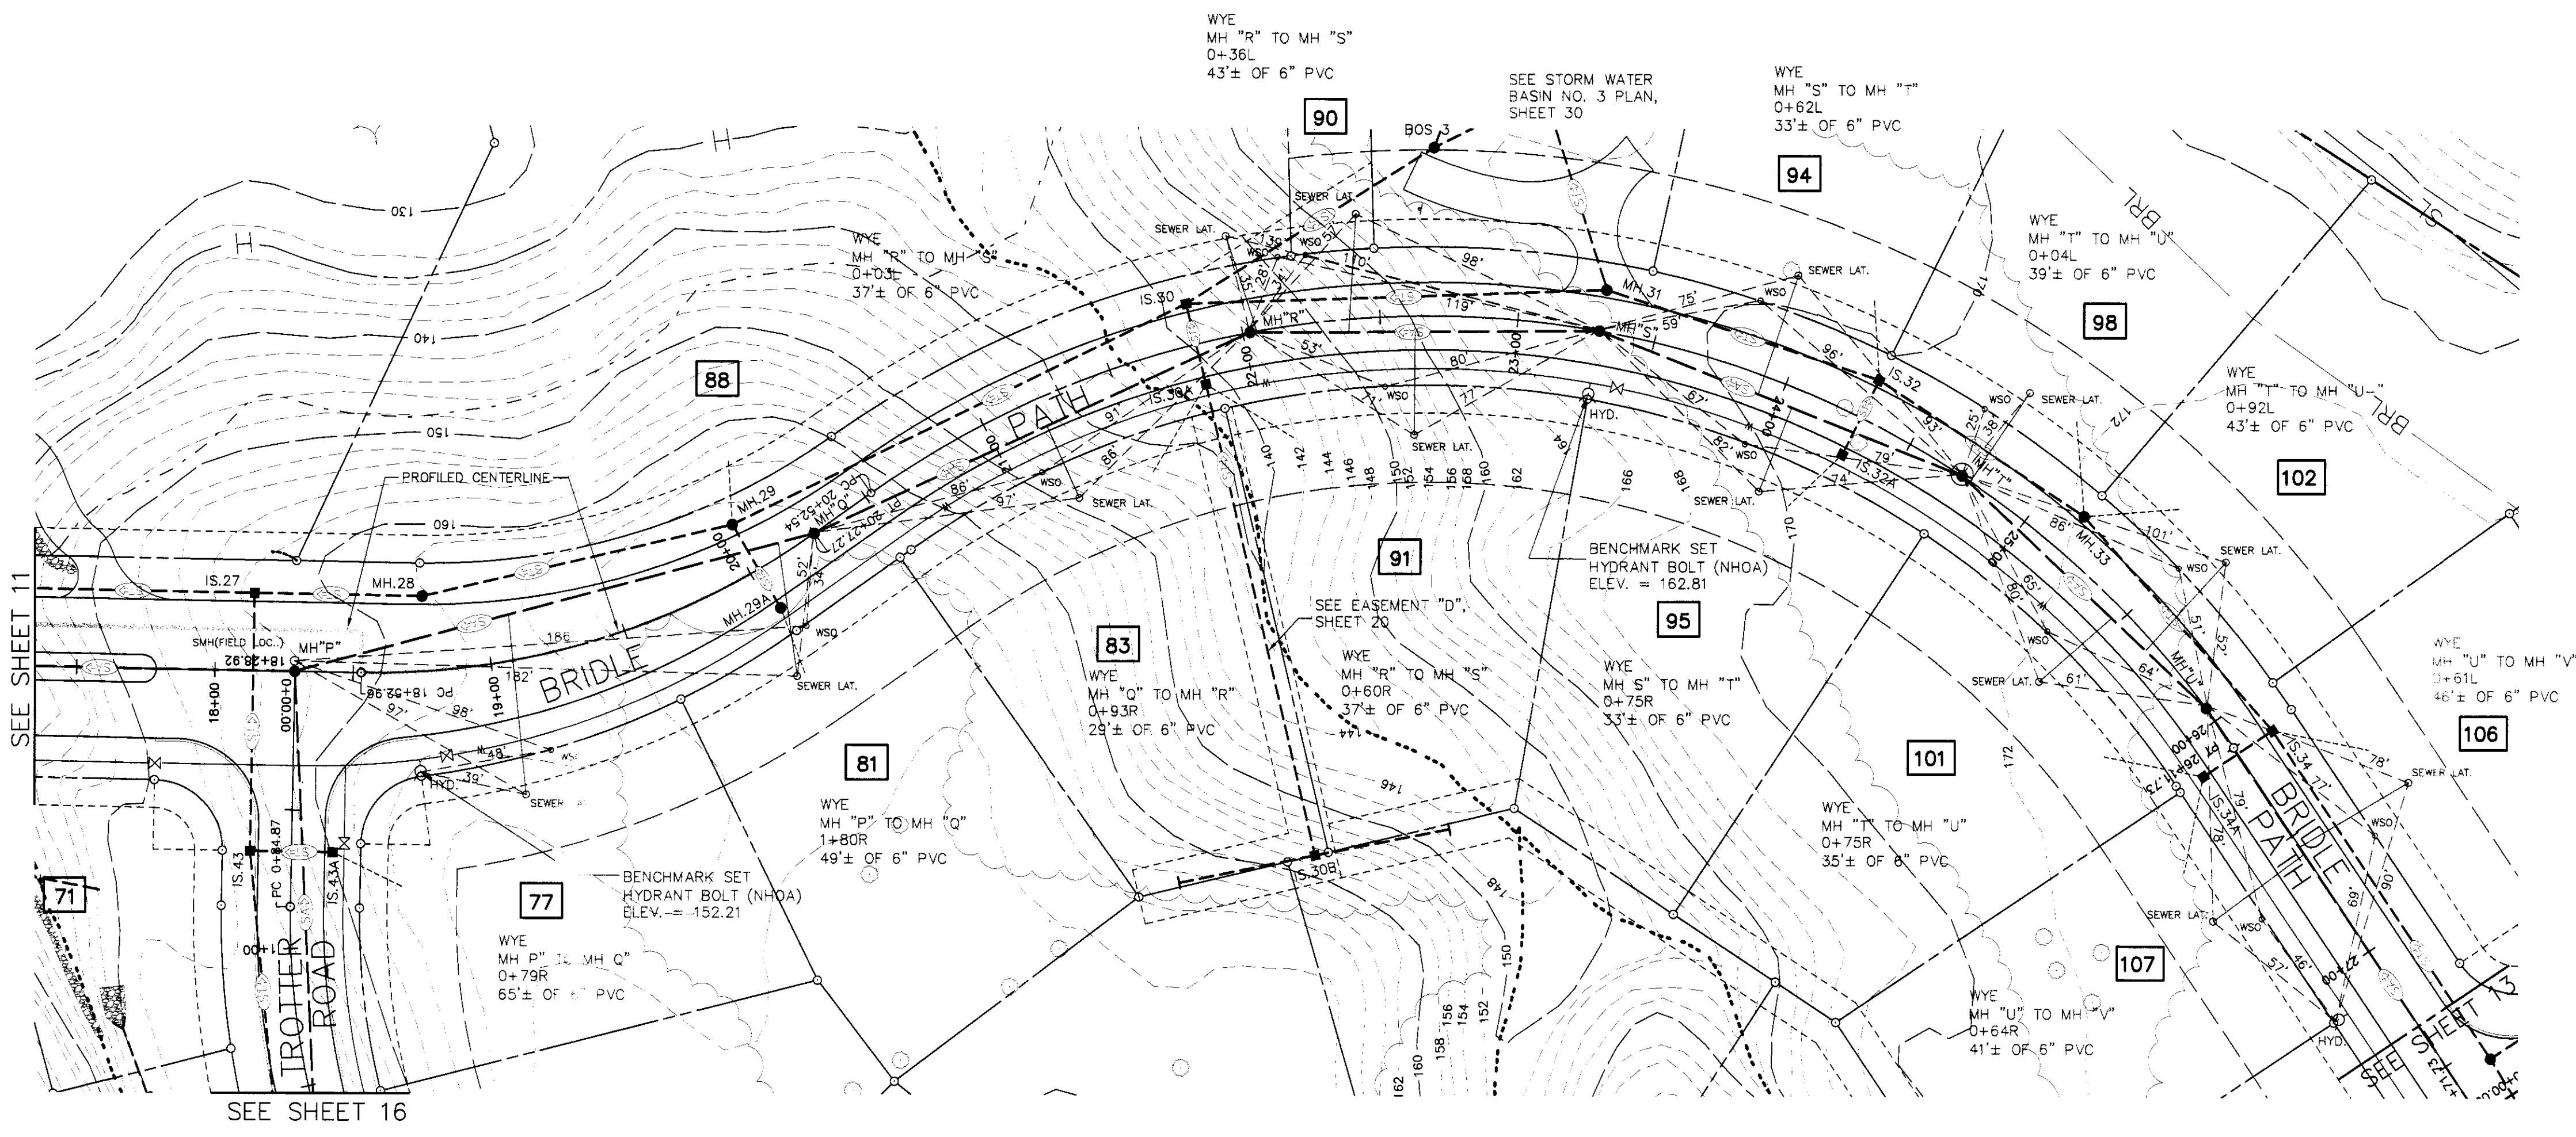



GENERAL NOTES

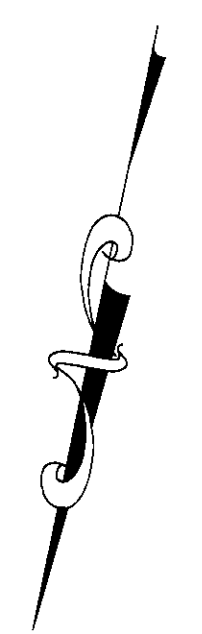

GENERAL PLAN - BRIDLE PATH
CENTERLINE STATIONING 17+80 - 27+00
SCALE: 1"= 40'

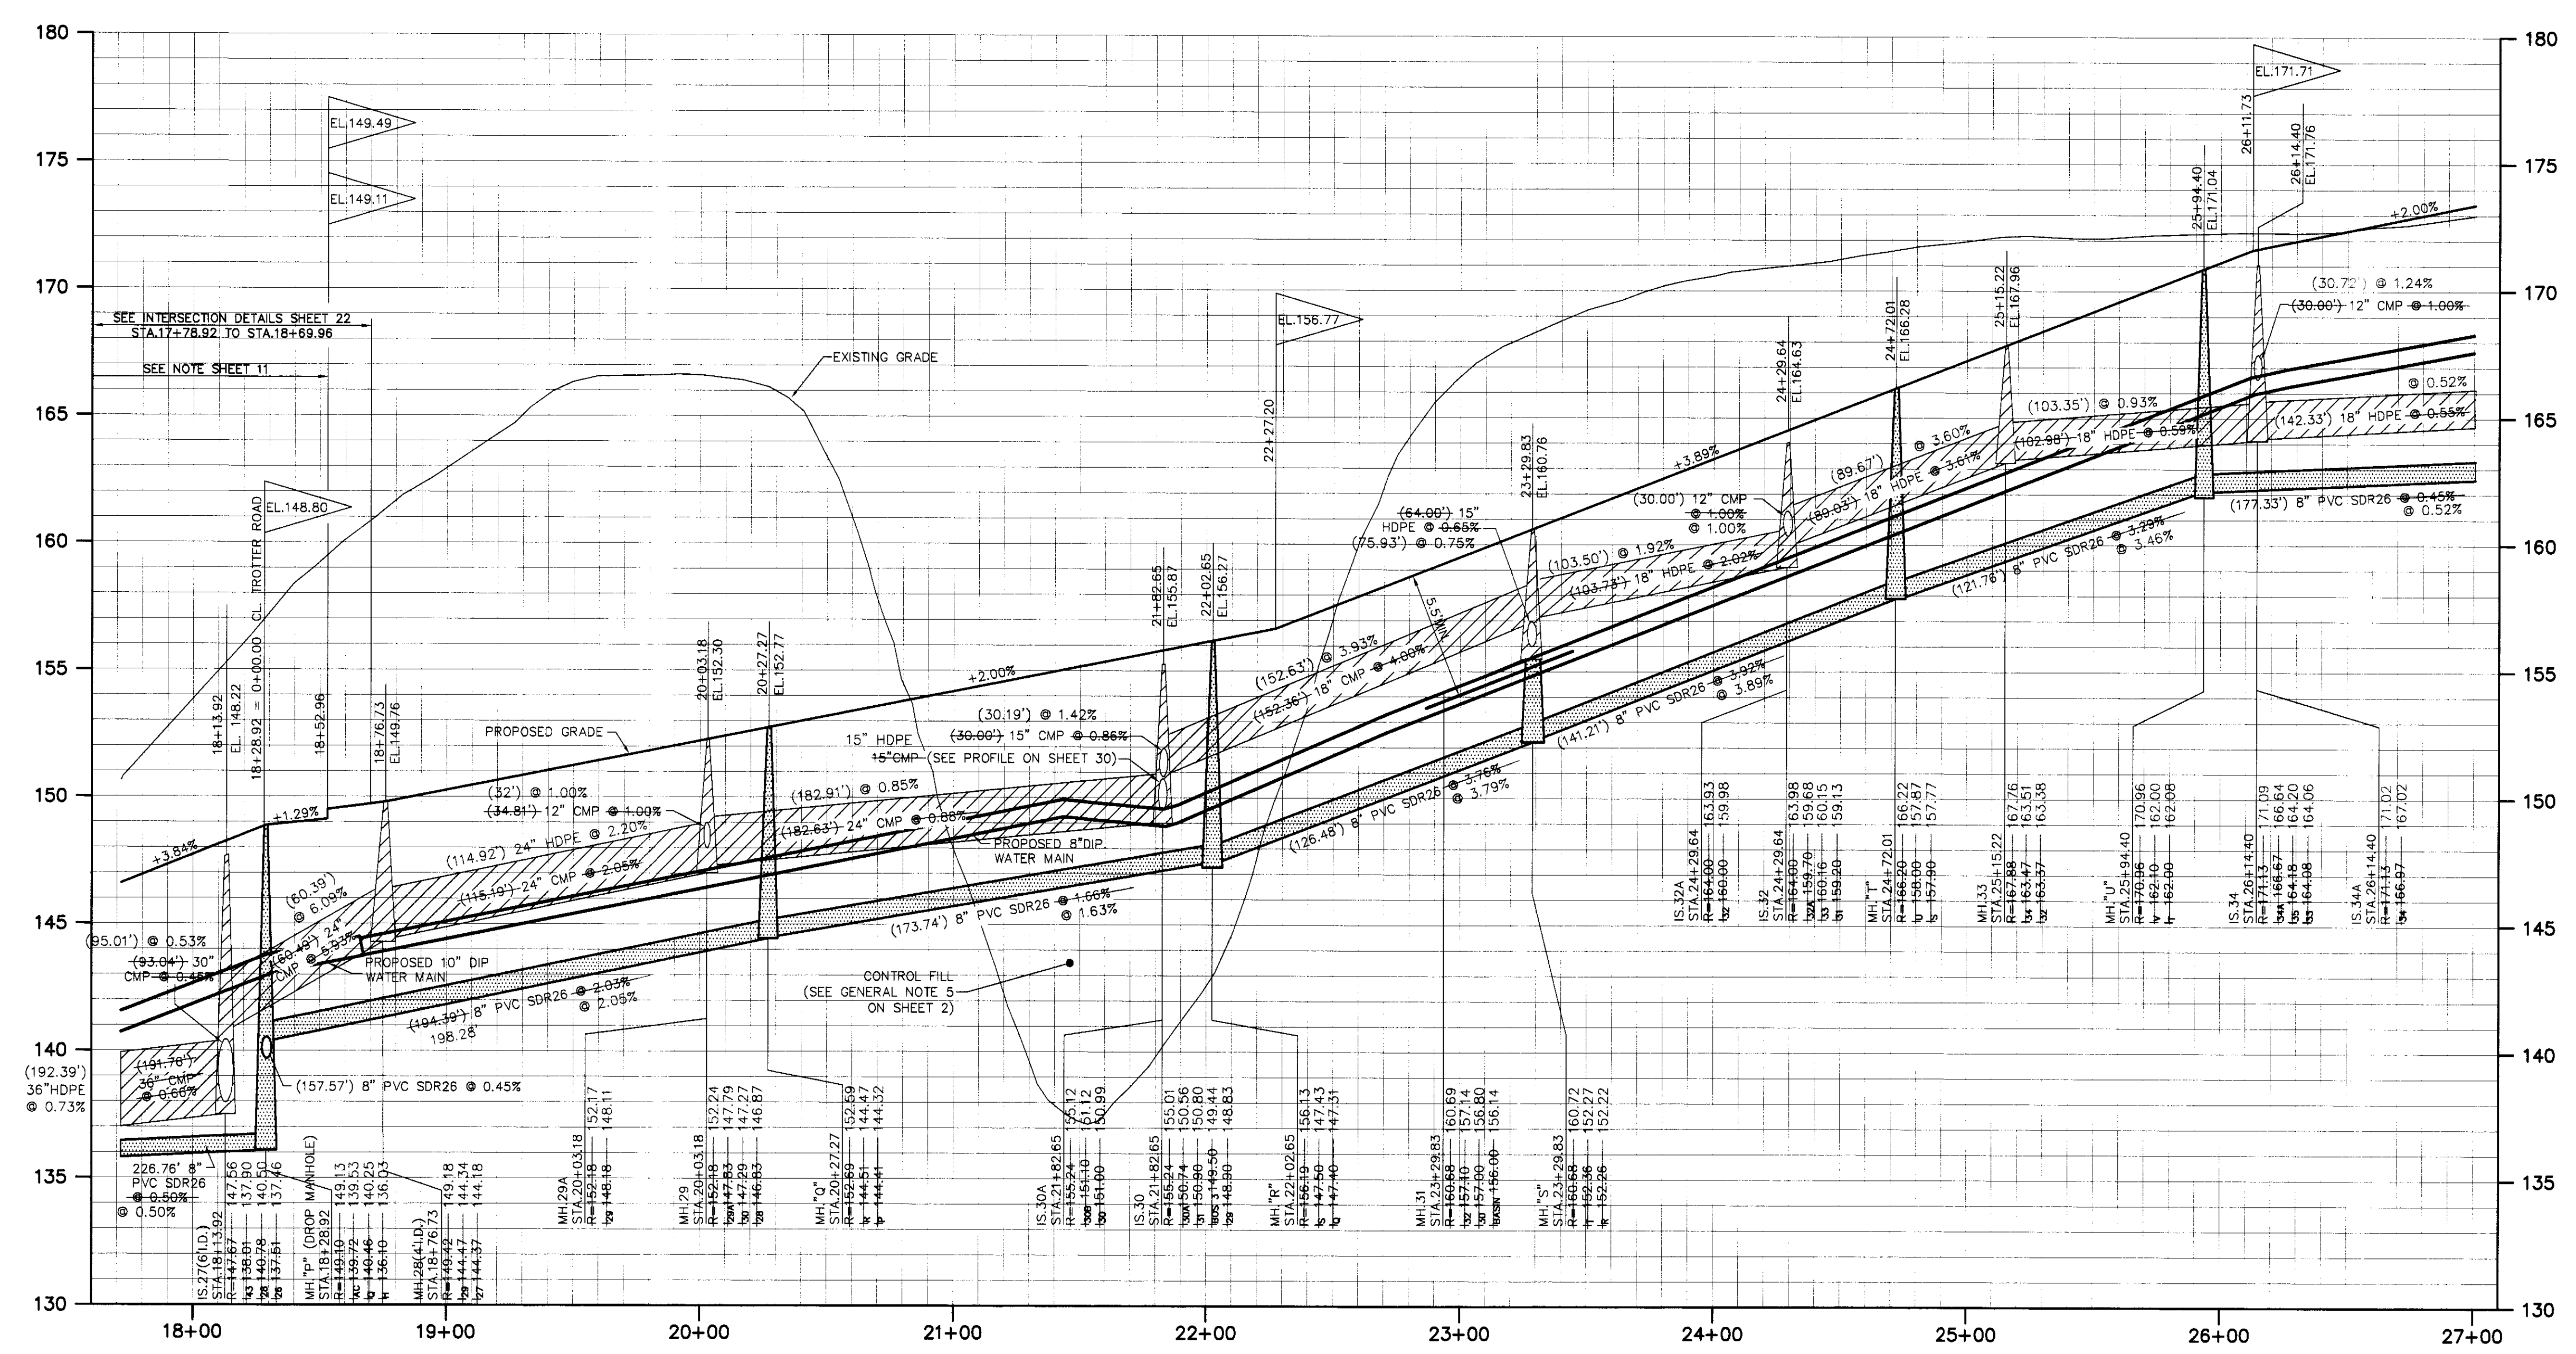

PROFILE - BRIDLE PATH
SCALE: 1"=4' VERT. / 1"=40' HORIZ.

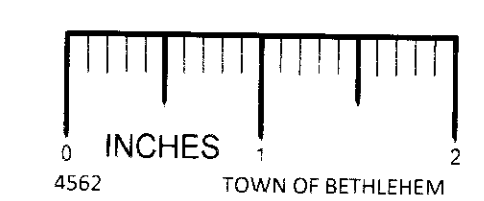

UNAUTHORIZED ALTERATIONS OR ADDITIONS TO THIS DOCUMENT IS A VIOLATION OF SECTION 2209 SUBDIVISION 2 OF THE NEW YORK STATE EDUCATION LAW

REVISIONS			
DATE	BY	DESCRIPTION	SYMBOL
6/99	CHJ	FINAL PLAN REVISIONS	▲
10/99	CHJ	FINAL PLAN REVISIONS	▲
5/00	CHJ	FINAL PLAN REVISIONS	▲
12/00	CHJ	FINAL PLAN REVISIONS	▲
1/28/01	CHJ	FINAL PLAN REVISIONS	▲
10/04	CHJ	FINAL PLAN REVISIONS	▲
5/05	CHJ	LET LINE OWNERS	▲
1/06	CHJ	MISCELLANEOUS REVISIONS	▲
3/06	CHJ	MISCELLANEOUS REVISIONS	▲
4/06	CHJ	MISCELLANEOUS REVISIONS	▲
6/28/06	CHJ	REVISED PER TOWN COMMENTS	▲

EDWARD W. BOUTELLE AND SON
CIVIL ENGINEERS AND SURVEYORS
423 KENWOOD AVENUE
DELMAR, NEW YORK
TEL.(518) 439-9981 FAX.(518) 439-9982
A DIVISION OF J. KENNETH FRASER AND ASSOCIATES, P.C., L.S., L.A., P.C.

FINAL PLAN AMENDED
CARRIAGE HILL SUBDIVISION
MAP OF LANDS OF CHARLEW CONSTRUCTION CORP.

TOWN OF BETHELEM COUNTY OF ALBANY
STATE OF NEW YORK

SCALE: AS NOTED

RECORD DRAWING

ALL INFORMATION SHOWN IN RED ON THESE DRAWINGS REPRESENT RECORD INFORMATION OBTAINED BY THE FIELD CREWS OF C.T. MALE ASSOCIATES, P.C. DURING THE MONTH OF OCTOBER 2008.

PROJ. SURVEYOR: CHJ
DRAWN BY: TWK
ASSEMBLED BY: TWK
CHECKED BY: CHJ

PROJECT NO.: 99-020
CAD FILE NAME: 4103-012

SHEET TITLE: PLAN & PROFILE
BRIDLE PATH STA. 17+80 - 27+00
DATE: NOVEMBER 1995 SHEET 12 OF 31

