


GENERAL PLAN - BRIDLE PATH  
 CENTERLINE STATIONING 27+00 - 34+78.20  
 SCALE: 1" = 40'

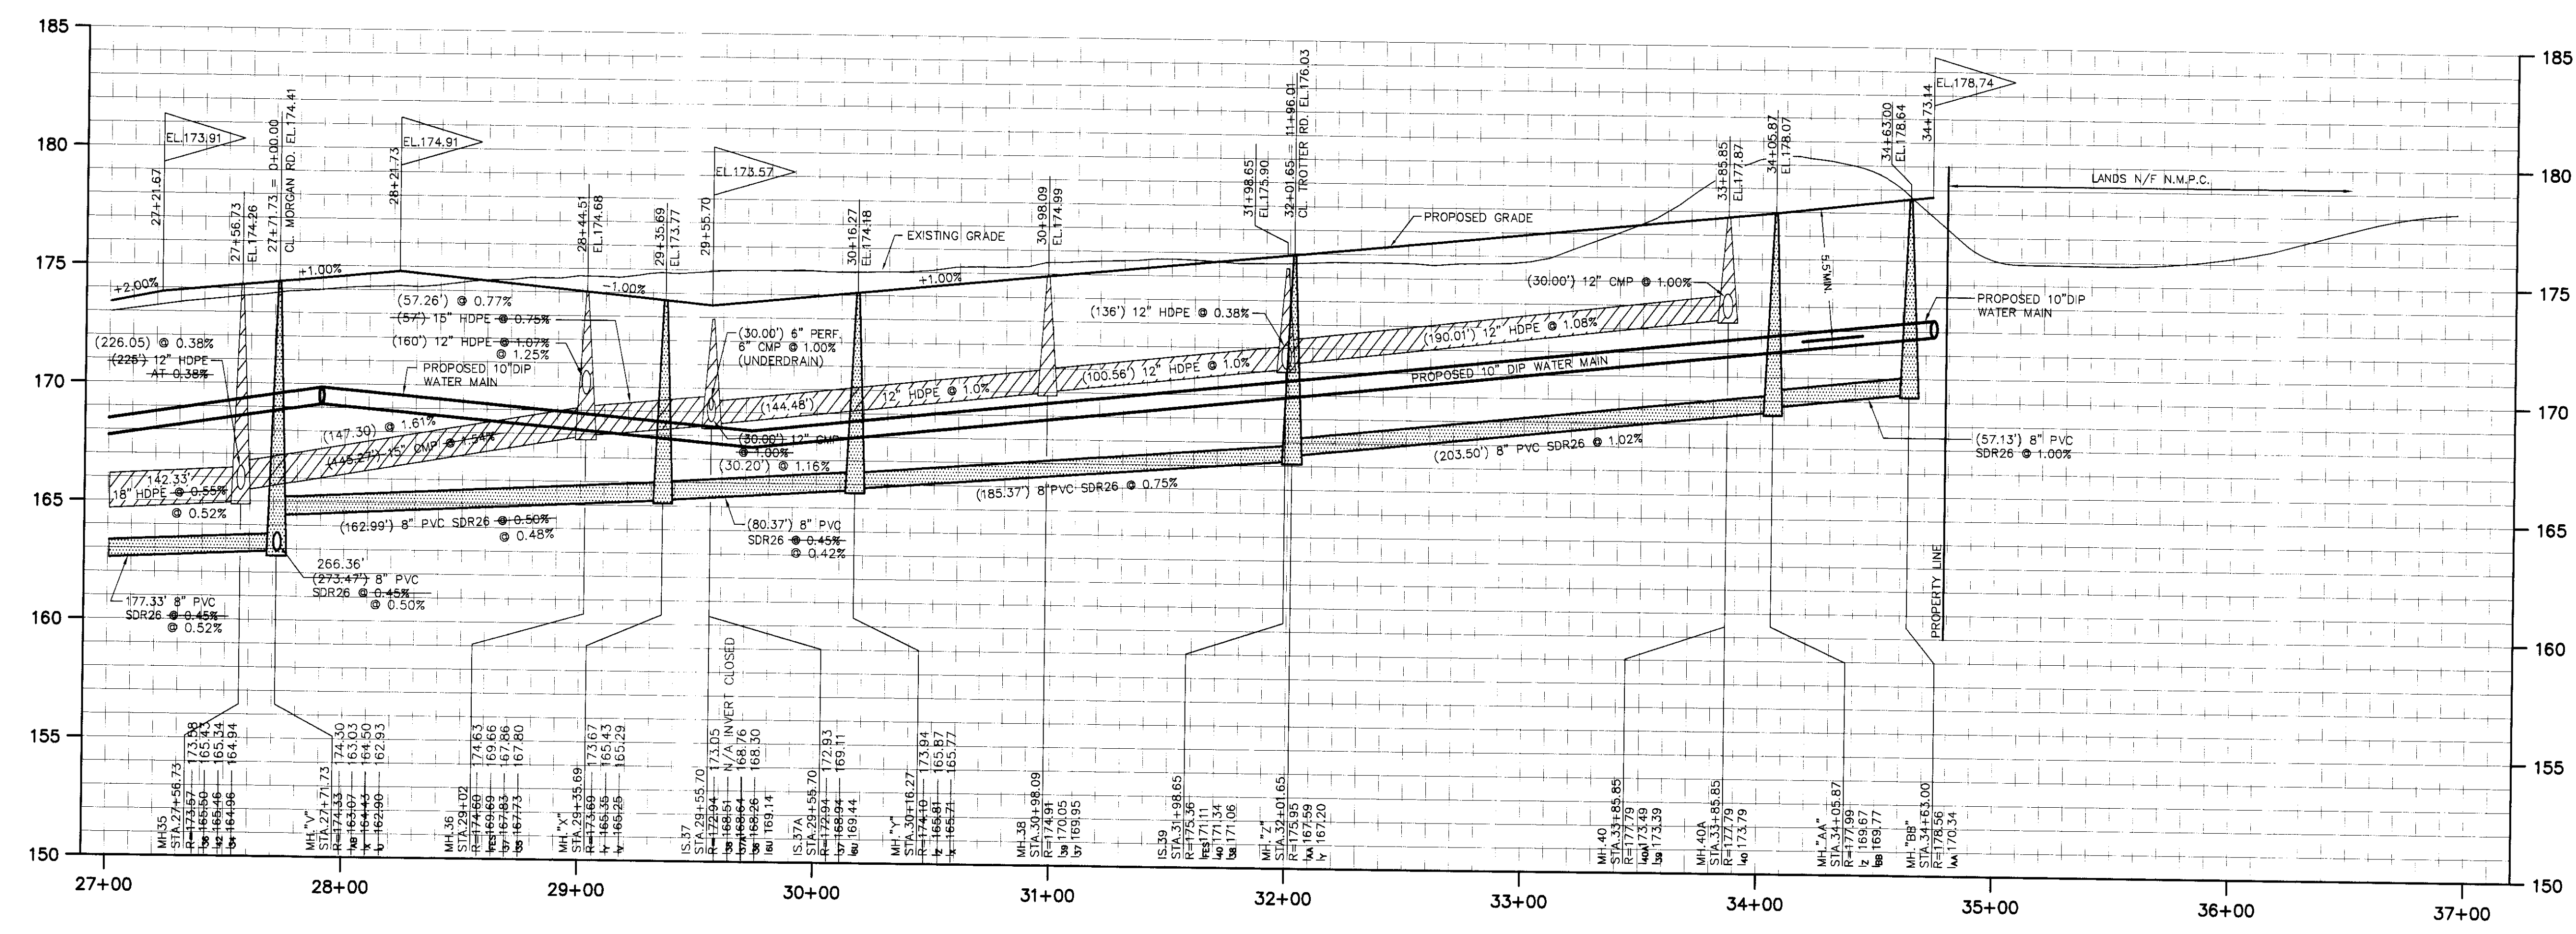

PROFILE - BRIDLE PATH  
 SCALE: 1" = 4' VERT. / 1" = 40' HORIZ.

UNAUTHORIZED ALTERATIONS OR ADDITIONS TO THIS DOCUMENT IS A VIOLATION OF SECTION 7209 SUBDIVISION 2 OF THE NEW YORK STATE EDUCATION LAW.

REVISIONS			
DATE	BY	DESCRIPTION	SYMBOL
8/99	CHJ	FINAL PLAN REVISIONS	△
10/99	CHJ	FINAL PLAN REVISIONS	△
5/00	CHJ	FINAL PLAN REVISIONS	△
12/00	CHJ	FINAL PLAN REVISIONS	△
1/26/01	CHJ	FINAL PLAN REVISIONS	△
10/04	CHJ	FINAL PLAN REVISIONS	△
5/05	CHJ	LOT LINE CHANGES	△
1/06	CHJ	MISCELLANEOUS REVISIONS	△
3/06	CHJ	MISCELLANEOUS REVISIONS	△
4/06	CHJ	MISCELLANEOUS REVISIONS	△

**EDWARD W. BOUTELLE AND SON**  
 CIVIL ENGINEERS AND SURVEYORS  
 423 KENWOOD AVENUE  
 DELMAR, NEW YORK  
 TEL: (315) 439-9981 FAX: (315) 439-9982  
 A DIVISION OF J. KENNETH FRASER AND ASSOCIATES, P.E., I.S., I.A., P.C.

**FINAL PLAN AMENDED**  
 CARRIAGE HILL SUBDIVISION  
 MAP OF LANDS OF CHARLEW CONSTRUCTION CORP.

TOWN OF BETHELEHEM COUNTY OF ALBANY  
 STATE OF NEW YORK  
 SCALE: AS NOTED

**RECORD DRAWING**

ALL INFORMATION SHOWN IN RED ON THESE DRAWINGS REPRESENT RECORD INFORMATION OBTAINED BY THE FIELD CREWS OF C.T. MALE ASSOCIATES, P.C. DURING THE MONTH OF OCTOBER 2008.

PROJ. SURVEYOR: CHJ  
 DRAWN BY: TWK  
 ASSEMBLED BY: TWK  
 CHECKED BY: CHJ

PROJECT NO.: 99-020  
 CAD FILE NAME: 4103-013

SHEET TITLE: **PLAN & PROFILE**  
 BRIDLE PATH STA. 27+00 - 34+78.20

