


GENERAL PLAN - HORSESHOE DRIVE  
 CENTERLINE STATIONING 6+80 - 12+91.60  
 SCALE: 1" = 40'

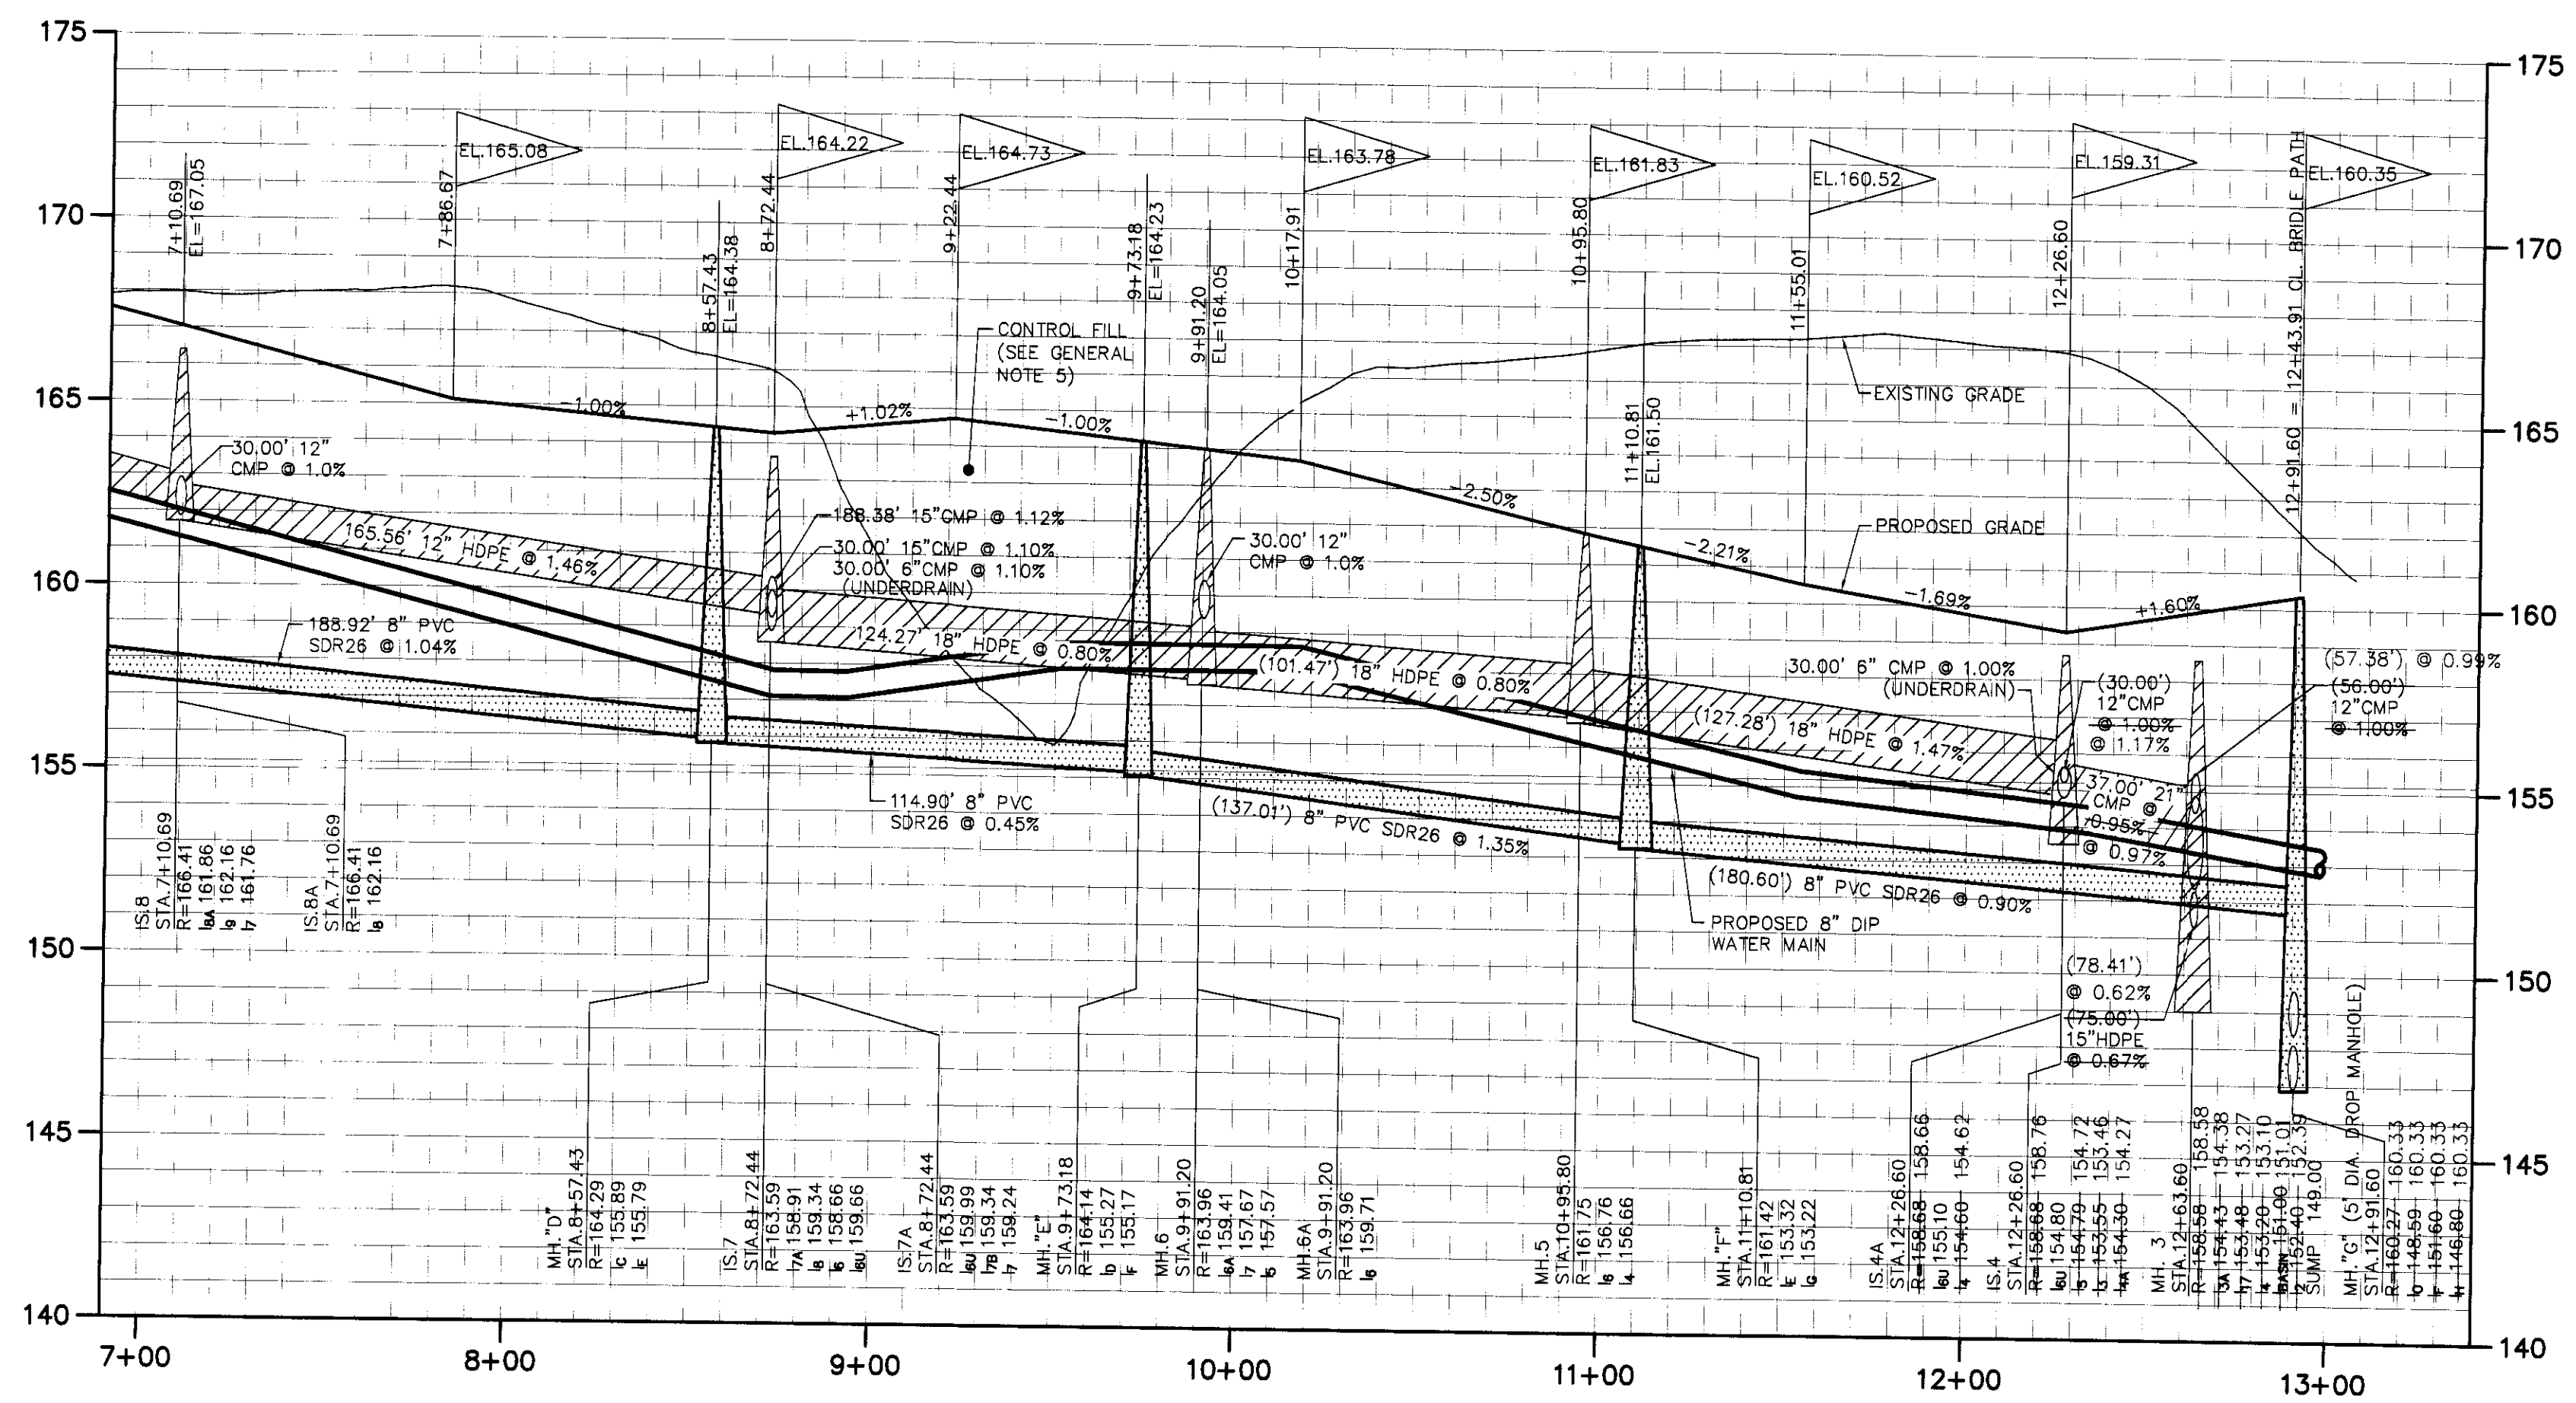

PROFILE - HORSESHOE DRIVE  
 SCALE: 1" = 4' VERT. / 1" = 40' HORIZ.

UNAUTHORIZED ALTERATIONS OR ADDITIONS TO THIS DOCUMENT IS A VIOLATION OF SECTION 7209 SUBDIVISION 2 OF THE NEW YORK STATE EDUCATION LAW

REVISIONS			
DATE	BY	DESCRIPTION	SYMBOL
6/99	CHJ	FINAL PLAN REVISIONS	△
10/99	CHJ	FINAL PLAN REVISIONS	△
5/00	CHJ	FINAL PLAN REVISIONS	△
12/00	CHJ	FINAL PLAN REVISIONS	△
1/28/01	CHJ	FINAL PLAN REVISIONS	△
10/04	CHJ	FINAL PLAN REVISIONS	△
9/08	CHJ	MISCELLANEOUS REVISIONS	△
1/08	CHJ	LOT LINE CHANGES	△
3/06	CHJ	MISCELLANEOUS REVISIONS	△
4/08	CHJ	MISCELLANEOUS REVISIONS	△

EDWARD W. BOUTELLE AND SON  
 CIVIL ENGINEERS AND SURVEYORS  
 423 KENWOOD AVENUE  
 DELMAR, NEW YORK  
 TEL. (518) 439-9981 FAX. (518) 439-9982  
 A DIVISION OF J. KENNETH FRASER AND ASSOCIATES, P.E., L.S., P.C.

FINAL PLAN  
 AMENDED  
 CARRIAGE HILL  
 SUBDIVISION  
 MAP OF LANDS OF  
 CHARLEW  
 CONSTRUCTION CORP.

TOWN OF BETHLEHEM COUNTY OF ALBANY  
 STATE OF NEW YORK

SCALE: AS NOTED

RECORD  
 DRAWING

ALL INFORMATION SHOWN IN RED ON THESE DRAWINGS REPRESENT RECORD INFORMATION OBTAINED BY THE FIELD CREWS OF C.T. MALE ASSOCIATES, P.C. DURING THE MONTH OF OCTOBER 2008.

PROJ. SURVEYOR: CHJ  
 DRAWN BY: TWK  
 ASSEMBLED BY: TWK  
 CHECKED BY: CHJ

PROJECT NO.: 99-020  
 CAD FILE NAME: 4103-015

SHEET TITLE: PLAN & PROFILE  
 HORSESHOE DRIVE STA. 6+80 - 12+91.60

