


GENERAL PLAN - TROTTER RD.
CENTERLINE STATIONING 0+00 - 6+20
SCALE: 1" = 40'

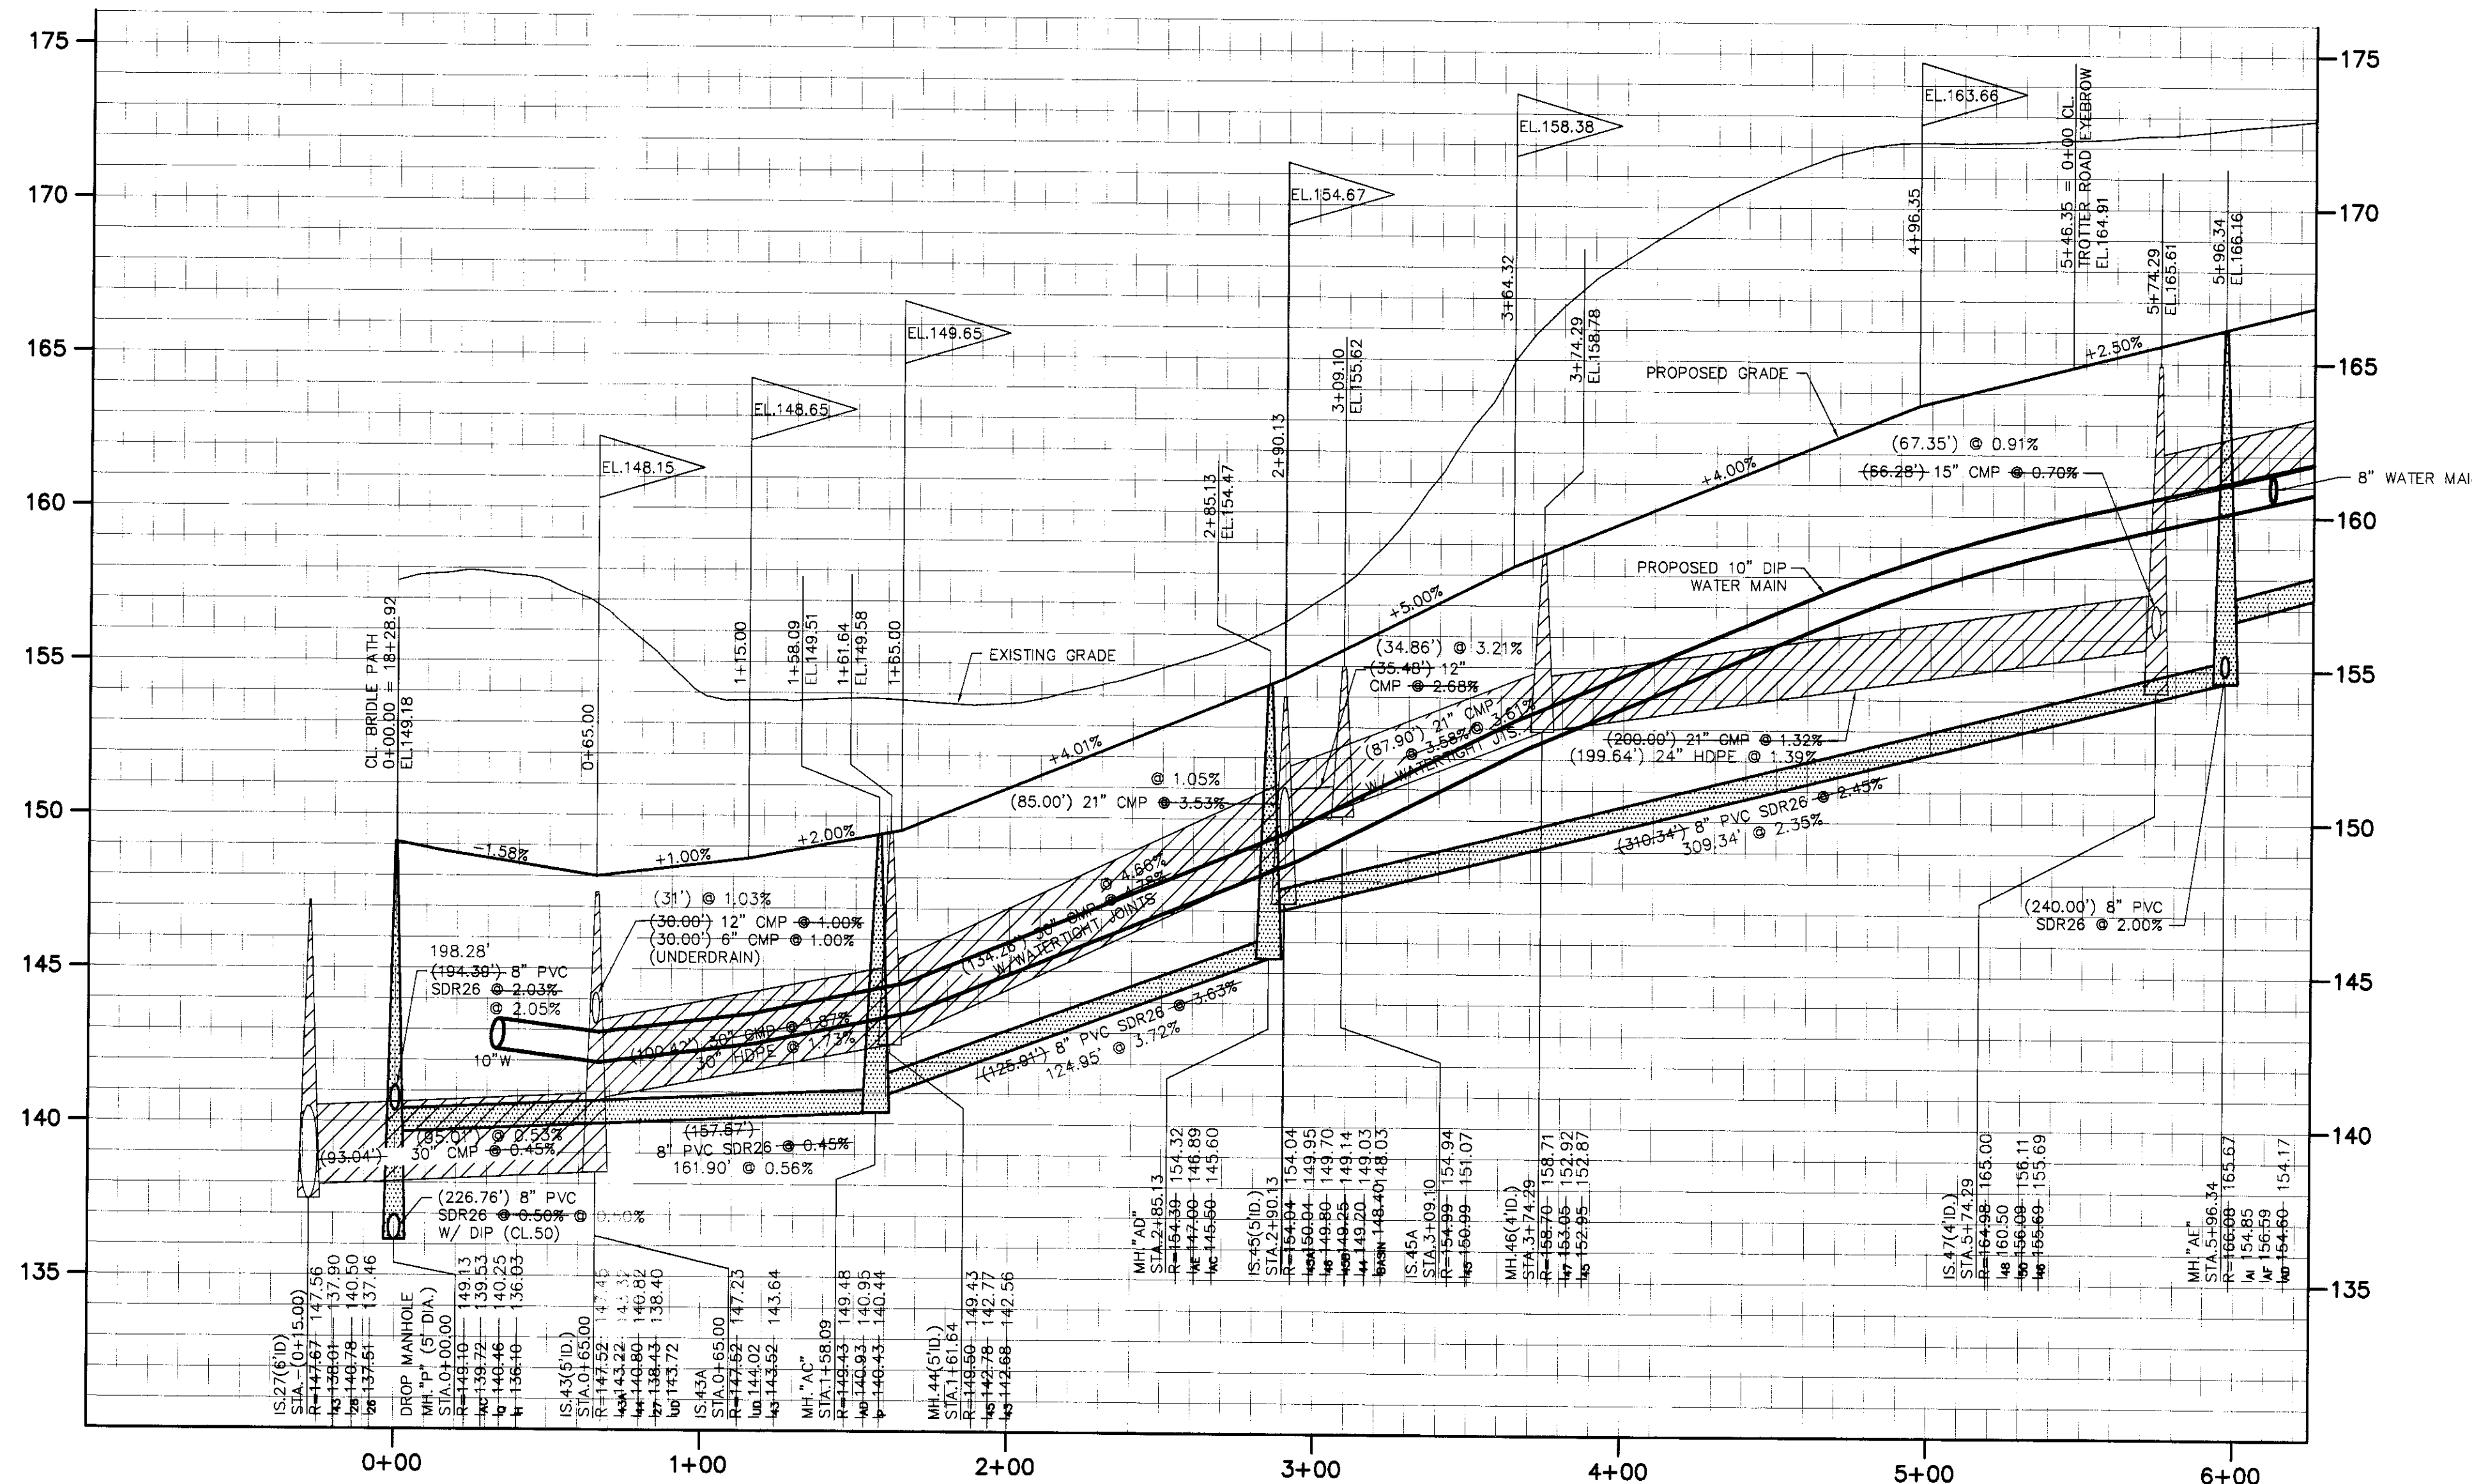

PROFILE - TROTTER RD.
SCALE: 1"=4' VERT. \ 1"=40' HORIZ.

UNAUTHORIZED ALTERATIONS OR ADDITIONS TO THIS DOCUMENT IS A VIOLATION OF SECTION 7209 SUBDIVISION 2 OF THE NEW YORK STATE EDUCATION LAW

| REVISIONS | | |
|-----------|-----|-------------------------|
| DATE | BY | DESCRIPTION |
| 6/99 | CHJ | FINAL PLAN REVISIONS |
| 10/99 | CHJ | FINAL PLAN REVISIONS |
| 5/00 | CHJ | FINAL PLAN REVISIONS |
| 12/00 | CHJ | FINAL PLAN REVISIONS |
| 1/28/01 | CHJ | FINAL PLAN REVISIONS |
| 10/04 | CHJ | FINAL PLAN REVISIONS |
| 5/05 | CHJ | LOT LINE CHANGES |
| 1/08 | CHJ | MISCELLANEOUS REVISIONS |
| 3/08 | CHJ | MISCELLANEOUS REVISIONS |
| 4/08 | CHJ | MISCELLANEOUS REVISIONS |

EDWARD W. BOUTELLE AND SON
CIVIL ENGINEERS AND SURVEYORS
423 KENWOOD AVENUE
DELMAR, NEW YORK
TEL: (518) 439-9981 FAX: (518) 439-9982
A DIVISION OF J. KENNETH FRASER AND ASSOCIATES, P.E., L.S., L.A., P.C.

FINAL PLAN AMENDED
CARRIAGE HILL SUBDIVISION
MAP OF LANDS OF CHARLEW CONSTRUCTION CORP.

TOWN OF BETHELEM COUNTY OF ALBANY STATE OF NEW YORK

SCALE: AS NOTED

RECORD DRAWING

ALL INFORMATION SHOWN IN RED ON THESE DRAWINGS REPRESENT RECORD INFORMATION OBTAINED BY THE FIELD CREWS OF C.T. MALE ASSOCIATES, P.C. DURING THE MONTH OF OCTOBER 2008.

PROJ. SURVEYOR: CHJ
DRAWN BY: TWK
ASSEMBLED BY: TWK
CHECKED BY: CHJ

PROJECT NO.: 99-020
CAD FILE NAME: 4103-016

SHEET TITLE: **PLAN & PROFILE**
TROTTER ROAD STA. 0+00 - 6+20

