




GENERAL PLAN - MORGAN ROAD  
SCALE: 1" = 40'

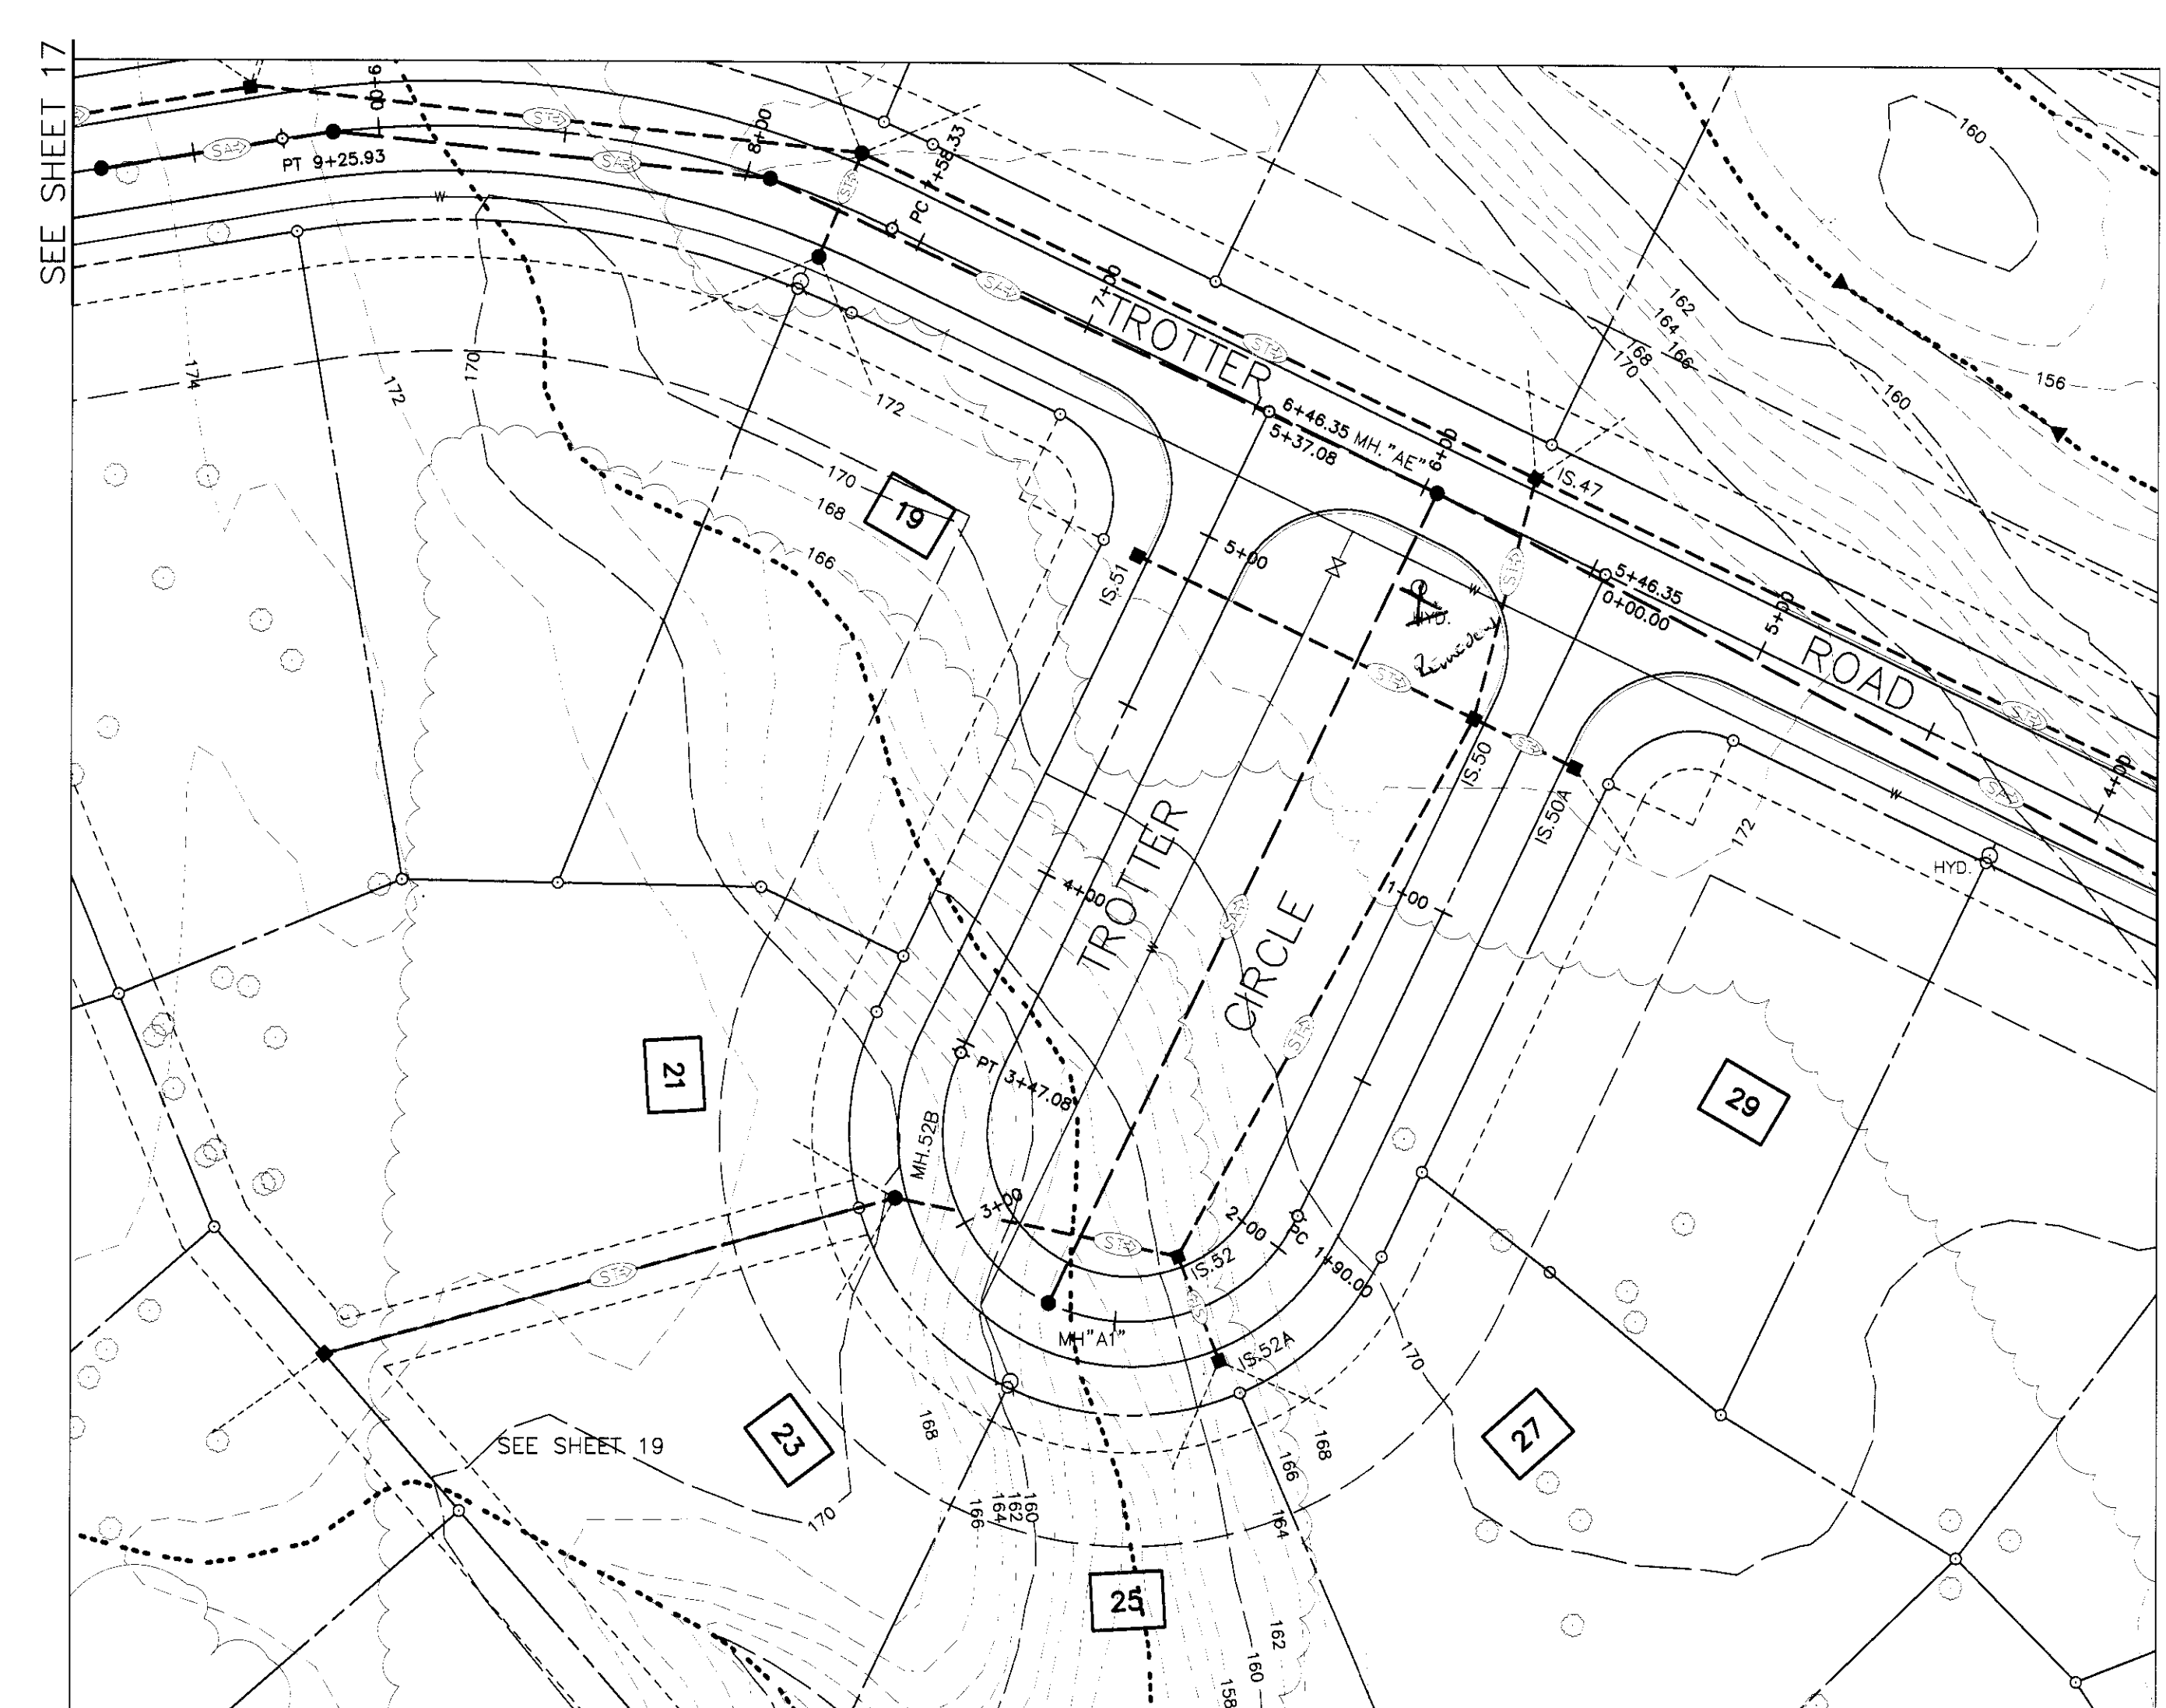

GENERAL PLAN - TROTTER CIRCLE  
SCALE: 1" = 40'

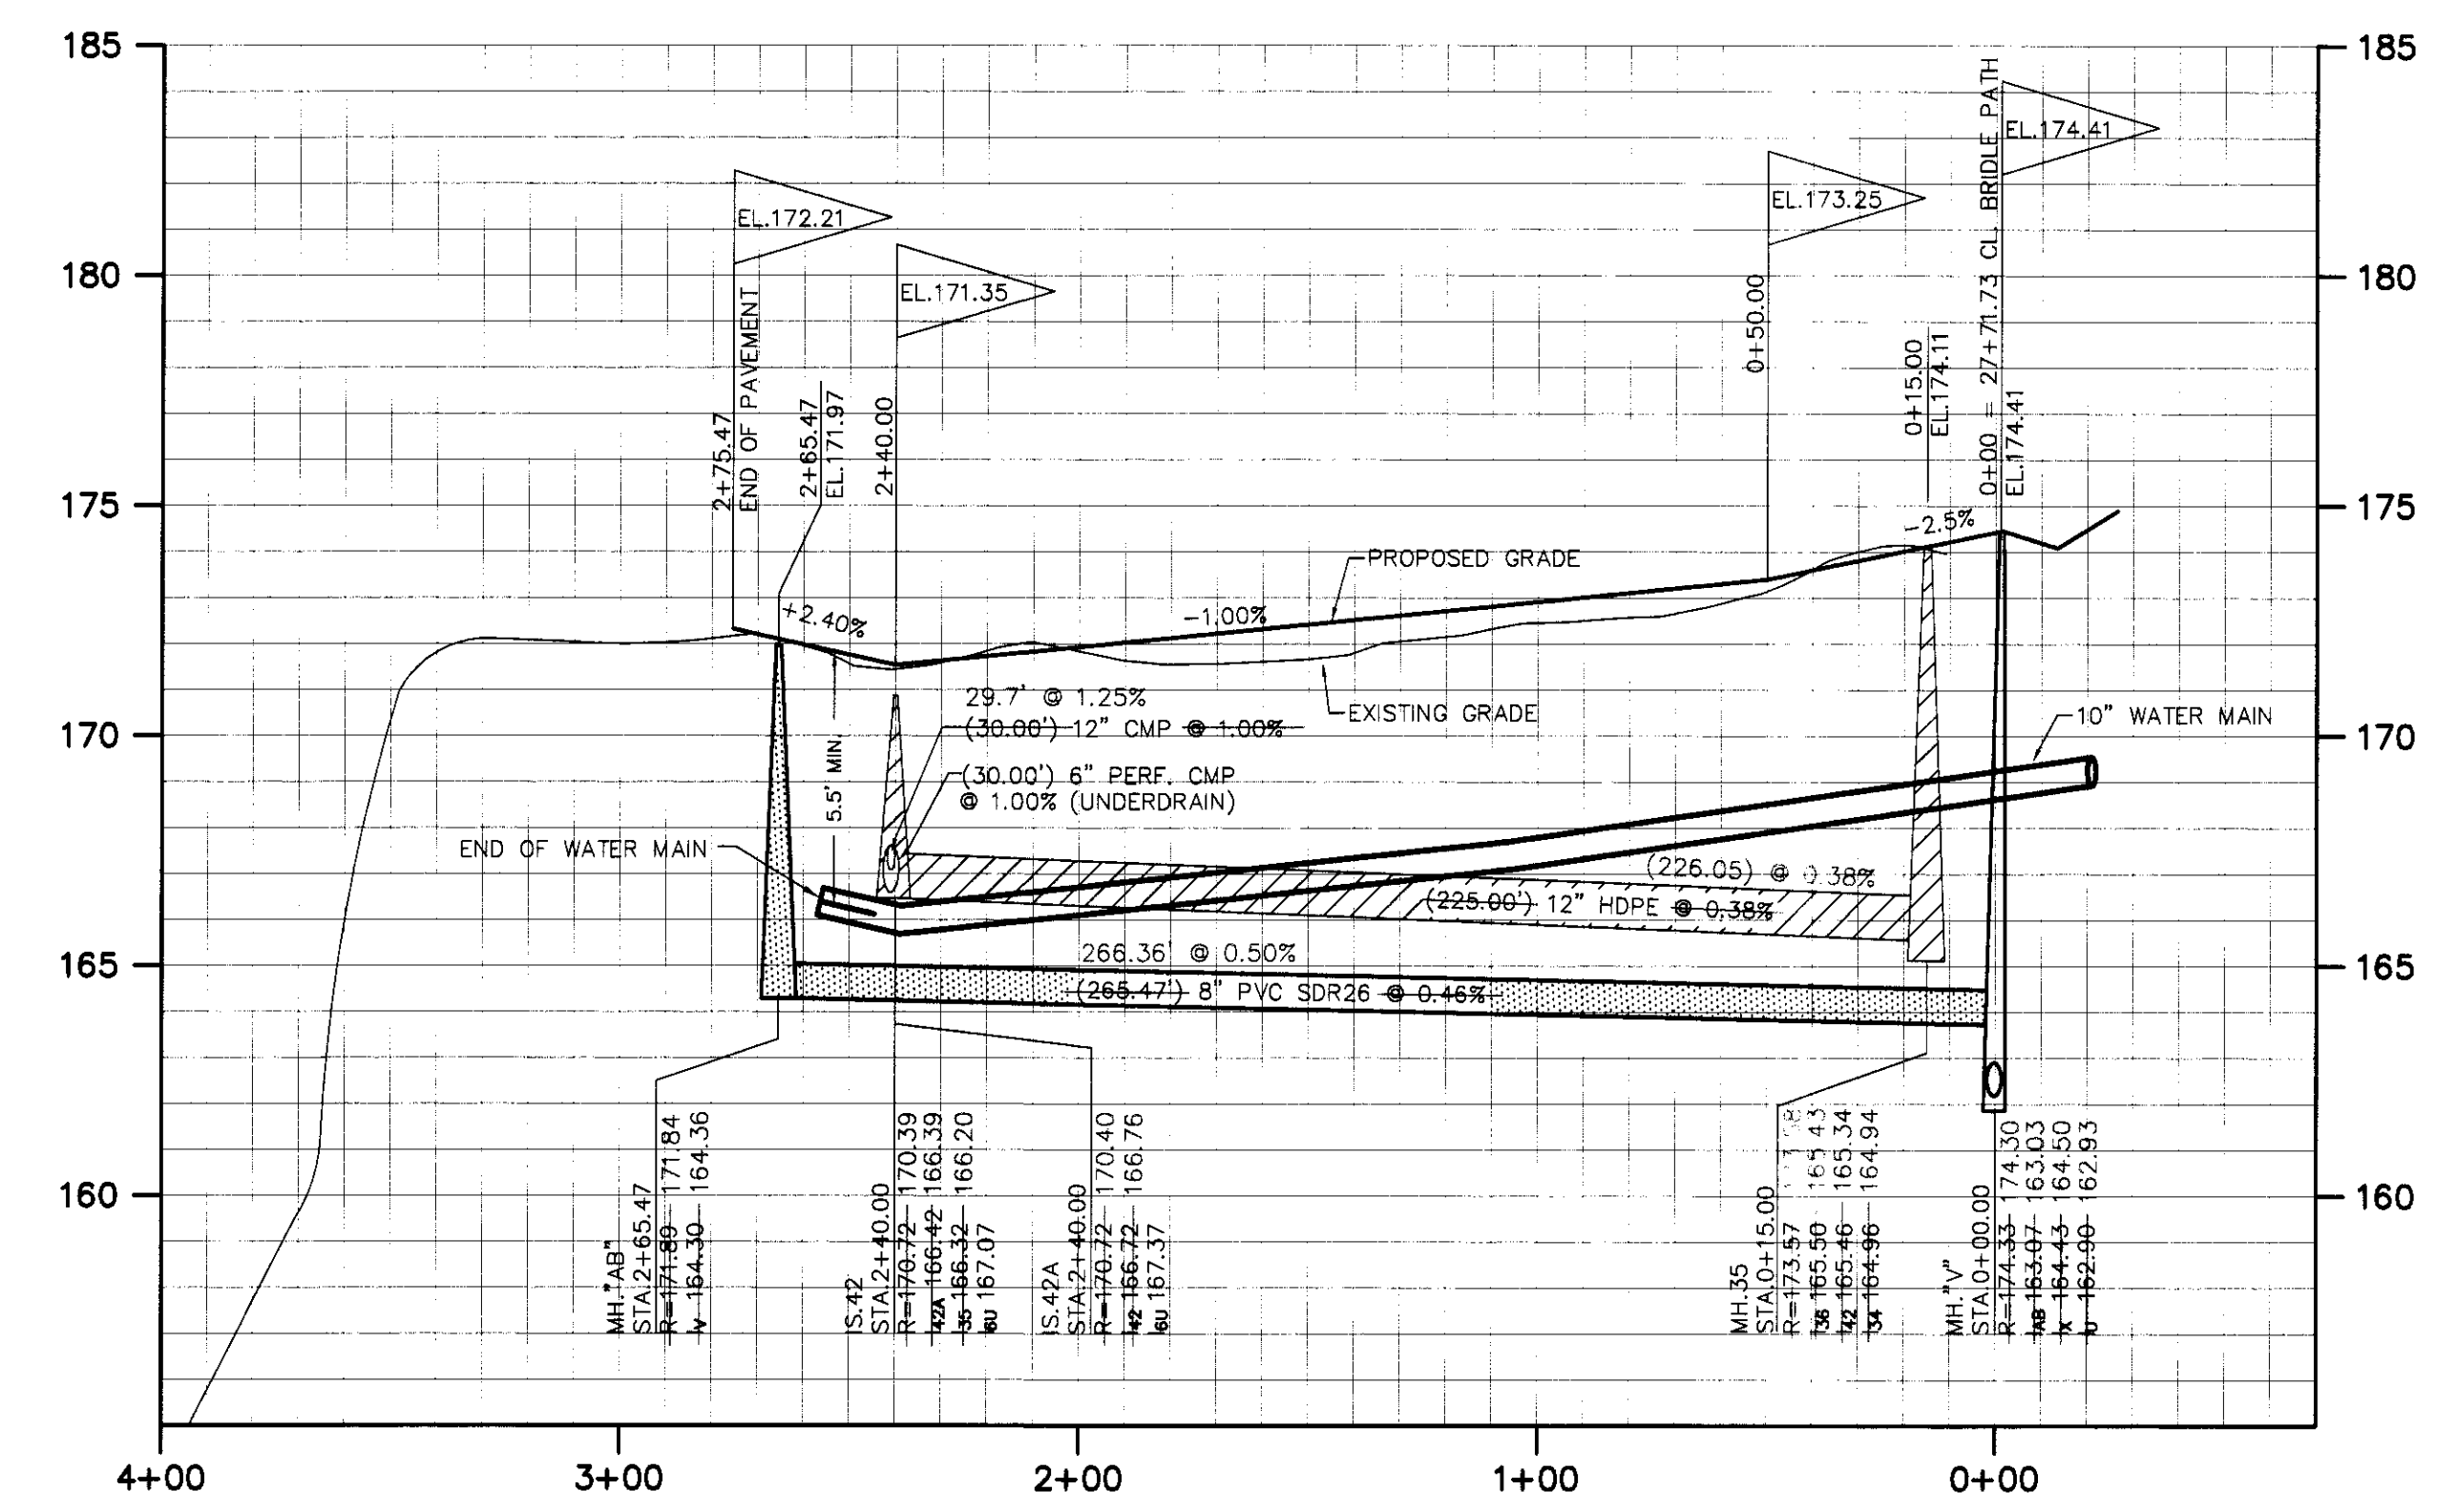

PROFILE - MORGAN ROAD  
SCALE: 1"=4' VERT. / 1"=40' HORIZ.

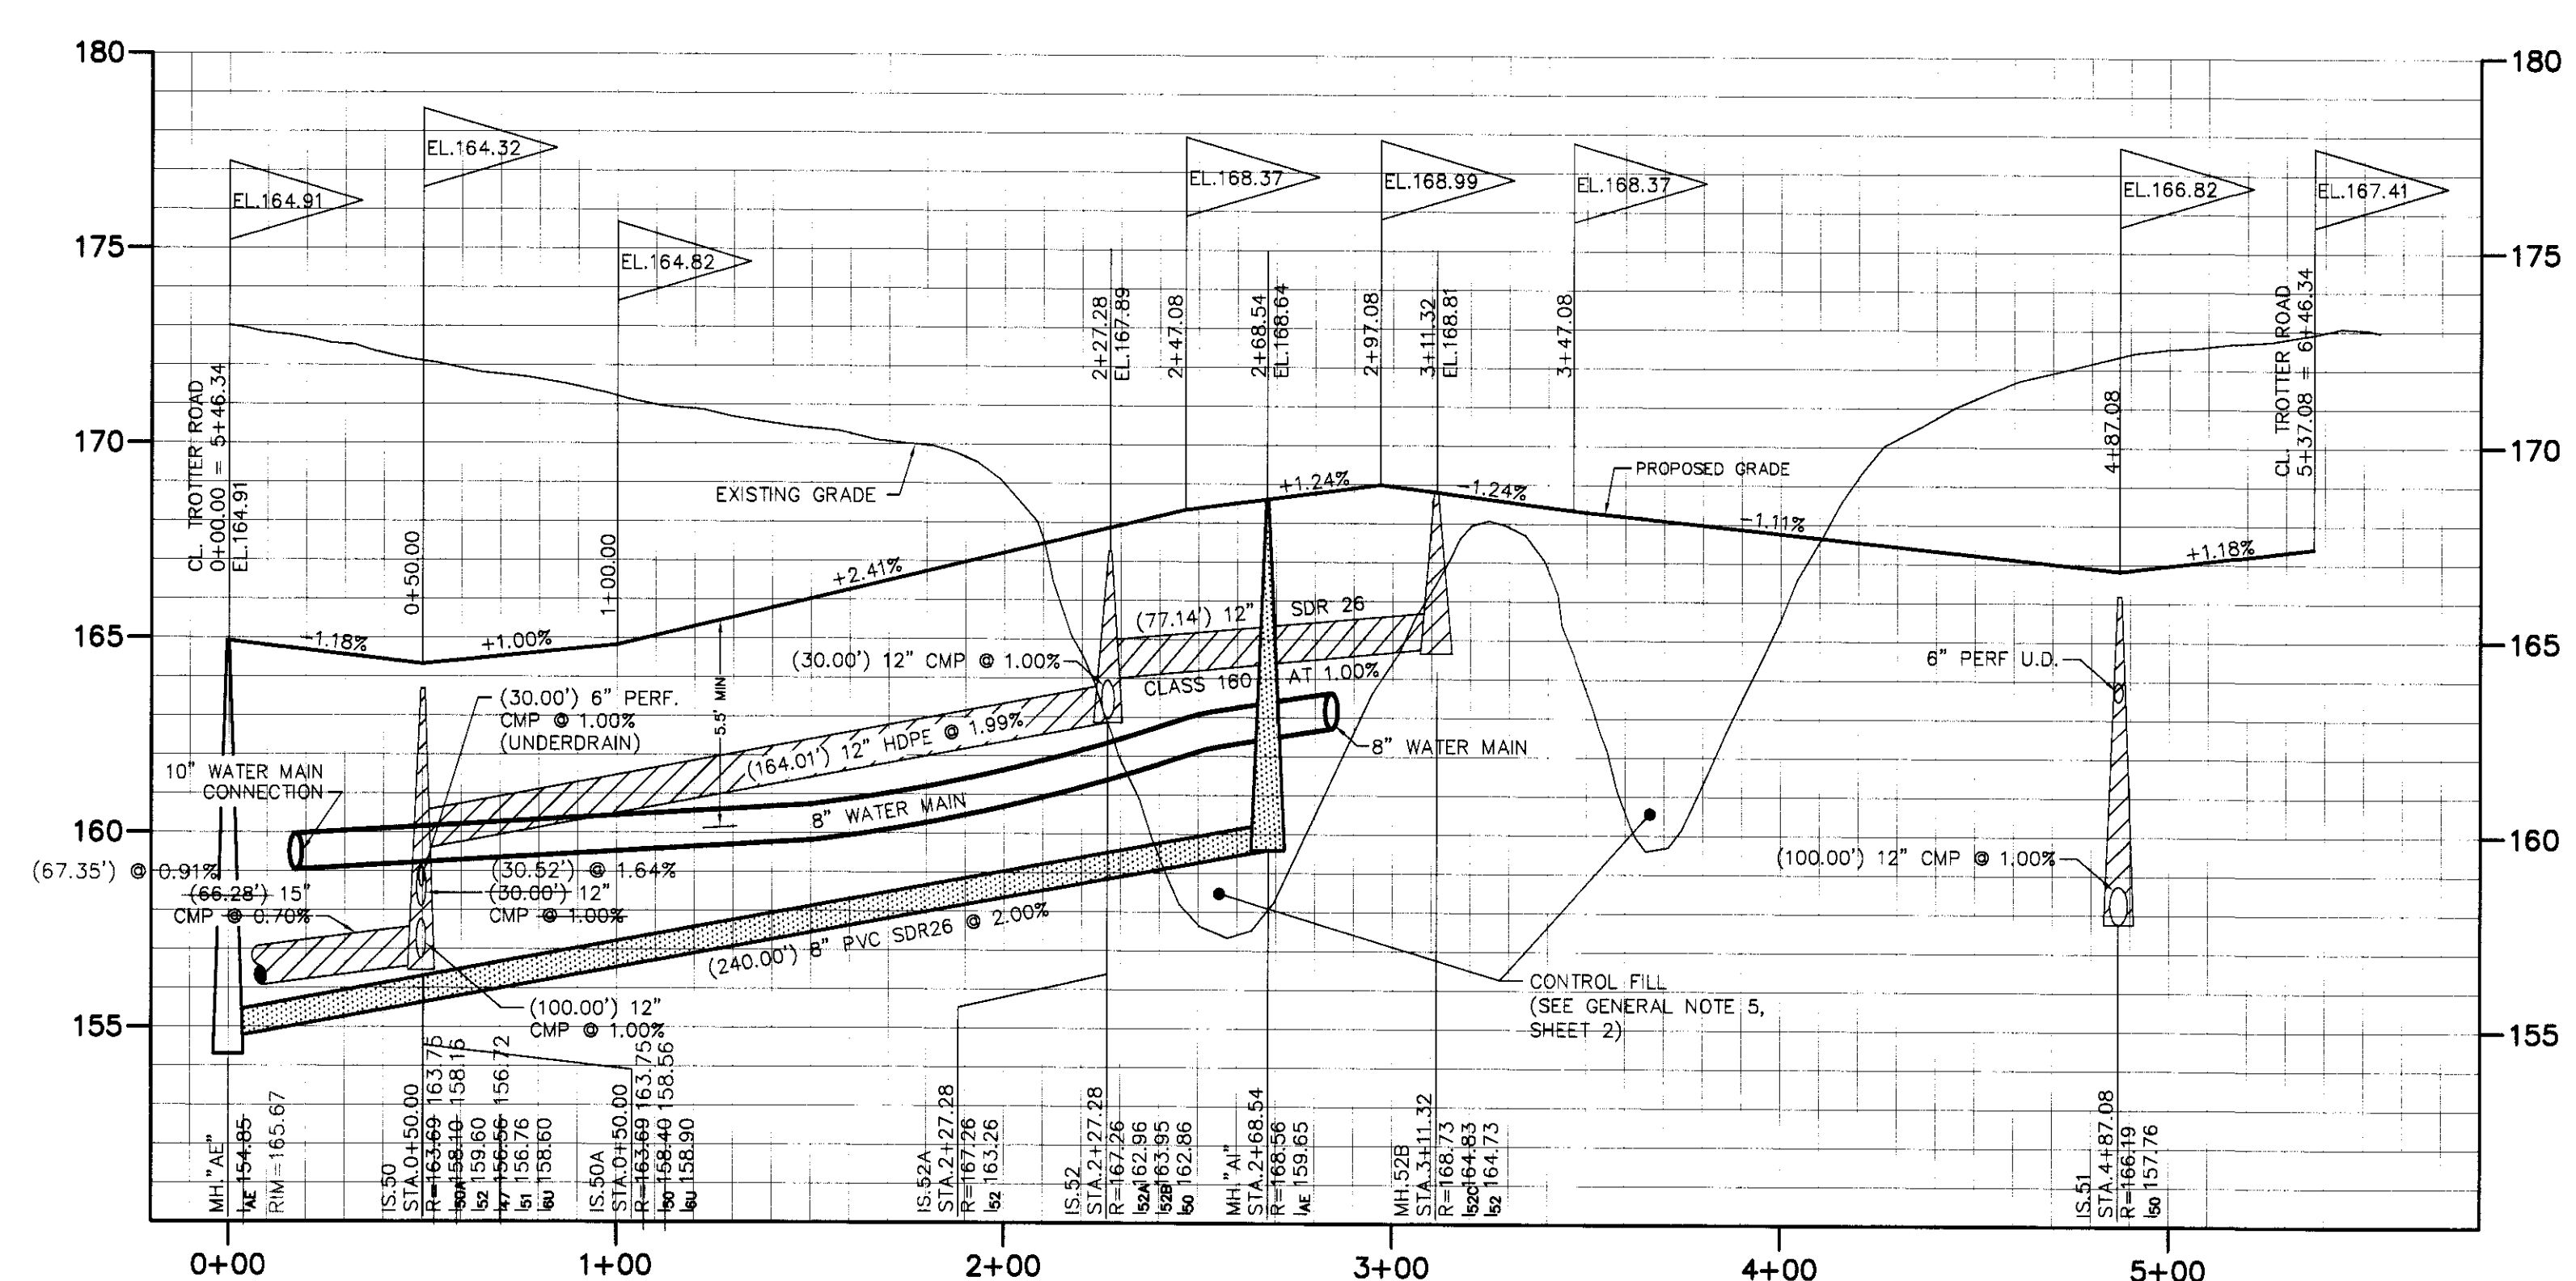

PROFILE - TROTTER CIRCLE  
SCALE: 1"=4' VERT. / 1"=40' HORIZ.

UNAUTHORIZED ALTERATIONS OR ADDITIONS TO THIS DOCUMENT IS A VIOLATION OF SECTION 7209 SUBDIVISION 2 OF THE NEW YORK STATE EDUCATION LAW.

REVISIONS

DATE	BY	DESCRIPTION	SYMBOL
4/99	CHJ	FINAL PLAN REVISIONS	△
10/99	CHJ	FINAL PLAN REVISIONS	△
5/00	CHJ	FINAL PLAN REVISIONS	△
12/00	CHJ	FINAL PLAN REVISIONS	△
1/28/01	CHJ	FINAL PLAN REVISIONS	△
7/01	CHJ	ADDC REVISIONS	△
1/04	CHJ	MISCELLANEOUS REVISIONS	△
3/06	CHJ	MISCELLANEOUS REVISIONS	△
4/04	CHJ	MISCELLANEOUS REVISIONS	△

**EDWARD W. BOUTELL AND SON**  
CIVIL ENGINEERS AND SURVEYORS  
423 KENWOOD AVENUE  
DELMAR, NEW YORK  
TEL: (518) 439-9981 FAX: (518) 439-998

A DIVISION OF J. KENNETH FRASER AND ASSOCIATES, P.E., L.S., P.C.


**FINAL PLAN AMENDED**  
CARRIAGE HILL SUBDIVISION  
MAP OF LANDS OF CHARLEW CONSTRUCTION CORP.

TOWN OF BETHLEHEM COUNTY OF ALBANY  
STATE OF NEW YORK

SCALE: AS NOTED

RECORD DRAWING

ALL INFORMATION SHOWN IN RED ON THESE DRAWINGS REPRESENT RECORD INFORMATION OBTAINED BY THE FIELD CREWS OF C.T. MALE ASSOCIATES, P.C. DURING THE MONTH OF OCTOBER 2008.

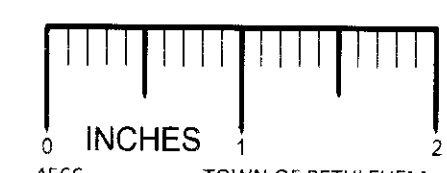

PROJ. SURVEYOR: CHJ  
DRAWN BY: TWK  
ASSEMBLED BY: TWK  
CHECKED BY: CHJ

PROJECT NO.: 99-020  
CAD FILE NAME: 4103-01-

SHEET TITLE: PLAN & PROFILE MORGAN ROAD AND TROTTER CIRCLE

DATE: NOVEMBER 1995 SHEET 18 OF 31

