




GENERAL PLAN - DRAINAGE EASEMENT "C"
SCALE: 1" = 40'

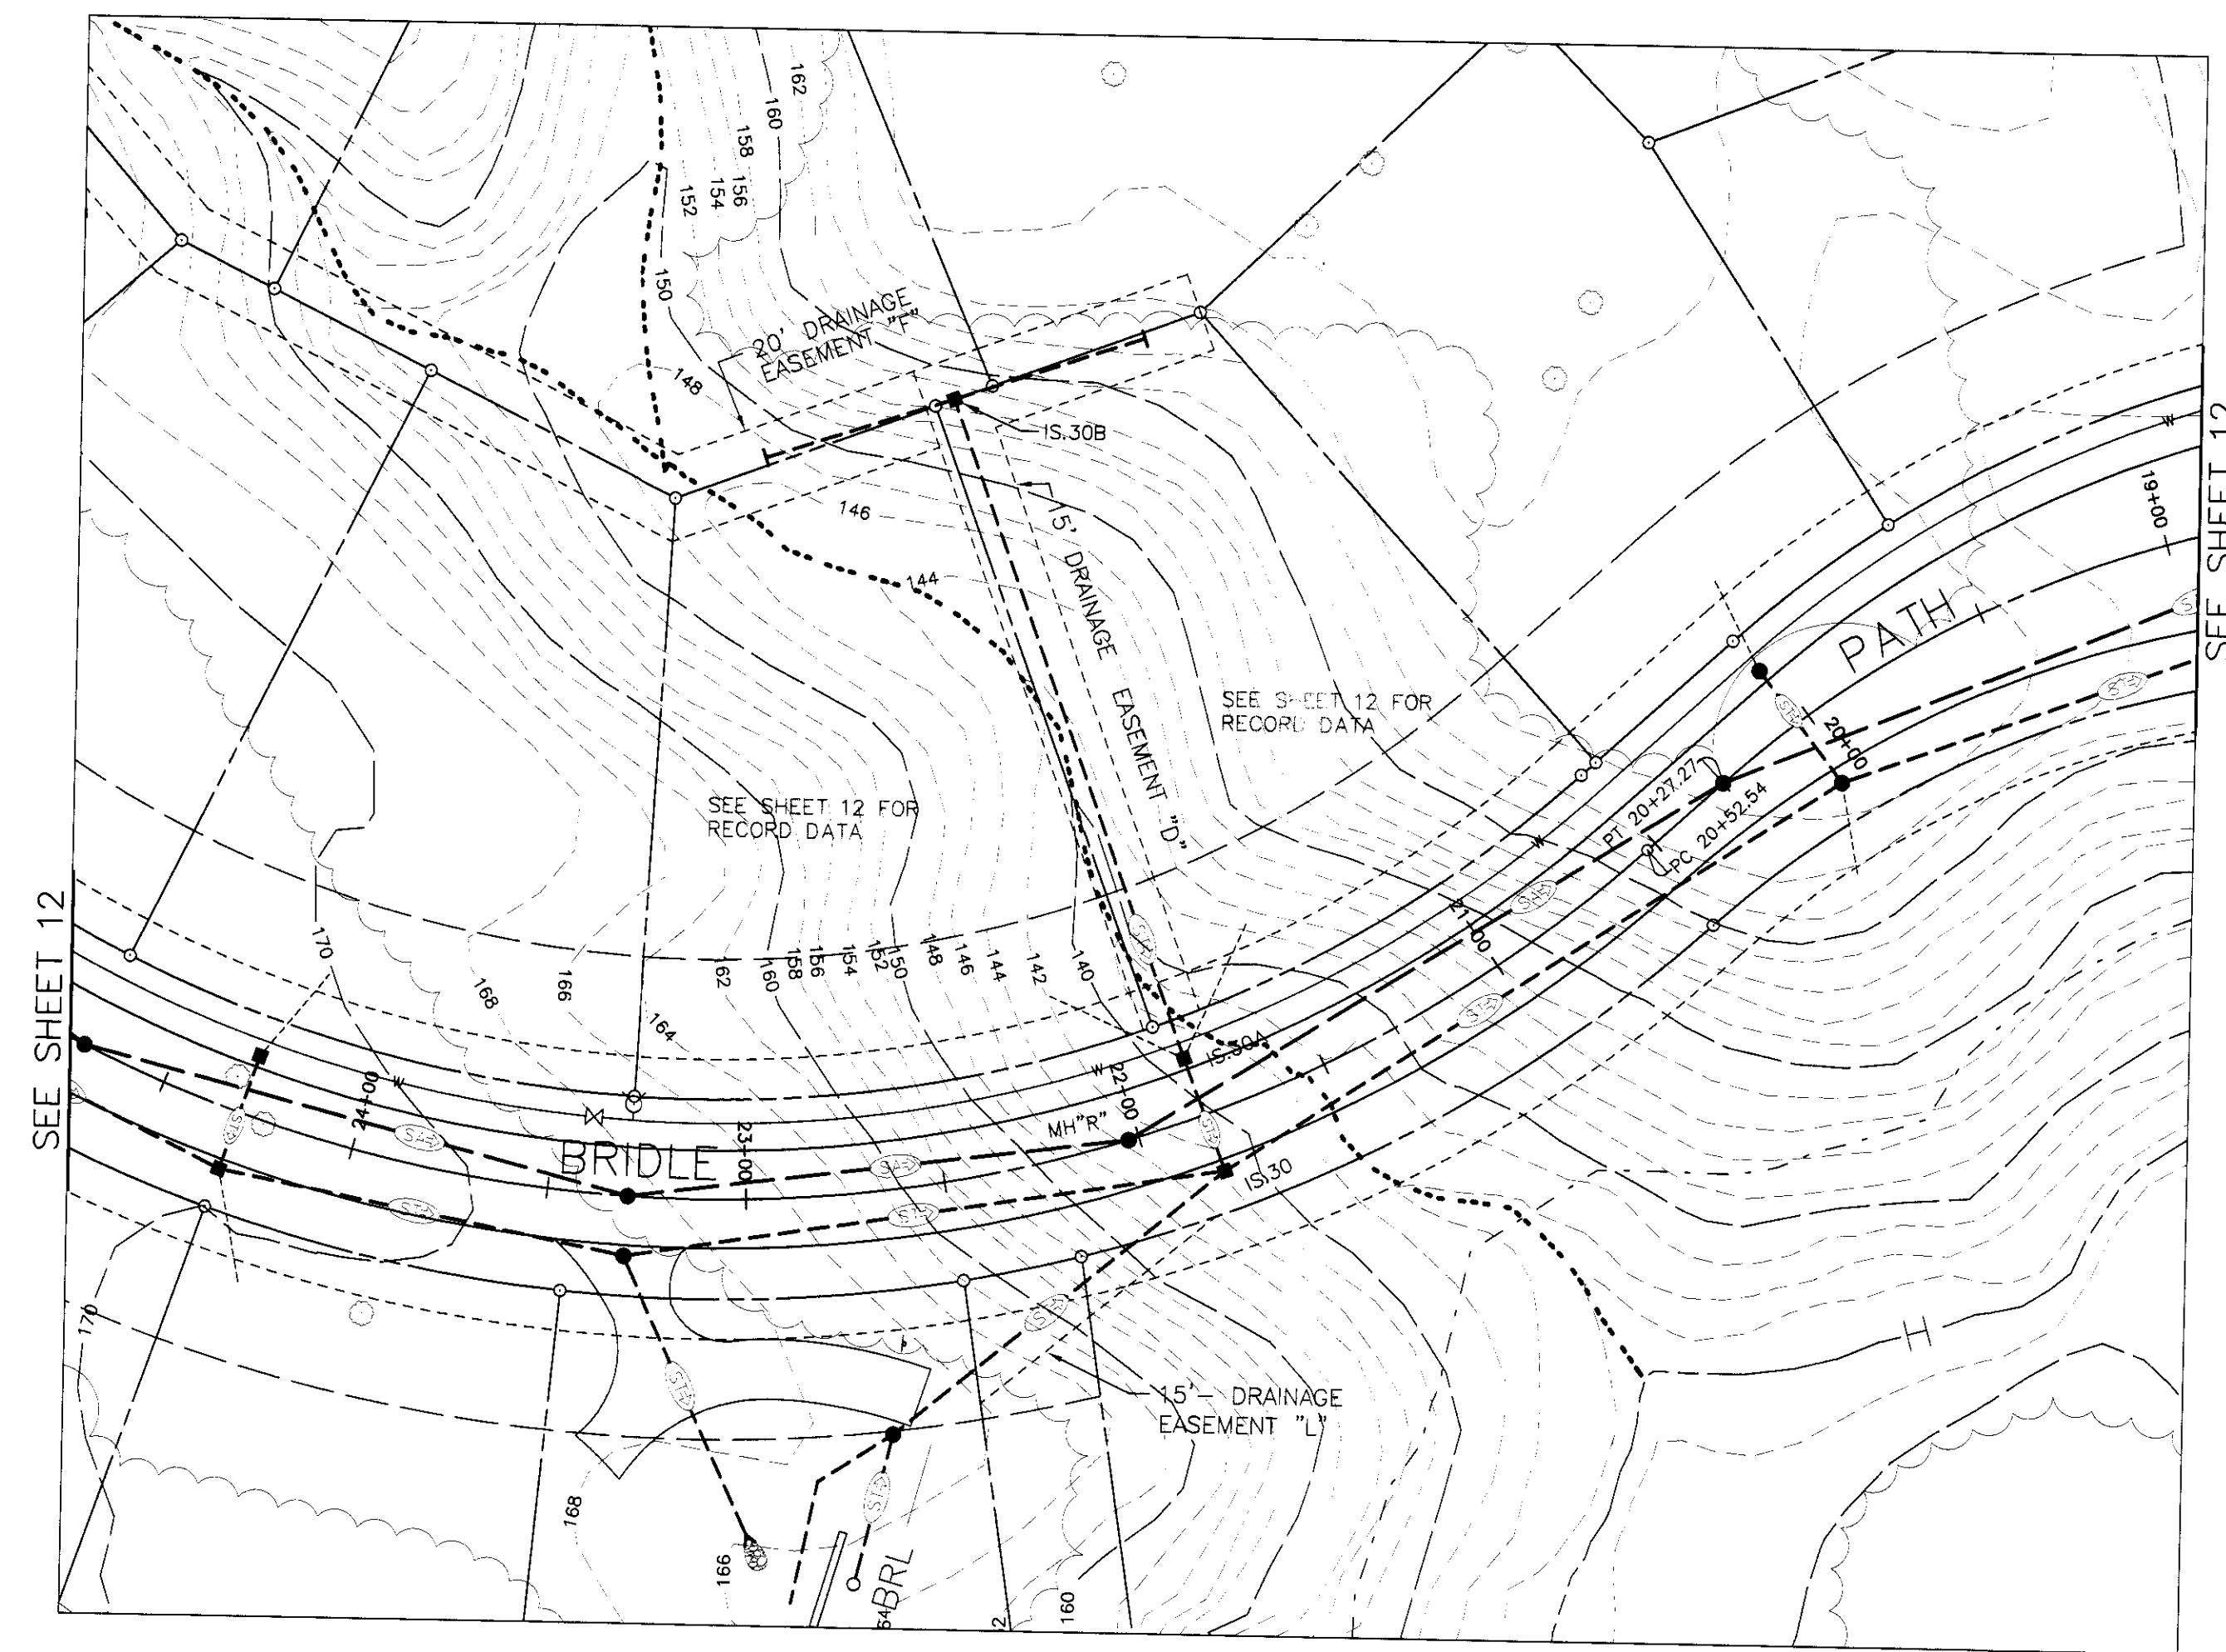

GENERAL PLAN - DRAINAGE EASEMENT "D"
SCALE: 1" = 40'

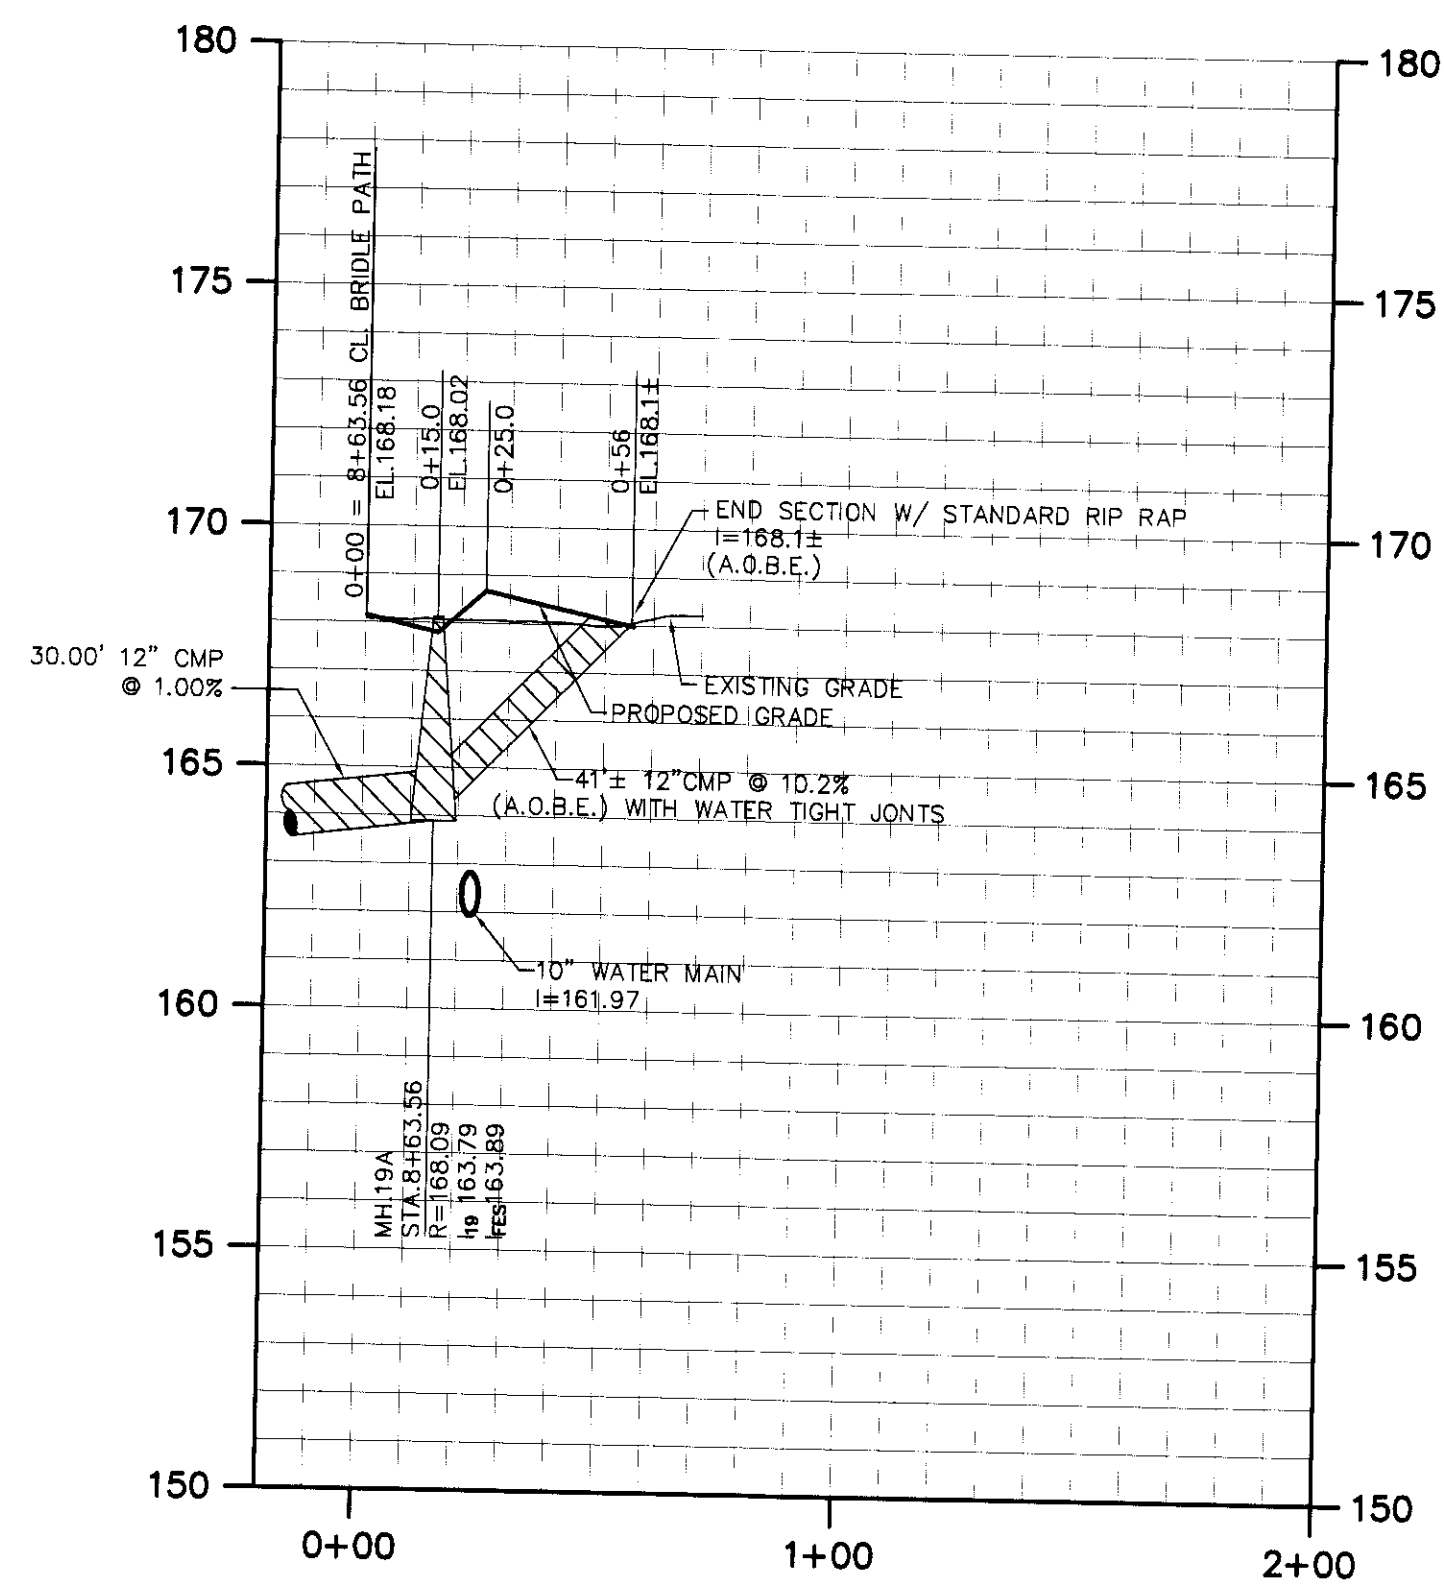

PROFILE - EASEMENT "C"
SCALE: 1"=4' VERT. / 1"=40' HORIZ.

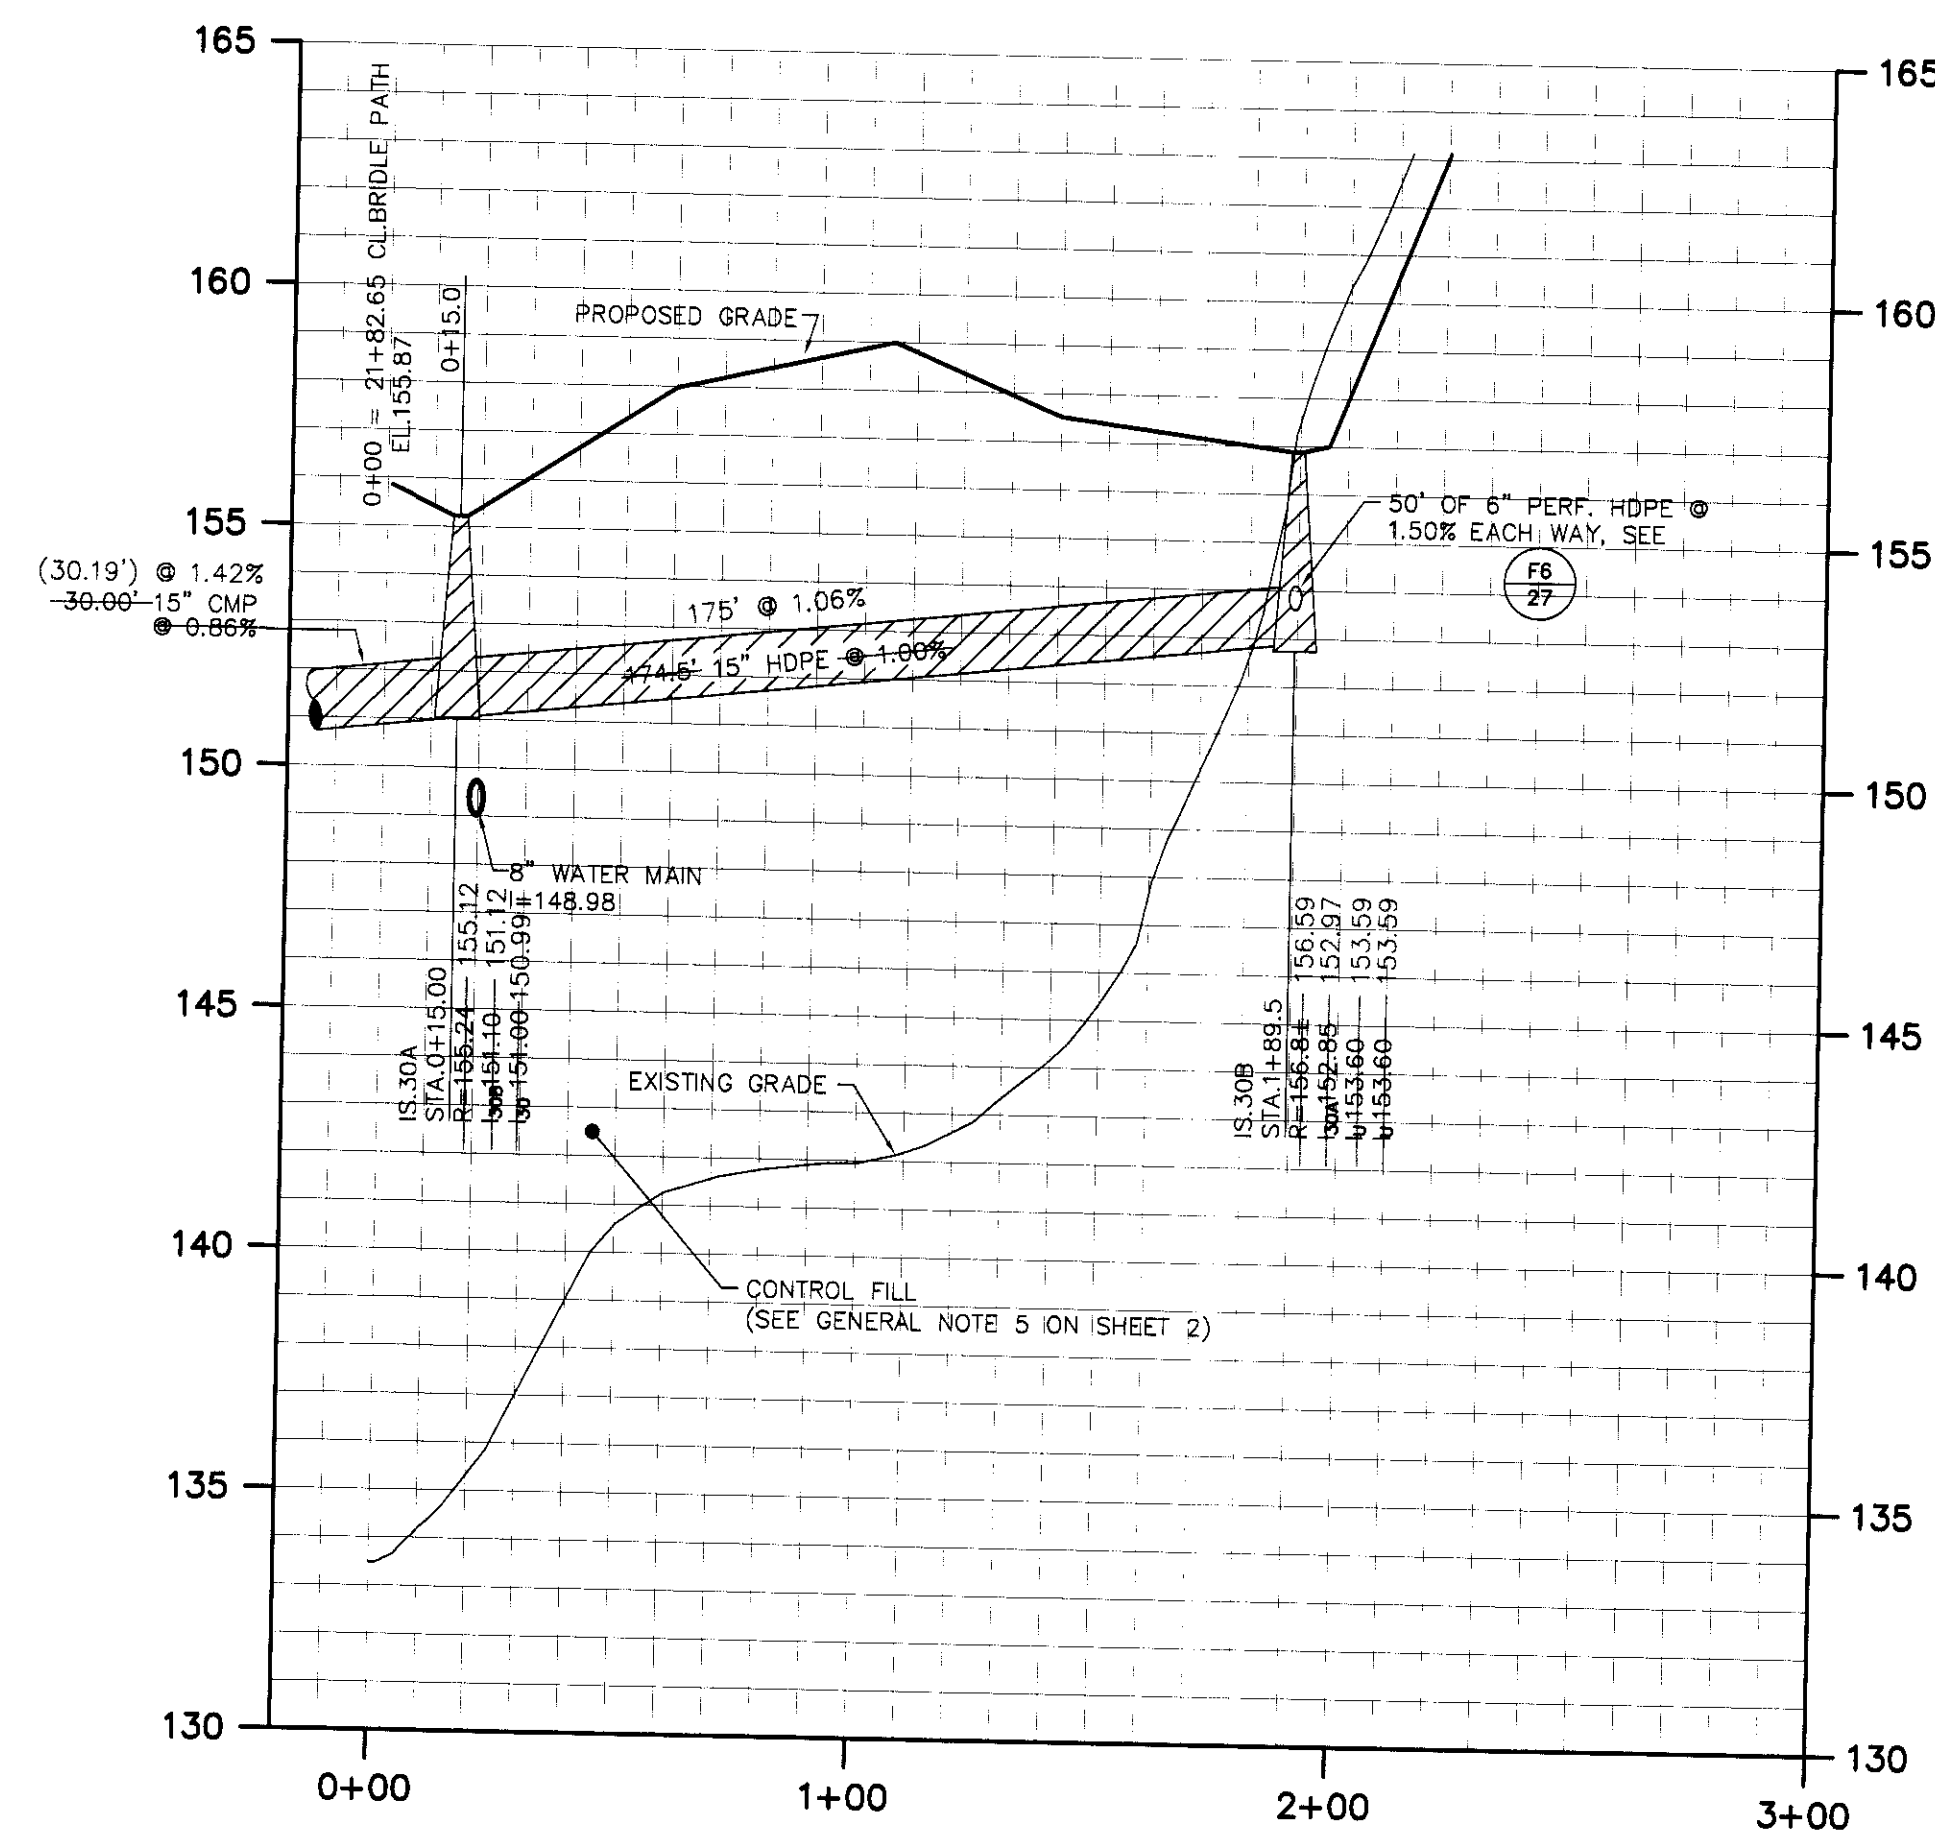

PROFILE - EASEMENT "D"
SCALE: 1"=4' VERT. / 1"=40' HORIZ.

UNAUTHORIZED ALTERATIONS OR ADDITIONS TO THIS DOCUMENT IS A VIOLATION OF SECTION 7209 SUBDIVISION 2 OF THE NEW YORK STATE EDUCATION LAW

REVISIONS

DATE	BY	DESCRIPTION	SYMBOL
6/08	CHJ	FINAL PLAN REVISIONS	△
10/08	CHJ	FINAL PLAN REVISIONS	△
5/00	CHJ	FINAL PLAN REVISIONS	△
12/00	CHJ	FINAL PLAN REVISIONS	△
1/28/01	CHJ	FINAL PLAN REVISIONS	△
5/05	CHJ	FINAL PLAN REVISIONS	△
10/04	CHJ	FINAL PLAN REVISIONS	△
5/05	CHJ	LOT LINE CHANGES	△
1/08	CHJ	MISCELLANEOUS REVISIONS	△
3/08	CHJ	MISCELLANEOUS REVISIONS	△
4/08	CHJ	MISCELLANEOUS REVISIONS	△

EDWARD W. BOUTELLE AND SON
CIVIL ENGINEERS AND SURVEYORS
423 KENWOOD AVENUE
DELMAR, NEW YORK
TEL: (518) 439-9981 FAX: (518) 439-9982
A DIVISION OF J. KENNETH PRASER AND ASSOCIATES, P.C., L.L.C.

FINAL PLAN AMENDED
CARRIAGE HILL SUBDIVISION
MAP OF LANDS OF CHARLEW CONSTRUCTION CORP.

TOWN OF BETHLEHEM COUNTY OF ALBANY
STATE OF NEW YORK

SCALE: AS NOTED

RECORD DRAWING

ALL INFORMATION SHOWN IN RED ON THESE DRAWINGS REPRESENT RECORD INFORMATION OBTAINED BY THE FIELD CREWS OF C.T. MALE ASSOCIATES, P.C. DURING THE MONTH OF OCTOBER 2008.

PROJ. SURVEYOR: CHJ
DRAWN BY: TWK
ASSEMBLED BY: TWK
CHECKED BY: CHJ

PROJECT NO.: 99-020
CAD FILE NAME: 4103-020

SHEET TITLE: PLAN & PROFILE DRAINAGE EASEMENTS "C" AND "D"

