


STORMWATER BASIN NO. 3 ENLARGEMENT PLAN
SCALE: 1" = 20'

PLANTING SCHEDULE				
KEY	BOTANIC NAME	COMMON NAME	QTY	SIZE
LC	LOBELIA CARDINALIS	CARDINAL FLOWER	12	1 GALLON CONT.
PP	POTAMOGETON PECTINATUS	POND WEED	12	1 GALLON CONT.
VD	VIBURNUM DENTATUM	ARROWWOOD VIBURNUM	2	4"-5"

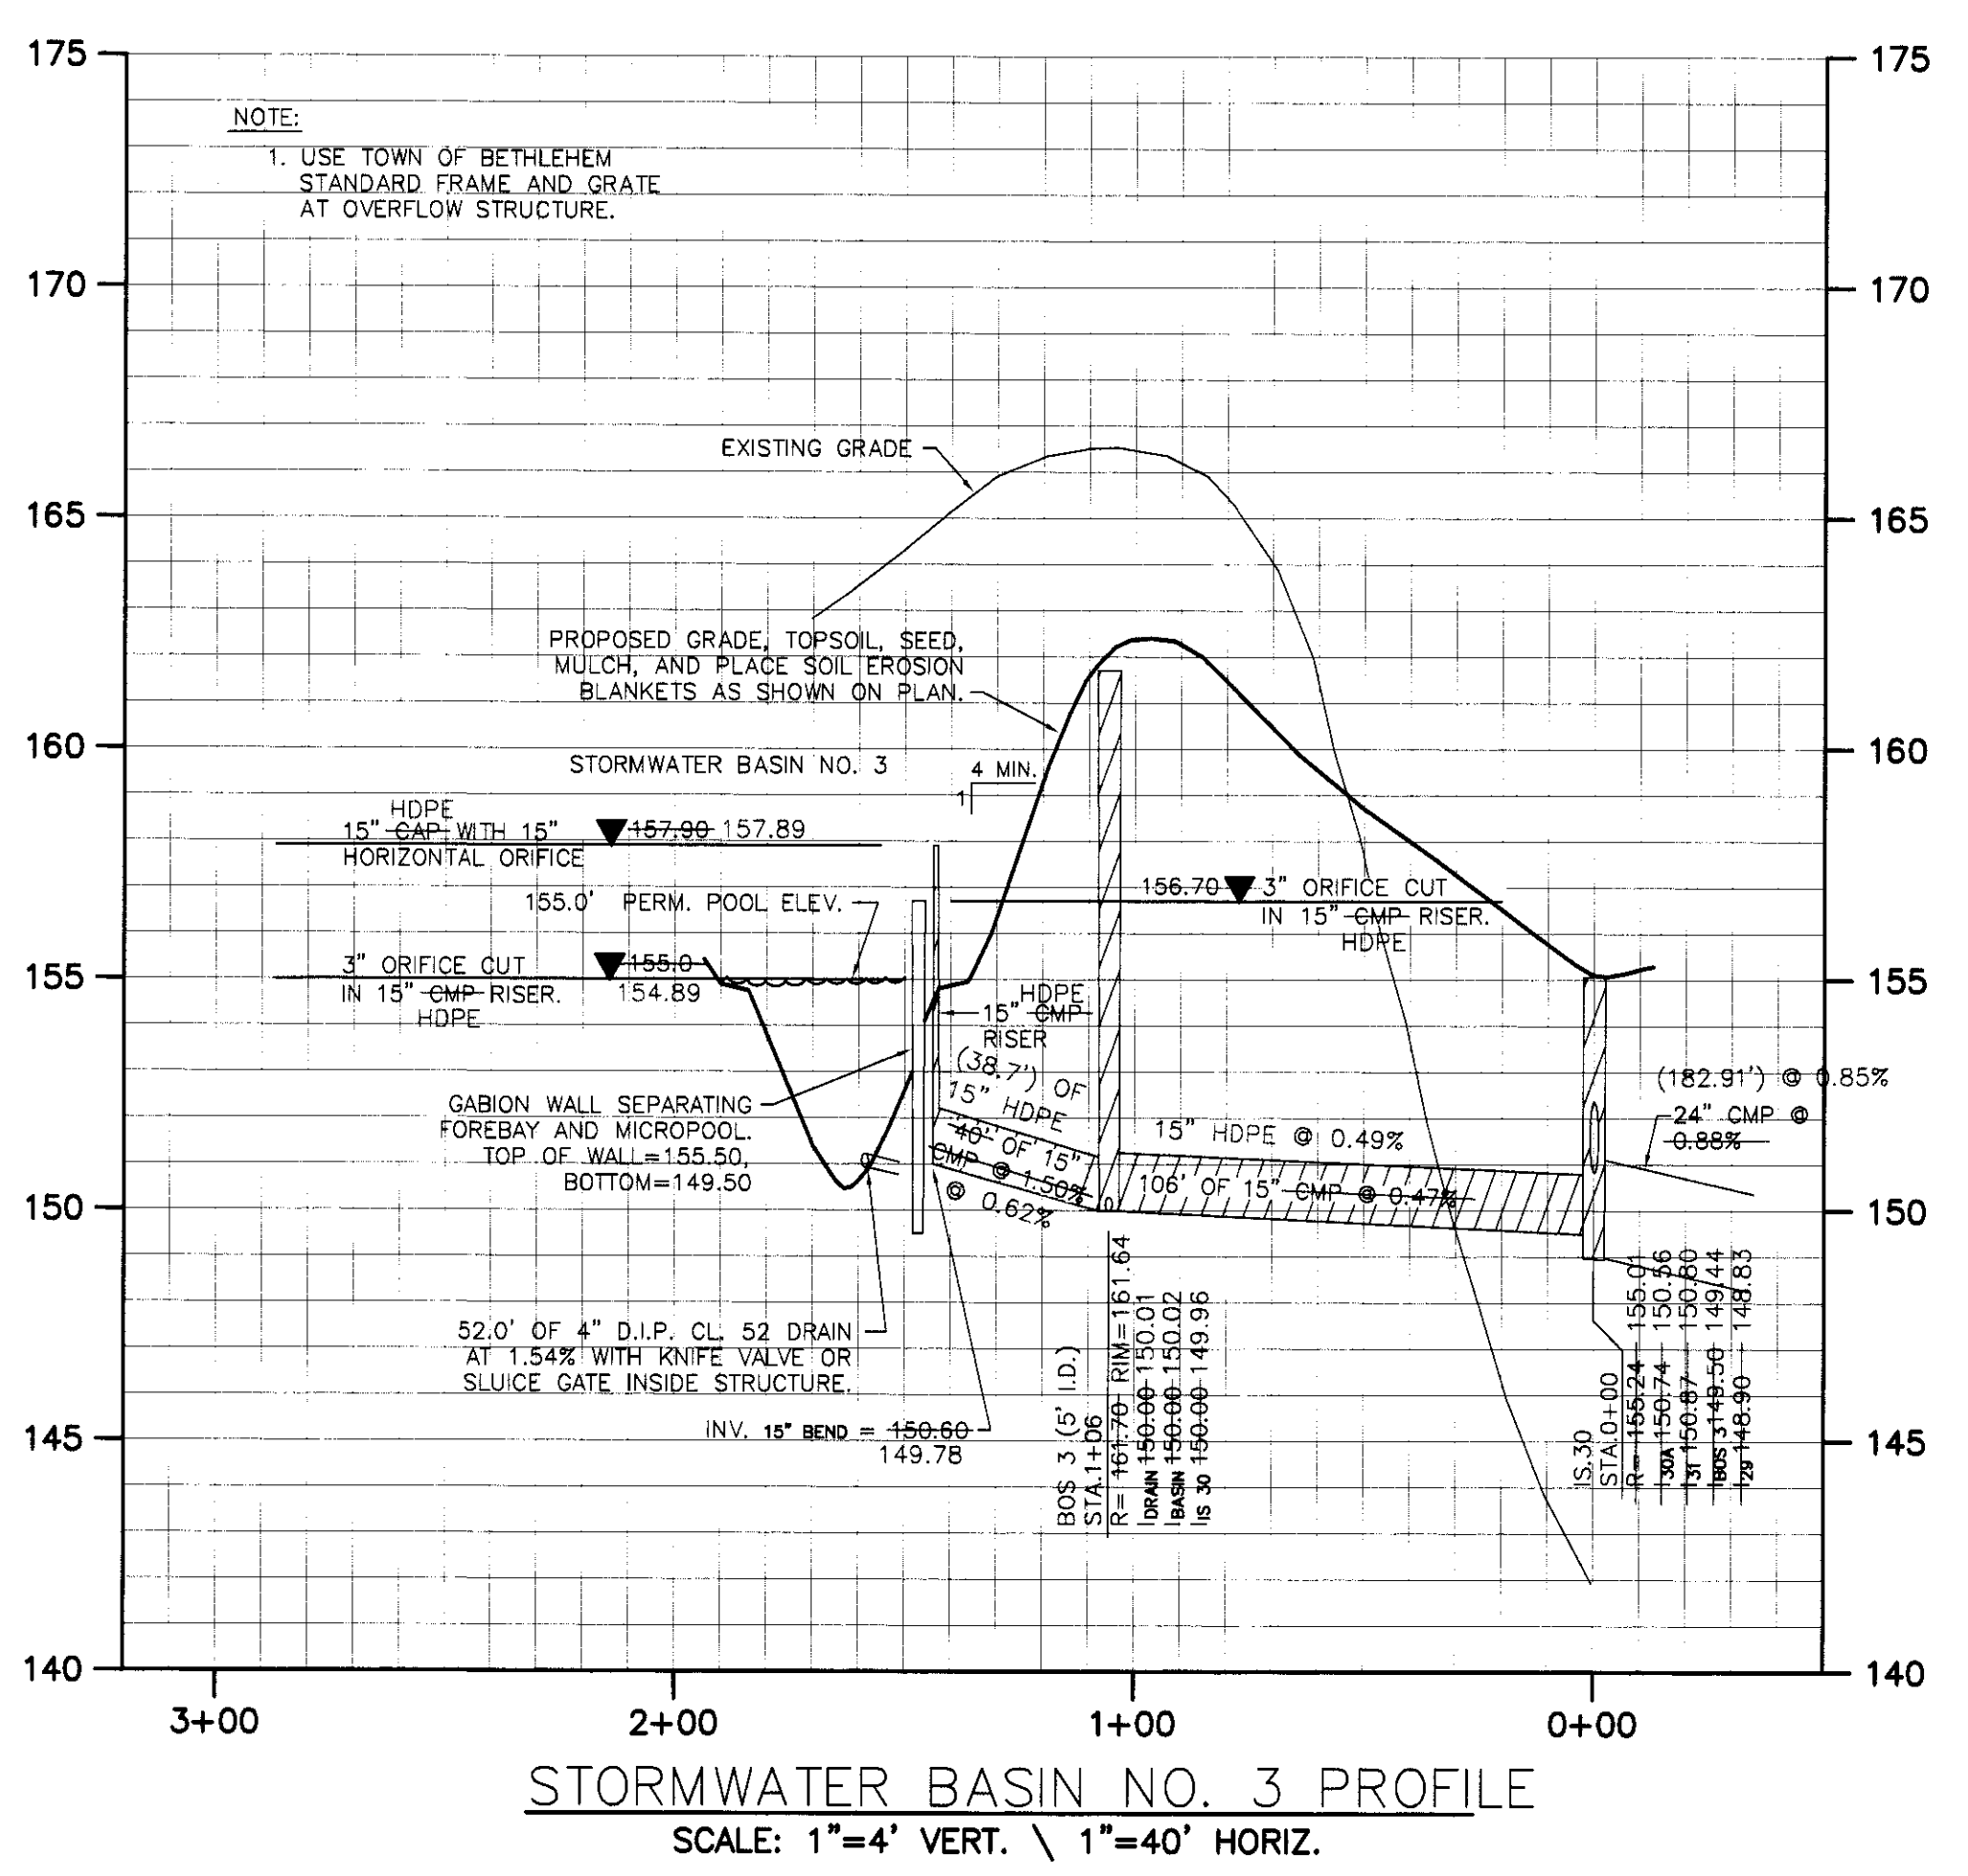

STORMWATER BASIN NO. 3 PROFILE
SCALE: 1" = 4' VERT. \ 1" = 40' HORIZ.

GENERAL NOTES

LEGEND

- PROPOSED MANHOLE
- PROPOSED INLET
- EROSION CONTROL AT CATCH BASIN
- WATER VALVE
- FIRE HYDRANT
- PROPERTY LINE
- WATER MAIN
- SEWAGE MAIN
- PROPOSED END SECTION
- SEWER DISTRICT
- WATER DISTRICT
- ZONING DISTRICT
- LIMIT OF 100 YEAR FLOOD PLAN
- 1% SLOPE LINE-SEE NOTE 22
- TEMPORARY MAINT.
- SEEDING CONTROL DNE
- MULCH WATTLE
- SEED FENCE
- PROPOSED FINISHED FLOOR GARAGE
- PROPOSED INLET WITH FOOTING DRAIN
- EROSION CONTROL WITH FOOTING DRAIN
- FENCING
- EASEMENT LINE
- SETBACK LINE
- STREAM
- TREE LINE
- CLEARING LIMIT
- CONTOUR (PRO)
- CONTOUR LINE
- SPOT ELEVATION
- TREE (DECIDUOUS)
- LOT NUMBER
- SUBCATCHMENT
- PRESERVED FEDERAL WETLANDS
- APPROXIMATE LOCATION BUILDING ENVELOPE
- TEMPORARY REPAIR/OUTLET SEDIMENT TRAP
- CHECK DAM
- EXISTING WETLAND BOUNDARY

NOTE:

THE SWPPP, "CONSTRUCTION PHASE OPERATION AND MAINTENANCE MANUAL" AND THE "POST CONSTRUCTION PHASE OPERATION AND MAINTENANCE MANUAL" INDICATE THAT THE DEVELOPER IS RESPONSIBLE FOR INSPECTION AND MAINTENANCE OF THE STORMWATER SYSTEM UNTIL THE TOWN HAS AGREED TO TAKE OVER THE SYSTEM, WHICH WILL OCCUR AT A MINIMUM OF 1 YEAR AFTER FULL-BUILDOUT OF THE HOMES WITHIN THE SUBDIVISION IS ACHIEVED. THE DEVELOPER SHALL SUPPLY A MAINTENANCE BOND TO THE TOWN DURING THIS PERIOD. THE STORMWATER BASINS SHALL BE CONVEYED TO THE TOWN, ALONG WITH THE ROAD RIGHTS-OF-WAY, BEFORE A BUILDING PERMIT IS ISSUED.

UNAUTHORIZED ALTERATIONS OR ADDITIONS TO THIS DOCUMENT IS A VIOLATION OF SECTION 7209 SUBDIVISION 2 OF THE NEW YORK STATE EDUCATION LAW

REVISIONS

DATE	BY	DESCRIPTION	SYMBOL
6/99	CHJ	FINAL PLAN REVISIONS	△
10/99	CHJ	FINAL PLAN REVISIONS	△
5/00	CHJ	FINAL PLAN REVISIONS	△
12/00	CHJ	FINAL PLAN REVISIONS	△
1/25/01	CHJ	FINAL PLAN REVISIONS	△
10/04	CHJ	ADDED NEW SHEET	△
12/05/04	BOG	ADDED ASHATIC BENCH PER NYSDOC	△
1/06	BOG	MISCELLANEOUS	△
3/06	CHJ	MISCELLANEOUS	△
4/06	CHJ	MISCELLANEOUS REVISIONS	△
6/06	BOG	REVISED PER DEC COMMENTS	△
8/28/06	CHJ	REVISED PER TOWN COMMENTS	△

EDWARD W. BOUTELLI AND SON
CIVIL ENGINEERS AND SURVEYORS
423 KENWOOD AVENUE
DELMAR, NEW YORK
TEL. (518) 439-9981 FAX. (518) 439-9982
A DIVISION OF J. KENNETH FRASER AND ASSOCIATES, P.E., L.S., L.A., P.C.

FINAL PLAN AMENDED
CARRIAGE HILL SUBDIVISION
MAP OF LANDS OF CHARLEW CONSTRUCTION CORP.

TOWN OF BETHELEHEM COUNTY OF ALBANY STATE OF NEW YORK

SCALE: 1" = 20'

RECORD DRAWING

ALL INFORMATION SHOWN IN RED ON THESE DRAWINGS REPRESENT RECORD INFORMATION OBTAINED BY THE FIELD CREWS OF C.T. MALE ASSOCIATES, P.C. ON AUGUST 4, 2007 AND OCTOBER 2008.

PROJ. SURVEYOR: CHJ
DRAWN BY: TWK
ASSEMBLED BY: TWK
CHECKED BY: CHJ

PROJECT NO.: 99-020
CAD FILE NAME: 4103-03C

SHEET TITLE: PARTIAL PLAN AND PROFILE STORMWATER BASIN 3

DATE: NOVEMBER 1995 SHEET 30 OF 31

