



- MAP REFERENCES:**
- 1) MAP ENTITLED "THE PINES AT NORMANSIDE - LEONARD PLACE - FINAL SUBDIVISION PLAN" AS PREPARED BY BERENSON MANNING ENGINEERS LLP ON NOVEMBER 7, 2011 AND LAST REVISED ON JUNE 6, 2012.
- NOTES:**
- 1) SURVEY PREPARED BY GERALD R GRAY, P.L.S. FROM A JUNE 2014 FIELD SURVEY.
  - 2) NORTH IS BASED ON MAP REFERENCE 1. ELEVATION DATUM IS NAD83 1929 PER MAP REFERENCE 1.
  - 3) SUBJECT TO ALL RIGHTS, EASEMENTS, COVENANTS OR RESTRICTIONS RECORDED OR UNRECORDED.
  - 4) UNDERGROUND UTILITIES IF SHOWN HEREON ARE BASED ON VISIBLE PHYSICAL EVIDENCE. THEY SHOULD BE CONSIDERED SCHEMATIC ONLY AND ARE SHOWN REGARDLESS OF WHETHER CONNECTIONS EXIST. THERE IS NO CERTIFICATION AS TO THE ACCURACY OF THE UNDERGROUND UTILITY LOCATIONS AND OTHER UTILITIES MAY EXIST THAT ARE NOT SHOWN ON THIS MAP. CALL DIGSAFE FOR FURTHER VERIFICATION.
  - 5) SURVEY IS PREPARED IN ACCORDANCE WITH THE NEW YORK STATE ASSOCIATION OF PROFESSIONAL LAND SURVEYORS CODE OF PRACTICE FOR LAND SURVEYS AS ADOPTED IN OCTOBER OF 1966 AND LAST REVISED ON JULY 18, 1997.
  - 6) ORIGINAL WATERLINE ALONG LEONARD PLACE TO BE ABANDONED IN PLACE.

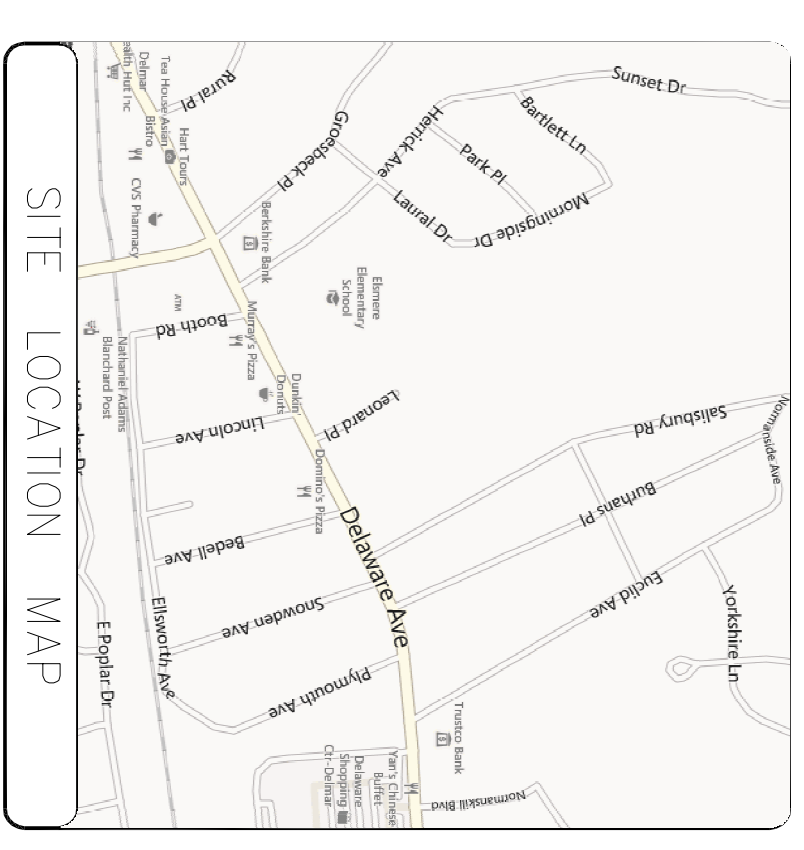

**Gerald R Gray, PLS**  
Licensed Land Surveyor  
Latham, New York 518 - 312 - 1335  
COPYRIGHT © 2014

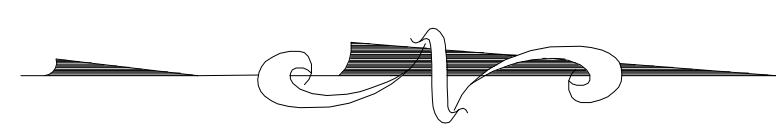

No.	Submitted/Revision	App'd	Date
Drawn:	GRG	Date:	12/31/14
Designed:	GRG	Date:	12/31/14
Checked:	GRG	Date:	12/31/14

Project Number: \_\_\_\_\_  
 Project Title: **The Pines at Normanside**  
 Leonard Place  
 Town of Bethlehem  
 State of New York

Prepared For:  
**Keystone Builders**

Drawing Title:  
**Record Survey Storm Sewer**

Drawing Scale:  
 1" = 40'

Date:  
 12/3/2014

Drawing Number:  
**2**