


IF THIS SHEET IS NOT 24"x36" IT IS A REDUCED PRINT - SCALE ACCORDINGLY

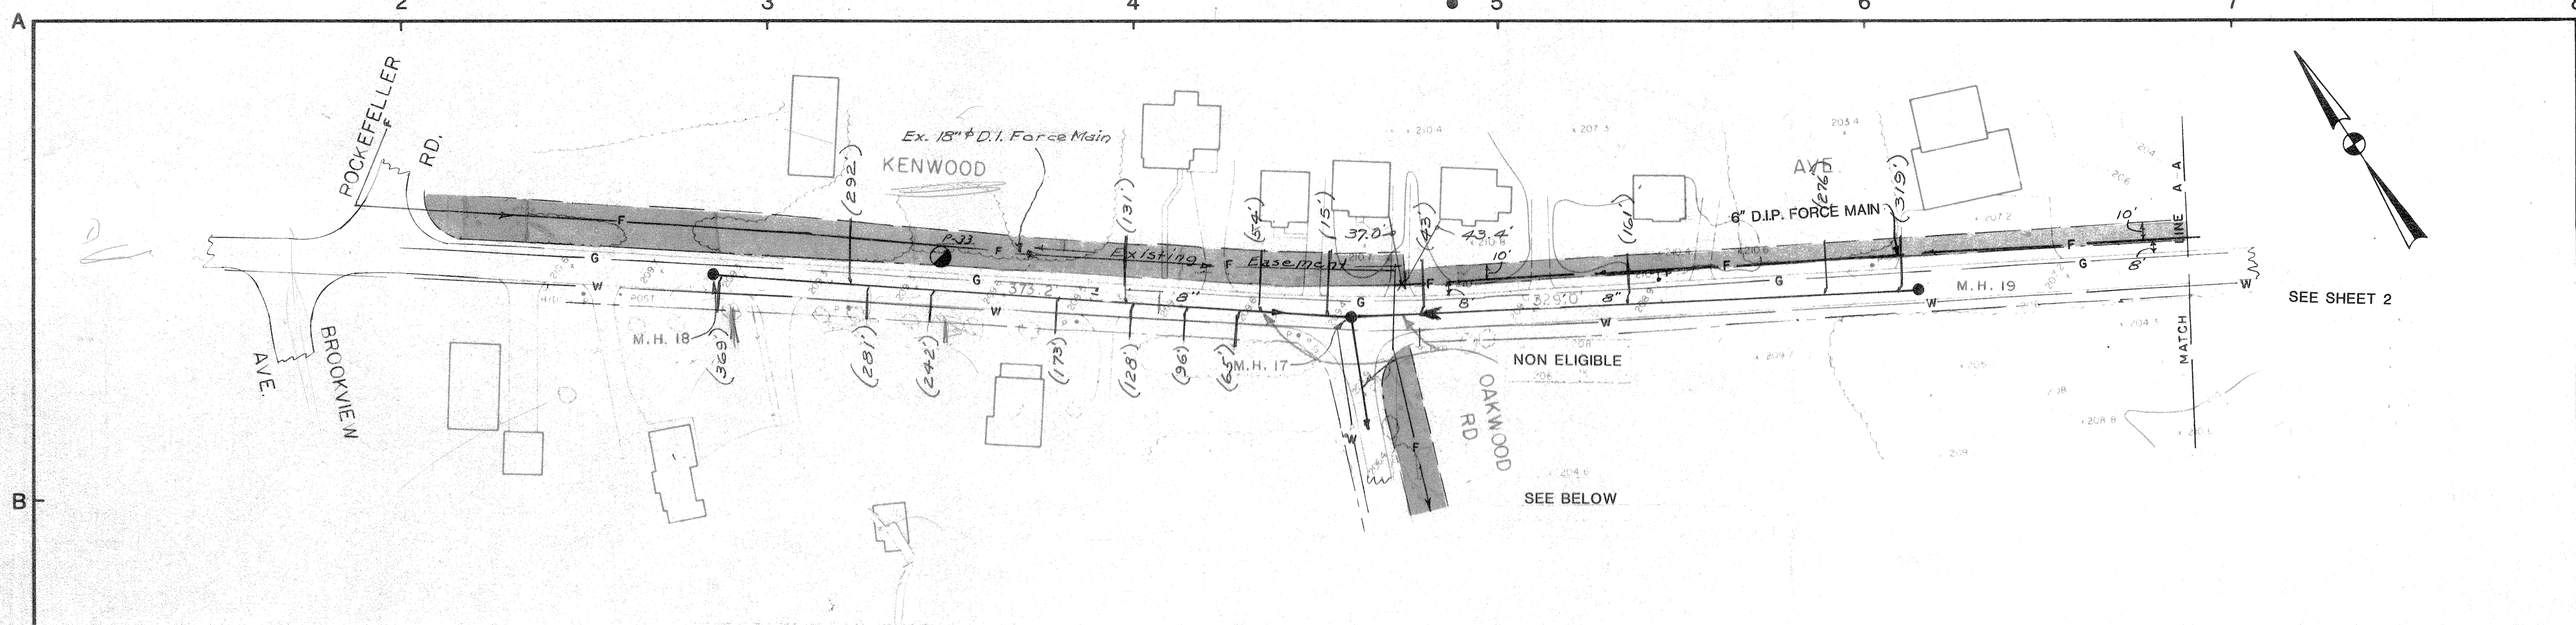


KEY PLAN

NOTES

UNAUTHORIZED ALTERATIONS OR ADDITIONS TO THIS DOCUMENT IS A VIOLATION OF SECTION 7209 SUBDIVISION 2 OF THE NEW YORK STATE EDUCATION LAW

REVISIONS

DATE	BY	DESCRIPTION	SYMBOL
11 83	E.O. R.P.		

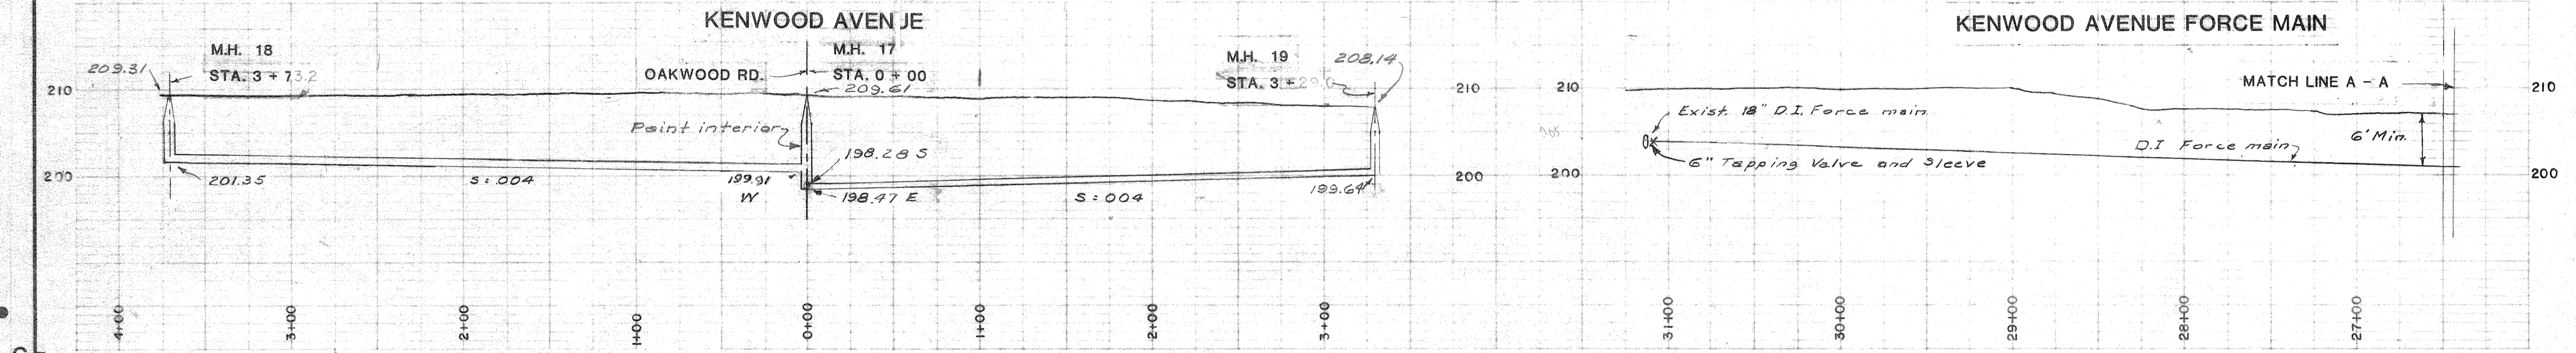

J. KENNETH FRASER AND ASSOCIATES, P.C.

CONSULTING ENGINEERS
RENSELAER, NEW YORK


BETHLEHEM SEWER DISTRICT

TOWN OF BETHLEHEM
ALBANY COUNTY NEW YORK


USEPA-NYSDEC PROJECT C-36-1096

CONTRACT NO. 2


COLLECTING SEWERS

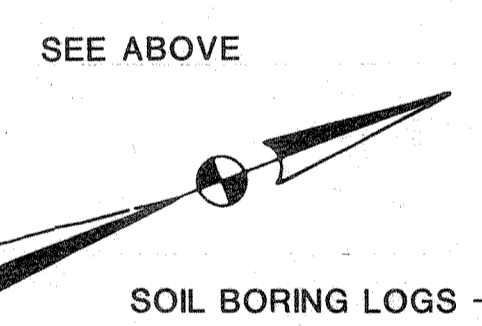

Probe #	Description	Ground Water
P-30	Brown silty fine sand 0-10'	7'
P-31	Brown silty fine sand 0-10'	5.5'
P-32	Brown silty fine sand 0-10'	5'
P-33	Brown silty fine sand 0-8' Clay 8-10'	5'

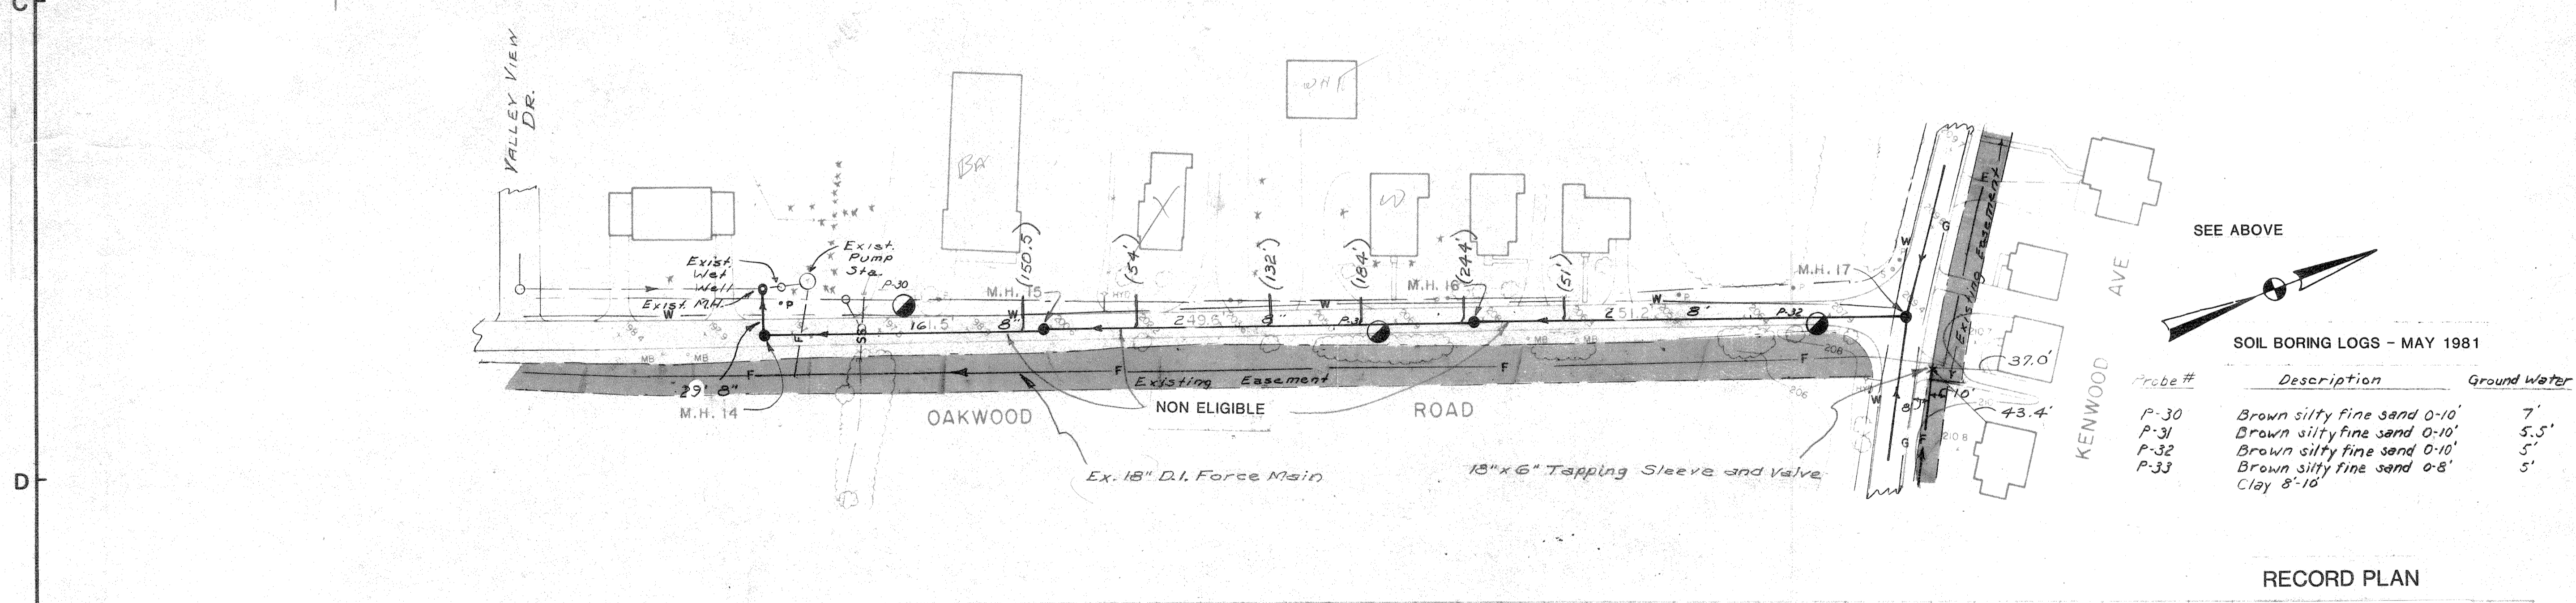

RECORD PLAN

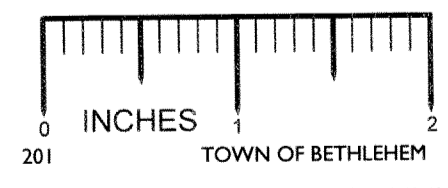

SCALE: HORIZONTAL 1" = 50'
VERTICAL 1" = 10'

PROJ. ENG'R.: W.T.B.
DRAWN BY: E.W.O.
TRACED BY: E.W.O.
CHECKED BY: W.T.B.
REF. No. 5095

SHEET TITLE:
KENWOOD AVE. - OAKWOOD RD.

DATE: JUNE 1981 SHEET 4 OF 32