

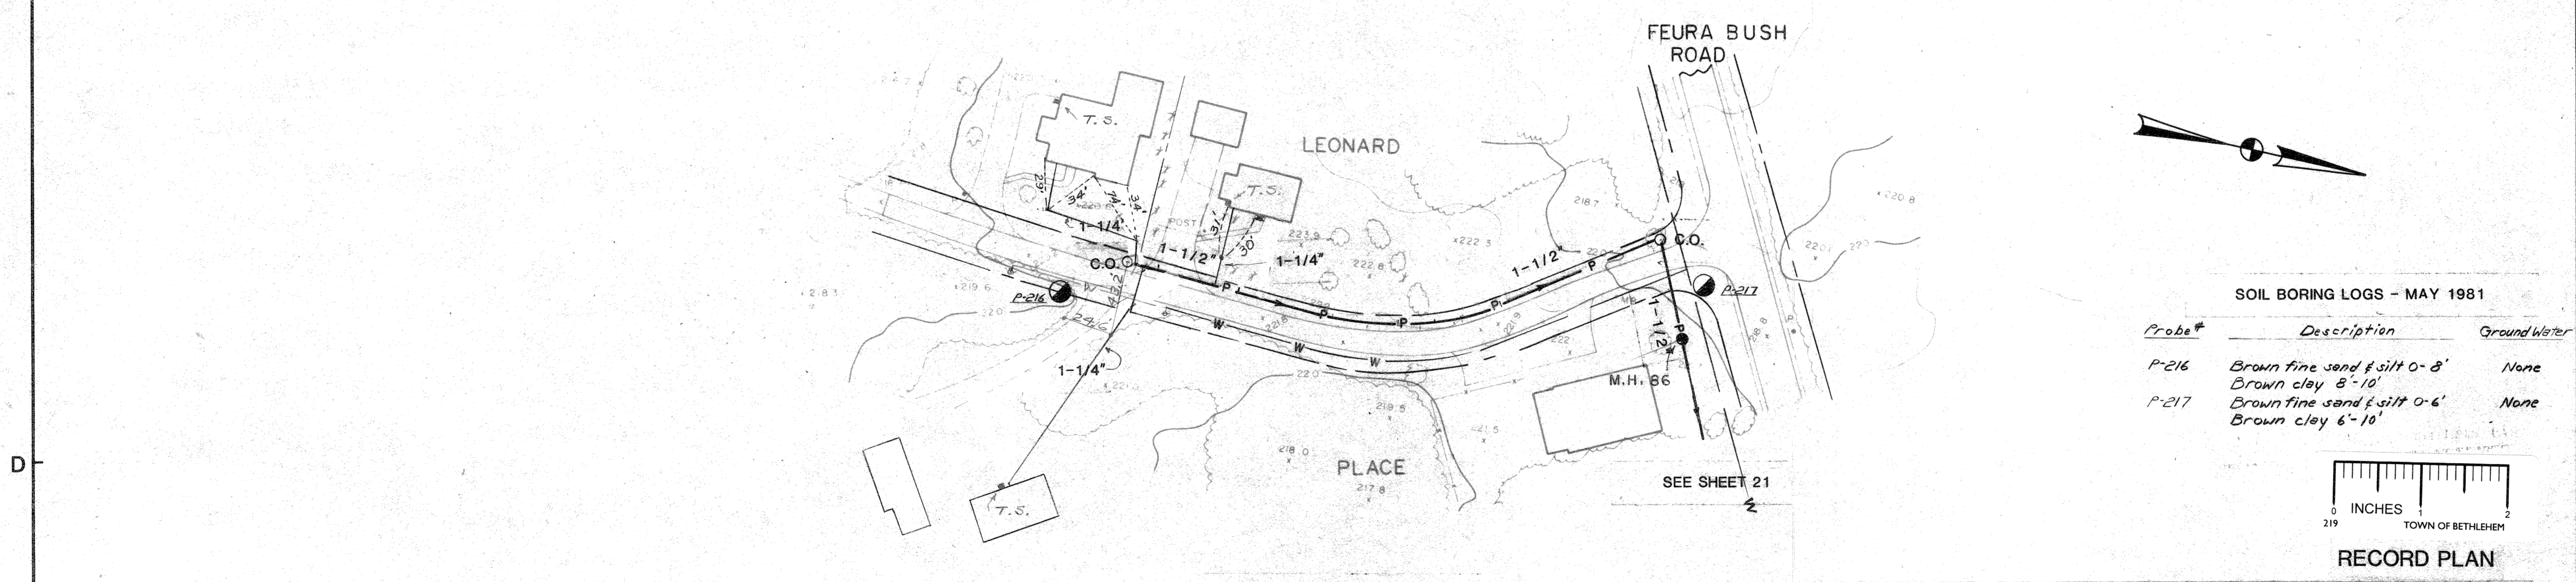
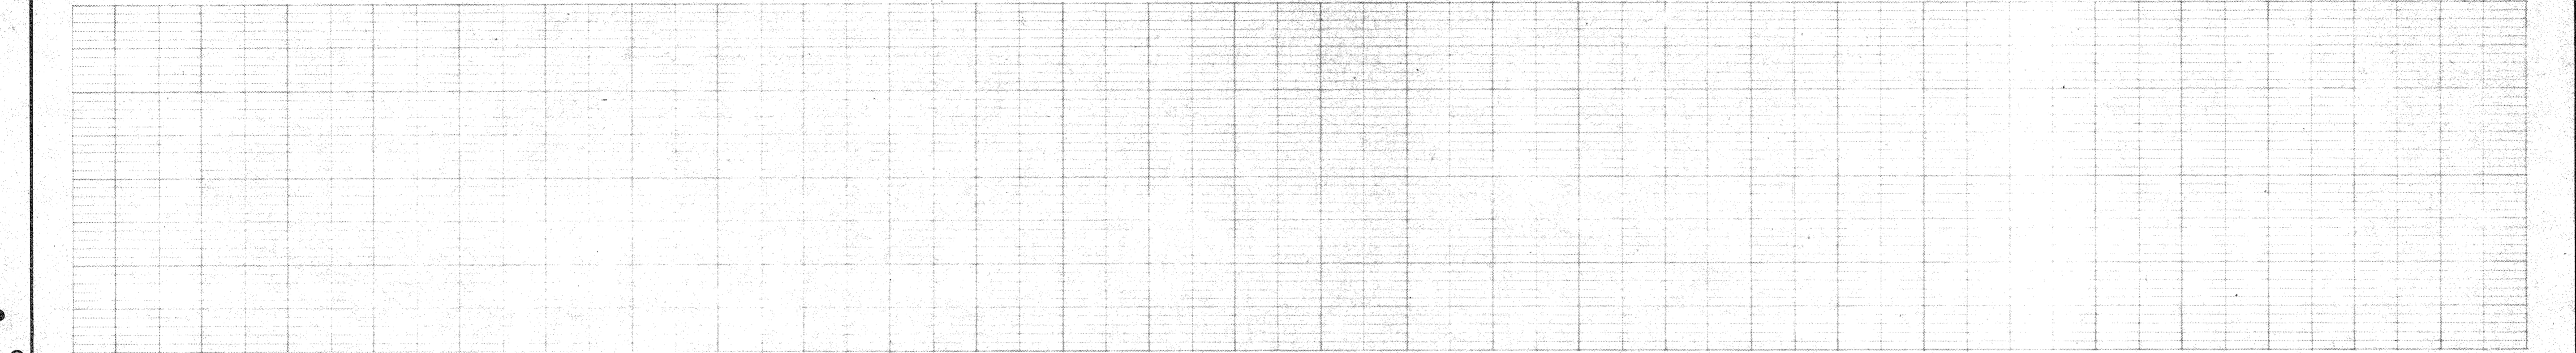


IF THIS SHEET IS NOT 24"x36" IT IS A REDUCED PRINT - SCALE ACCORDINGLY

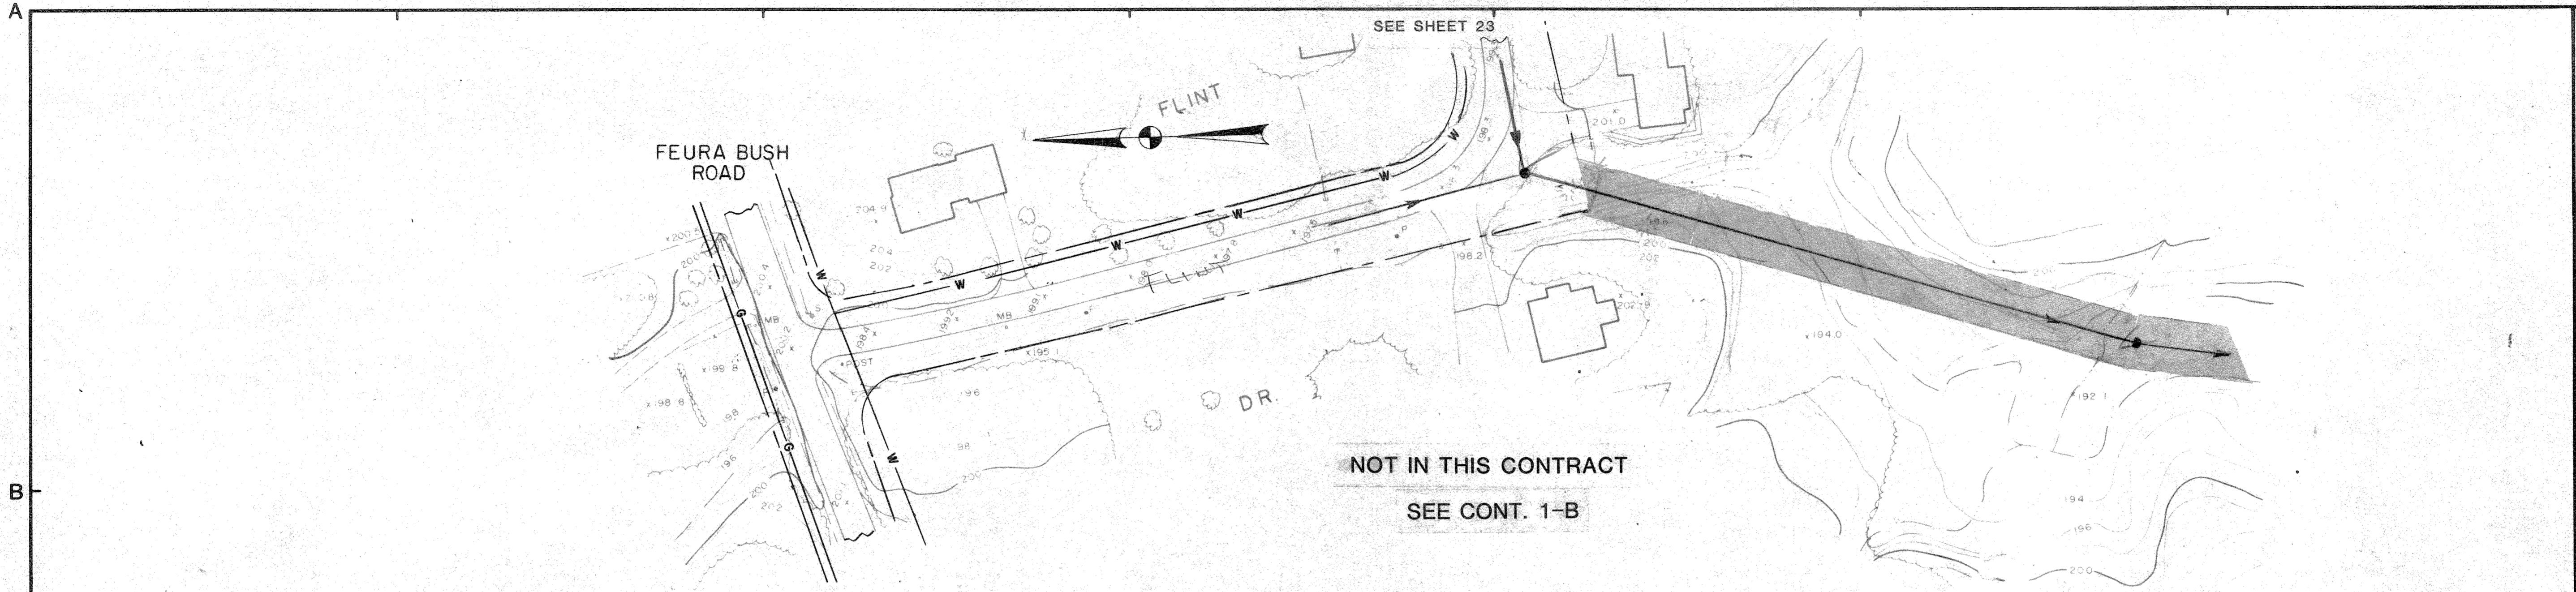


SOIL BORING LOGS - MAY 1981

Probe #	Description	Ground Water
P-216	Brown fine sand & silt 0'-8' Brown clay 8'-10'	None
P-217	Brown fine sand & silt 0'-6' Brown clay 6'-10'	None

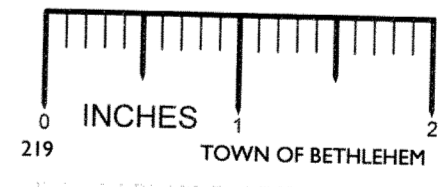

RECORD PLAN

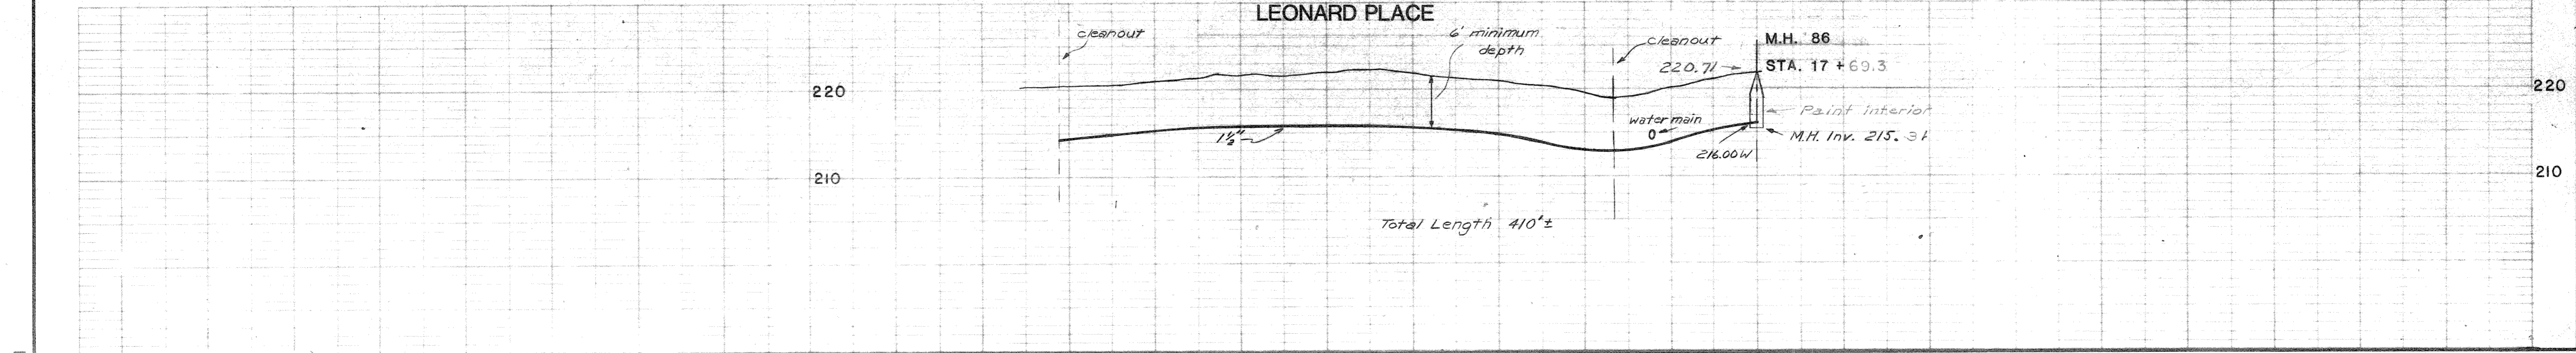

KEY PLAN

NOTES

UNAUTHORIZED ALTERATIONS OR ADDITIONS TO THIS DOCUMENT IS A VIOLATION OF SECTION 7209 SUBDIVISION 2 OF THE NEW YORK STATE EDUCATION LAW

REVISIONS			
DATE	BY	DESCRIPTION	SYMBOL
11/83	E.O. R.P.		

**J. KENNETH FRASER AND ASSOCIATES, P.C.**  
CONSULTING ENGINEERS  
RENSELAER, NEW YORK

**BETHLEHEM SEWER DISTRICT**  
TOWN OF BETHLEHEM  
ALBANY COUNTY NEW YORK

USEPA-NYSDEC PROJECT C-36-1096

**CONTRACT NO. 2**  
**COLLECTING SEWERS**

SCALE: HORIZONTAL 1" = 50'  
VERTICAL 1" = 10'

	PROJ. ENG'R.: W.T.B.
	DRAWN BY: G.L.M.
	TRACED BY: G.L.M.
	CHECKED BY: W.T.B.

REF. No. 5113

SHEET TITLE: **LEONARD PLACE**

DATE: JUNE 1981      SHEET 22 OF 32