


IF THIS SHEET IS NOT 24"x36" IT IS A REDUCED PRINT - SCALE ACCORDINGLY

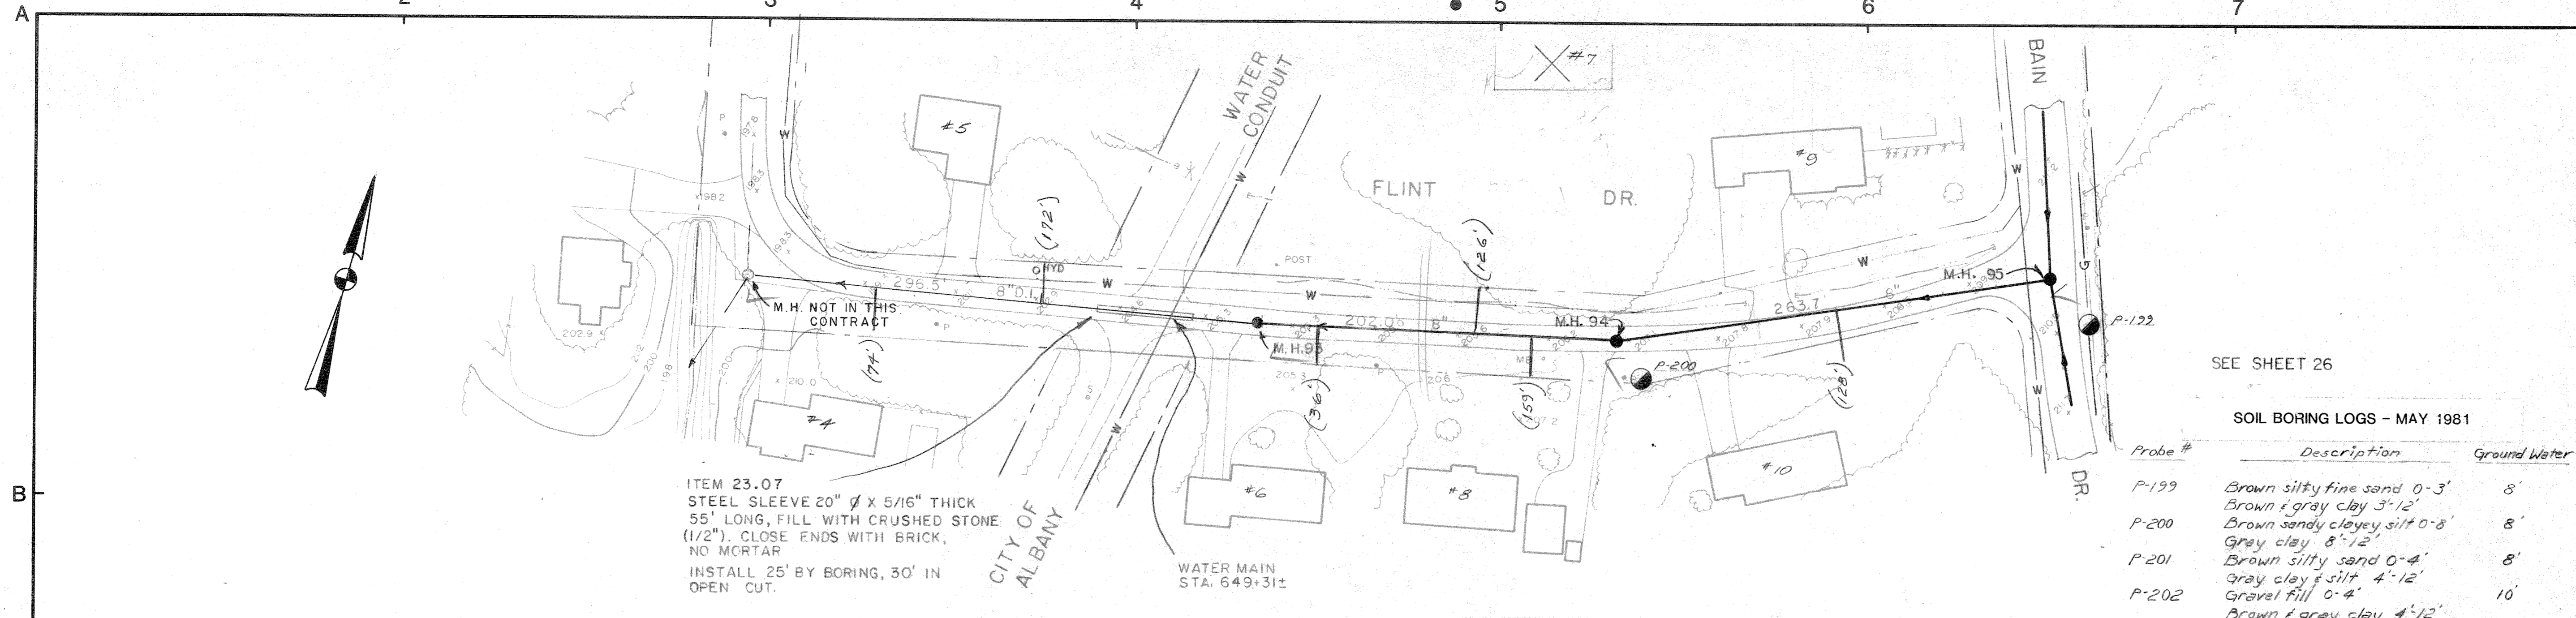

KEY PLAN


NOTES
PRESSURE SEWERS TO BE CONSTRUCTED OF P.V.C. PIPE SDR-26 WITH SOLVENT WELD JOINTS.

SEE SHEET 26

SOIL BORING LOGS - MAY 1981

Probe #	Description	Ground Water
P-199	Brown silty fine sand 0'-3'	8'
	Brown & gray clay 3'-12'	
P-200	Brown sandy clayey silt 0'-8'	8'
	Gray clay 8'-12'	
P-201	Brown silty sand 0'-4'	8'
	Gray clay & silt 4'-12'	
P-202	Gravel fill 0'-4'	10'
	Brown & gray clay 4'-12'	

ITEM 23.07
STEEL SLEEVE 20" Ø X 5/16" THICK
55' LONG, FILL WITH CRUSHED STONE
(1/2"). CLOSE ENDS WITH BRICK,
NO MORTAR
INSTALL 25' BY BORING, 30' IN
OPEN CUT.

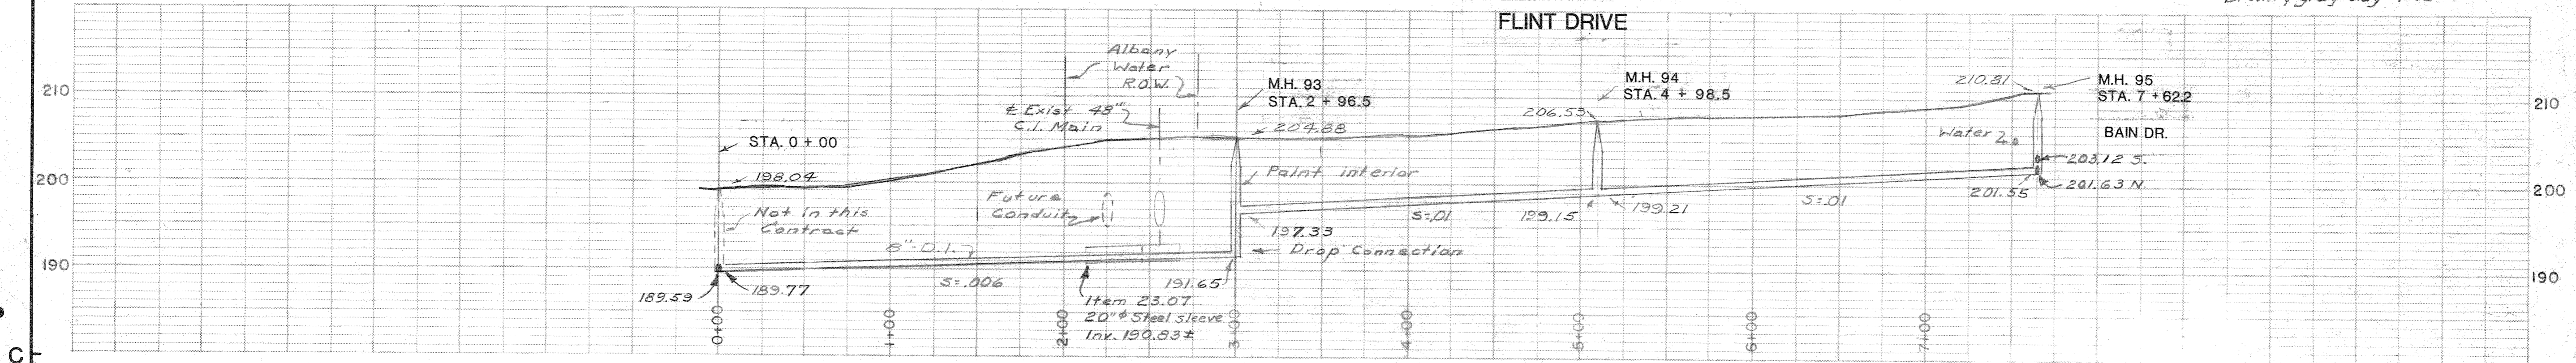

UNAUTHORIZED ALTERATIONS OR ADDITIONS TO THIS DOCUMENT IS A VIOLATION OF SECTION 7209 SUBDIVISION 2 OF THE NEW YORK STATE EDUCATION LAW

REVISIONS

DATE	BY	DESCRIPTION	SYMBOL
9/81	E.O.	SEWER ROUTE CHANGED & 4 GRINDER PUMPS ADDED.	
11/88	E.O.	R.P.	

J. KENNETH FRASER AND ASSOCIATES, P.C.

CONSULTING ENGINEERS
RENSELAER, NEW YORK

BETHLEHEM SEWER DISTRICT
TOWN OF BETHLEHEM
ALBANY COUNTY NEW YORK

USEPA-NYSDEC PROJECT C-36-1096



CONTRACT NO. 2
COLLECTING SEWERS

SCALE: HORIZONTAL 1" = 50'
VERTICAL 1" = 10'

PROJ. ENG'R.: W.T.B.
DRAWN BY: W.T.B.
TRACED BY: J.F.B.
CHECKED BY: W.T.B.
REF. No. 5114

SHEET TITLE:
FLINT DR. & BOYLSTON DR.

DATE: JUNE 1981 SHEET 23 OF 32

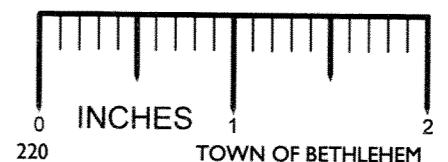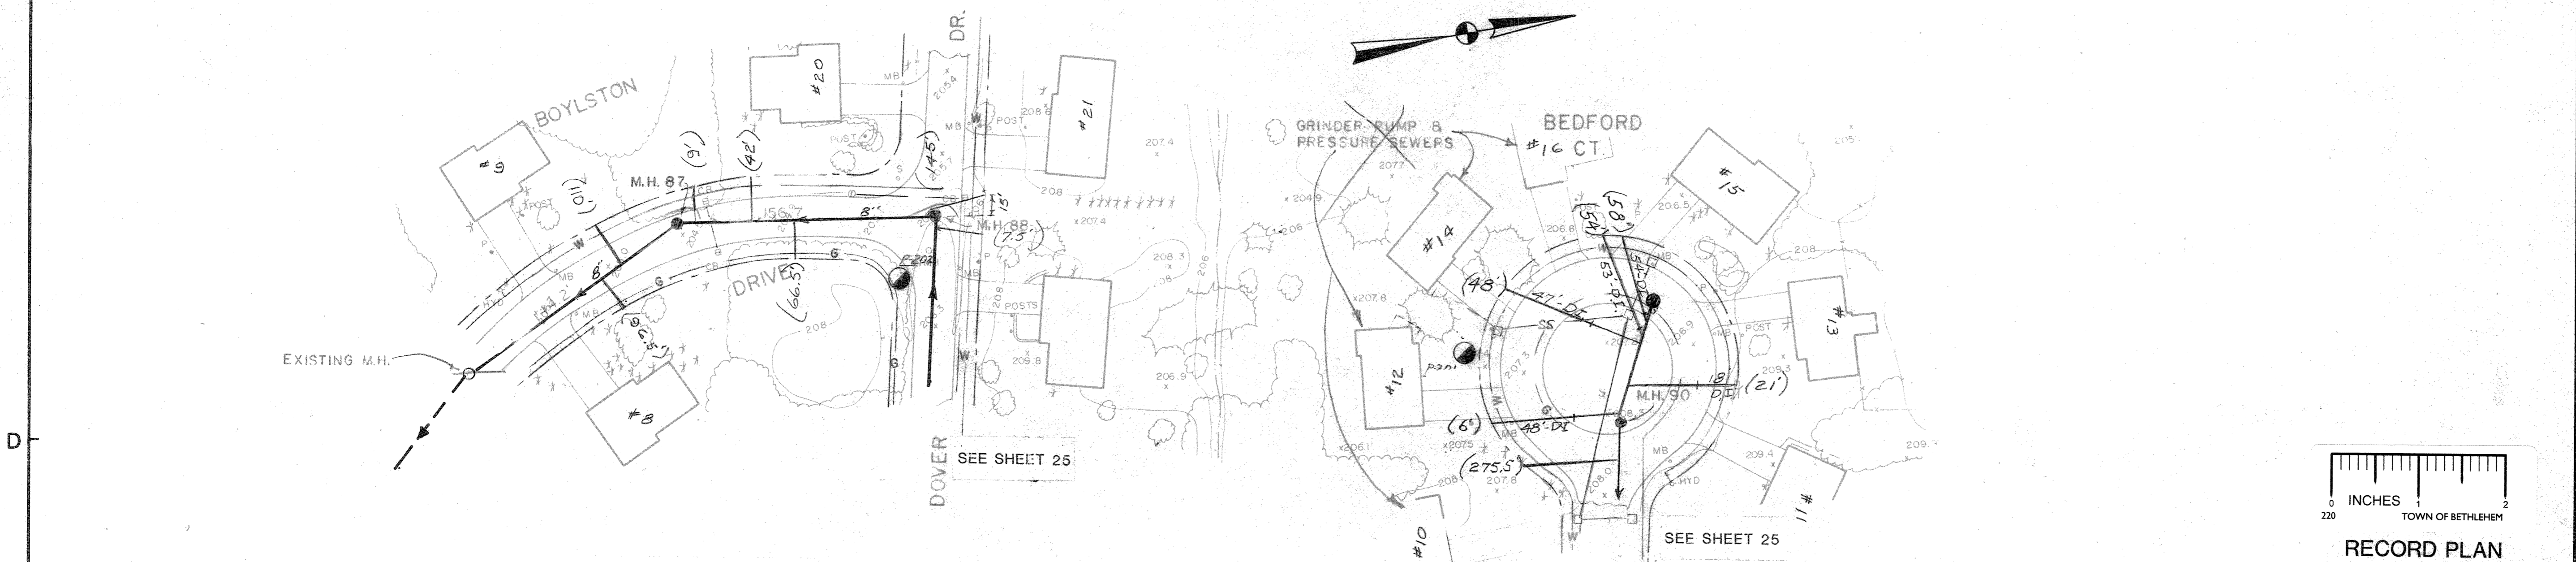

RECORD PLAN

