

R= 1255.00'
 L= 323.15'
 Ch= 322.26'
 S40° 54' 53"E


R= 1285.00'
 L= 279.85'
 Ch= 279.29'
 N42° 03' 08"W

LEGEND

- Overhead Utilities, Utility Pole & Guy
- IPF Iron Pipe Found
- IRF Iron Rod Found
- Underground Telephone
- Underground Gas Line
- Sign
- WV Water Valve
- CB Catch Basin
- MH Manhole

NOTES:

1. UNDERGROUND UTILITIES ARE SHOWN AS MARKED ON THE GROUND OR APPARENT FROM THE SURFACE. OTHER UNDERGROUND UTILITIES MAY EXIST AND ARE NOT SHOWN. CALL U.F.P.O. PRIOR TO ANY EXCAVATION.
2. THIS SURVEY HAS BEEN PREPARED WITHOUT THE BENEFIT OF AN ABSTRACT OF TITLE, AND IS SUBJECT TO WHATEVER FACTS AN ABSTRACT MAY SHOW.

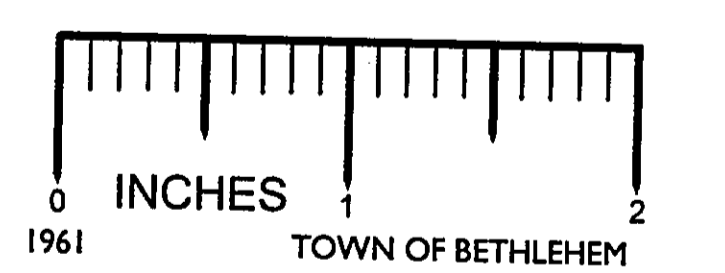

PROPOSED UTILITY EASEMENT
**BETHLEHEM CENTRAL
 SCHOOL DISTRICT**
 TOWN OF BETHLEHEM, ALBANY COUNTY, NEW YORK
EASEMENT MAP

Prepared For:
BARTON & LOGUIDICE, P.C.
 264 Washington Avenue Ext.
 Albany, NY 12203

Date: 11/7/03
 12/31/03
 1/5/04

Date	Revisions
11/7/03	Revise Easement to fit As-Built Sewer
12/31/03	Revise Easement to fit As-Built Sewer
1/5/04	General Revisions

Drawn by: JJW
 Scale: 1" = 50'

Date: 8/1/03
 Sheet: 1 of 1

Unauthorized alterations or additions to this survey map is a Violation of Section 7209 of the New York State Education Law. Copies of this survey map not bearing the land surveyors embossed seal shall not be considered valid copies. This Survey was prepared for the parties and purposes indicated hereon. Any extension of the use beyond the purpose exceeds the scope of the engagement.

JAMES J. WHITE, L.S. No. 50,026