



Project Title



4	7/20/07	Issue	2/25
3	7/20/07	Issue	2/25
2	4/16/06	Issue	1/12
1	4/16/06	Issue	1/12

Drawn By: SMK
 Checked By: SEE BELOW
 Date: FEBRUARY 3, 2008
 CSN Project # 04102-000

VAN DYKE RD
WATER MAIN
RECORD
PLAN

Sheet No. **TR**
C107P
RECORD
 CONSTRUCTION DOC.

Profile View of Proposed Water Line

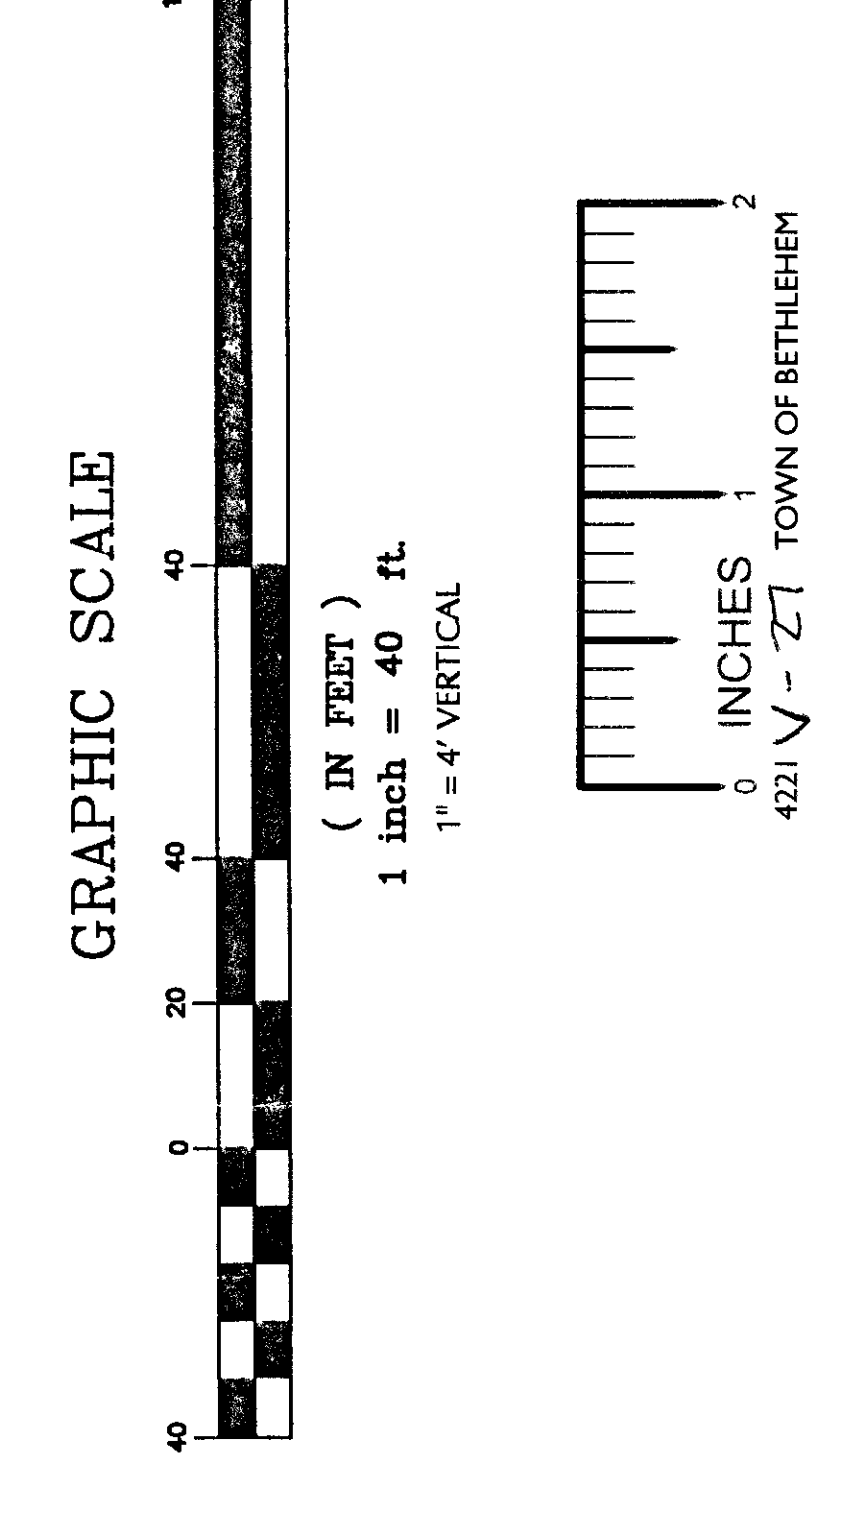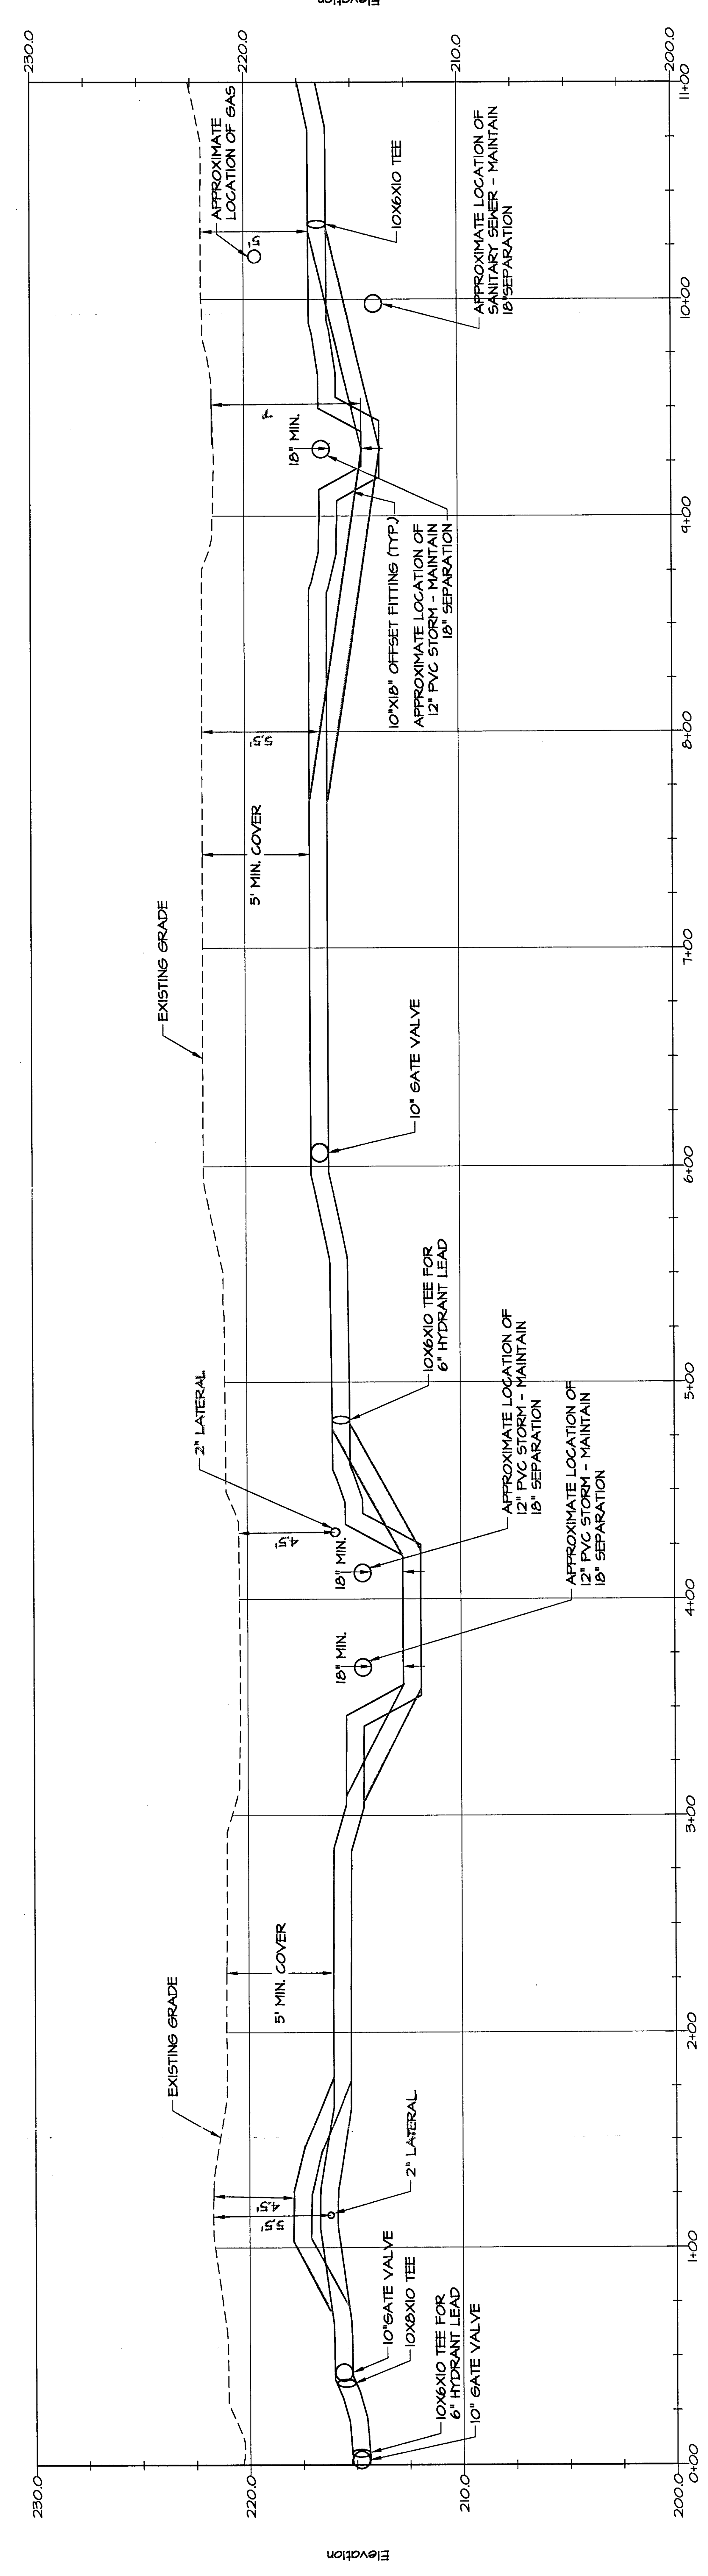

S.E.D. PROJECT CONTROL NUMBERS:
 BUS GARAGE: 01-03-06-06-5-010008
 BUS WASH: 01-03-06-06-5-027-001
 COPYRIGHT © ALL RIGHTS RESERVED