



LONG LANE

J. DOOLEY

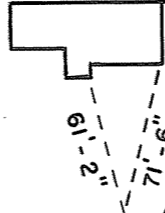

CO. ROUTE 55

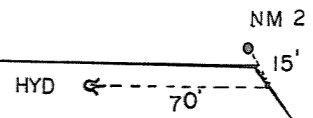

CO. ROUTE 55