



MATCH LINE SEE SHEET C7

NOTE:


1. INSTALL PIPE LINE MARKERS IN ACCORDANCE WITH TOWN'S STANDARD SPECIFICATION FOR THE FORCE MAIN SHOWN HEREON.
2. CONTRACTOR SHALL INSTALL BENDS ALONG FORCE MAINS NECESSARY TO MAINTAIN LOCATION OF UTILITY AS SHOWN ON THE PLAN.

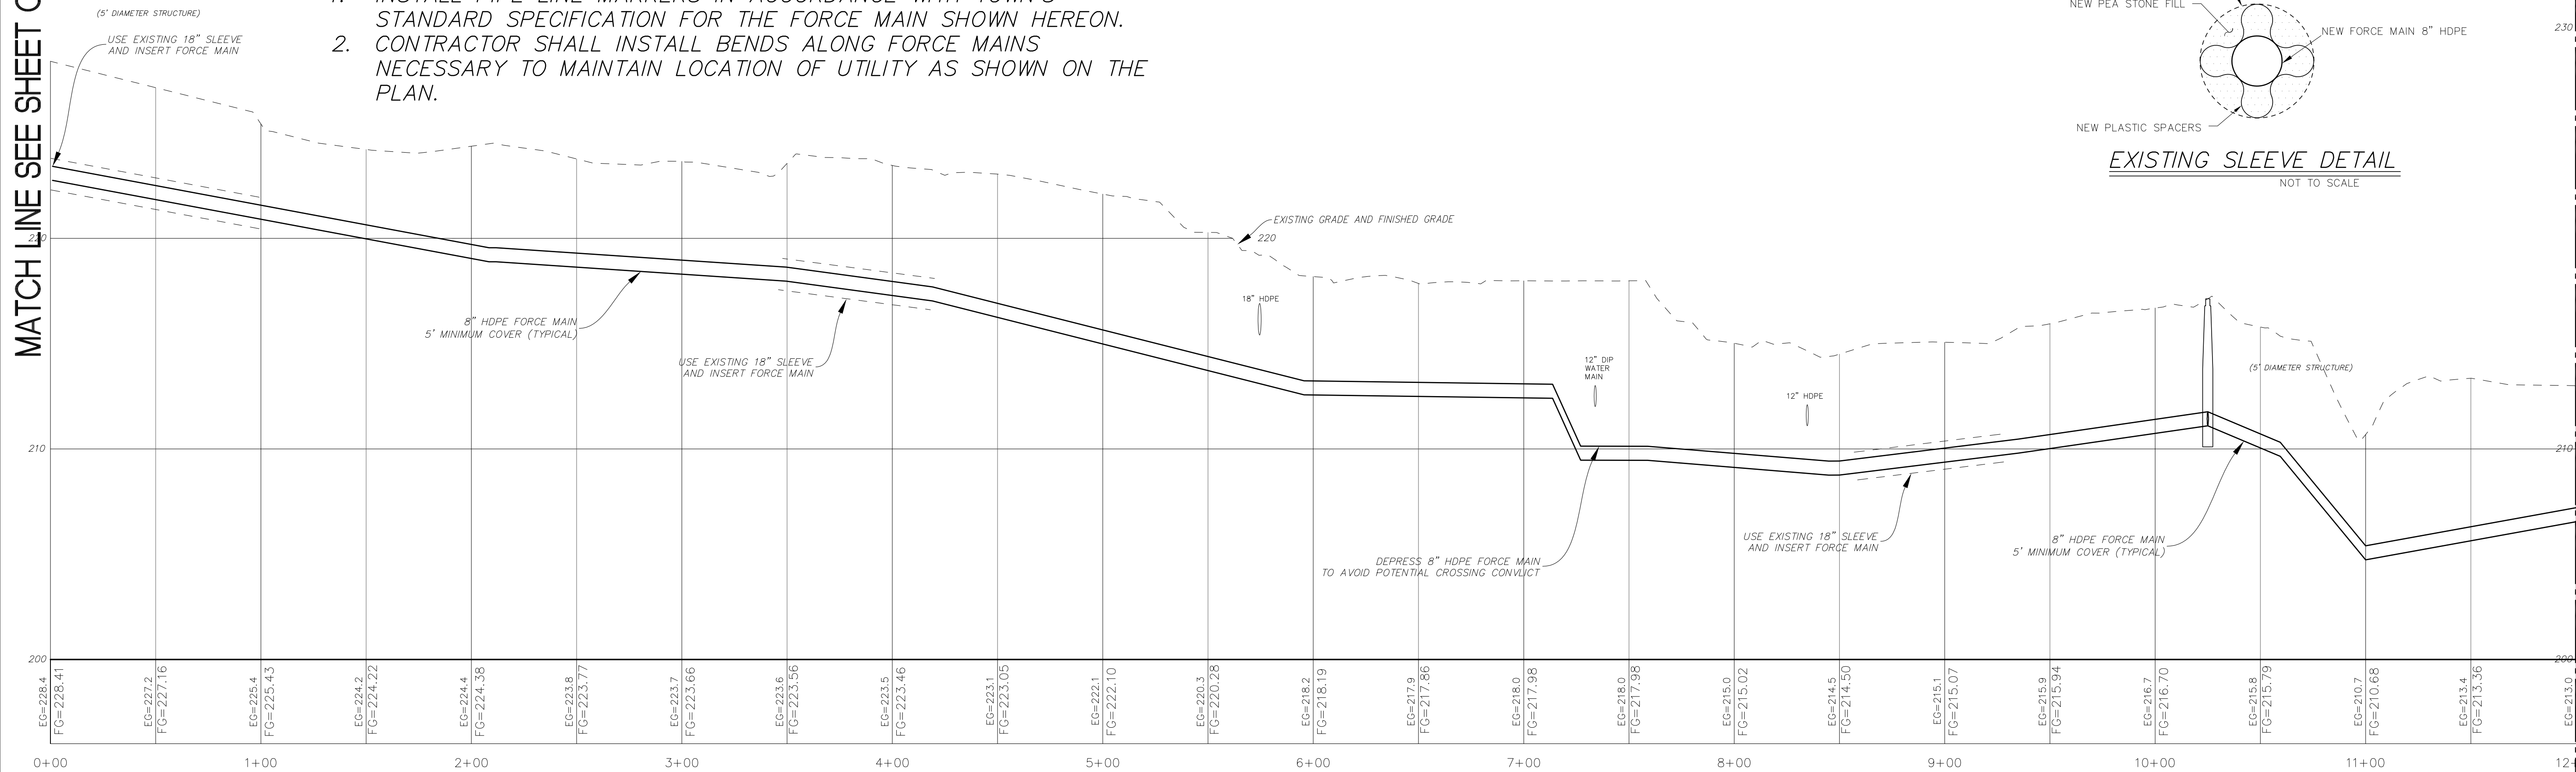

FORCE MAIN PROFILE

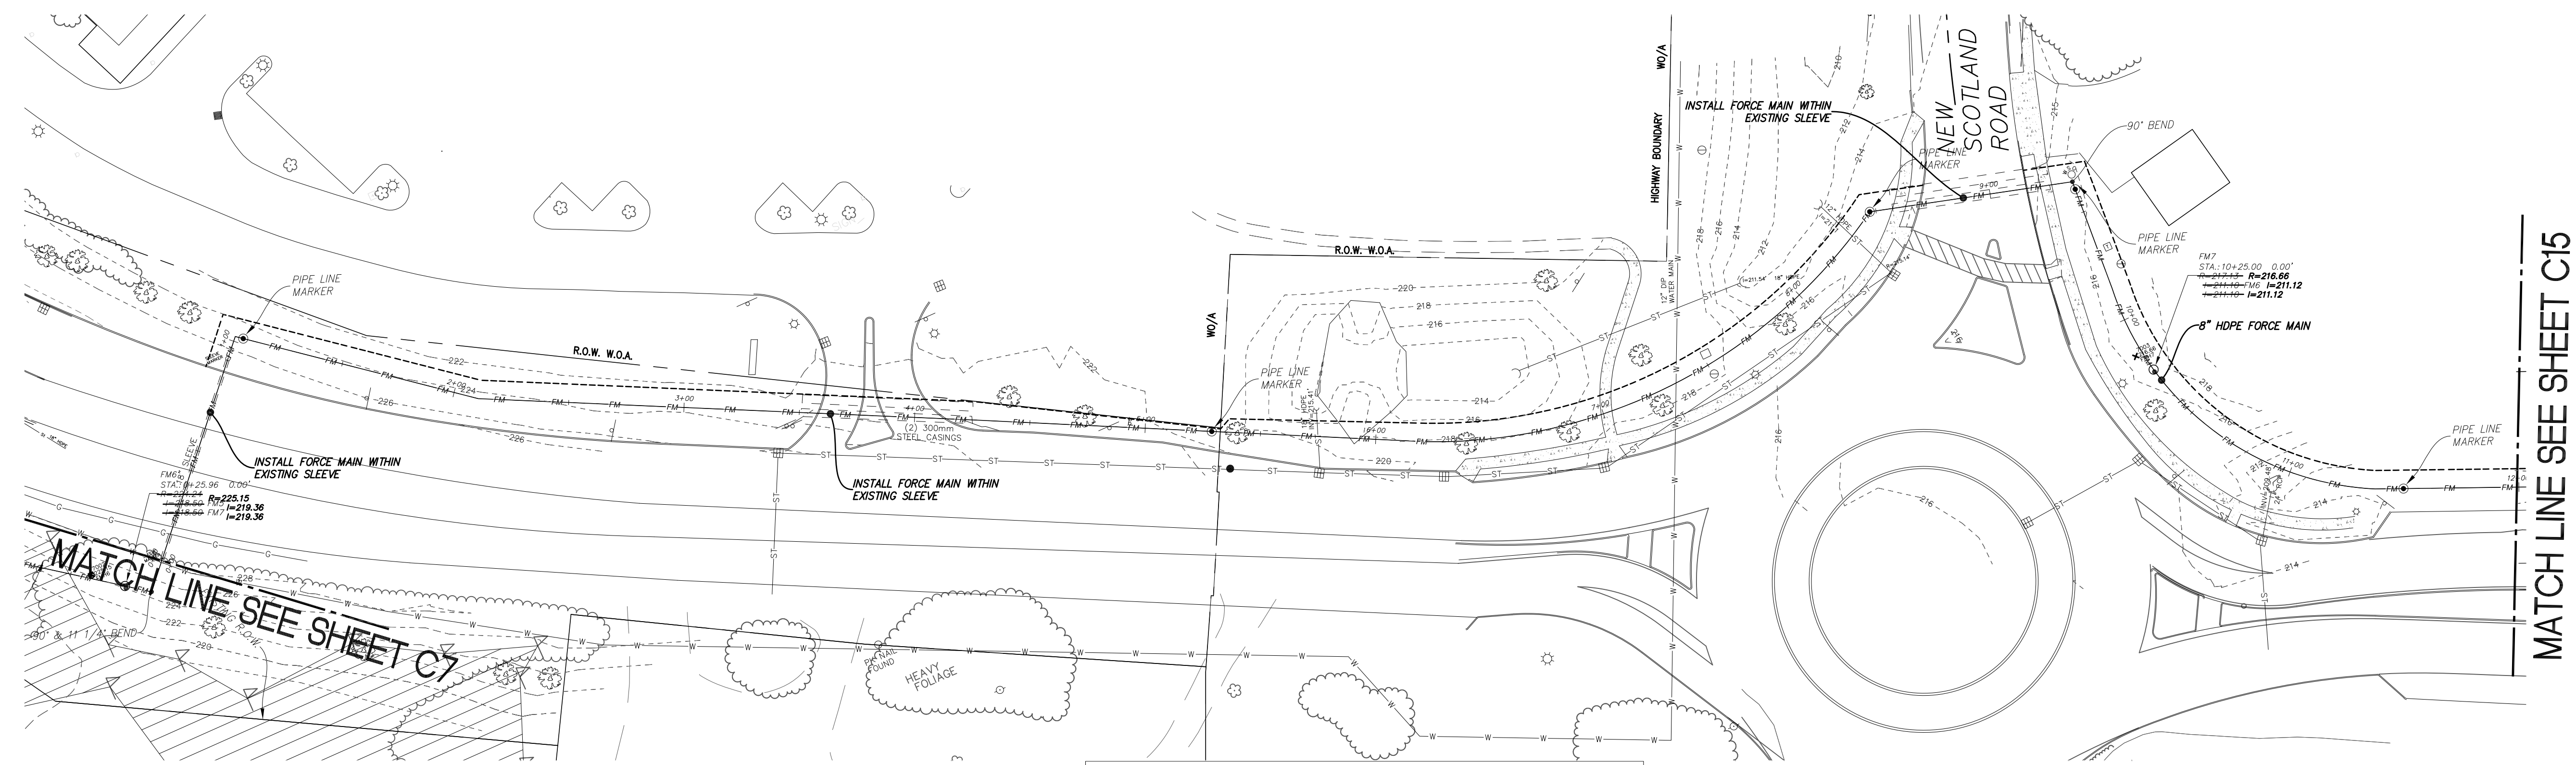

FORCE MAIN PLAN

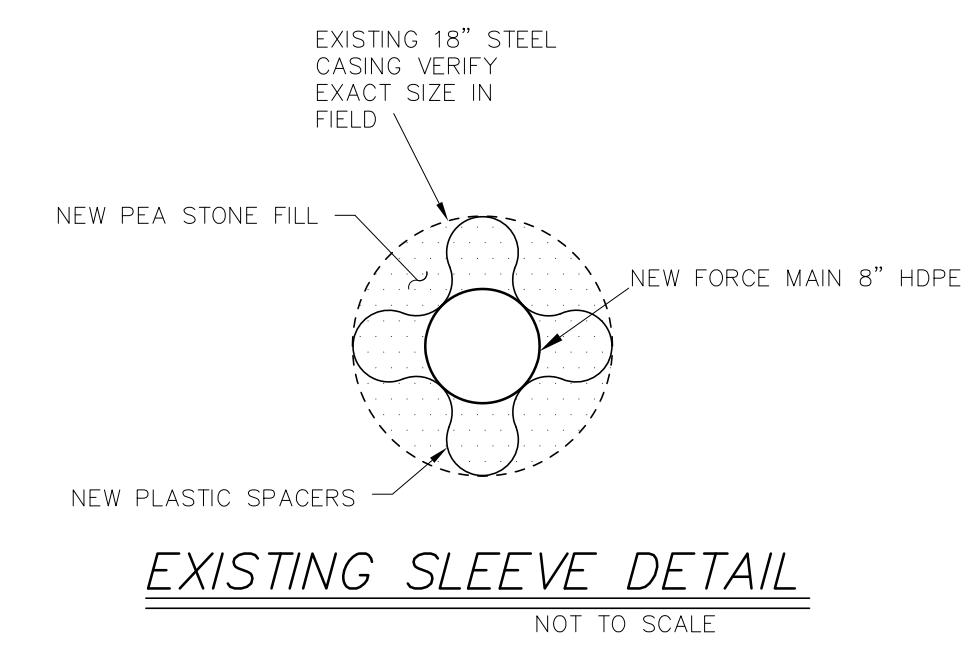

EXISTING SLEEVE DETAIL
NOT TO SCALE

MATCH LINE SEE SHEET C15

NOTE:
RECORD INFORMATION SHOWN HEREON OBTAINED BY
INGALLS & ASSOCIATES LLP FROM A FIELD SURVEY
CONDUCTED AUGUST 8, 2012 THROUGH AUGUST 13,
AND REFLECTS CONDITIONS EXISTING AT THOSE
OCCASIONS.

SANITARY SEWER AND STORM SEWER
RECORD PLAN

PUBLIC INFRASTRUCTURE CONSTRUCTION
VISTA TECHNOLOGY CAMPUS
TOWN OF BETHLEHEM
ALBANY COUNTY, STATE OF NEW YORK

HERSHBERG
&
HERSHBERG
Consulting Engineers
and Land Surveyors
18 Locust Street
Albany, New York 12203

ALTERATION OF THIS
DOCUMENT EXCEPT BY A
LICENSED PROFESSIONAL
ENGINEER OR LAND
SURVEYOR, IS ILLEGAL.

DATE	
REMARKS	
REVISIONS	

FILE: 110027

SCALE: H=1"=40' V=1"=4'

DATE: 2/18/11

CHK: DBH

BY: WM

110027-1.dwg