



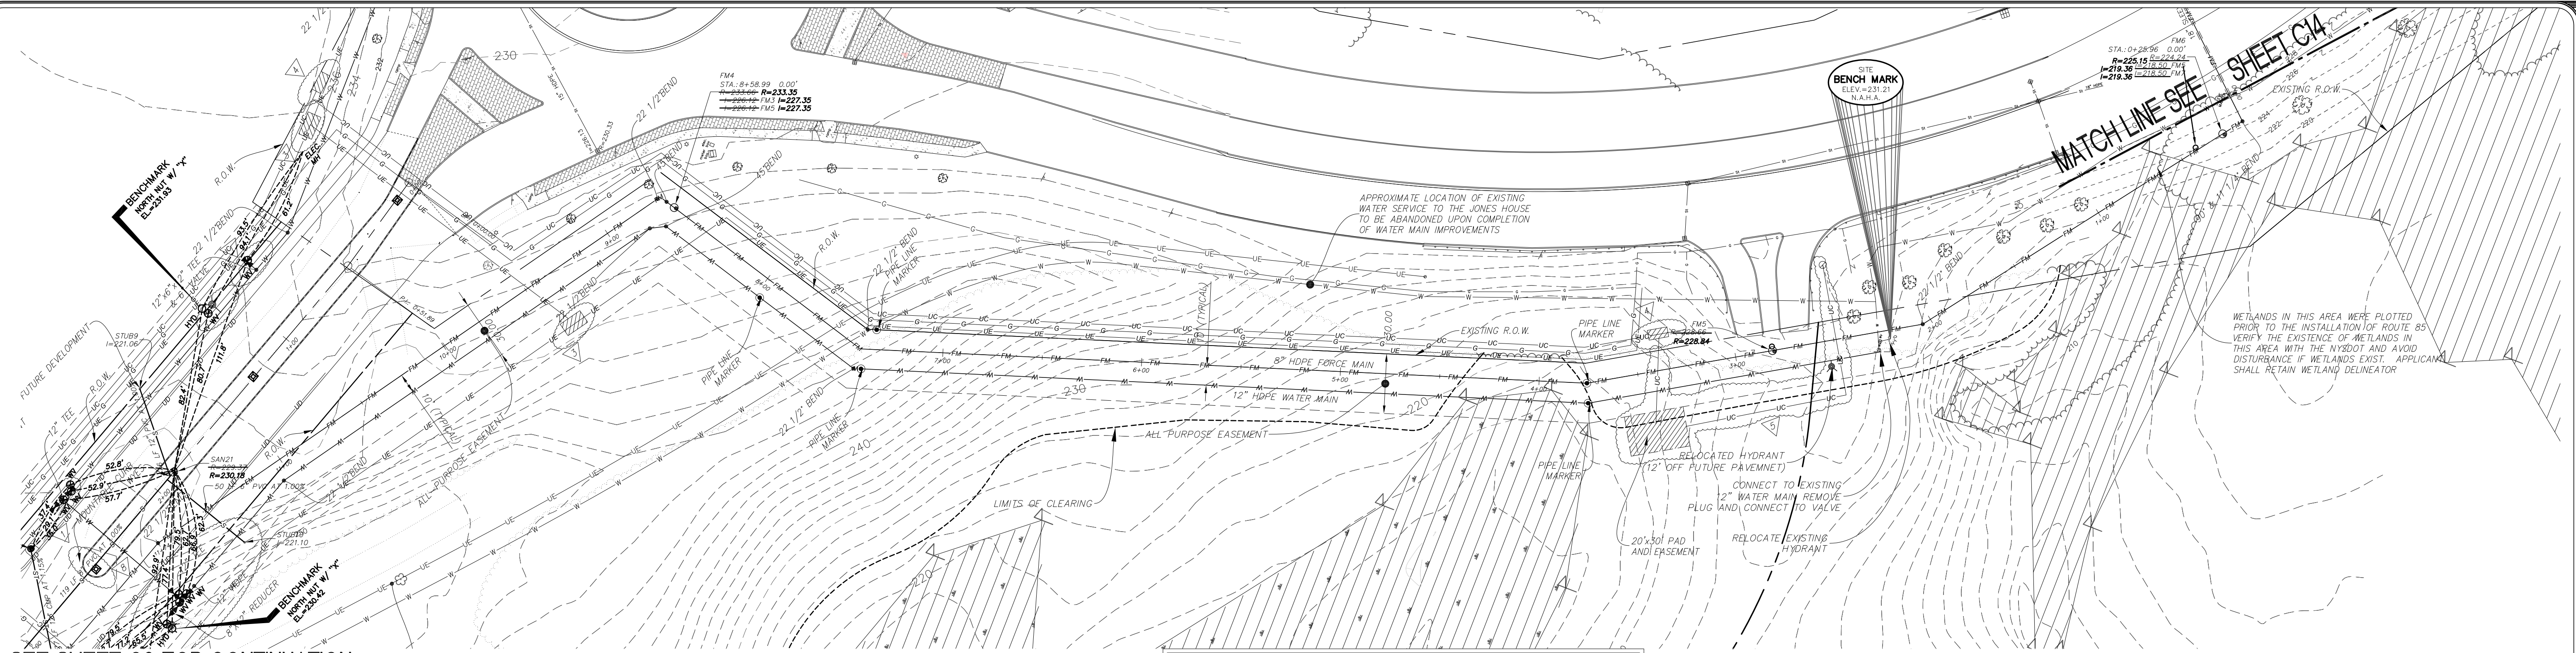

SEE SHEET C3 FOR CONTINUATION

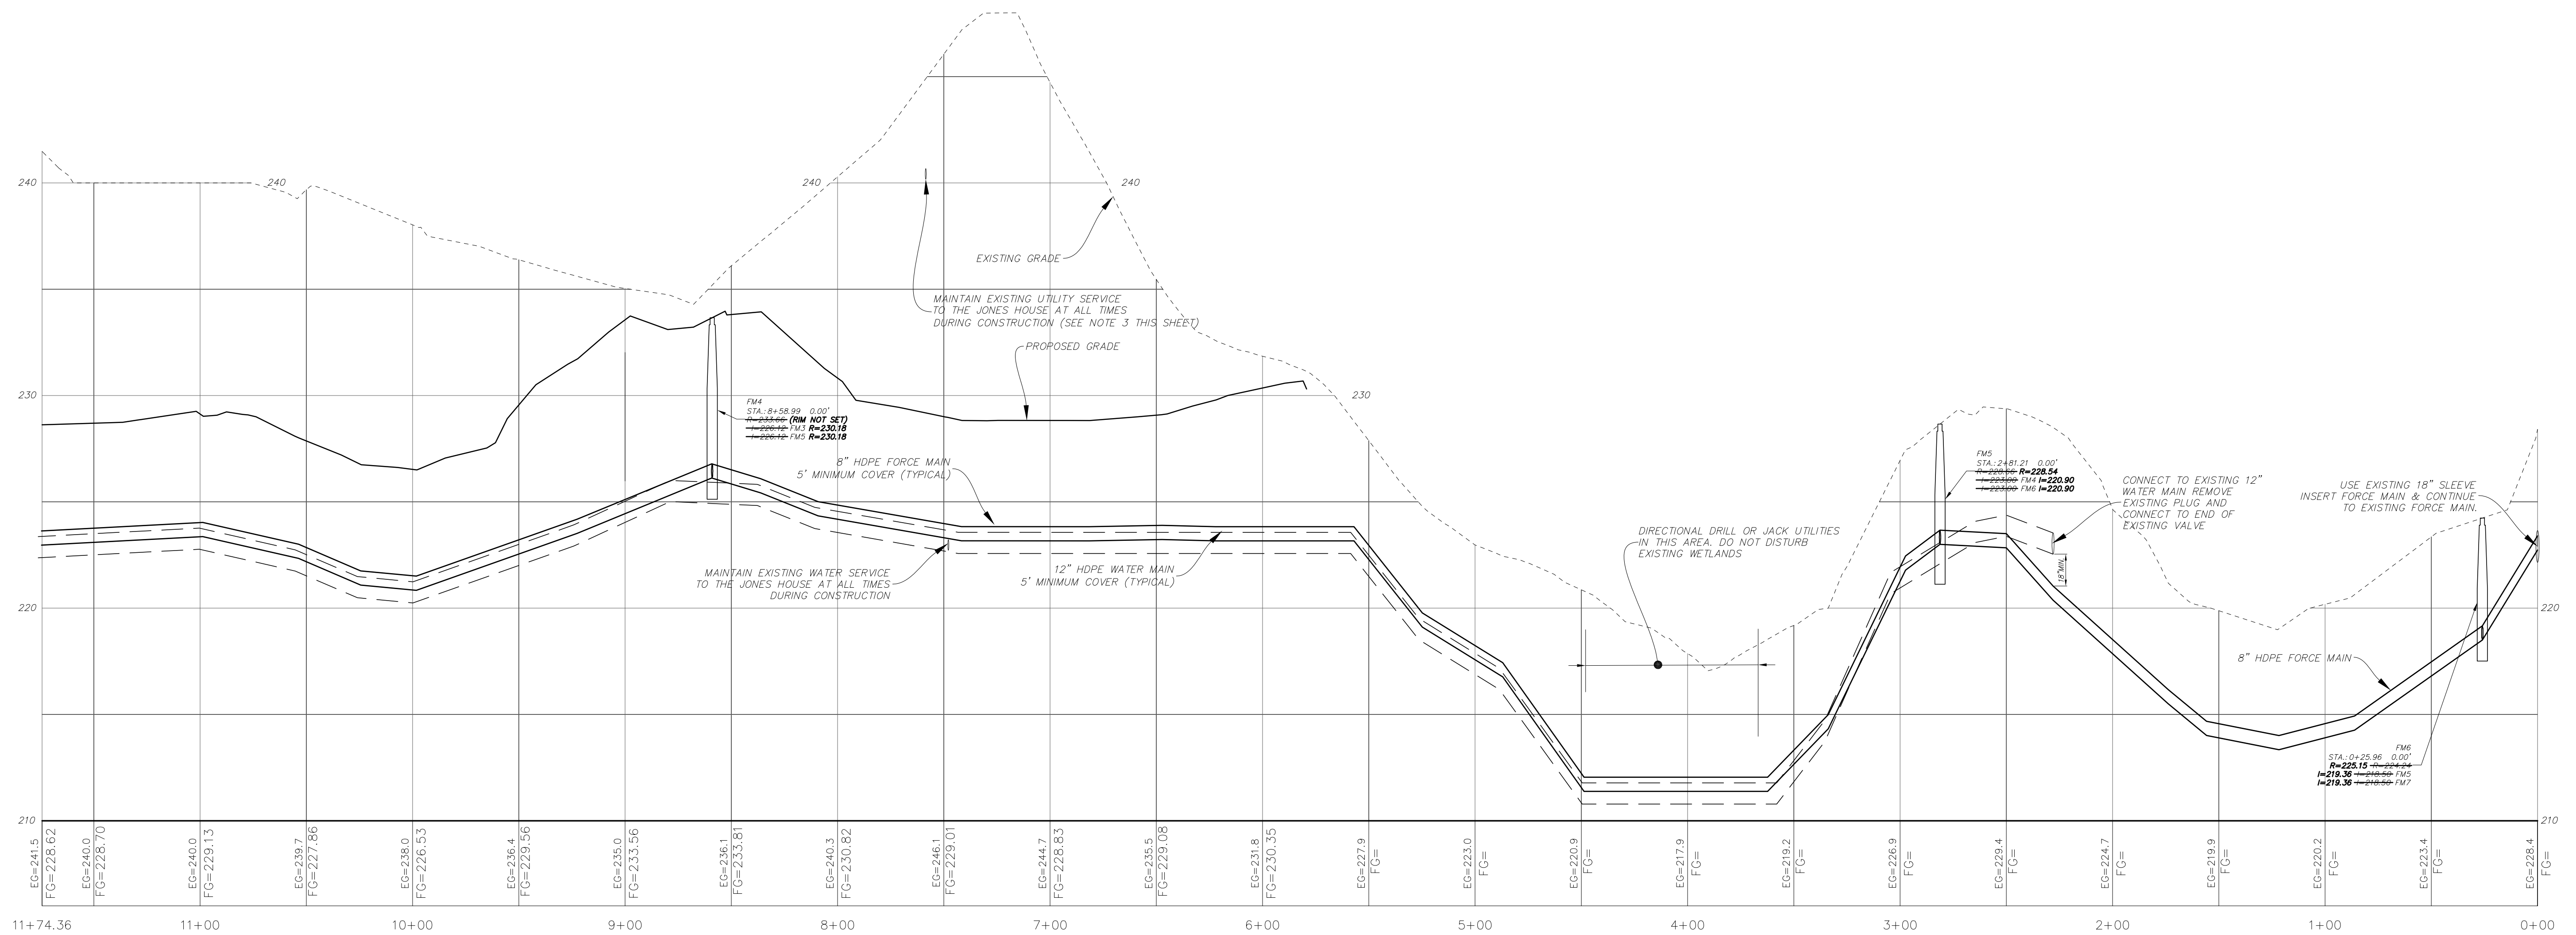


NOTE:

1. INSTALL PIPE LINE MARKERS IN ACCORDANCE WITH TOWN'S STANDARD SPECIFICATION FOR THE WATER MAIN AND FORCE MAIN SHOWN HEREON.
2. CONTRACTOR SHALL INSTALL BENDS ALONG WATER MAINS AND FORCE MAINS NECESSARY TO MAINTAIN LOCATION OF UTILITY AS SHOWN ON THE PLAN.
3. THE TIME FRAME FOR POTENTIAL WATER SERVICE INTERRUPTION TO THE JONES HOUSE SHALL BE LIMITED TO 4 HOURS. THE OWNER SHALL BE NOTIFIED AT LEAST 72 HOUR PRIOR TO WATER SERVICE WORK. COORDINATE ALL WORK WITH THE TOWN OF BETHLEHEM.

NOTE:
RECORD INFORMATION SHOWN HEREON OBTAINED BY
INGALLS & ASSOCIATES LLP FROM A FIELD SURVEY
CONDUCTED AUGUST 8, 2012 THROUGH AUGUST 13,
AND REFLECTS CONDITIONS EXISTING AT THOSE
OCCASIONS.

SANITARY SEWER AND STORM SEWER
RECORD PLAN (LAST REVISED 10-16-12)

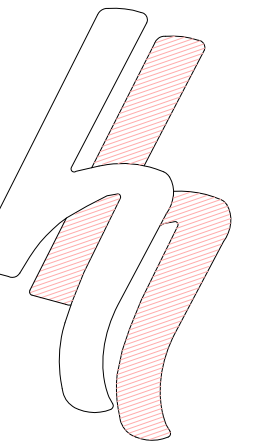

**HERSHBERG
&
HERSHBERG**

Consulting Engineers
and Land Surveyors
18 Locust Street
Albany, New York 12203

ALTERATION OF THIS
DOCUMENT EXCEPT BY A
LICENSED PROFESSIONAL
ENGINEER OR LAND
SURVEYOR, IS ILLEGAL

REMARKS	DATE
HYDRANT & SEWER LATERALS	5/11/11
✓ COMMUNICATIONS	4/12/12
✓ COMMUNICATIONS	5/2/12
REVISIONS	

PUBLIC INFRASTRUCTURE CONSTRUCTION
VISTA TECHNOLOGY CAMPUS
TOWN OF BETHLEHEM
ALBANY COUNTY, STATE OF NEW YORK

FILE: 110027
SCALE: H=1"=40' V=1"=4'
DATE: 2/18/11
CHK: DBH
DATE: 2/18/11
110027-1.dwg

C7