



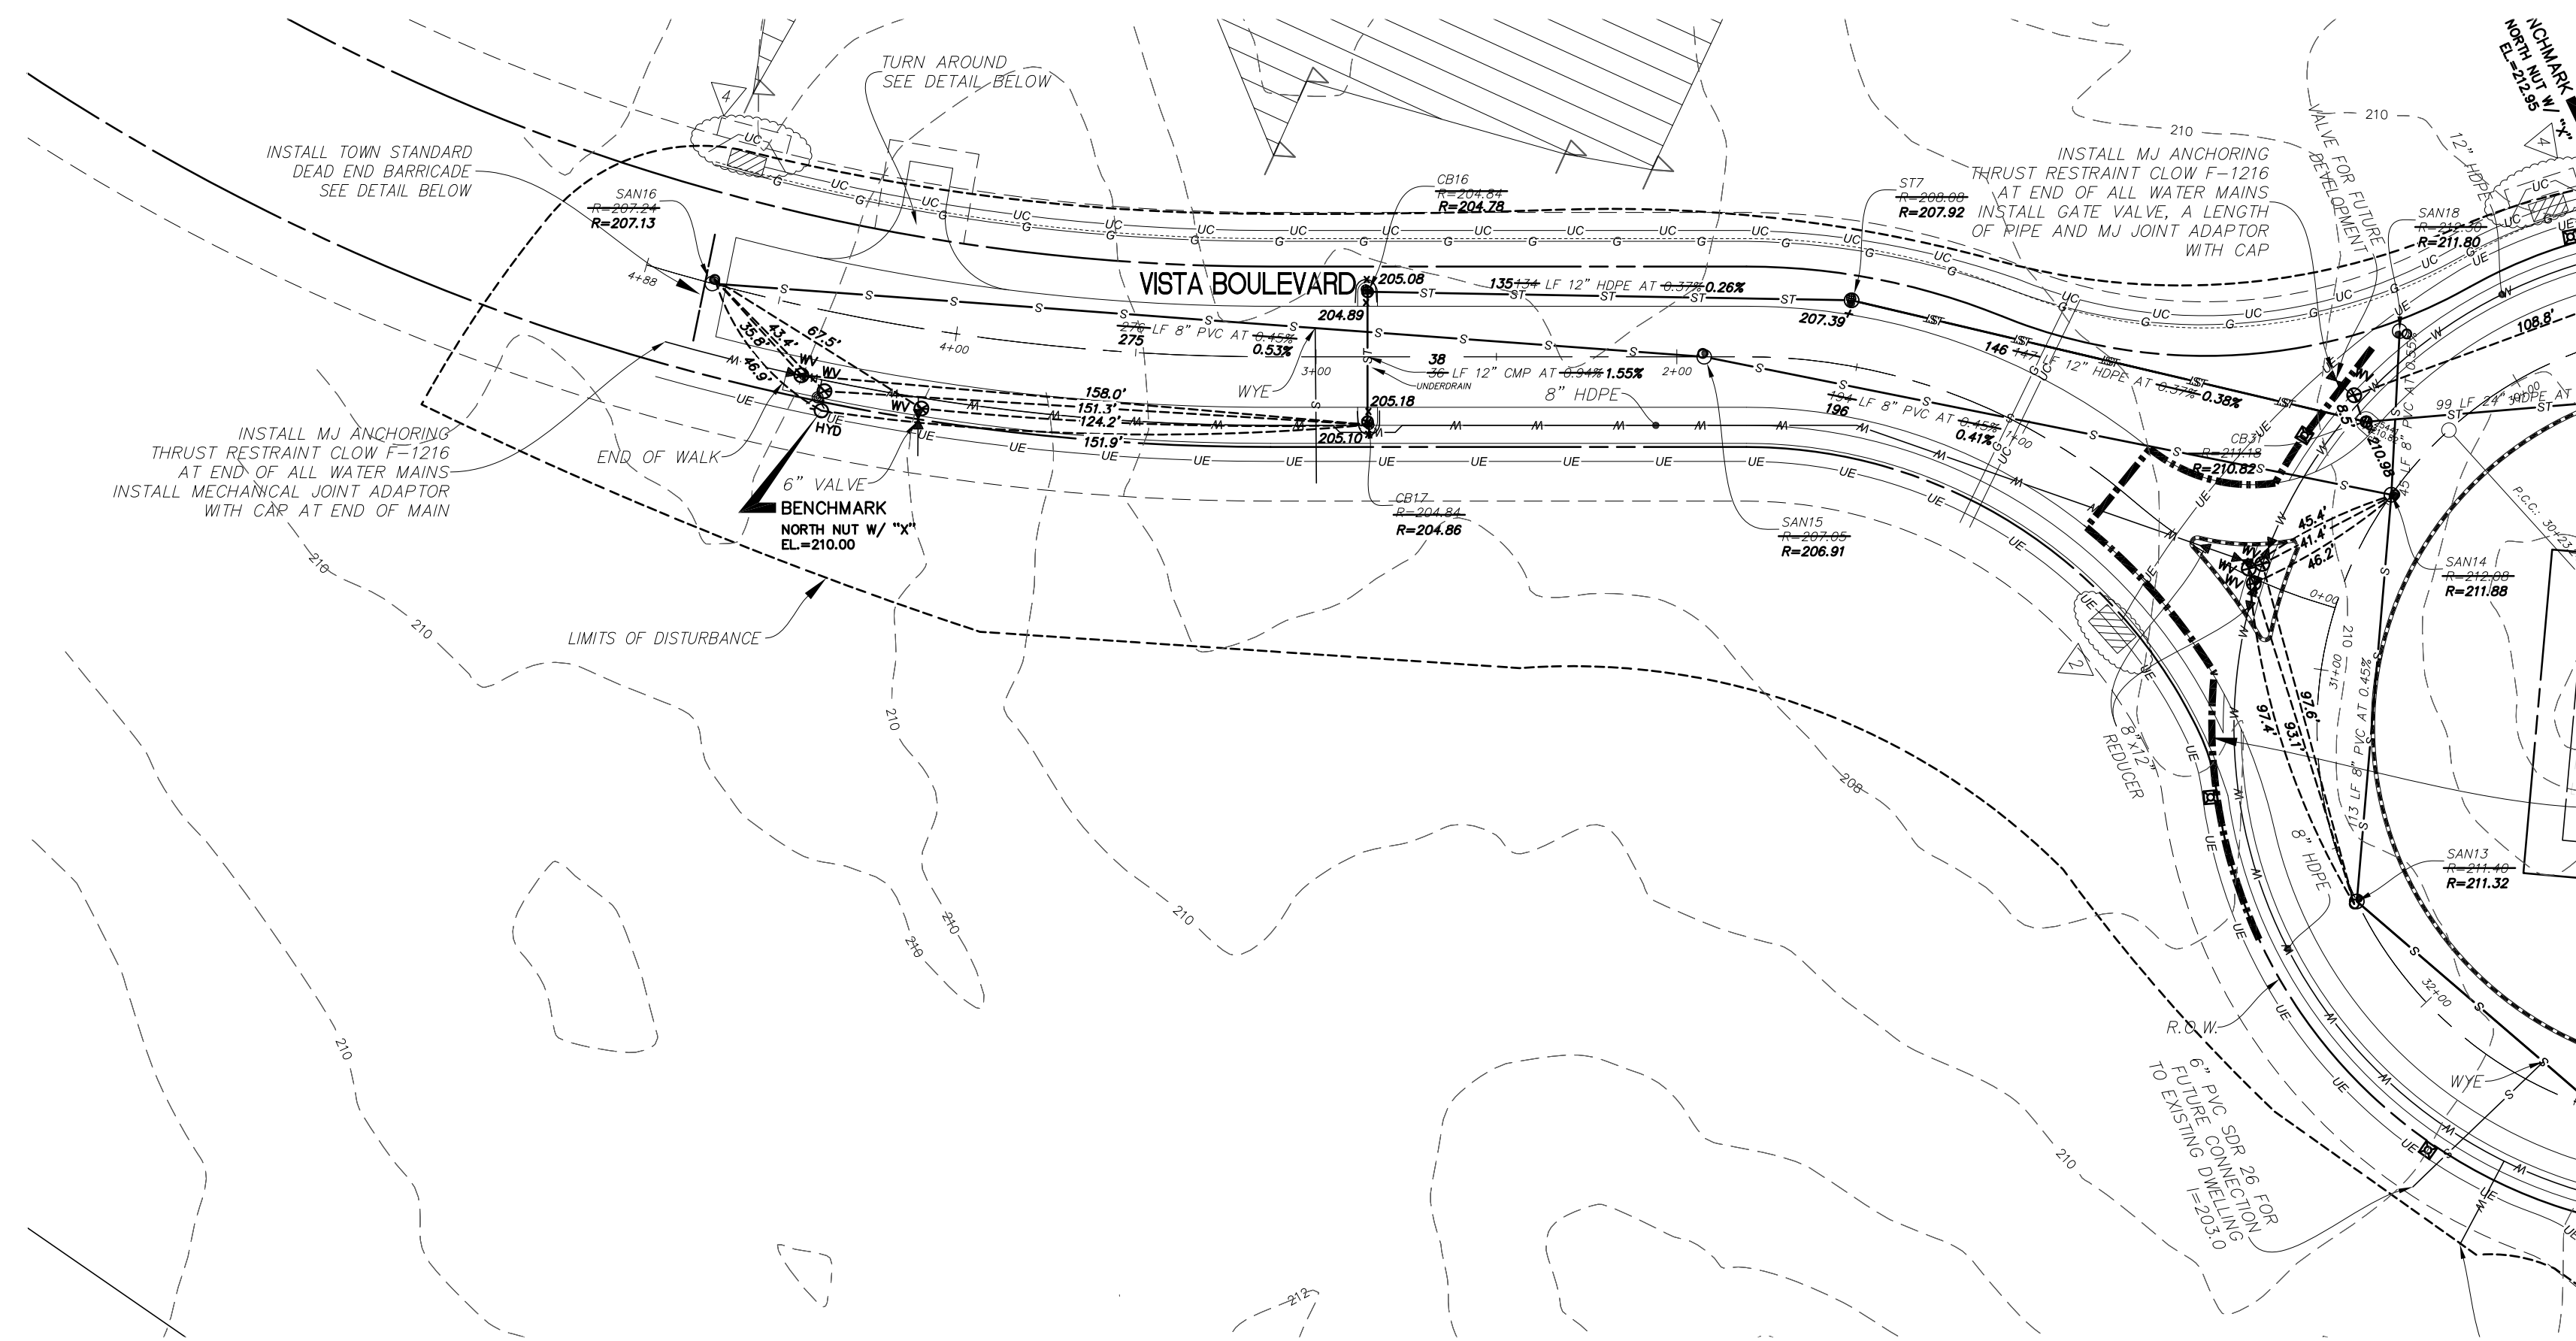


MATCH LINE SEE SHEET C5

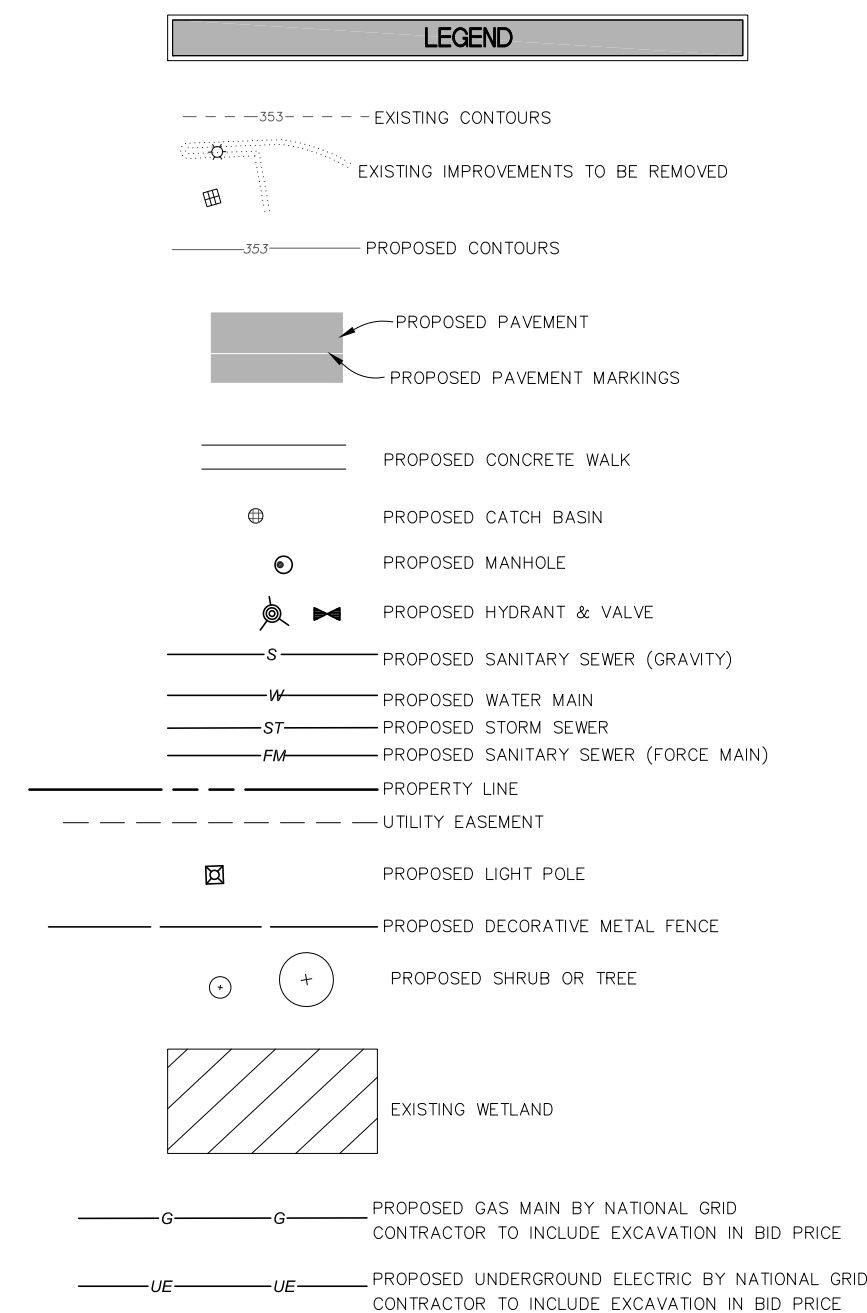


NOTE: ASPHALT SPOT ELEVATIONS SHOWN HEREON ARE TOP OF ASPHALT BINDER ELEVATION.

VISTA BOULEVARD PLAN

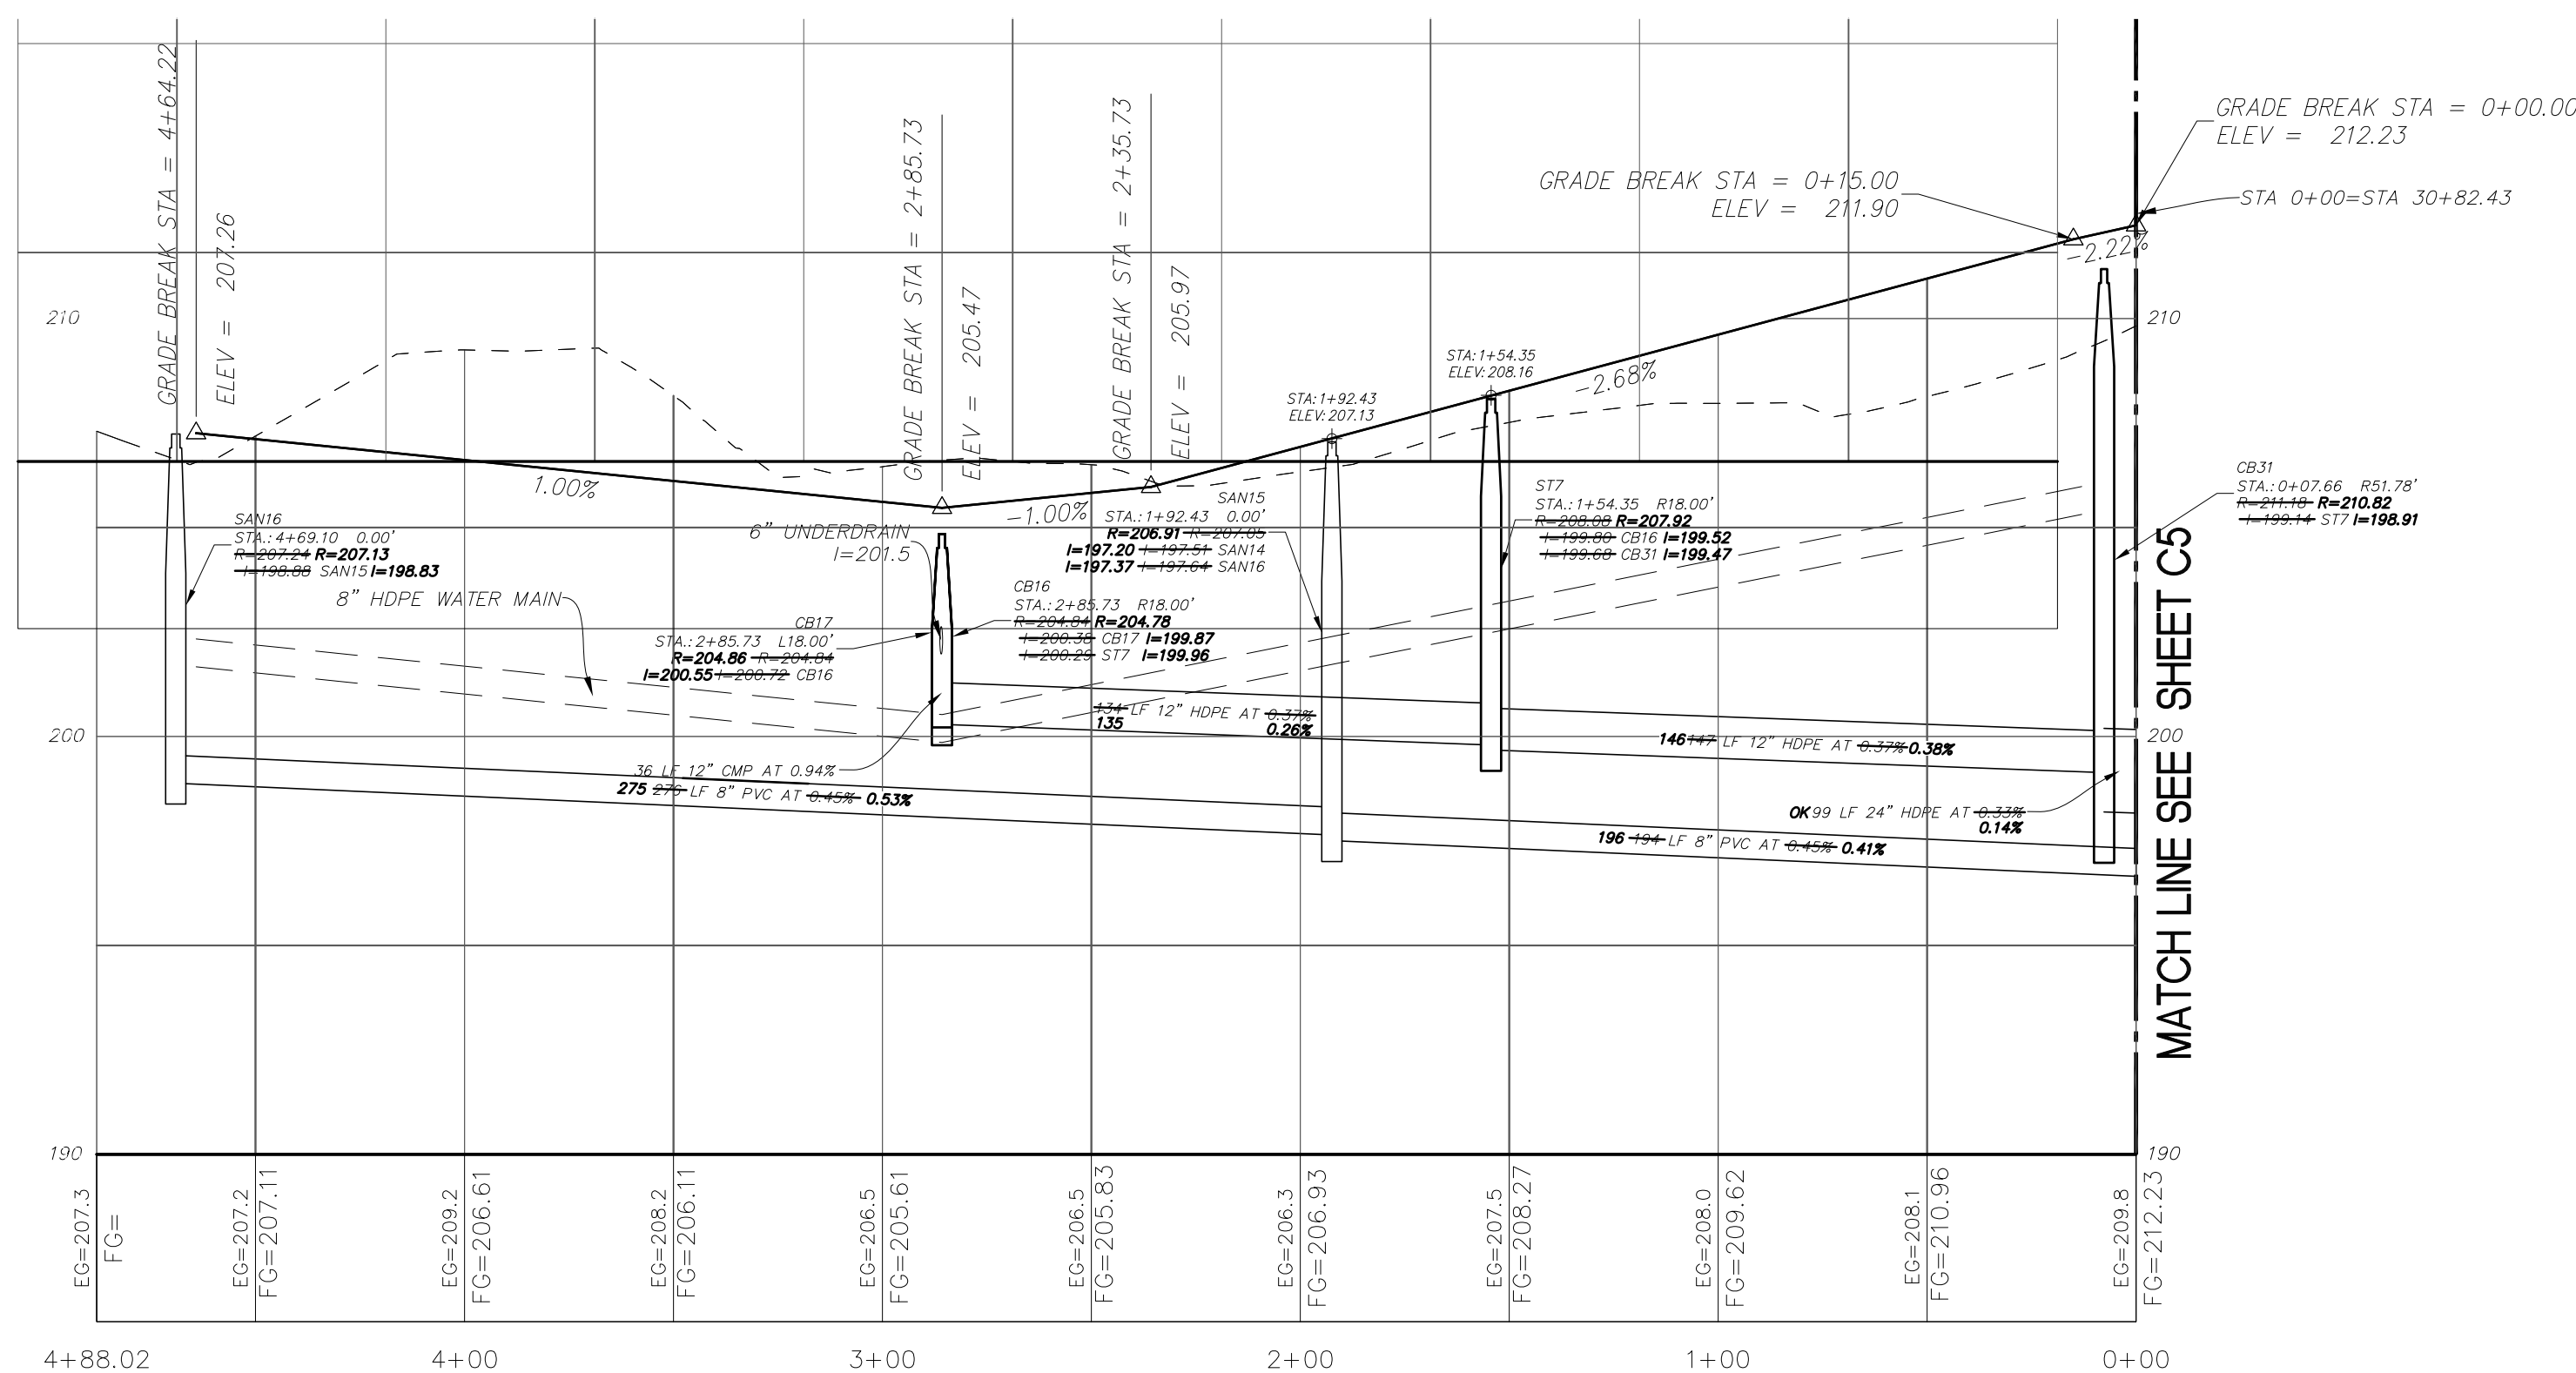

MATCH LINE SEE SHEET C5


VISTA BOULEVARD PROFILE

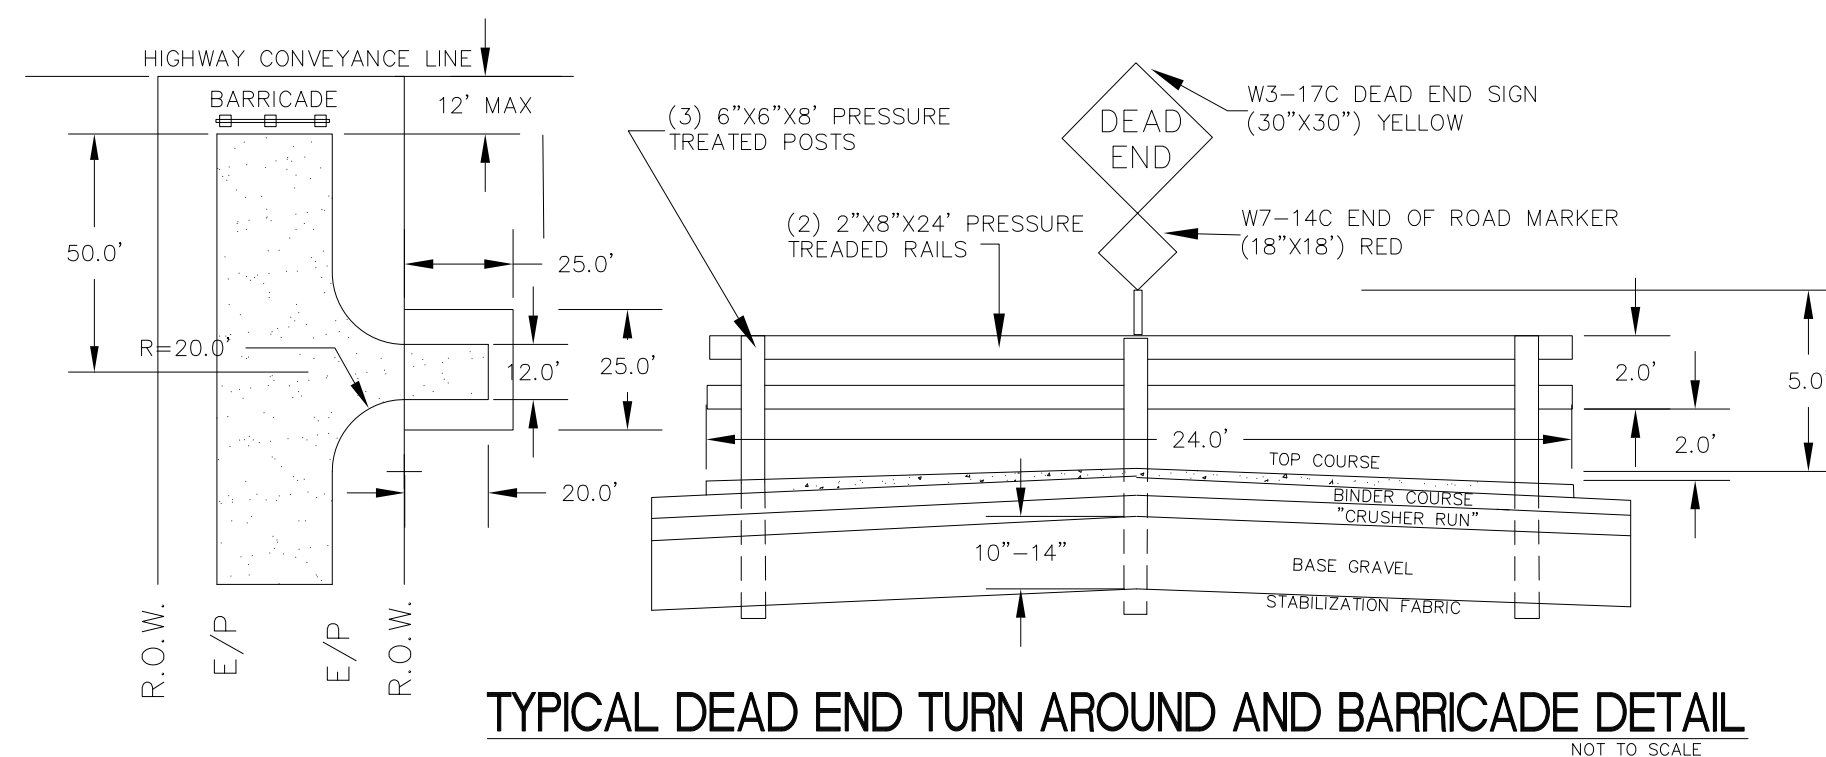

TYPICAL DEAD END TURN AROUND AND BARRICADE DETAIL

NOTE: RECORD INFORMATION SHOWN HEREON OBTAINED BY INGALLS & ASSOCIATES LLP FROM A FIELD SURVEY CONDUCTED AUGUST 8, 2012 THROUGH AUGUST 13, AND REFLECTS CONDITIONS EXISTING AT THOSE OCCASIONS.

SANITARY SEWER, STORM SEWER AND
HYDRANT & WATER VALVE TIE
RECORD PLAN (LAST REVISED 10-16-12)

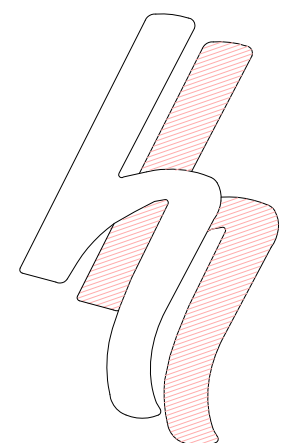

**HERSHBERG
&
HERSHBERG**

Consulting Engineers
and Land Surveyors

18 Locust Street
Albany, New York 12203

ALTERATION OF THIS
DOCUMENT EXCEPT BY A
LICENSED PROFESSIONAL
ENGINEER OR LAND
SURVEYOR, IS ILLEGAL

REMARKS	DATE
GAS & ELEC	5/11/11
COMMUNICATION LINES	4/9/12
COMMUNICATIONS	4/12/12
REVISIONS	

PUBLIC INFRASTRUCTURE CONSTRUCTION
VISTA TECHNOLOGY CAMPUS
TOWN OF BETHLEHEM
ALBANY COUNTY, STATE OF NEW YORK

110027-1.dwg

DATE: 2/18/11

CHK: DRH

BY: WM

SCALE: H: 1"=40' V: 1"=4'

FILE: 110027

02