


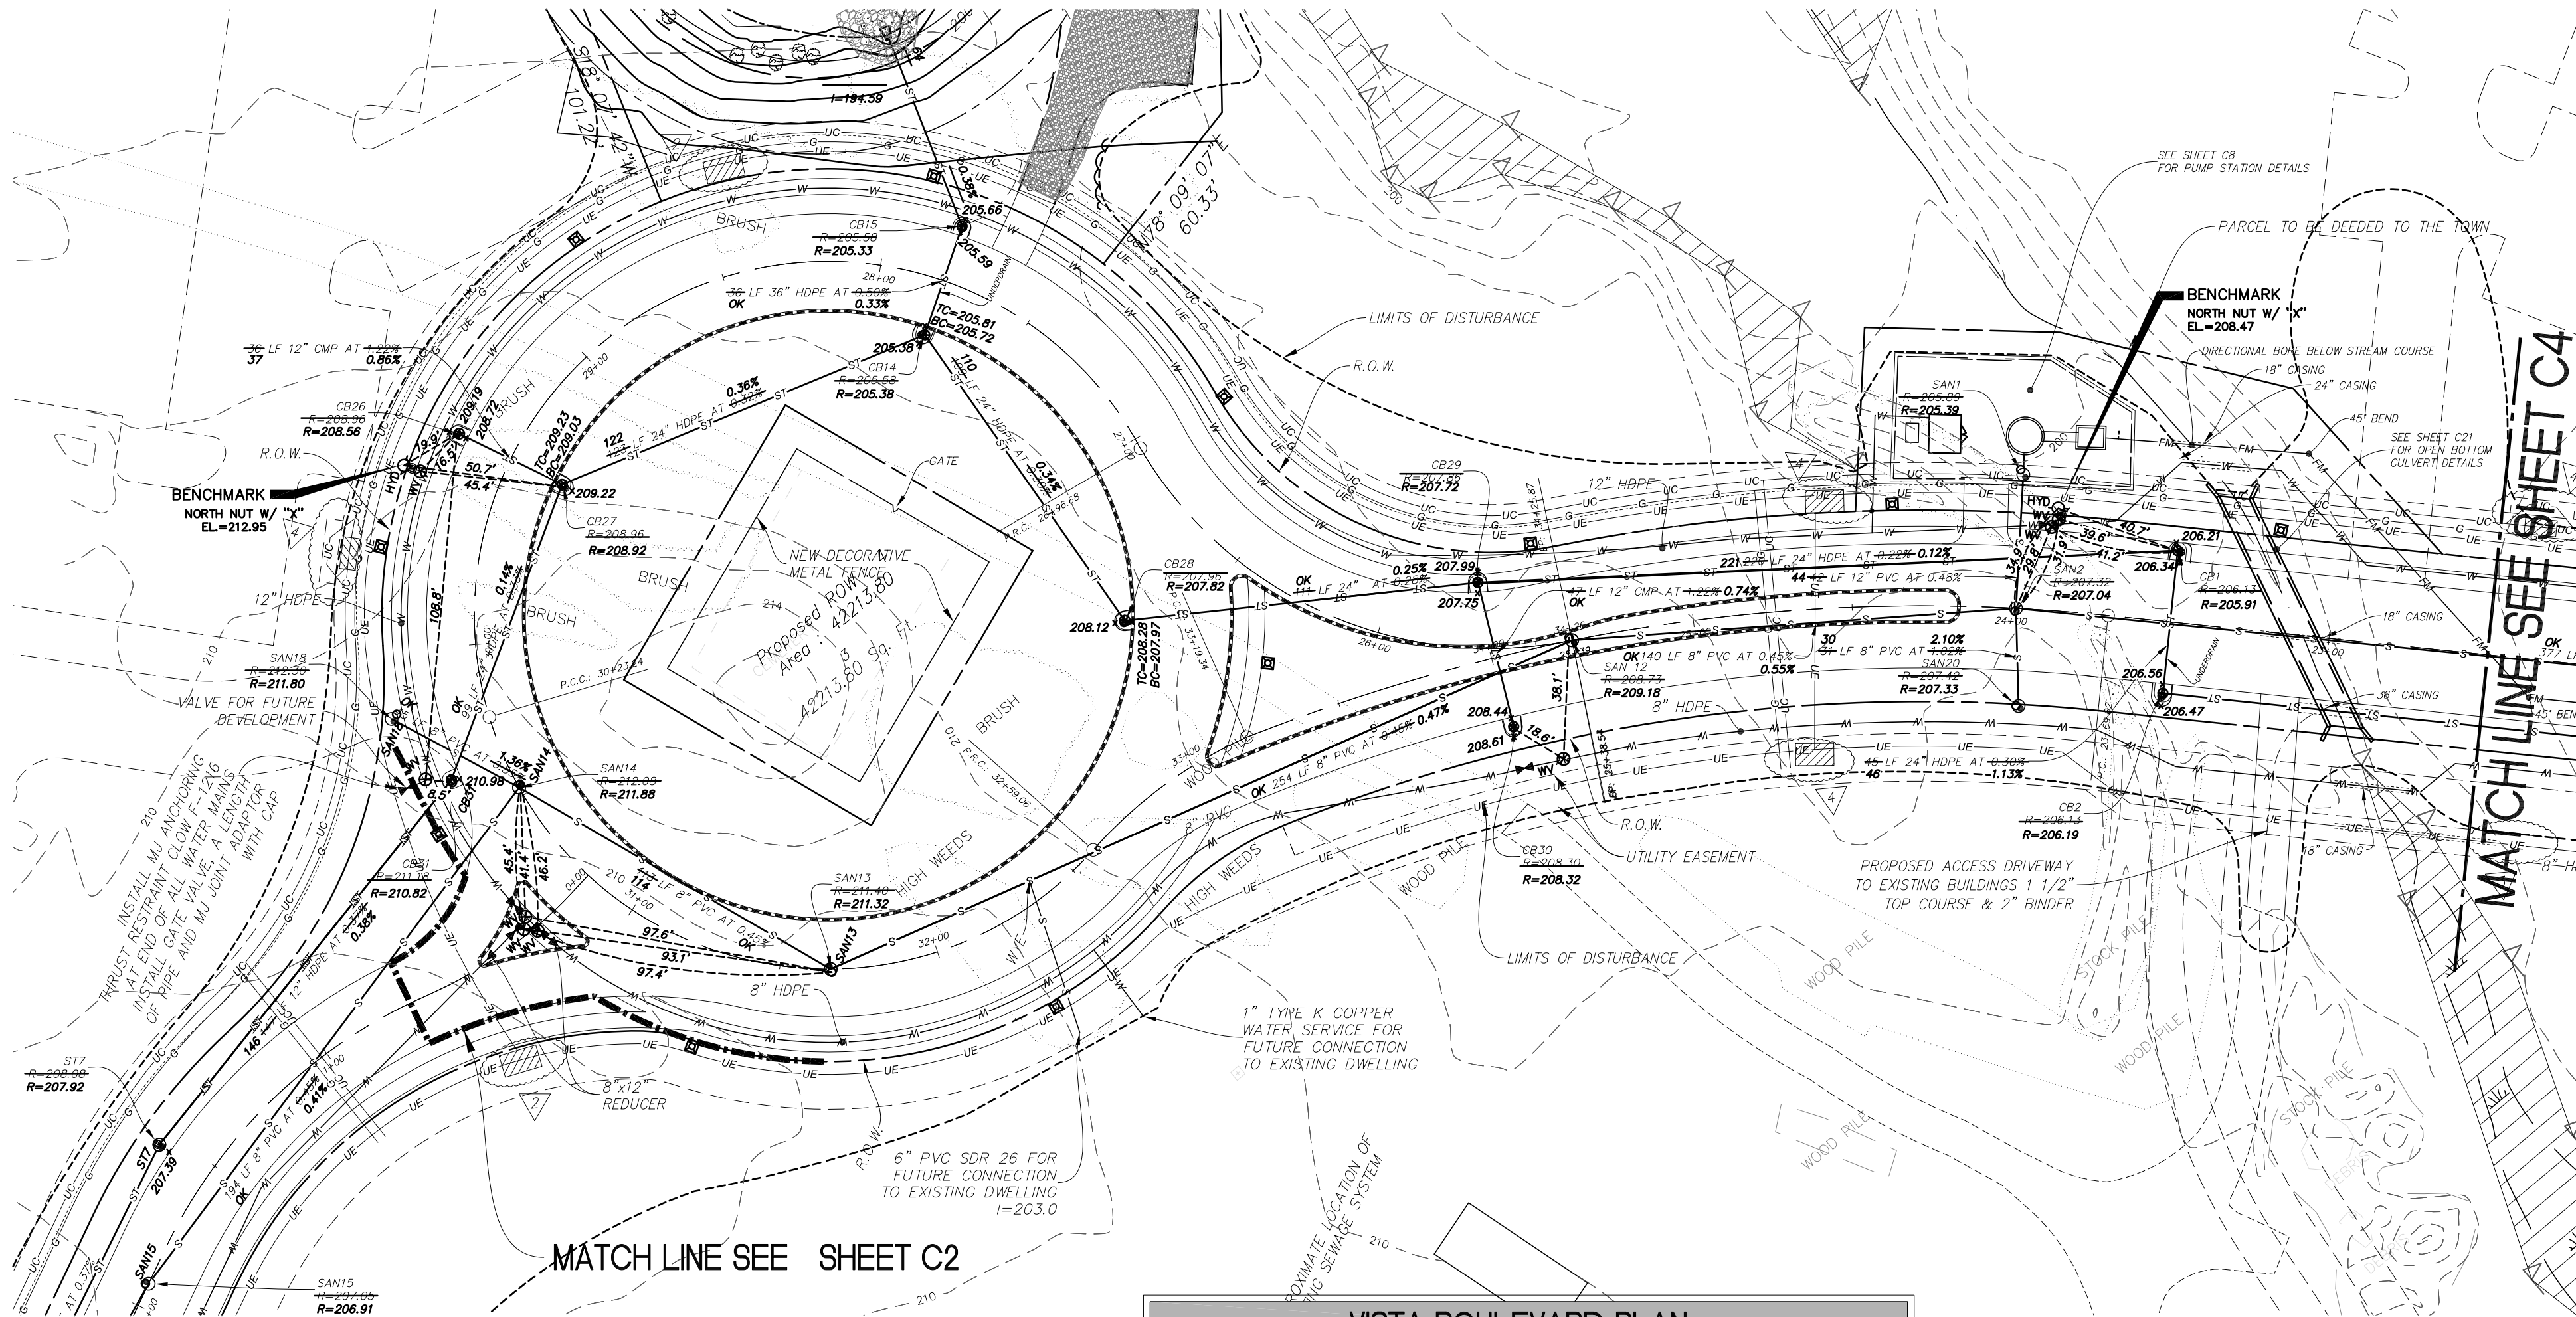


VISTA BOULEVARD PLAN

NOTE: ASPHALT SPOT ELEVATIONS SHOWN HEREON ARE TOP OF ASPHALT BINDER ELEVATION.

SYM	BOTANICAL NAME	COMMON NAME	SIZE	COMMENTS
SHRUBS				
AC	AMELANCHIER CANADENSIS	SHADBLOW	6"-7" HT. HEAVY	B & B
BW	BUXUS x 'WINTER GEM'	WINTER GEM BOXWOOD	18" HT.	C.G.
CA	CORNUS ALBA STOLONIFERA	RED OSIER DOGWOOD	3 GAL.	C.G.
EC	EUDONYMUS ALATUS 'COMPACTA'	COMPACT BURNING BUSH	2"-3' HT.	B & B
JG	JUNIPERUS CHINENSIS 'SEA GREEN'	SEA GREEN JUNIPER	18" HT.	C.G.
TREES				
CL	CLADRASTIS LUTEA	YELLOW WOOD	2" CAL.	B & B
GRASSES				
PH	PENNISETUM ALOPECUROIDES 'HADELIN'	DWARF FOUNTAIN GRASS	#3 POT	-


NOTE:
1. CONTRACTOR SHALL INSTALL BENDS ALONG WATER MAINS AND FORCE MAINS NECESSARY TO MAINTAIN LOCATION OF UTILITY AS SHOWN ON THE PLAN.

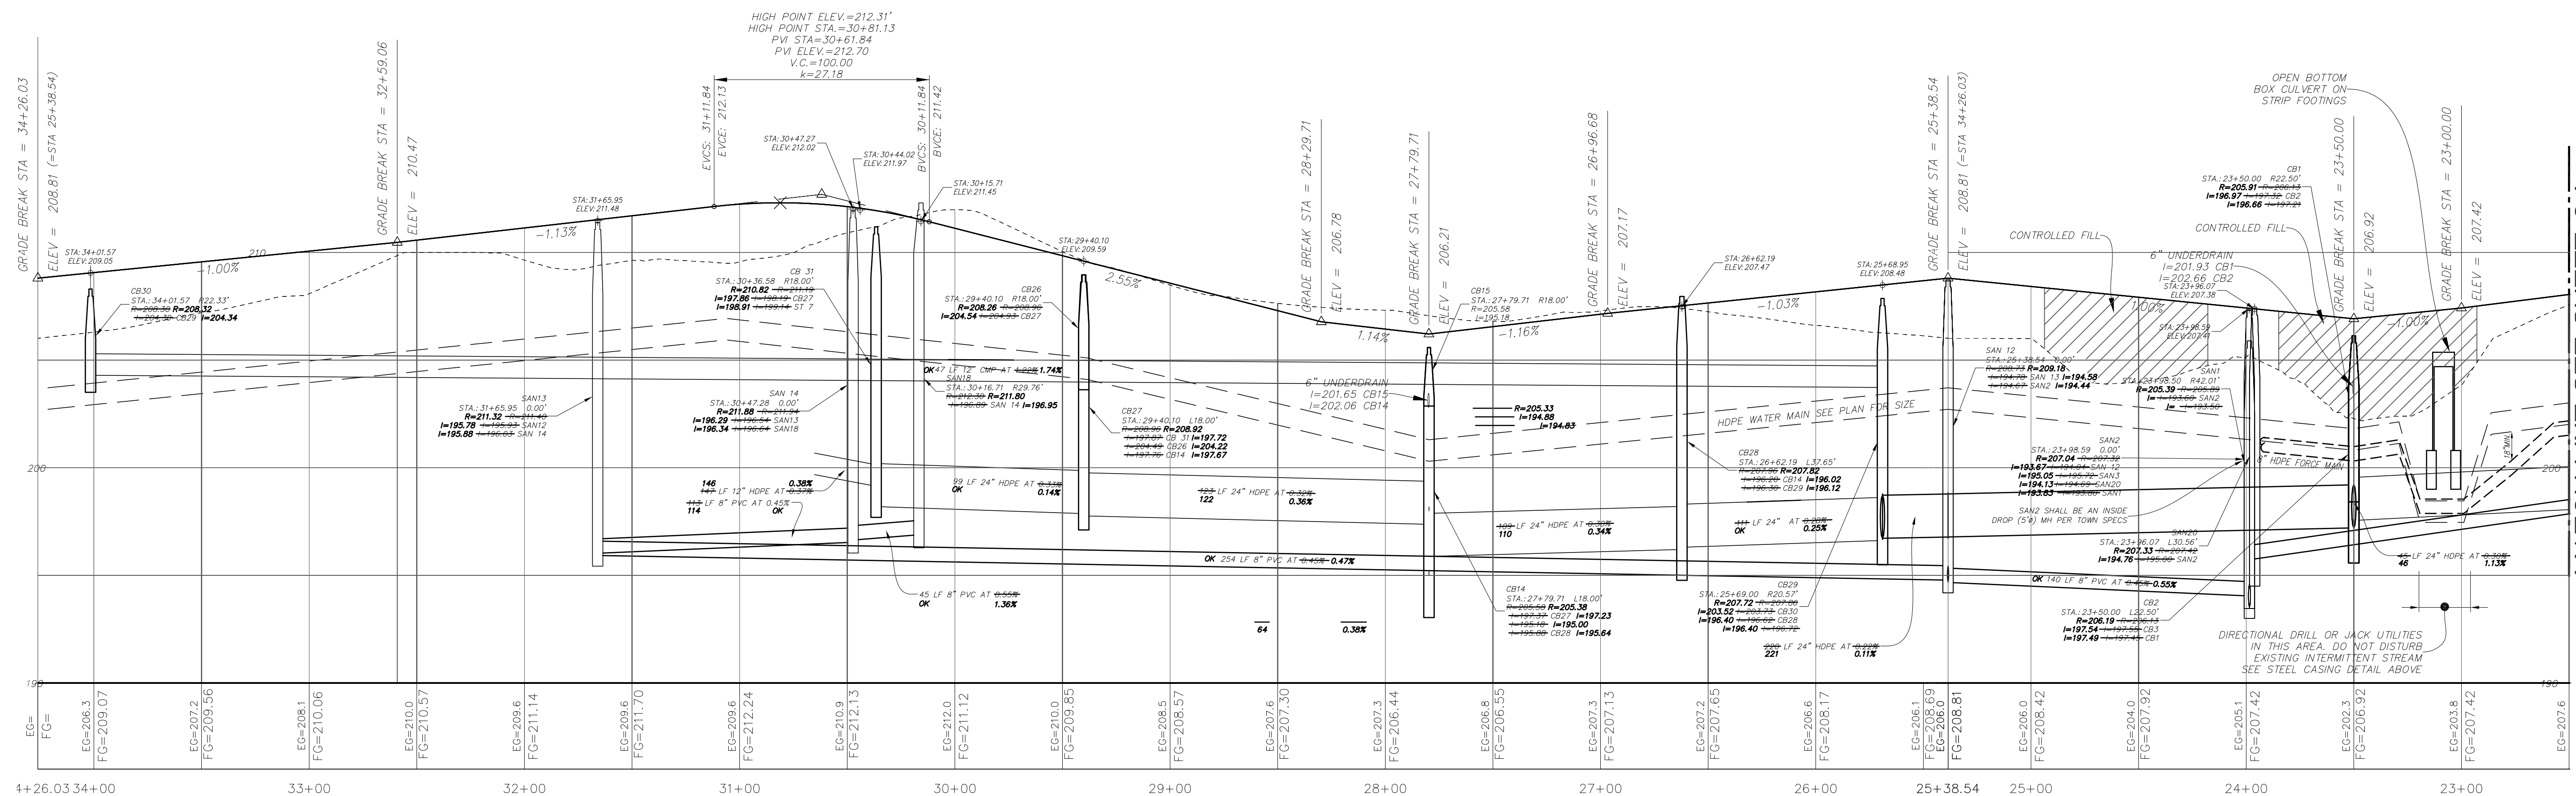

VISTA BOULEVARD PROFILE

NOTE:
RECORD INFORMATION SHOWN HEREON OBTAINED BY INGALLS & ASSOCIATES LLP FROM A FIELD SURVEY CONDUCTED AUGUST 8, 2012 THROUGH AUGUST 13, AND REFLECTS CONDITIONS EXISTING AT THOSE OCCASIONS.

SANITARY SEWER, STORM SEWER AND HYDRANT & WATER VALVE TIE RECORD PLAN (LAST REVISED 10-16-12)

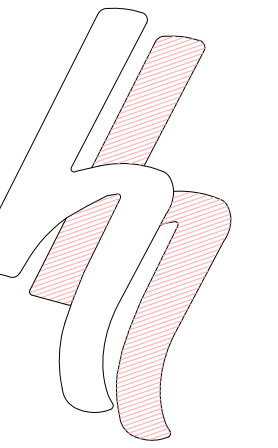

HERSHBERG & HERSHBERG
Consulting Engineers
and Land Surveyors

18 Locust Street
Albany, New York 12203

ALTERATION OF THIS DOCUMENT EXCEPT BY A LICENSED PROFESSIONAL ENGINEER OR LAND SURVEYOR, IS ILLEGAL

REVISIONS	DATE	REMARKS
1	5/11/11	GAS & ELEC
2	11/1/11	ELECTRIC SWITCH GEARS
3	12/8/11	ELECTRIC SWITCH GEARS
4	4/12/12	COMMUNICATIONS

PUBLIC INFRASTRUCTURE CONSTRUCTION
VISTA TECHNOLOGY CAMPUS
TOWN OF BETHLEHEM
ALBANY COUNTY, STATE OF NEW YORK

FILE: 110027 SCALE: H=1"=40' V=1"=4' GY: WM DATE: 2/18/11 GNC: DHI 110027-1.dwg