

HERSHBERG
&
HERSHBERG


Consulting Engineers
and Land Surveyors
18 Locust Street
Albany, New York 12203

ALTERATION OF THIS
DOCUMENT EXCEPT BY A
LICENSED PROFESSIONAL
ENGINEER OR LAND
SURVEYOR, IS ILLEGAL


REMARKS	DATE
<input type="checkbox"/> ELECTRIC	5/10/12
REVISIONS	

PUBLIC INFRASTRUCTURE CONSTRUCTION
VISTA TECHNOLOGY CAMPUS
TOWN OF BETHLEHEM
ALBANY COUNTY, STATE OF NEW YORK

SCALE: 1:100	FILE: 110027-1.dwg
DATE: 2/7/11	CHK: DRH
BY: JMW	FILE: 110027-1.dwg

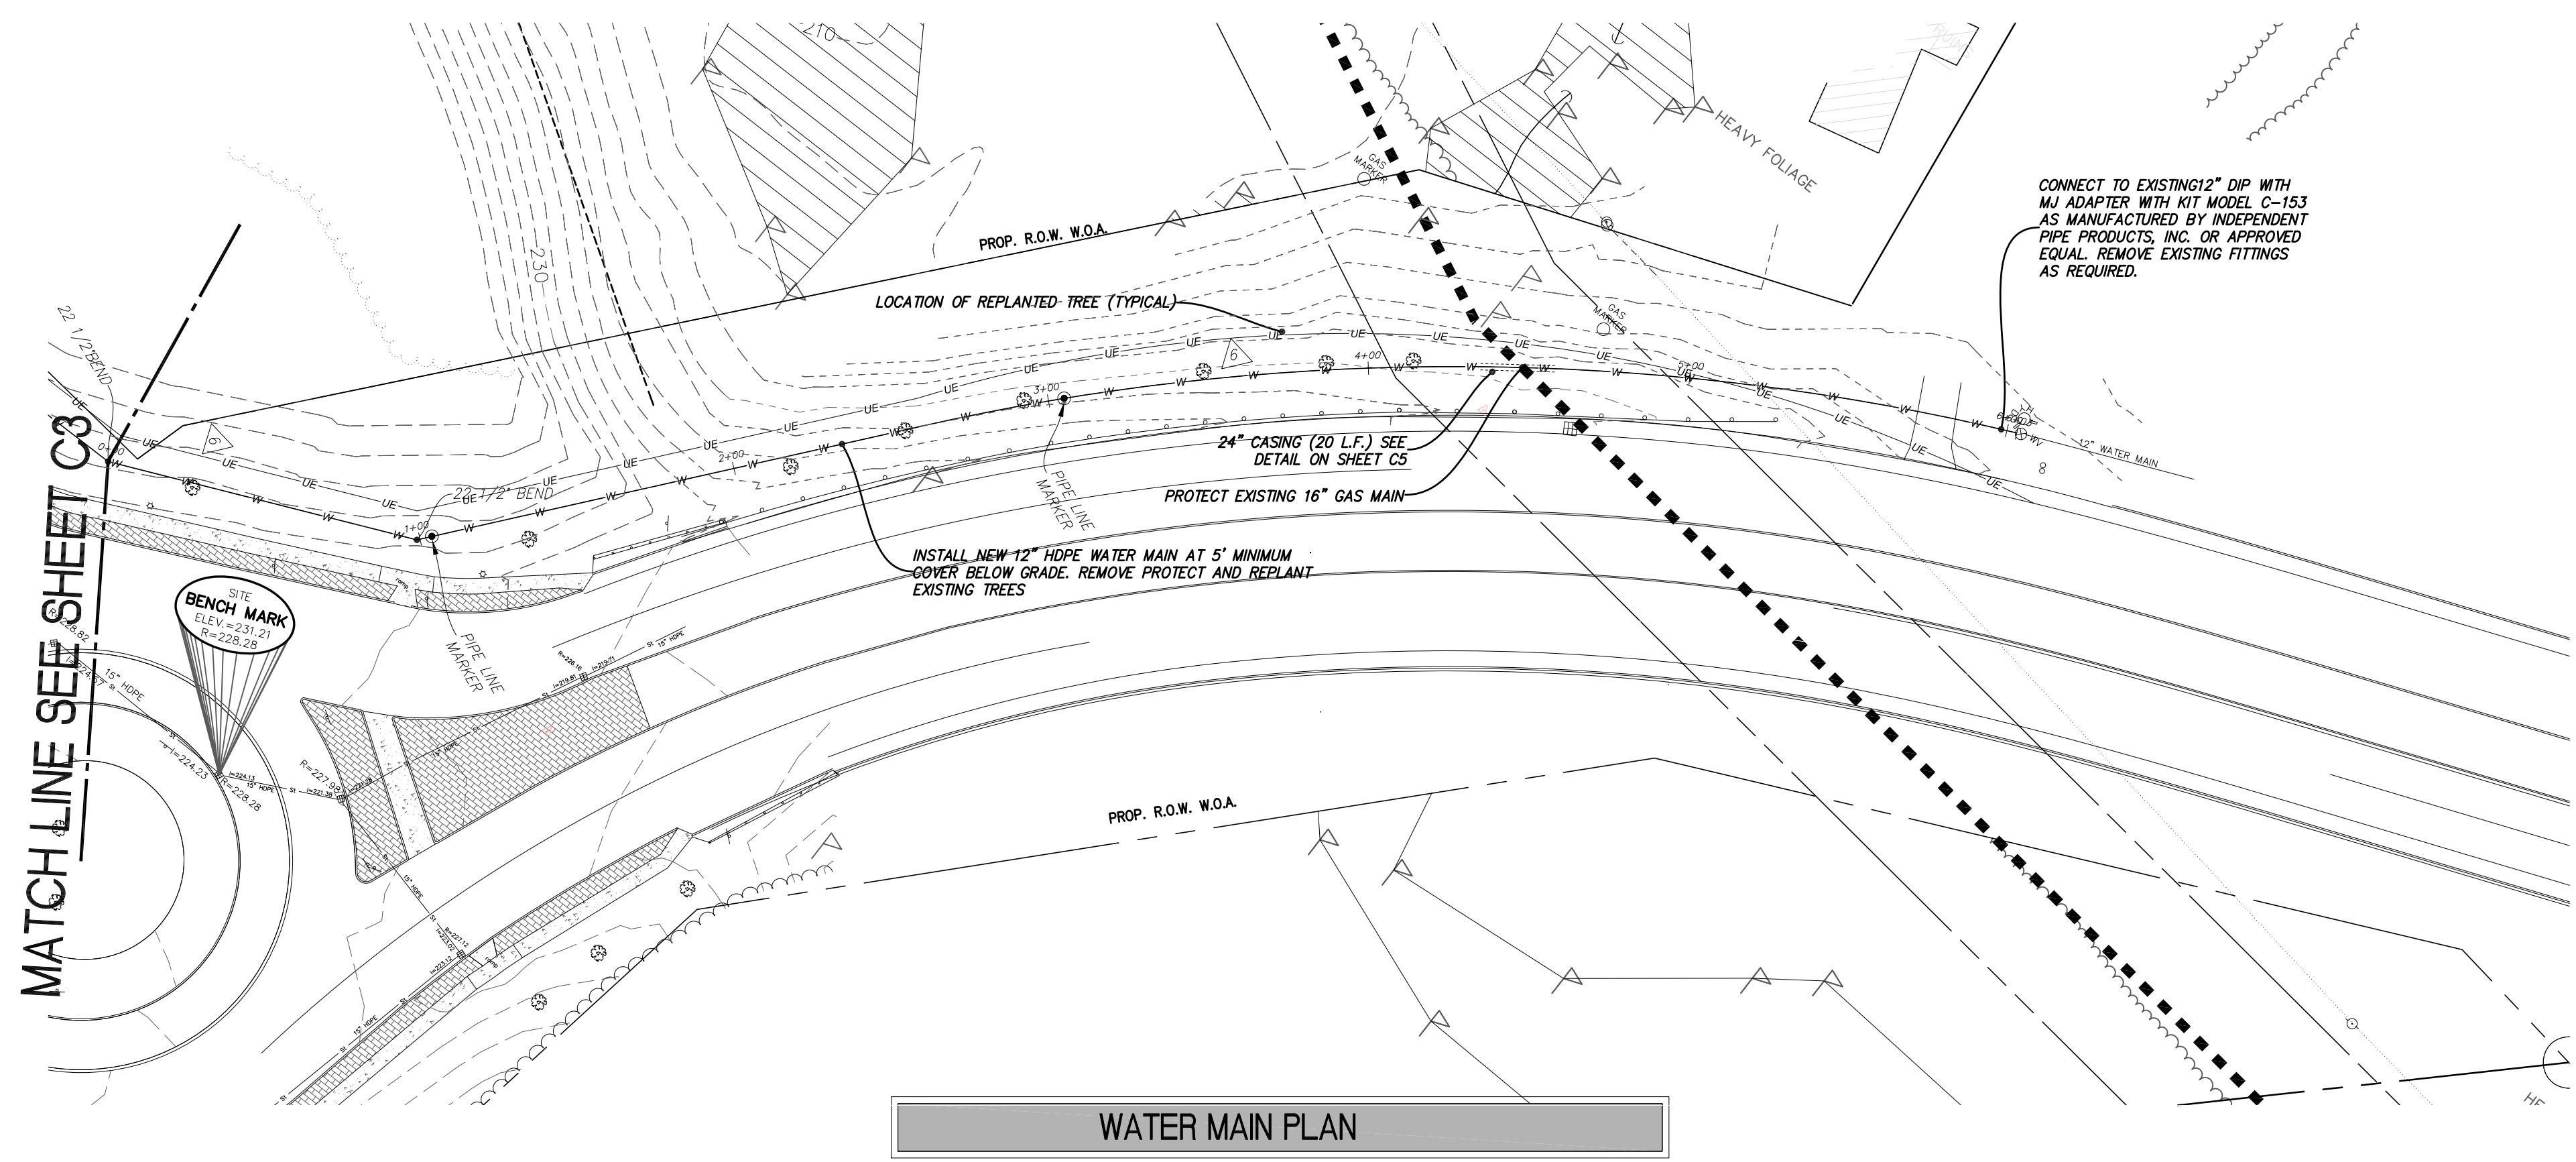

NOTE: INSTALL PIPE LINE MARKERS IN ACCORDANCE WITH TOWN'S STANDARD SPECIFICATION FOR THE WATER MAIN SHOWN HEREON.

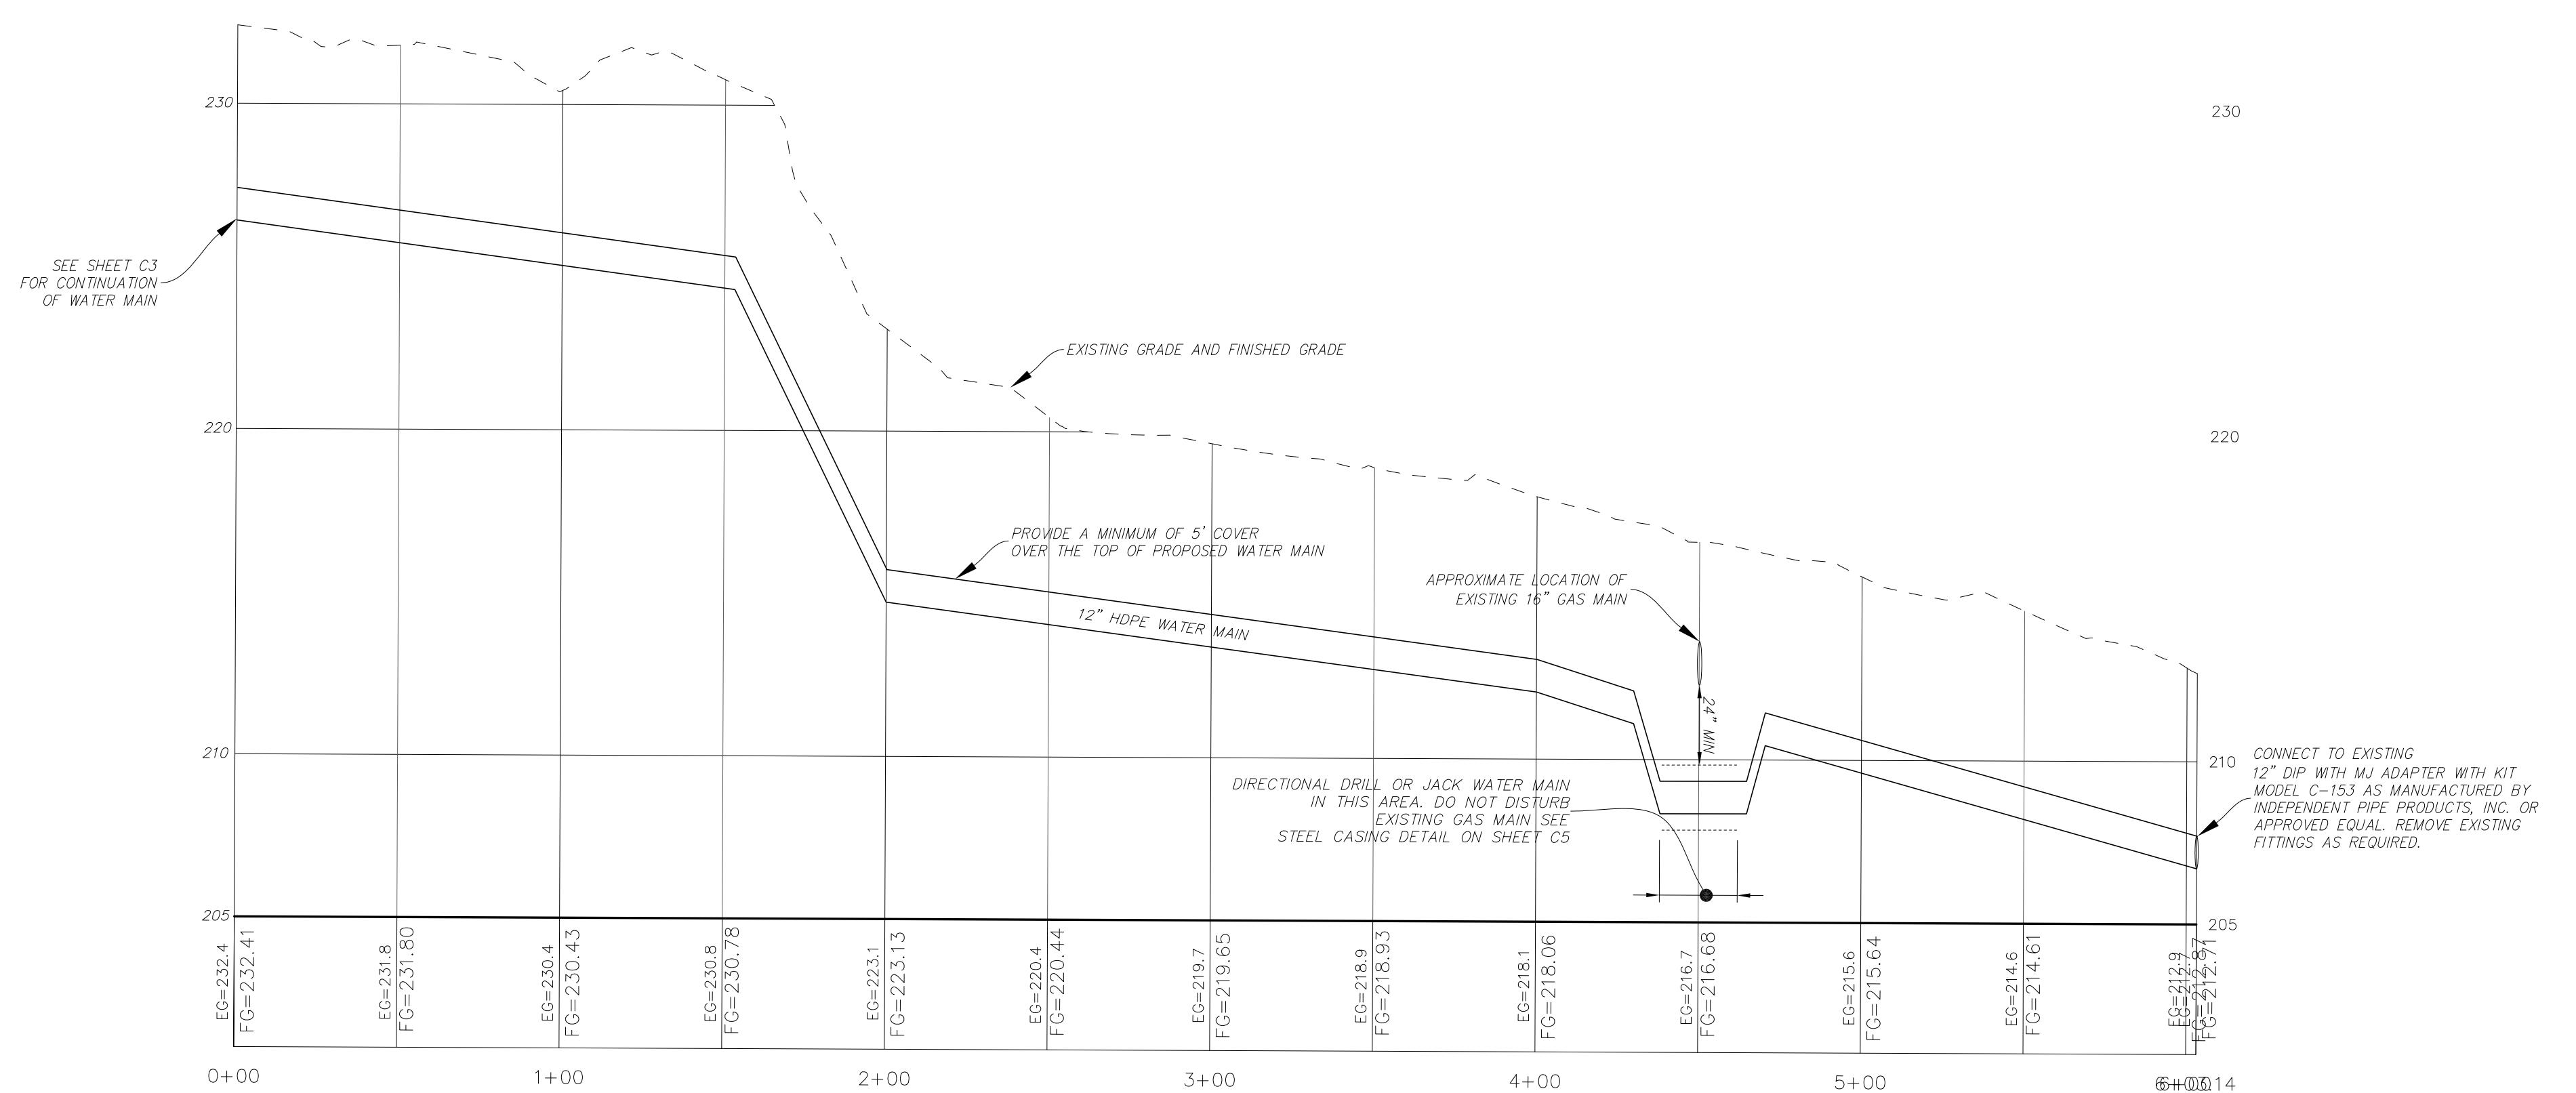

WATER MAIN PROFILE

SANITARY SEWER, STORM SEWER AND
HYDRANT & WATER VALVE TIE
RECORD PLAN (LAST REVISED 10-16-12)

C13