



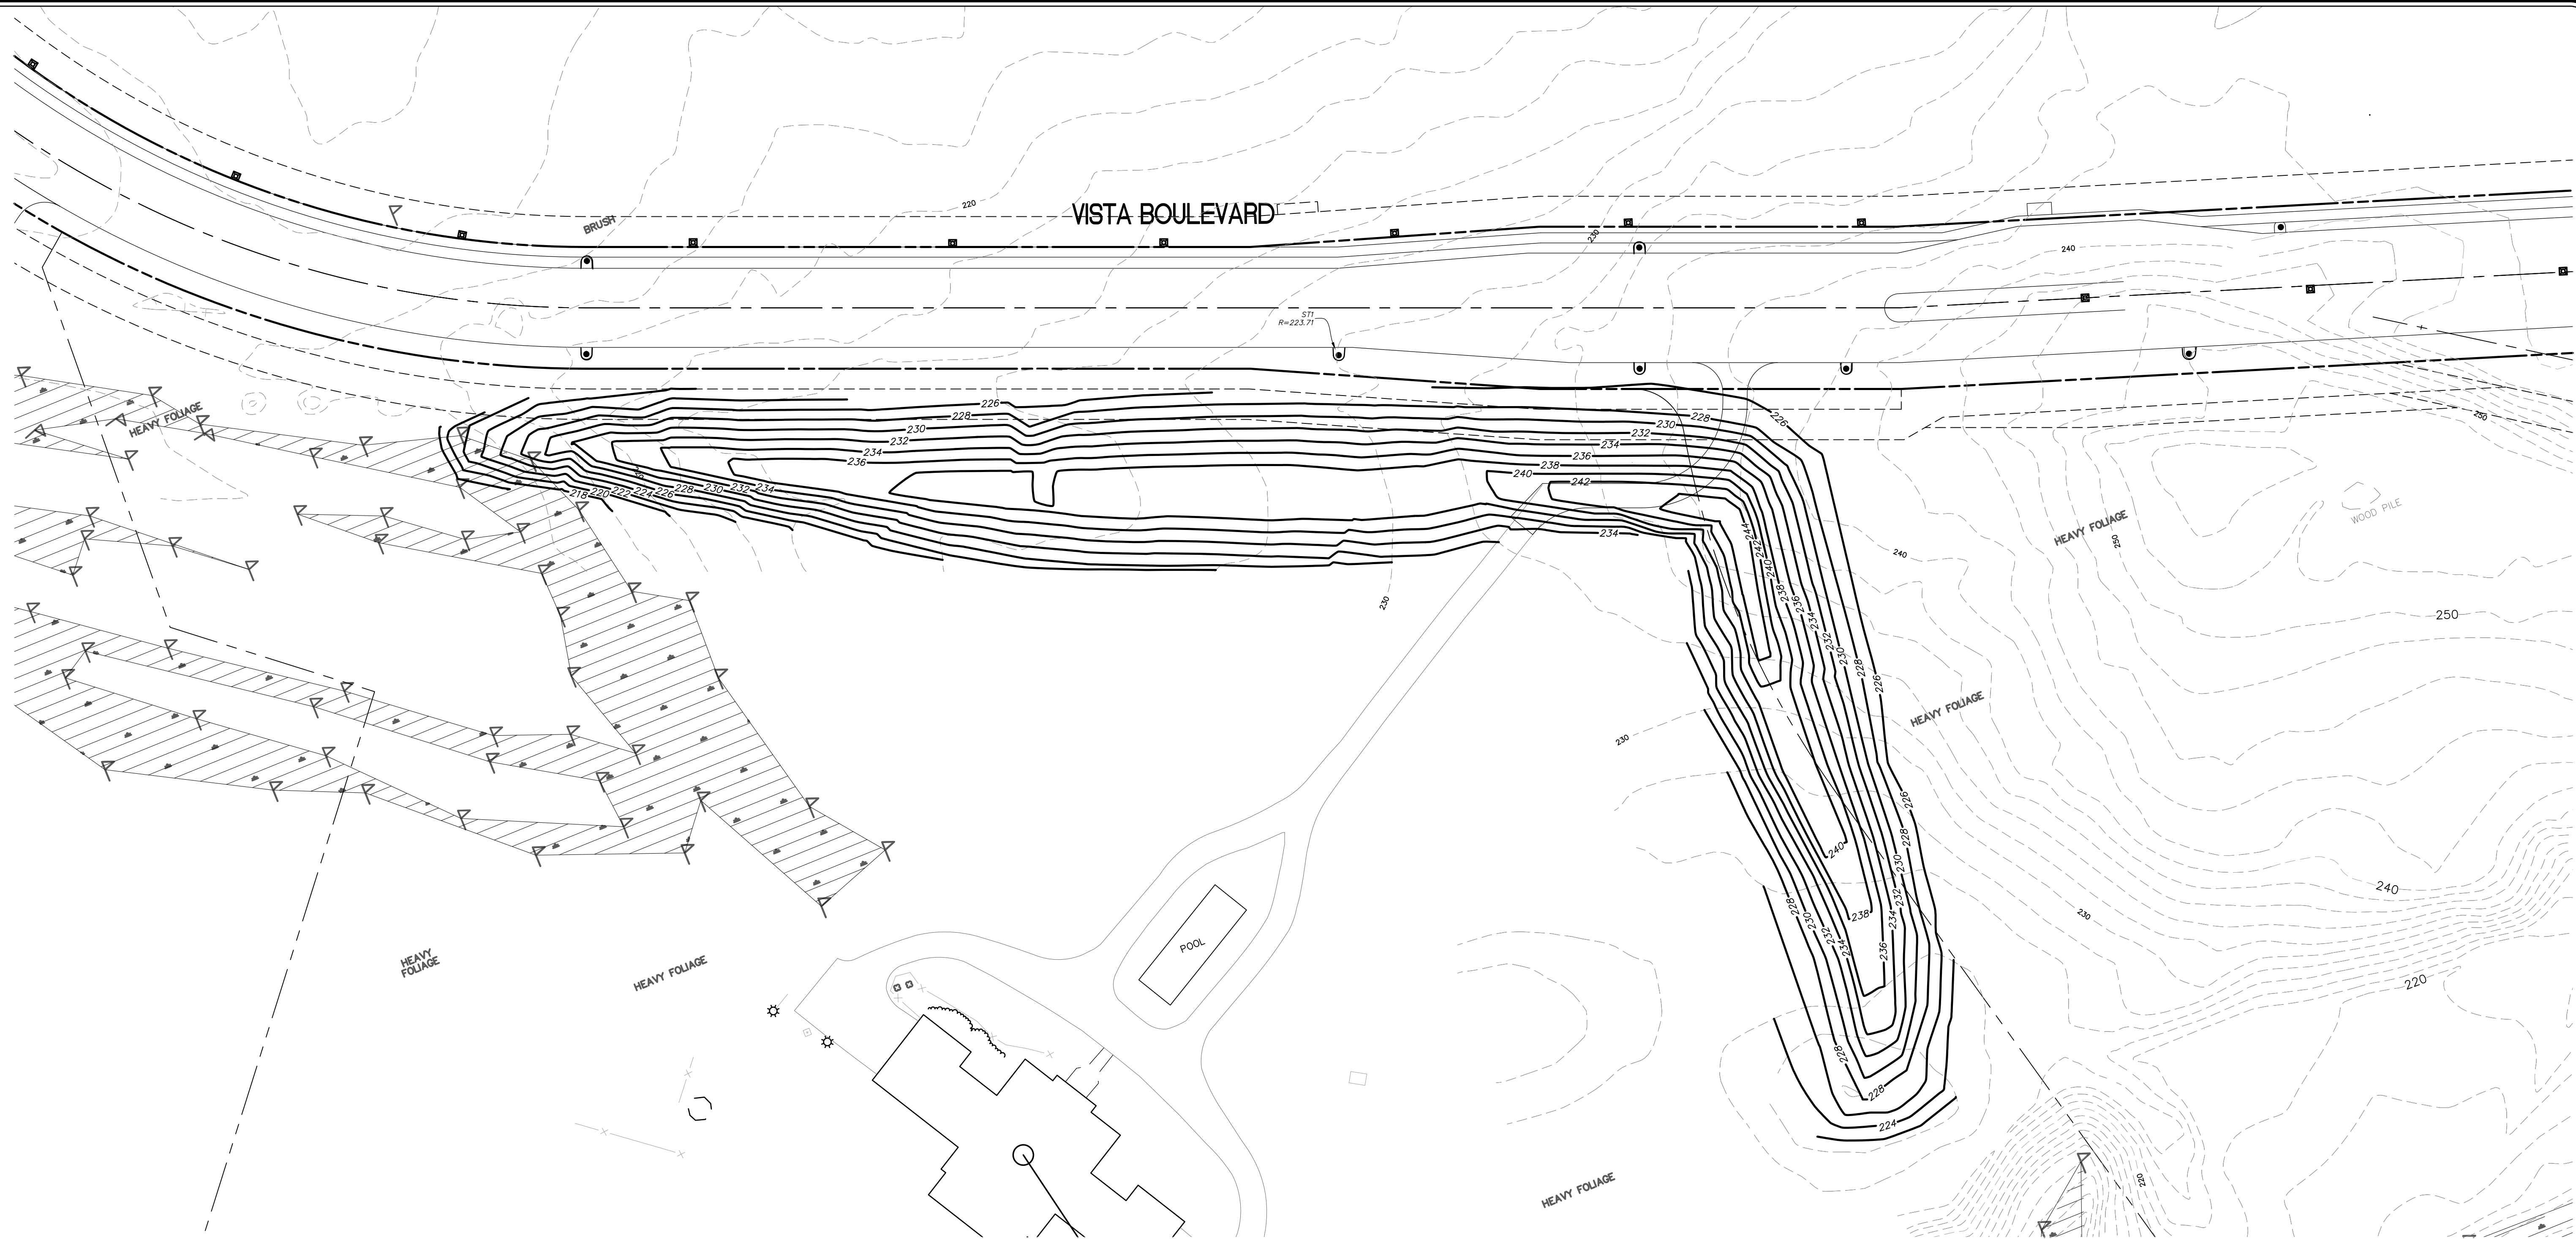

SCREENING BERM
RECORD PLAN (LAST REVISED 11-7-12)

NOTE:
RECORD INFORMATION SHOWN HEREON OBTAINED BY
INGALLS & ASSOCIATES LLP FROM A FIELD SURVEY
CONDUCTED AUGUST 8, 2012 THROUGH NOVEMBER 5, 2012
AND REFLECTS CONDITIONS EXISTING AT THOSE
OCCASIONS RELATIVE TO SCREENING BERM ONLY.

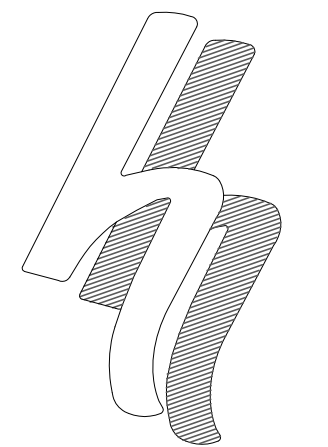

**HERSHBERG
&
HERSHBERG**

Consulting Engineers
and Land Surveyors

18 Locust Street
Albany, New York 12203

ALTERATION OF THIS
DOCUMENT EXCEPT BY A
LICENSED PROFESSIONAL
ENGINEER OR LAND
SURVEYOR, IS ILLEGAL.

REVISIONS	DATE	REMARKS
1	11/1/11	ELECTRIC SWITCH GEARS
2	12/8/11	ELECTRIC SWITCH GEARS
3	4/12/12	COMMUNICATIONS
4	4/17/12	ELEC. SWITCH GEAR STA 5+00
5	5/10/12	ELEC. SWITCH GEAR STA 4+60
6	5/16/12	MEDIAN FROM PHASE 1B

PUBLIC INFRASTRUCTURE CONSTRUCTION
VISTA TECHNOLOGY CAMPUS
TOWN OF BETHLEHEM
ALBANY COUNTY, STATE OF NEW YORK

FILE: 110027
SCALE: H:T=40 V:T=4'
DATE: 2/18/11
CHK: DRH
BY: WM
110027-1.dwg