

Micheli Contracting

Blessings Corners

Pre-Acceptance Inspection

7-7-2014

Bethlehem, NY

Disc 1



Kenyon Pipeline Inspection

22 Helen Drive
Queensbury, NY 12804
518-926-9843 ph
518-348-3040 fx
www.kpisewer.com



Profile Report (Section)

Project Name: BLESSINGS CORNER	Project Number: 1	Contact:	Date: 7/7/2014
--	-----------------------------	----------	--------------------------

No.	US MH	DS MH	Date	Street	Tape No.	Material	ft	(ft)
1	MH 4	MH 3	7/7/2014	BLESSINGS CORNERS		Polyvinyl Chloride	150.80	150.80
2	MH 3	MH 2	7/7/2014	BLESSINGS CORNERS		Polyvinyl Chloride	214.60	214.60
3	MH 2	MH 1	7/7/2014	BLESSINGS CORNERS		Polyvinyl Chloride	75.20	75.20
4	MH 1	EXT MH	7/7/2014	BLESSINGS CORNERS		Polyvinyl Chloride	109.80	109.80
5	MH 6	MH 5	7/7/2014	BLESSINGS CORNERS		Polyvinyl Chloride	365.00	365.00
6	MH 7	MH 6	7/7/2014	BLESSINGS CORNERS		Polyvinyl Chloride	215.60	215.60

Pipe size: Circular 8/0 = 1131.00 ft (1131.00 ft)

All sections = 1131.00 ft (1131.00 ft)



Inspection report

Date : 7/7/2014	Work Order : BLESSINGS CORNER BETHLEHEM NY.1	Weather : Dry	Surveyed By : EP	Certificate Number :	Pipe Segment Ref. : MH 4-MH 3
Year laid :	Pre-cleaning : 1	Direction : Downstream	Pipe Joint Length :	Total Length : 150.8	Length Surveyed : 150.8

City : BETHLEHEM NY	Drainage Area :	Upstream MH : MH 4
Street : BLESSINGS CORNERS	Media Label :	Up Rim to Invert : 0.0
Location Code :	Flow Control :	Downstream MH : MH 3
Location Details :	Sheet Number :	Down Rim to Invert : 0.0

Pipe shape : Circular	Sewer Use : Sanitary
Pipe size : 8	Sewer Category : SEC
Pipe material : Polyvinyl Chloride	Purpose : Pre-Acceptance- New Sewers
Lining Method :	Owner : BETHLEHEM

Additional Info :

1:1397	Distance	Code	Observation	Counter	Photo	Grade
	0.00	AMH	Upstream Manhole, Survey Begins / MH 4	00:00:13		
	57.60	TFA	Tap Factory Made Active, at 09 o'clock, 6", within 8 inches of joint: YES	00:02:18		
	60.50	TFA	Tap Factory Made Active, at 02 o'clock, 6", within 8 inches of joint: YES	00:02:43		
	150.80	AMH	Downstream Manhole, Survey Ends / MH 3	00:05:28		
QSR	QMR	SPR	MPR	OPR	SPRI	MPRI
						OPRI



Inspection report


Date : 7/7/2014	Work Order : BLESSINGS CORNER BETHLEHEM NY.1	Weather : Dry	Surveyed By : EP	Certificate Number :	Pipe Segment Ref. : MH 3-MH 2
Year laid :	Pre-cleaning : 1	Direction : Downstream	Pipe Joint Length :	Total Length : 214.6	Length Surveyed : 214.6

City : BETHLEHEM NY	Drainage Area :	Upstream MH : MH 3
Street : BLESSINGS CORNERS	Media Label :	Up Rim to Invert : 0.0
Location Code :	Flow Control :	Downstream MH : MH 2
Location Details :	Sheet Number :	Down Rim to Invert : 0.0

Pipe shape: Circular	Sewer Use: Sanitary
Pipe size: 8	Sewer Category : SEC
Pipe material: Polyvinyl Chloride	Purpose: Pre-Acceptance- New Sewers
Lining Method :	Owner : BETHLEHEM

Additional Info :

1:1988	Distance	Code	Observation	Counter	Photo	Grade
--------	----------	------	-------------	---------	-------	-------

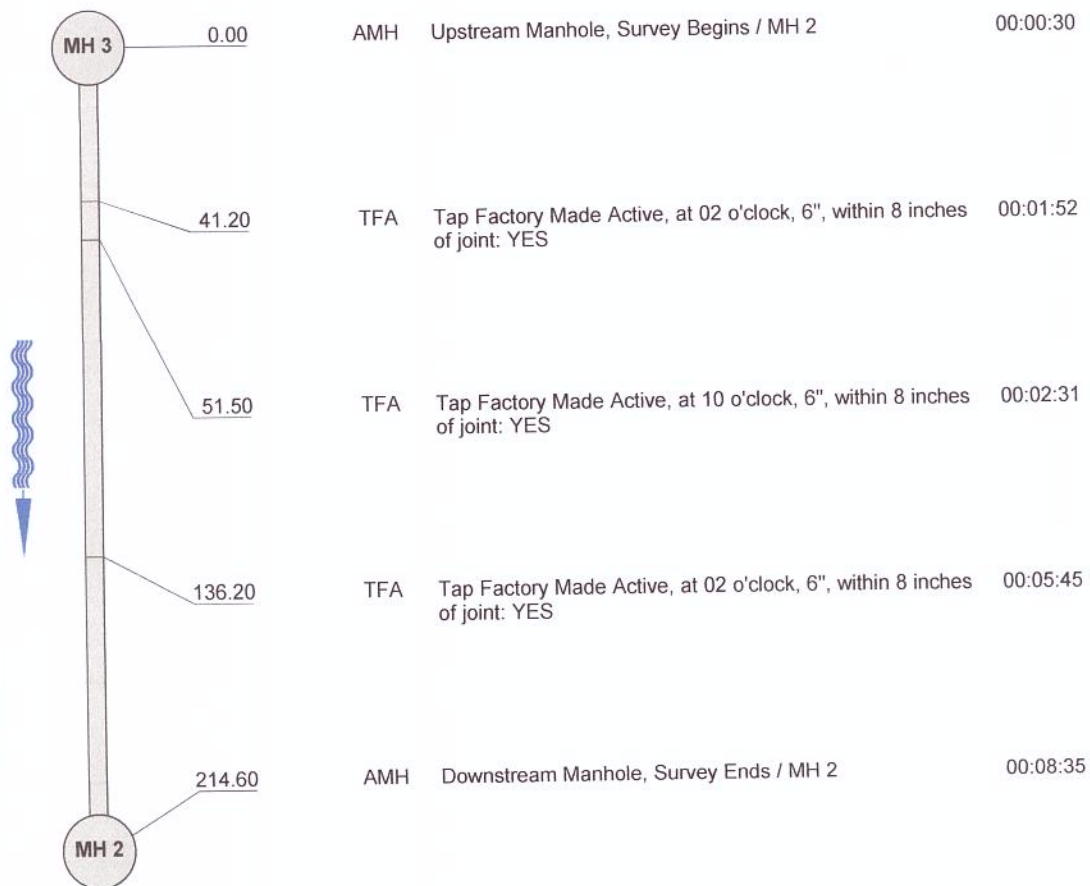

QSR

QMR

SPR

MPR

OPR

SPRI

MPRI

OPRI



Inspection report

Date : 7/7/2014	Work Order : BLESSINGS CORNER BETHLEHEM NY.3	Weather : Dry	Surveyed By : EP	Certificate Number :	Pipe Segment Ref. : MH 2-MH 1
Year laid :	Pre-cleaning : 1	Direction : Downstream	Pipe Joint Length :	Total Length : 75.2	Length Surveyed : 75.2

City : BETHLEHEM NY	Drainage Area :	Upstream MH : MH 2
Street : BLESSINGS CORNERS	Media Label :	Up Rim to Invert : 0.0
Location Code :	Flow Control :	Downstream MH : MH 1
Location Details :	Sheet Number :	Down Rim to Invert : 0.0
Pipe shape: Circular	Sewer Use: Sanitary	
Pipe size: 8	Sewer Category : SEC	
Pipe material: Polyvinyl Chloride	Purpose: Pre-Acceptance- New Sewers	
Lining Method :	Owner : BETHLEHEM	
Additional Info :		

1:697	Distance	Code	Observation	Counter	Photo	Grade
	0.00	AMH	Upstream Manhole, Survey Begins / MH 2	00:00:17		
	30.20	TFA	Tap Factory Made Active, at 02 o'clock, 6", within 8 inches of joint: YES	00:01:31		
	75.20	AMH	Downstream Manhole, Survey Ends / MH 1	00:03:25		
QSR	QMR	SPR	MPR	OPR	SPRI	MPRI
						OPRI



Inspection report


Date : 7/7/2014	Work Order : BLESSINGS CORNER BETHLEHEM NY.1	Weather : Dry	Surveyed By : EP	Certificate Number :	Pipe Segment Ref. : MH 1-EXT MH
Year laid :	Pre-cleaning : 1	Direction : Downstream	Pipe Joint Length :	Total Length : 109.8	Length Surveyed : 109.8

City : BETHLEHEM NY	Drainage Area :	Upstream MH : MH 1
Street : BLESSINGS CORNERS	Media Label :	Up Rim to Invert : 0.0
Location Code :	Flow Control :	Downstream MH : EXT MH
Location Details :	Sheet Number :	Down Rim to Invert : 0.0

Pipe shape: Circular	Sewer Use: Sanitary
Pipe size: 8	Sewer Category : SEC
Pipe material: Polyvinyl Chloride	Purpose: Pre-Acceptance- New Sewers
Lining Method :	Owner : BETHLEHEM

Additional Info :

1:1017	Distance	Code	Observation	Counter	Photo	Grade
--------	----------	------	-------------	---------	-------	-------

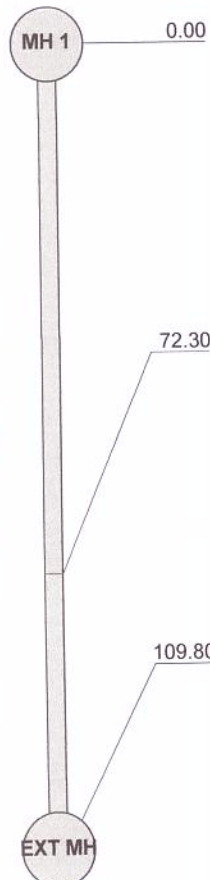	0.00	AMH	Upstream Manhole, Survey Begins / MH 1	00:00:16		
--	------	-----	--	----------	--	--

	72.30	TFA	Tap Factory Made Active, at 02 o'clock, 6", within 8 inches of joint: YES	00:03:33		
--	-------	-----	---	----------	--	--

	109.80	AMH	Downstream Manhole, Survey Ends / EXT MH	00:05:06		
--	--------	-----	--	----------	--	--

QSR	QMR	SPR	MPR	OPR	SPRI	MPRI	OPRI
-----	-----	-----	-----	-----	------	------	------



Inspection report

Date : 7/7/2014	Work Order : BLESSINGS CORNER BETHLEHEM NY.1	Weather : Dry	Surveyed By : EP	Certificate Number :	Pipe Segment Ref. : MH 7-MH 6
Year laid :	Pre-cleaning : 1	Direction : Downstream	Pipe Joint Length :	Total Length : 365.0	Length Surveyed : 365.0

City : BETHLEHEM NY	Drainage Area :	Upstream MH : MH 6
Street : BLESSINGS CORNERS	Media Label :	Up Rim to Invert : 0.0
Location Code :	Flow Control :	Downstream MH : MH 5
Location Details :	Sheet Number :	Down Rim to Invert : 0.0

Pipe shape : Circular	Sewer Use : Sanitary
Pipe size : 8	Sewer Category : SEC
Pipe material : Polyvinyl Chloride	Purpose : Pre-Acceptance- New Sewers
Lining Method :	Owner : BETHLEHEM

Additional Info :

1:3380	Distance	Code	Observation	Counter	Photo	Grade
--------	----------	------	-------------	---------	-------	-------

	0.00	AMH	Upstream Manhole, Survey Begins / MH 6	00:00:13		
--	------	-----	--	----------	--	--

	365.00	AMH	Downstream Manhole, Survey Ends / MH 5	00:10:43		
--	--------	-----	--	----------	--	--

QSR	QMR	SPR	MPR	OPR	SPRI	MPRI	OPRI
-----	-----	-----	-----	-----	------	------	------



Inspection report

Date : 7/7/2014	Work Order : BLESSINGS CORNER BETHLEHEM NY.1	Weather : Dry	Surveyed By : EP	Certificate Number :	Pipe Segment Ref. : MH 7-MH 6
Year laid :	Pre-cleaning : 1	Direction : Upstream	Pipe Joint Length :	Total Length : 215.6	Length Surveyed : 215.6

City : BETHLEHEM NY	Drainage Area :	Upstream MH : MH 7
Street : BLESSINGS CORNERS	Media Label :	Up Rim to Invert : 0.0
Location Code :	Flow Control :	Downstream MH : MH 6
Location Details :	Sheet Number :	Down Rim to Invert : 0.0

Pipe shape: Circular	Sewer Use: Sanitary
Pipe size: 8	Sewer Category : SEC
Pipe material: Polyvinyl Chloride	Purpose: Pre-Acceptance- New Sewers
Lining Method :	Owner : BETHLEHEM

Additional Info :

1:1997	Distance	Code	Observation	Counter	Photo	Grade	
	0.00	AMH	Downstream Manhole, Survey Begins / MH 6	00:00:10			
	93.00	TFA	Tap Factory Made Active, at 02 o'clock, 6", within 8 inches of joint: YES	00:03:13			
	205.10	TFA	Tap Factory Made Active, at 02 o'clock, 6", within 8 inches of joint: YES	00:06:38			
	215.60	AMH	Upstream Manhole, Survey Ends / MH 7	00:07:07			
QSR	QMR	SPR	MPR	OPR	SPRI	MPRI	OPRI