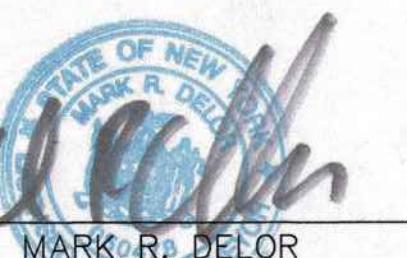
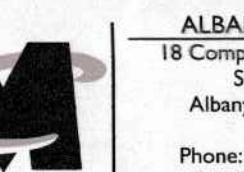


REV	DATE	DRAWING	DESCRIPTION
-	11/20/17	1	REVISED BIR DRAIN COMMENTS
REV	DATE	DRAWN BY	DESCRIPTION
-			
UNAUTHORIZED ALTERATION OR ADDITION TO A SURVEYED MAP BEARING A LICENSED LAND SURVEYOR'S SEAL IS A VIOLATION OF THE NEW YORK STATE EDUCATION LAW. ONLY BOUNDARY SURVEY MAPS WITH THE SURVEYOR'S SEAL ARE LEGAL SURVEY MAPS. THIS IS NOT A SURVEYOR'S ORIGINAL WORK AND OPINION.			
 MARK R. DELOR NEW YORK STATE PROFESSIONAL LAND SURVEYOR LIC. NO. 050478			
AS-BUILT SURVEY FOR BENDER FARMS			
OVERALL AS-BUILT			
TOWN OF BETHLEHEM COUNTY OF ALBANY STATE OF NEW YORK			
 ALBANY OFFICE 18 Computer Drive East Suite 203 Albany, NY 12205 Phone: 518.459.2525 Fax: 518.459.3284			
SCALE: DATE: DRAWN BY: CHECKED BY: AS SHOWN 10/31/17 MMW PROJECT NUMBER: 1700077A DRAWING NUMBER: BENDER FARMS SHEET NUMBER: 01 OF 01			
TOWN OF BETHLEHEM, NEW YORK DEPARTMENT OF PUBLIC WORKS - OFFICE COPY - AS-BUILT			