

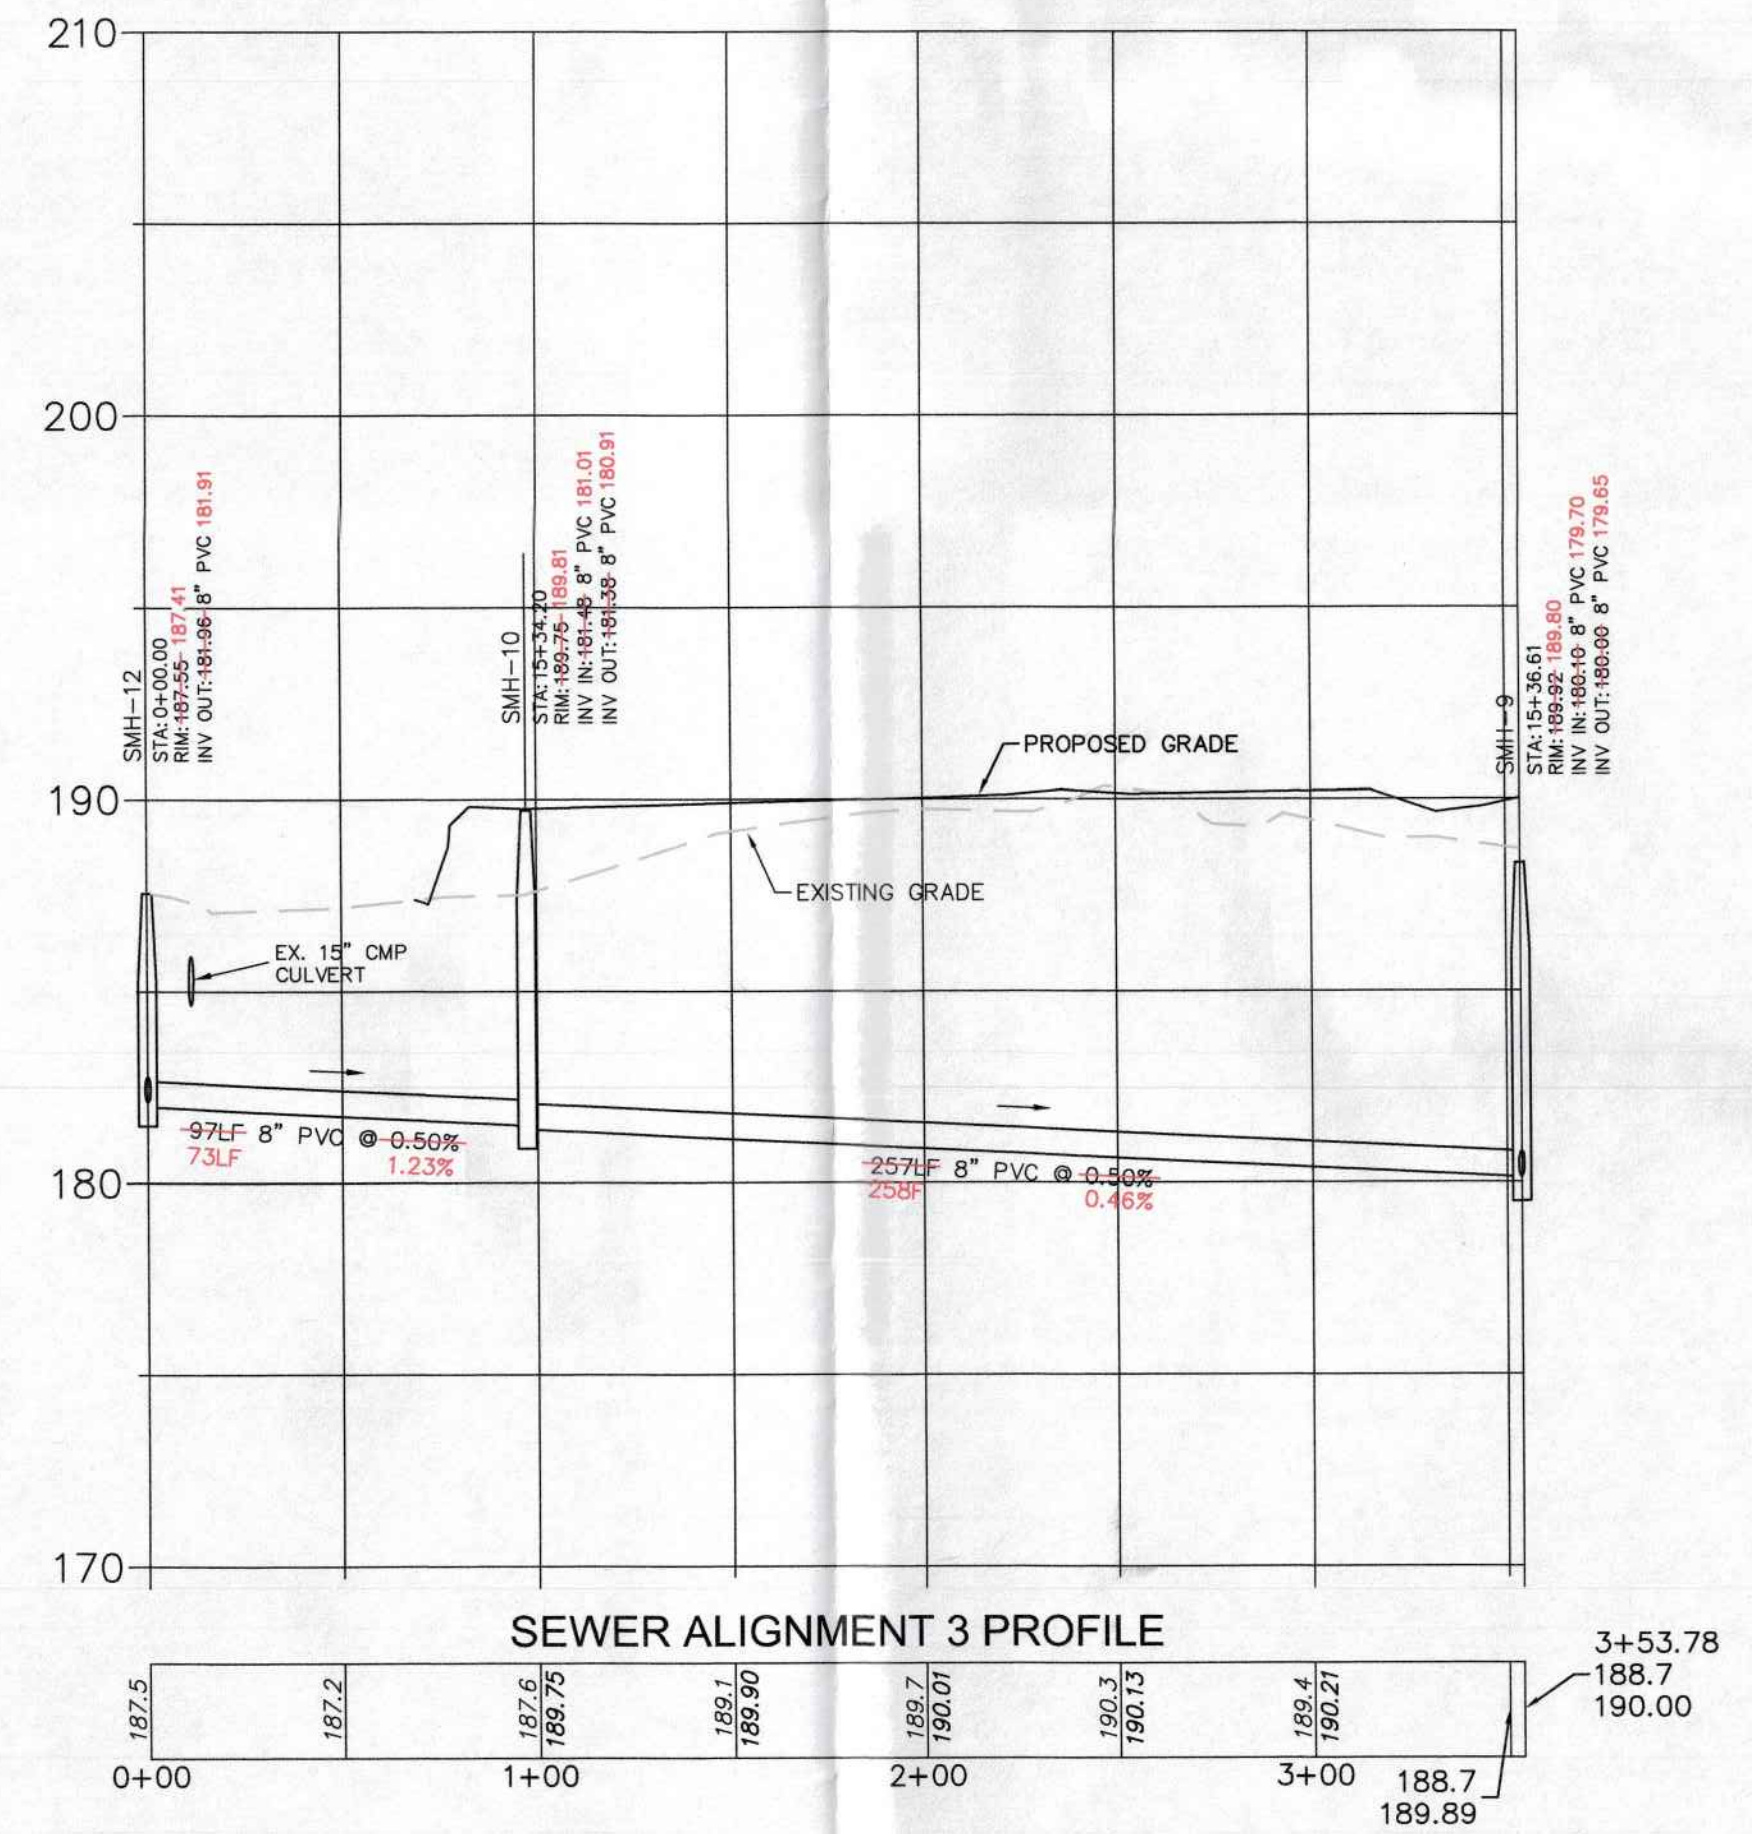
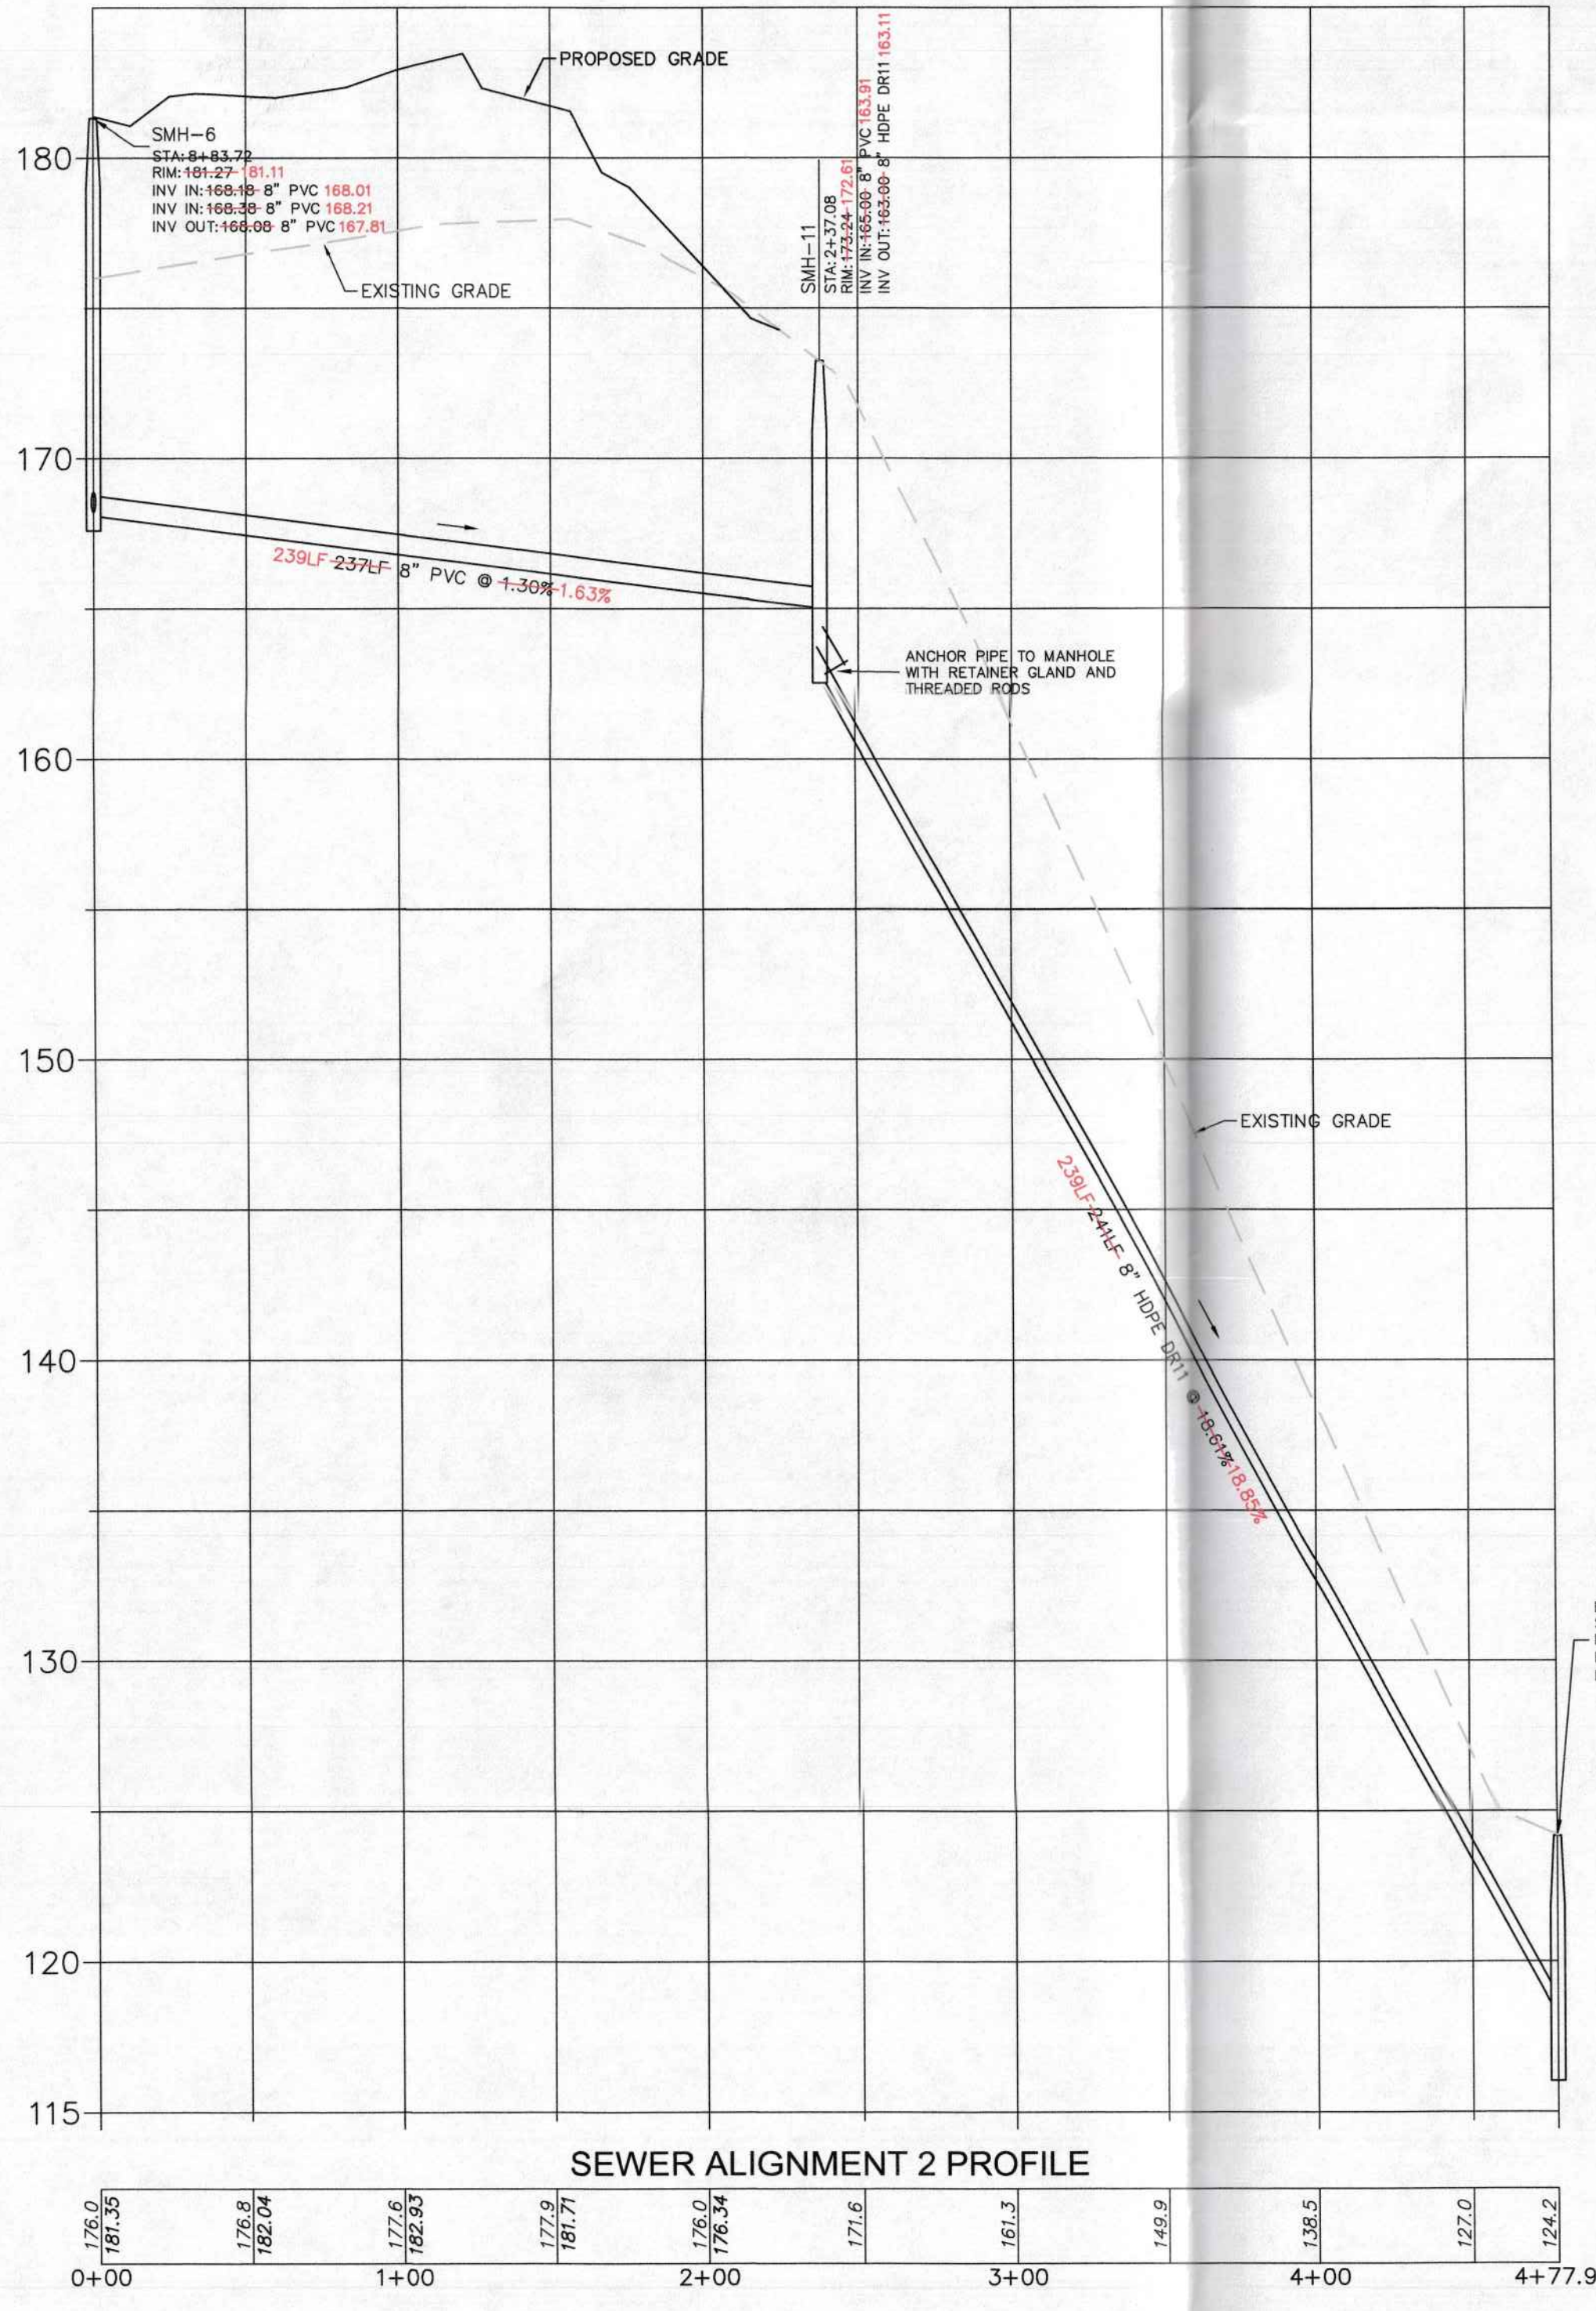
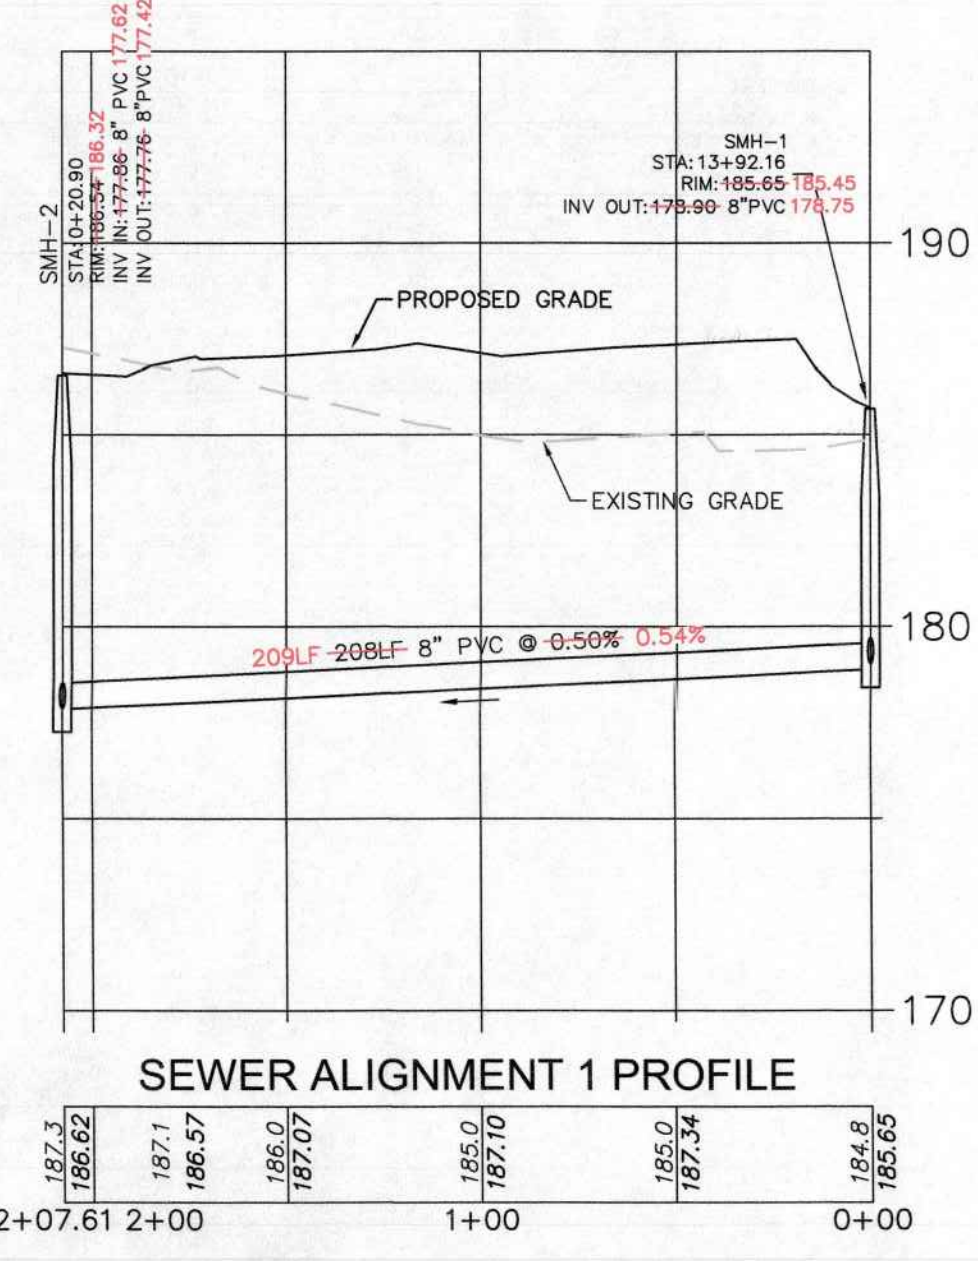


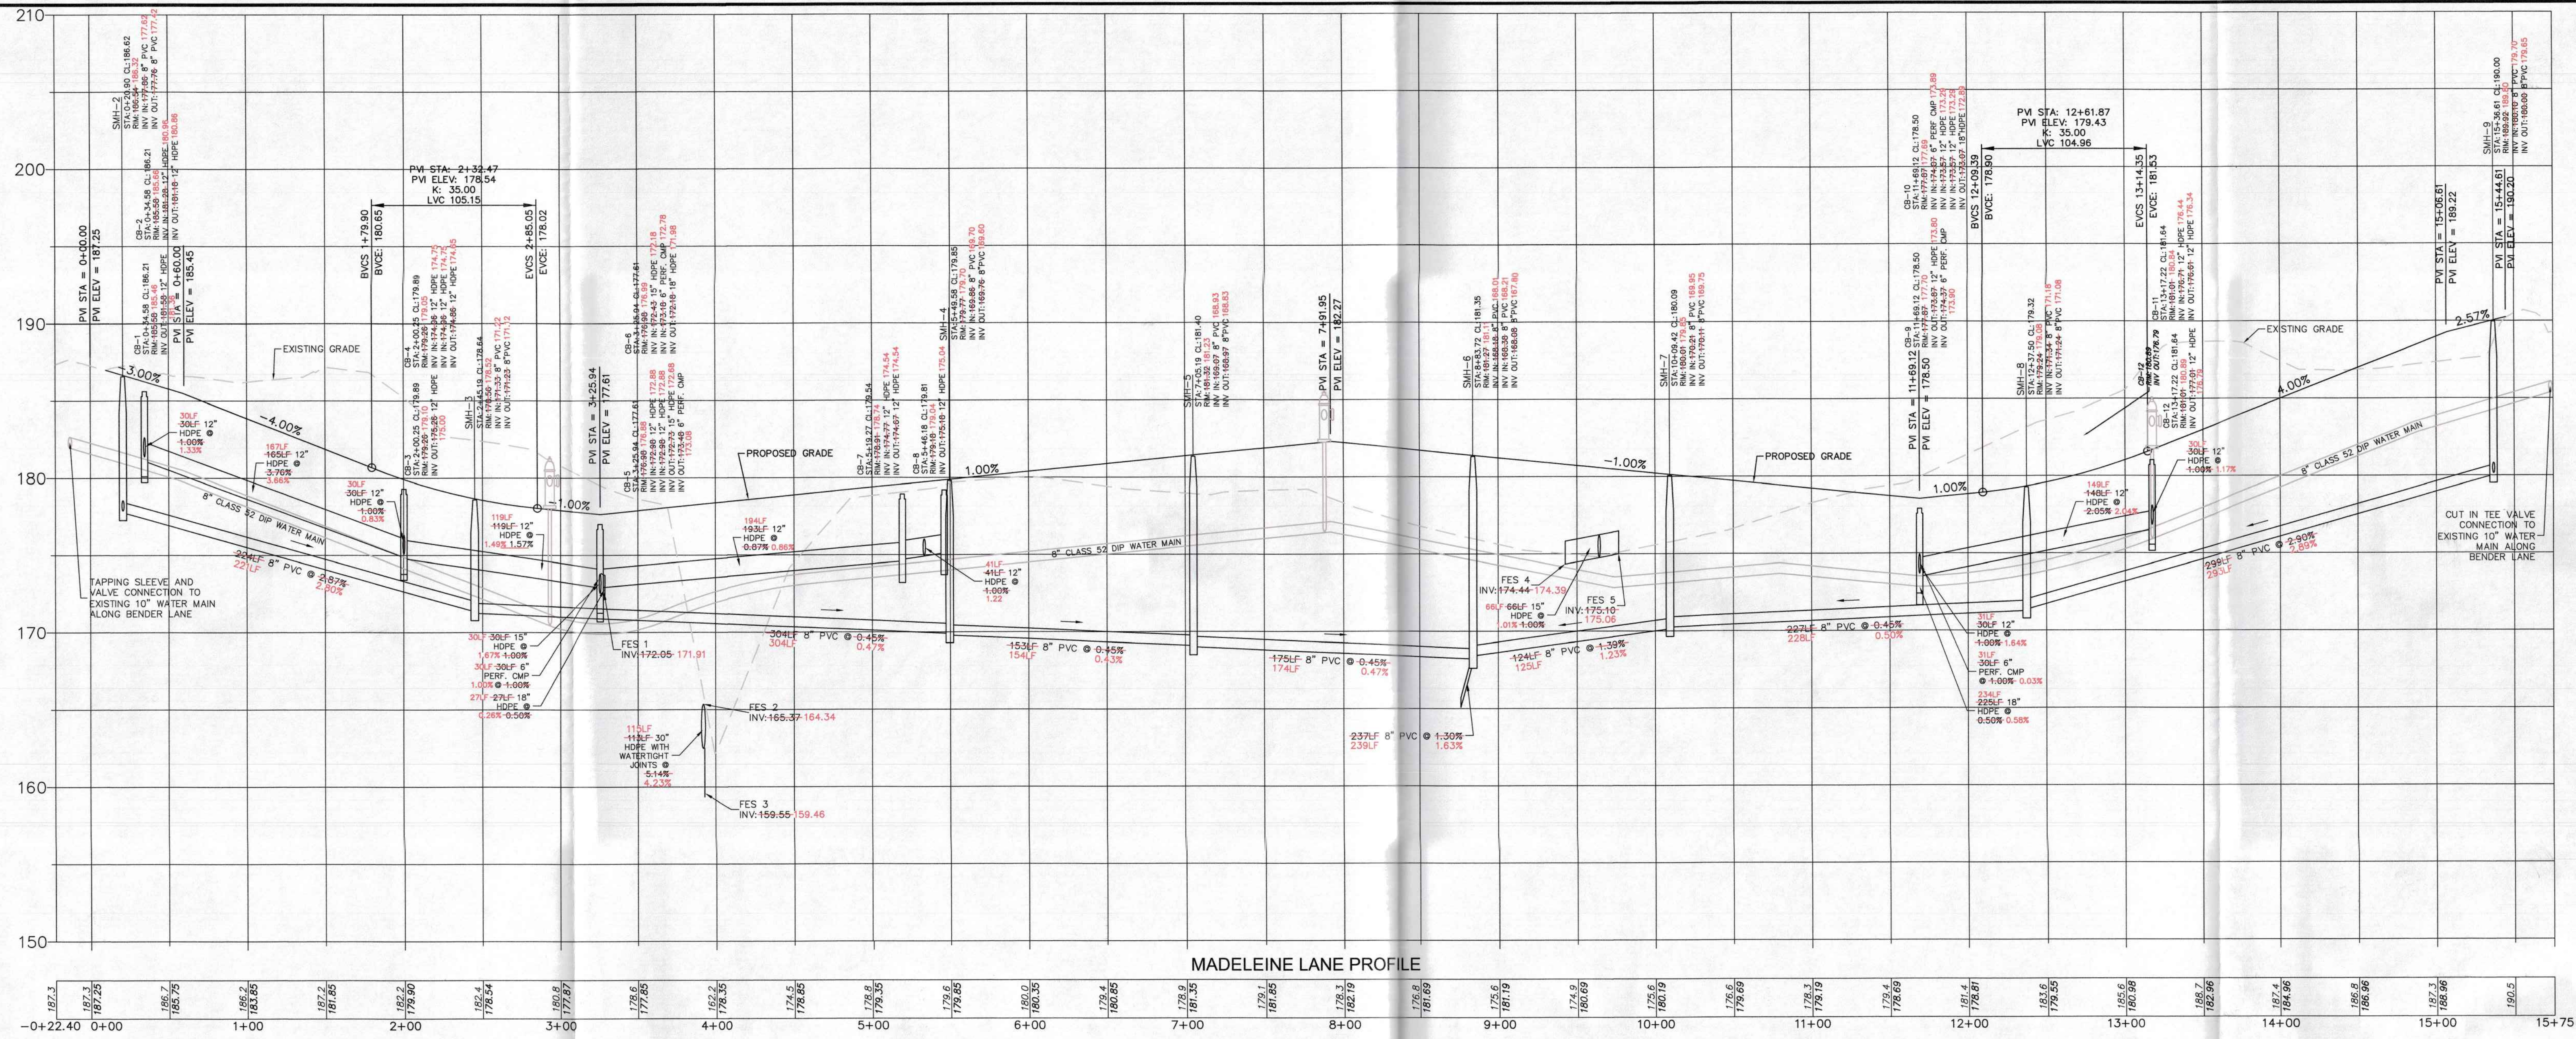

GENERAL NOTES:
 1. UNDERGROUND UTILITIES SHOWN HEREON BASED ON UTILITY EVIDENCE VISIBLE AT GROUND SURFACE AND RECORD DRAWINGS AND ARE SUBJECT TO FIELD VERIFICATION BY EXCAVATION. UTILITIES SHOWN DO NOT PURPORT TO CONSTITUTE OR REPRESENT ALL UTILITIES LOCATED UPON OR ADJACENT TO THE SURVEYED PREMISES.
 2. THE OFFSETS OR DIMENSIONS SHOWN HEREON, FROM THE PROPERTY LINES TO THE STRUCTURES ARE FOR A SPECIFIC PURPOSE AND USE. THEREFORE, THEY ARE NOT INTENDED TO MONUMENT THE PROPERTY LINES OR TO GUIDE THE ERECTION OF FENCES, ADDITIONAL STRUCTURES OR ANY OTHER IMPROVEMENTS.
 3. EXISTING AND/OR PROPOSED STRUCTURES RECORDED OR UNRECORDED ARE NOT GUARANTEED UNLESS PHYSICALLY EVIDENT ON THE PREMISES AT THE TIME OF THE SURVEY. SUBJECT TO ALL RIGHTS, EASEMENTS, COVENANTS AND RESTRICTIONS OF RECORD.
 4. SUBJECT TO ANY STATE OF FACTS AN UP-TO-DATE ABSTRACT OF TITLE WOULD DISCLOSE.
 MAP REFERENCES:
 1. MAP ENTITLED "FINAL PLAT, BENDER FARMS, 250 & 280 BENDER LANE, TOWN OF BETHLEHEM, ALBANY COUNTY, STATE OF NEW YORK" BY INALLS & ASSOCIATES, L.P., DATED JUNE 2, 2010, LAST REVISED FEBRUARY 7, 2017.
 2. MAP ENTITLED "AS-BUILT STORM POND AREAS, 15 & 40 MADELINE LANE, BENDER FARMS SUBDIVISION, TOWN OF BETHLEHEM, COUNTY OF ALBANY, STATE OF NEW YORK," BY INALLS & ASSOCIATES, L.P., DATED OCTOBER 12, 2017.

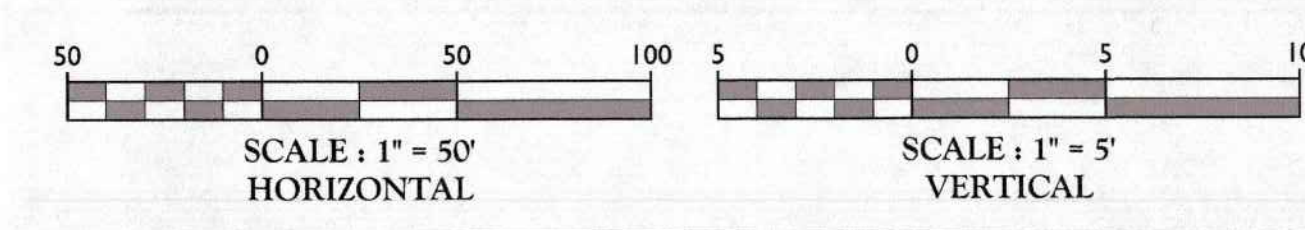

Customer Loyalty through Client Satisfaction
 www.maserconsulting.com
 Engineers • Planners • Surveyors
 Landscape Architects • Environmental Scientists

Office Locations:
 • Red Bank, NJ
 • Clinton, NJ
 • Hamilton, NJ
 • High Harbor, PA
 • Monroeville, NJ
 • New Brunswick, NJ
 • New York, NY
 • Philadelphia, PA
 • Pittsburgh, PA
 • Tampa, FL
 • Washington, DC
 • Westchester, NY
 • Charlotte, NC

State of N.Y. Certificate of Authorization 000671 / 000813

811
 Know what's below.
 Call before you dig.
 STATE REQUIRED FILE NUMBER
 FOR STATE SPECIFIC DIRECT PHONE NUMBERS VISIT:
 WWW.CALL811.COM

REV	DATE	DRAWN BY	DESCRIPTION
1	11/28/17	MMW	REVISED PER TOWN COMMENTS
2	12/01/17	MMW	REVISED PER TOWN COMMENTS

UNAUTHORIZED ALTERATION OR ADDITION TO A SURVEY MAP BEARING A LICENSED LAND SURVEYOR'S SEAL IS A VIOLATION OF SECTION 2009, SUB-DIVISION 2, OF THE NEW YORK STATE EDUCATION LAW.

ONLY BOUNDARY SURVEY MAPS WITH THE SURVEYOR'S SEAL ARE GENUINE, TRUE, AND CORRECT COPIES OF THE SURVEYOR'S ORIGINAL WORK AND OPINION.

MARK R. BELOR
 NEW YORK STATE PROFESSIONAL
 LAND SURVEYOR LICENSE NO. 050478

AS-BUILT SURVEY
 FOR
 BENDER FARMS

AS-BUILT PROFILES

TOWN OF BETHLEHEM
 COUNTY OF ALBANY
 STATE OF NEW YORK

ALBANY OFFICE
 18 Computer Drive East
 Suite 203
 Albany, NY 12205
 Phone: 518.459.3252
 Fax: 518.459.3284

SCALE	DATE	DRAWN BY	CHECKED BY
AS SHOWN	10/11/17	MMW	DPS

PROJECT NUMBER: 1700077A
 DRAWING NAME: AS-BUILT BENDER FARMS

SHEET TITLE: AS-BUILT

SHEET NUMBER: 01 of 01