



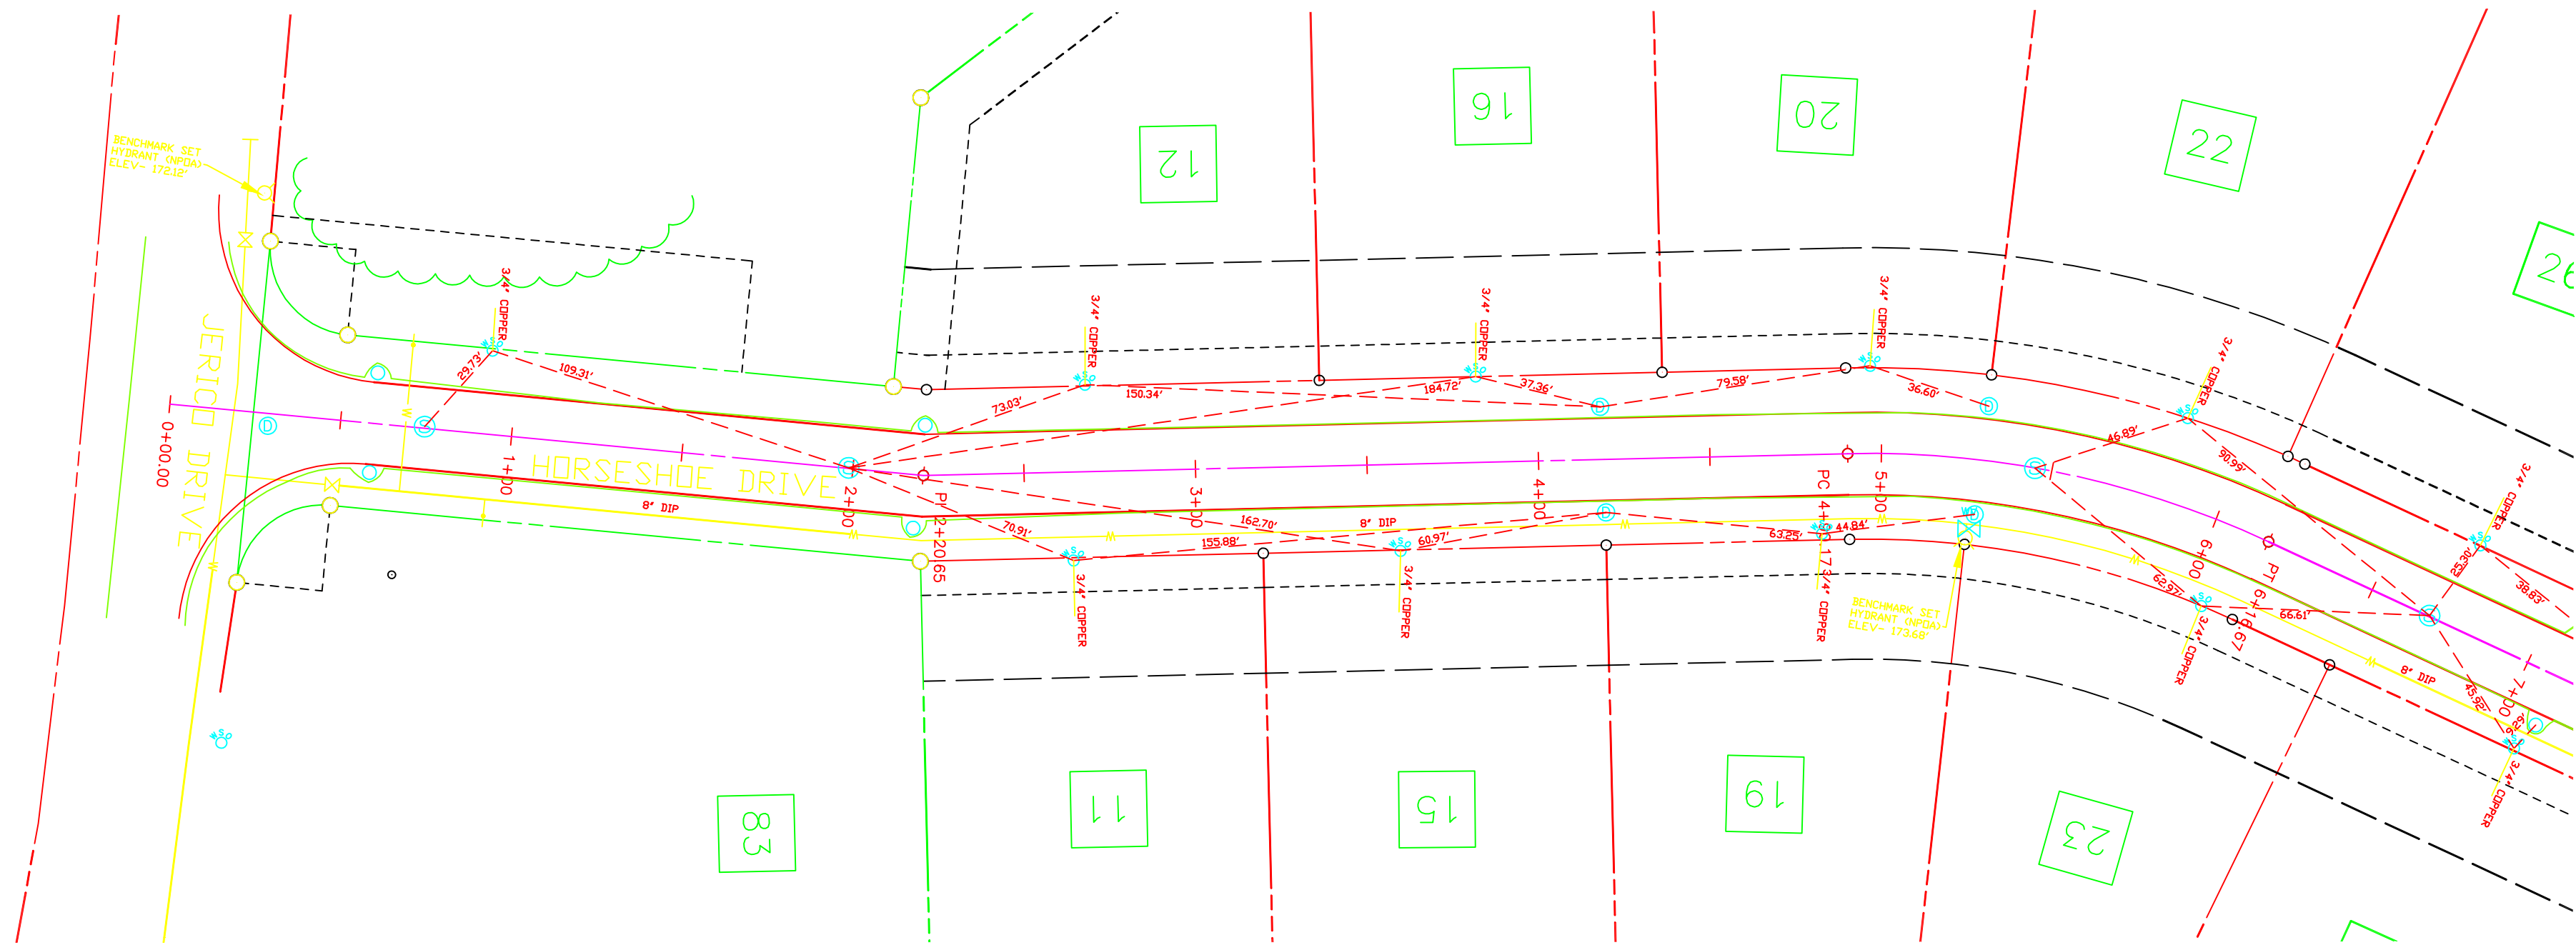

GENERAL PLAN - HORSESHOE DRIVE
CENTERLINE STATIONING 0+00 - 6+80
SCALE: 1" = 40'

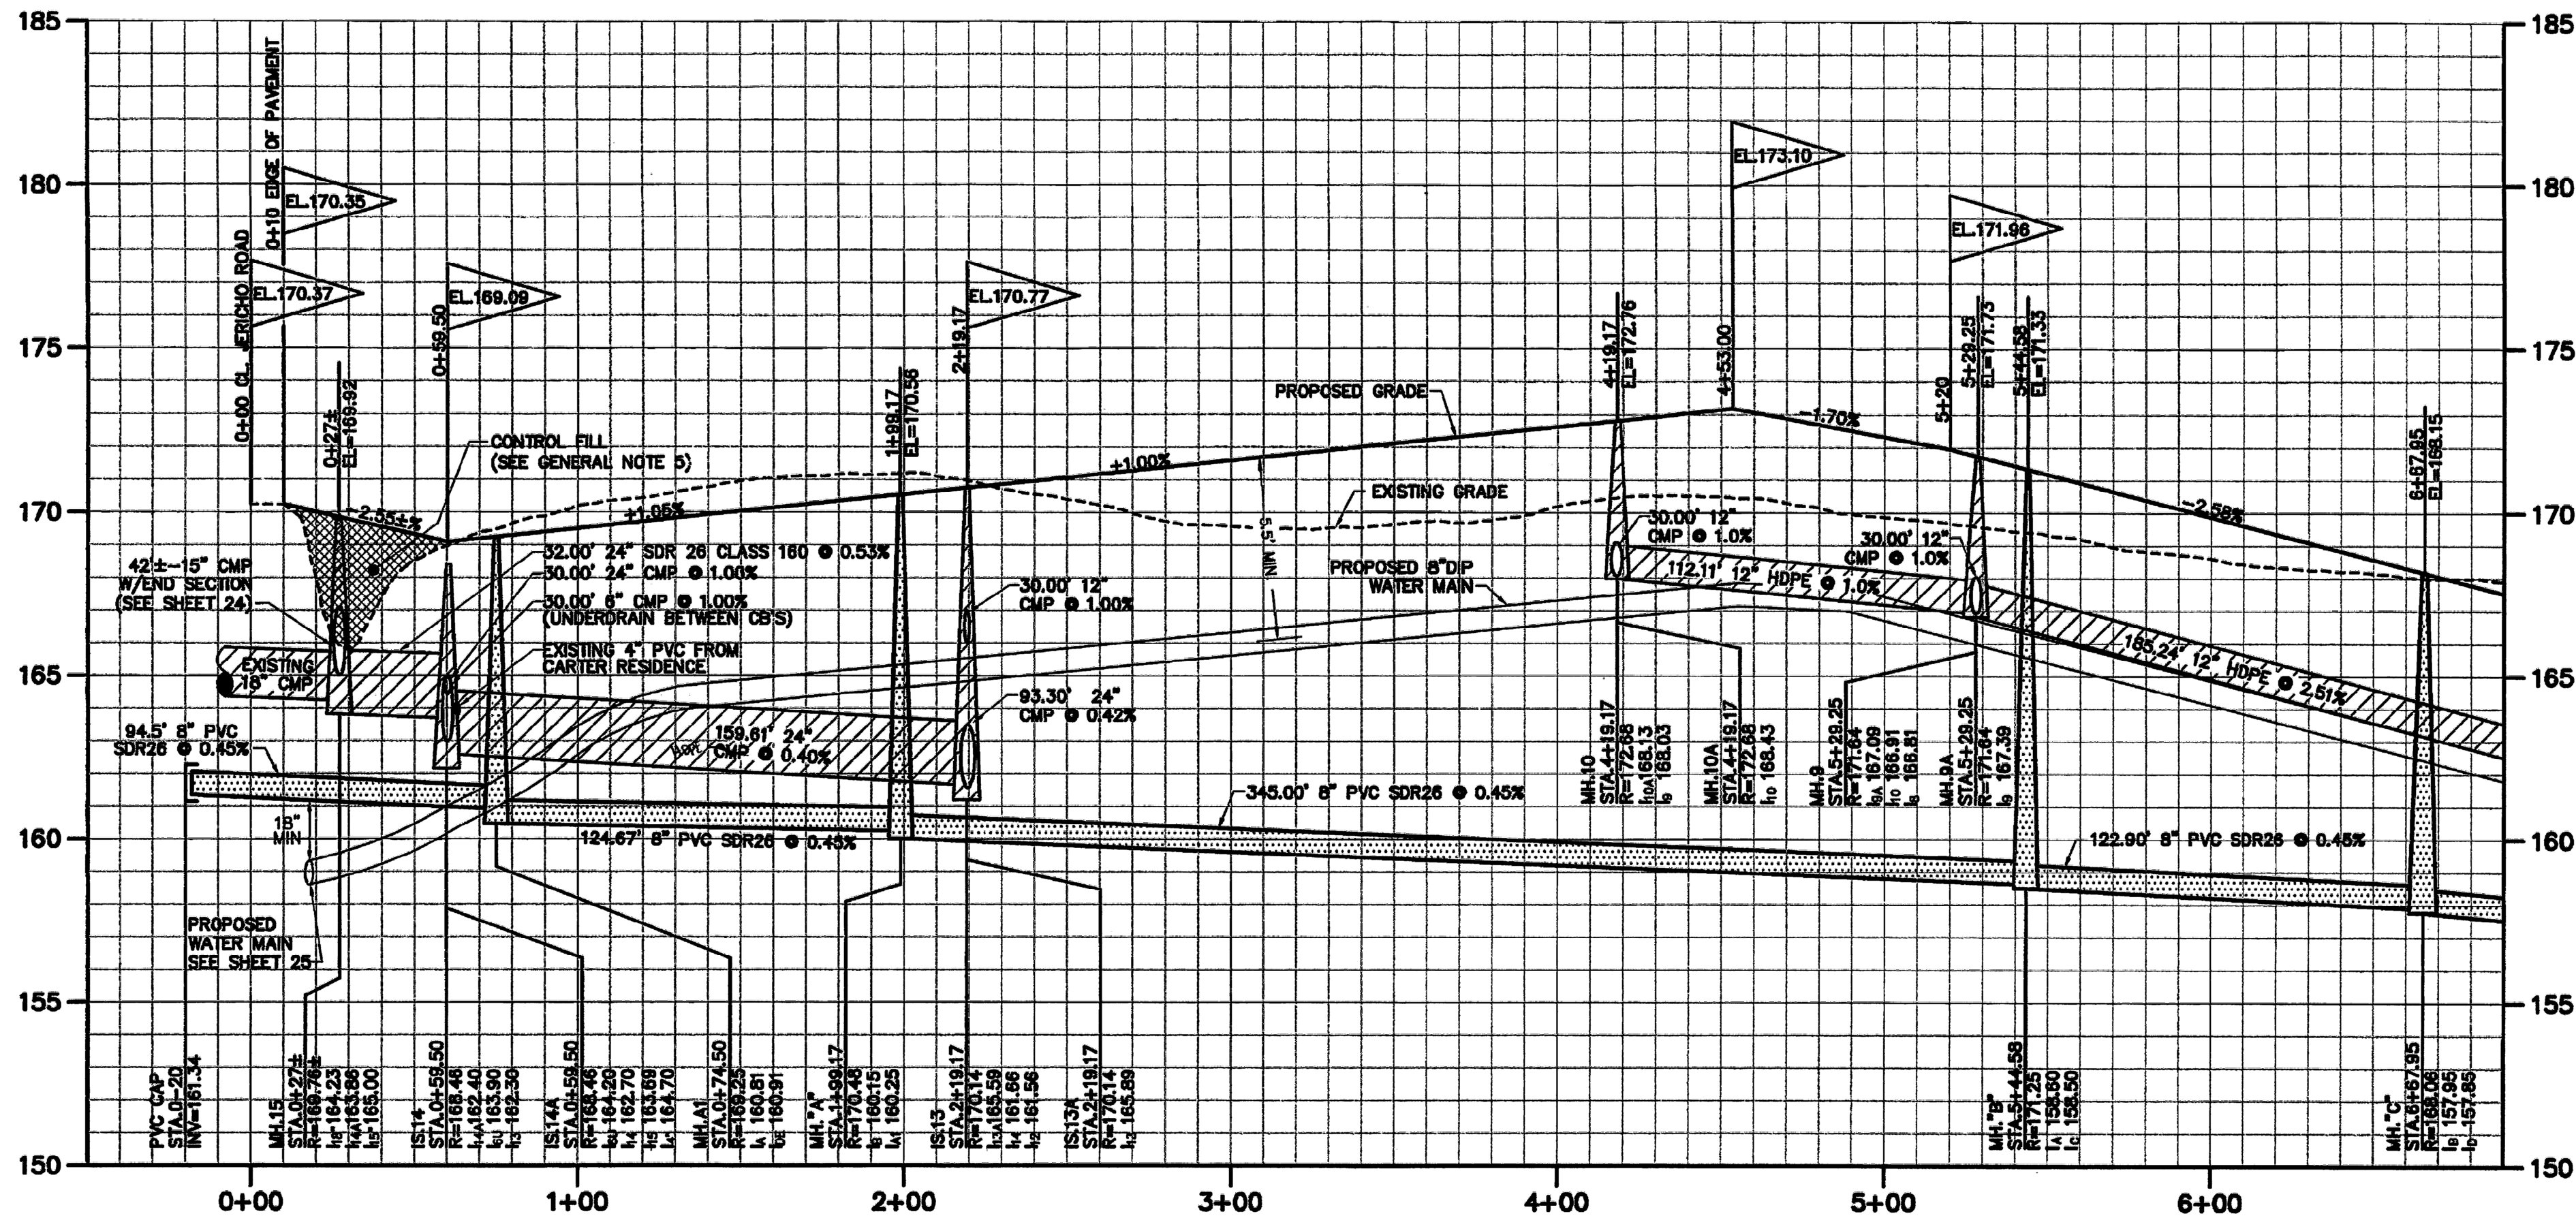

PROFILE - HORSESHOE DRIVE
SCALE: 1"=4' VERT. / 1"=40' HORIZ.

UNAUTHORIZED ADDITION OR ALTERATION TO THIS MAP IS A VIOLATION OF ARTICLE 145, SECTION 7209, SUB-PARAGRAPH 2 OF NEW YORK STATE EDUCATION LAW.

WATER LINE RECORD DRAWING HORSESHOE DRIVE		SYK S.Y. KIM LAND SURVEYOR, P.C. 260 OSBORNE ROAD, ALBANY, N.Y. 12211 PHONE : (518) 785-3969 FAX: (518) 785-1608	SHEET 1 OF 2
TOWN OF BETHLEHEM	ALBANY COUNTY, N.Y.		
SCALE : 1" = 40'	OCTOBER 23, 2015		
JOB NO. : 15-202	15-202.DWG		