




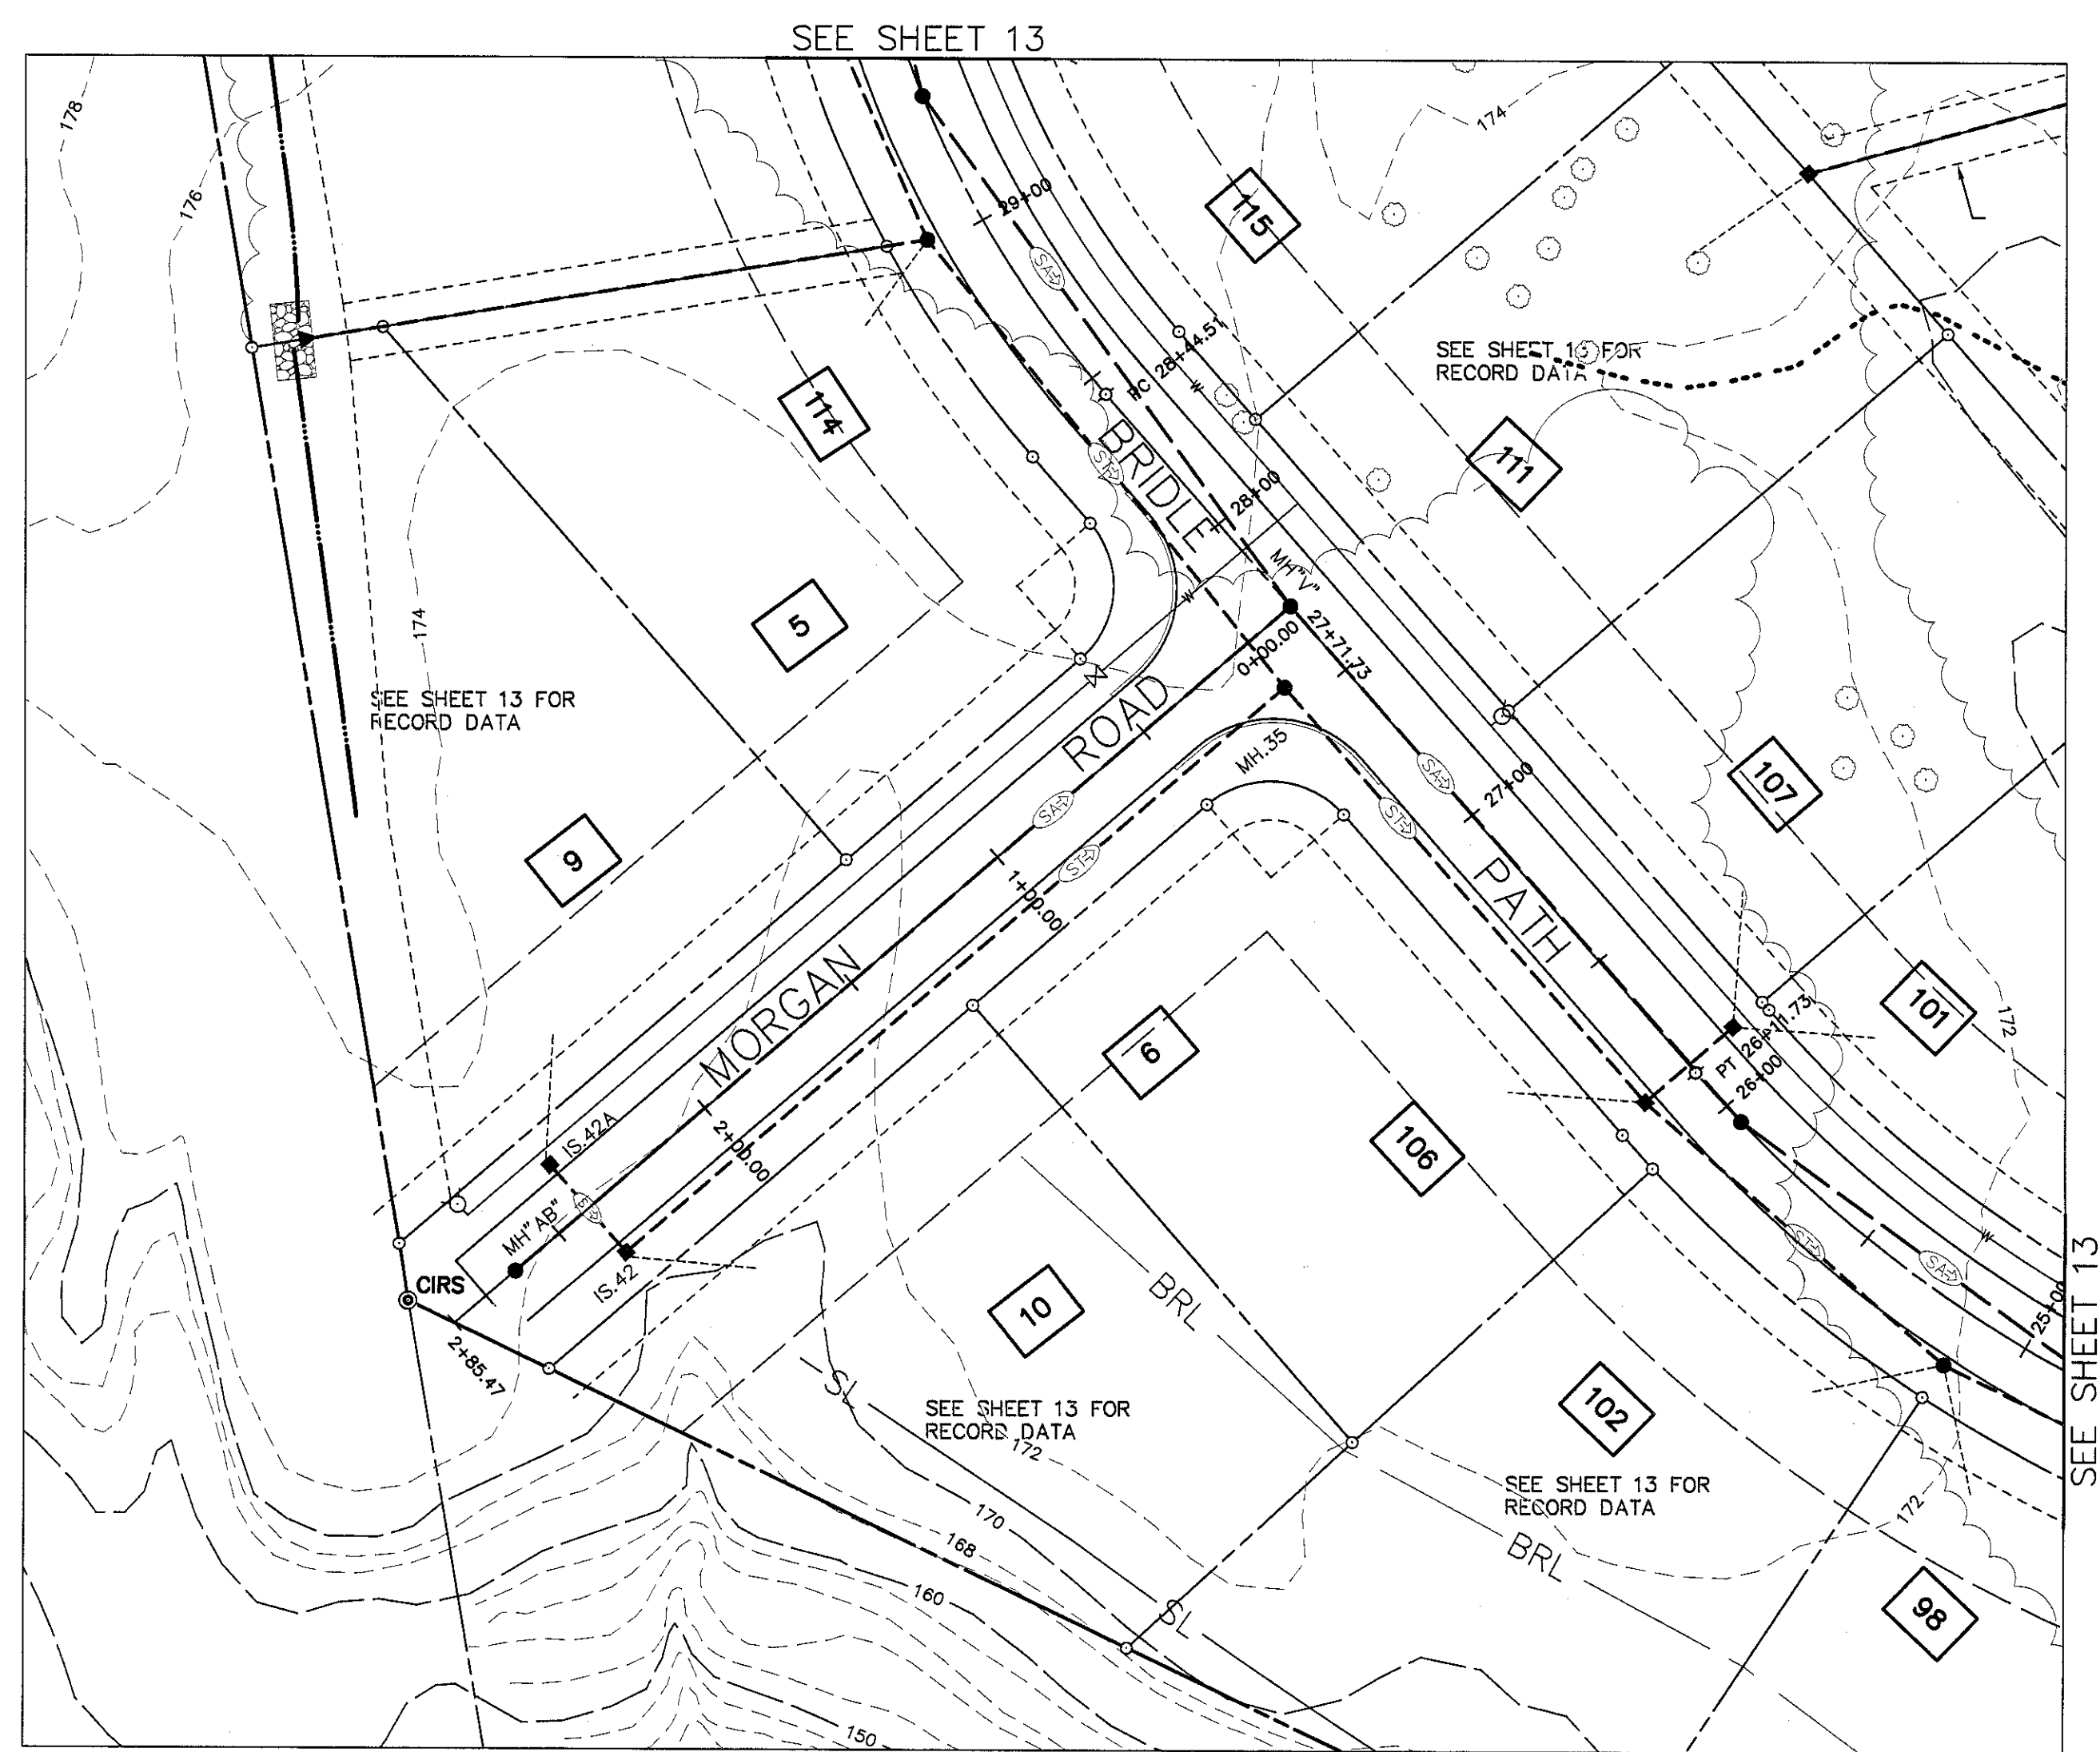


GENERAL PLAN — MORGAN ROAD
SCALE: 1" = 40'

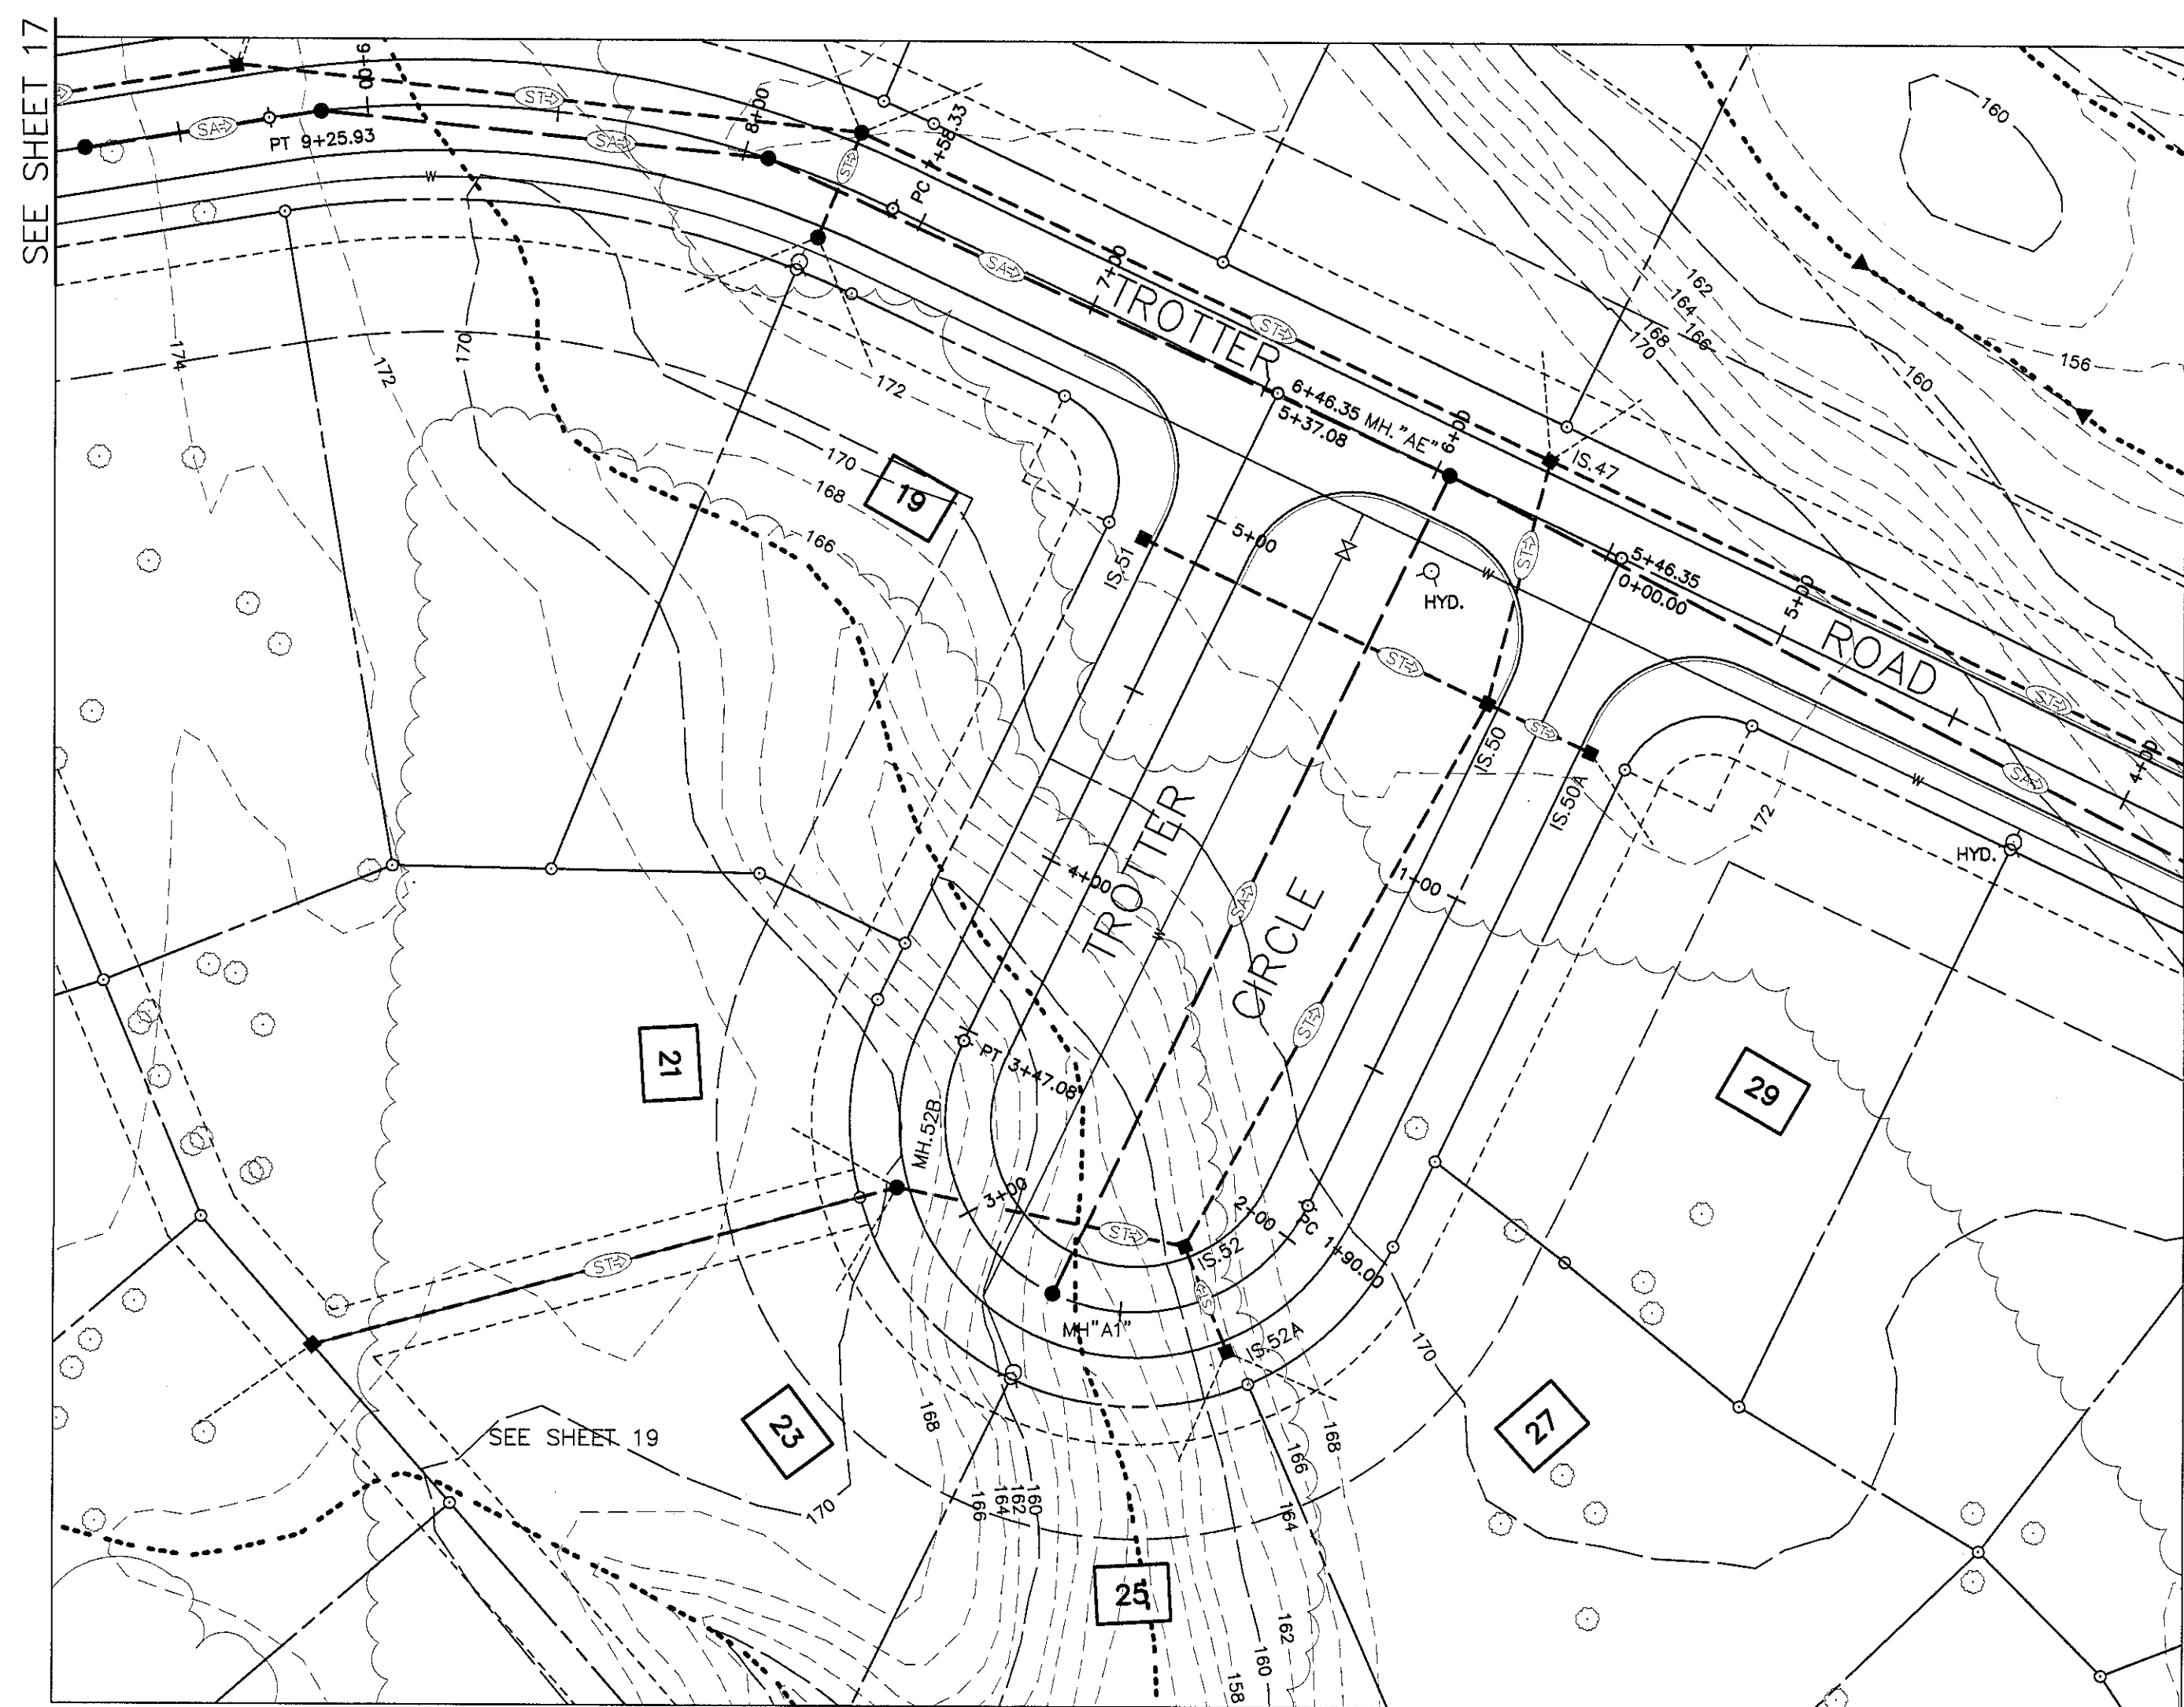

GENERAL PLAN — TROTTER CIRCLE
SCALE: 1" = 40'

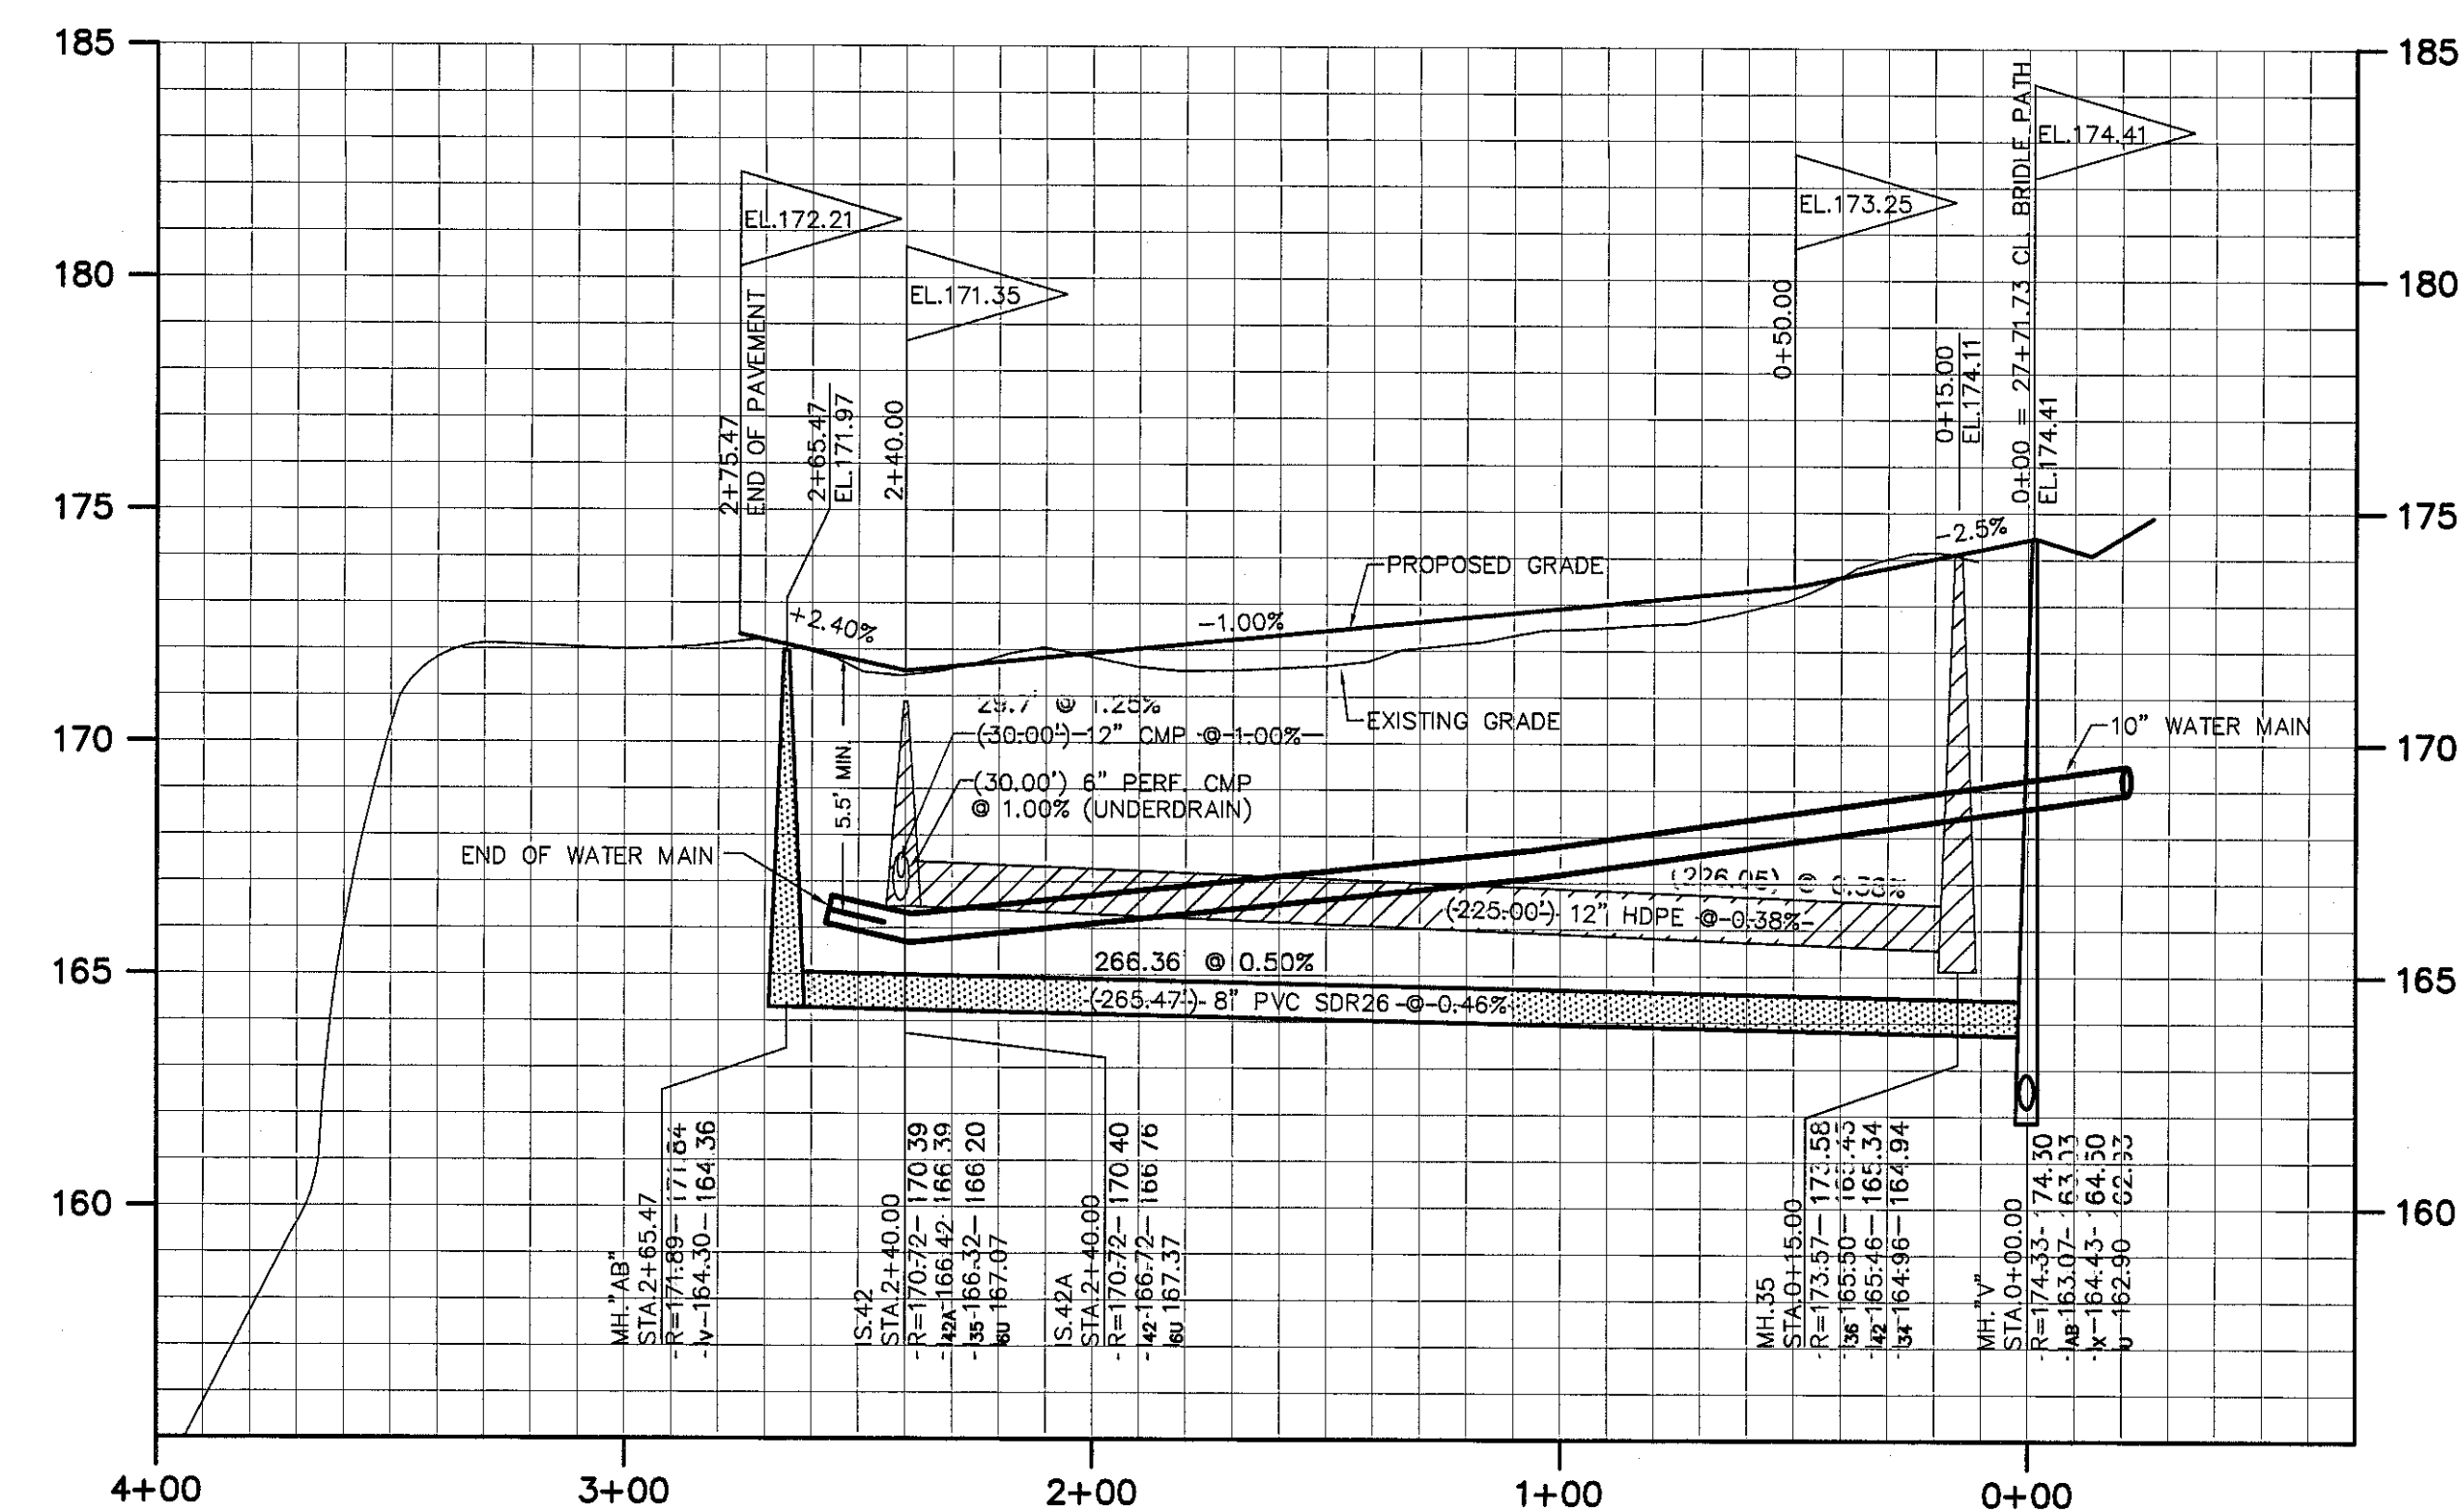


PROFILE — MORGAN ROAD
SCALE: 1"=4' VERT. / 1"=40' HORIZ.

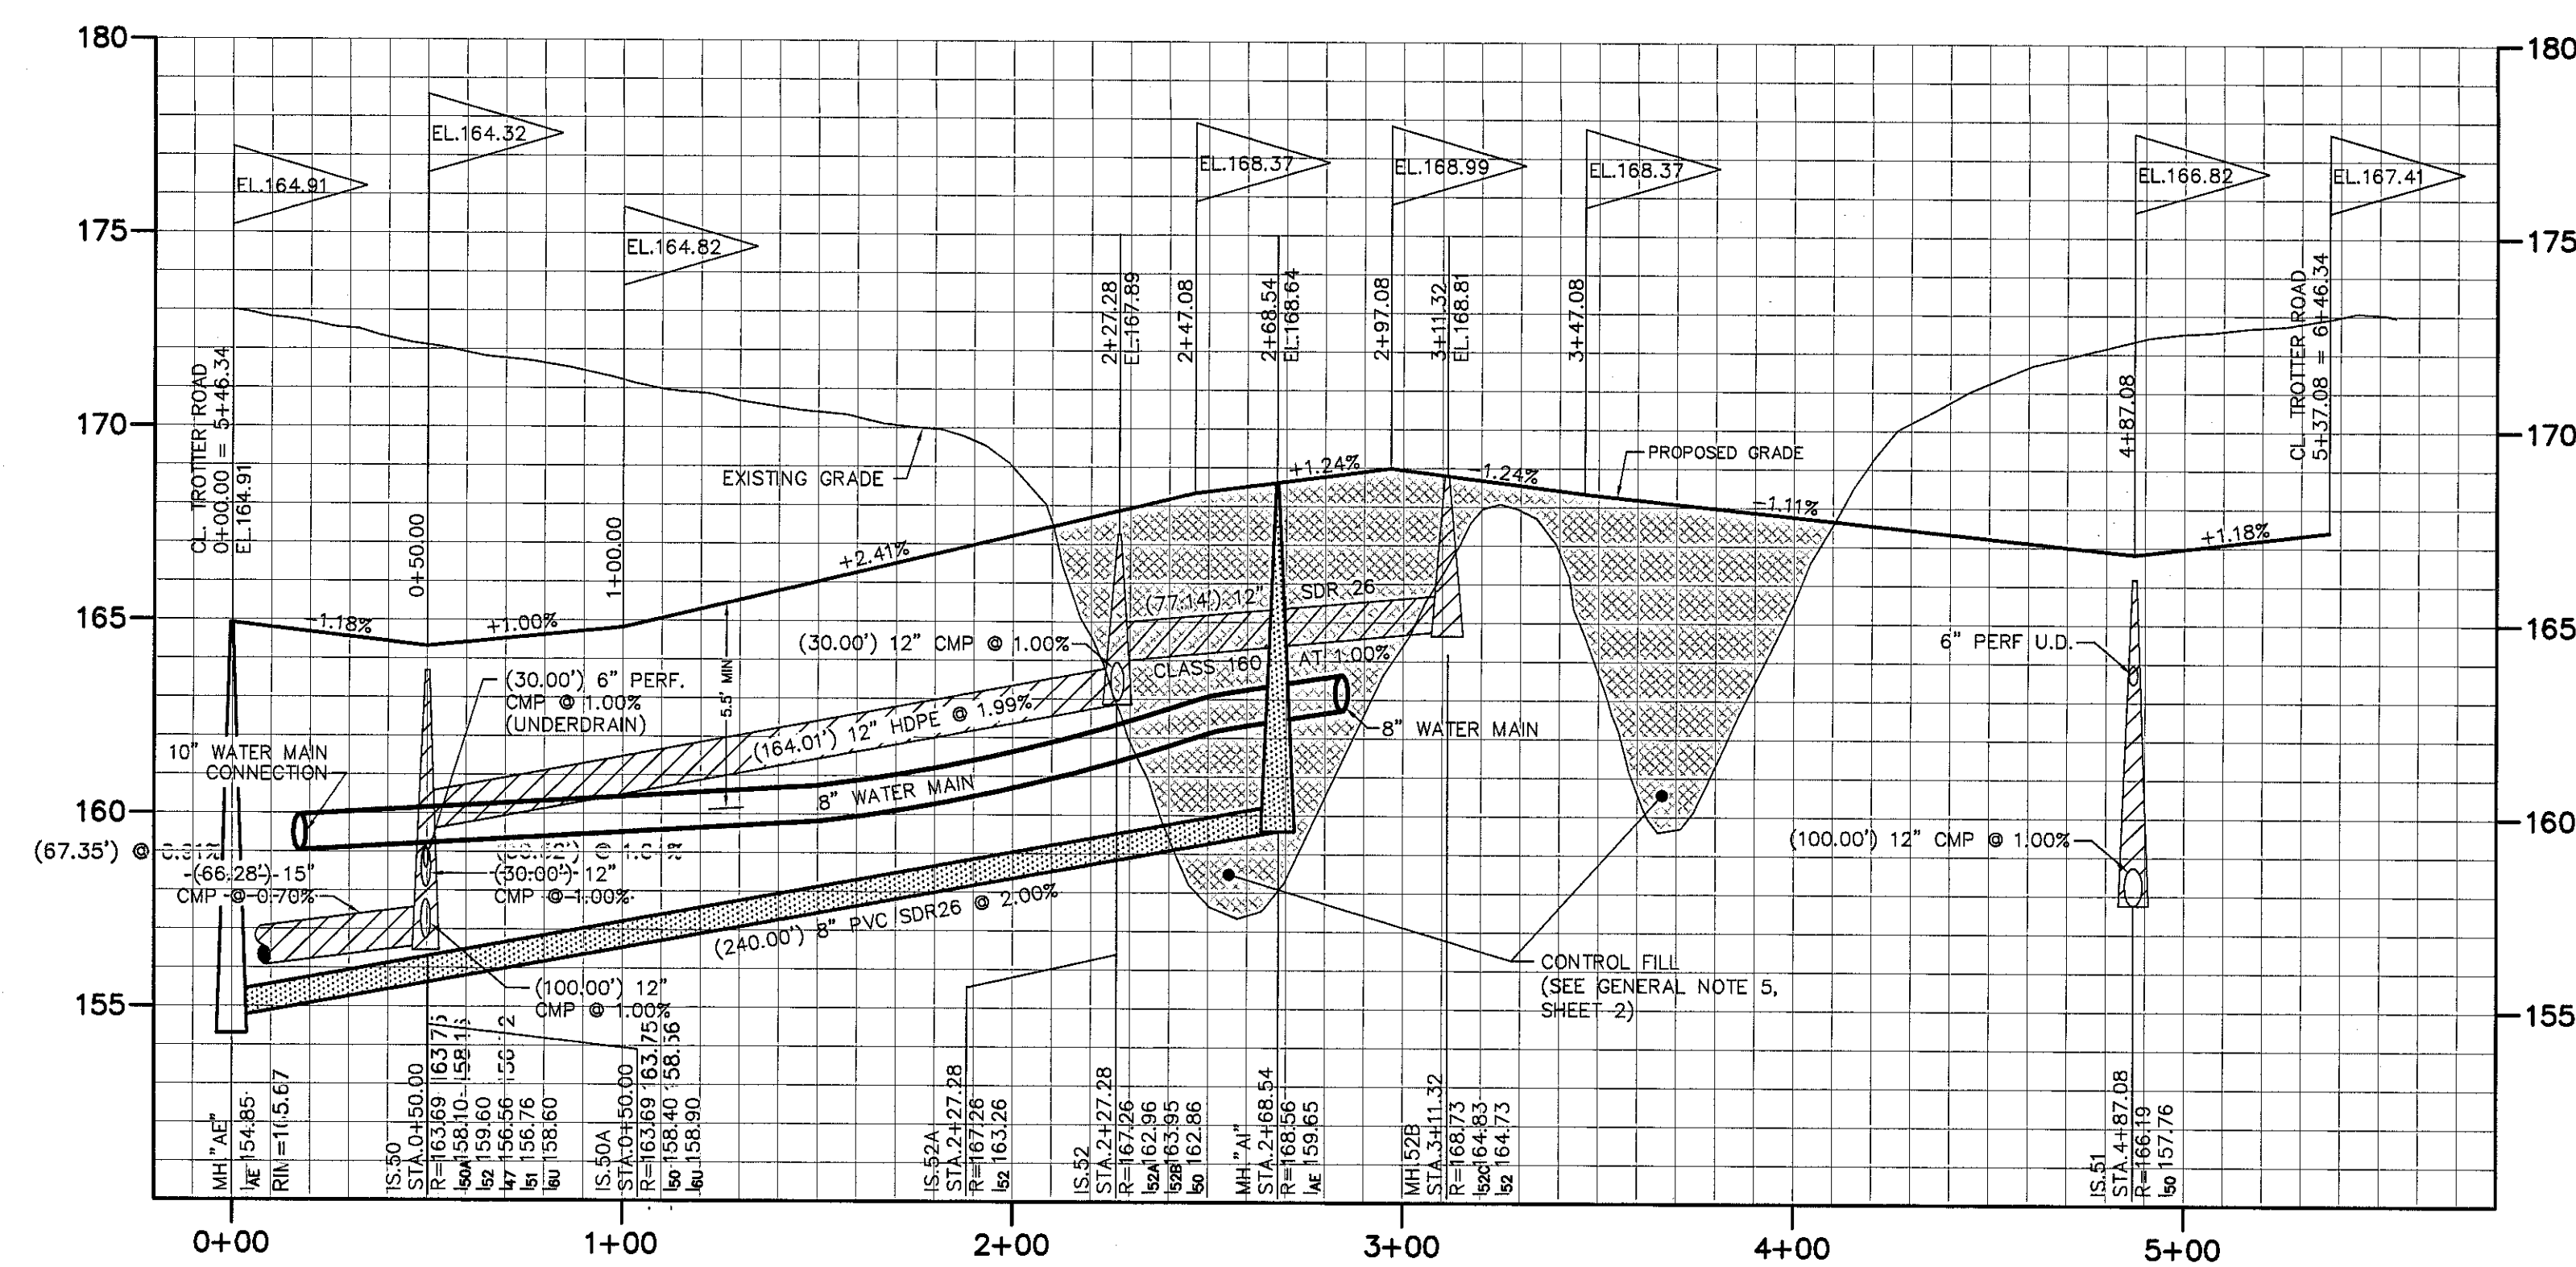

PROFILE — TROTTER CIRCLE
SCALE: 1"=4' VERT. / 1"=40' HORIZ.

RECORD
DRAWING

ALL INFORMATION SHOWN IN RED
ON THESE DRAWINGS REPRESENT
RECORD INFORMATION OBTAINED
BY THE FIELD CREWS OF
C.T. MALE ASSOCIATES, P.C.
DURING THE MONTH OF OCTOBER 2008.

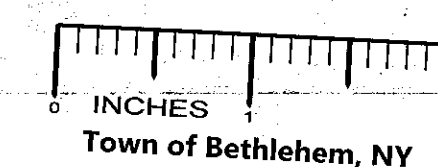

GENERAL NOTES

UNAUTHORIZED ALTERATIONS OR ADDITIONS TO THIS DOCUMENT
IS A VIOLATION OF SECTION 7209 SUBDIVISION 2 OF THE
NEW YORK STATE EDUCATION LAW.

REVISIONS

DATE	BY	DESCRIPTION	SYMBOL
6/99	CHJ	FINAL PLAN REVISIONS	△
10/99	CHJ	FINAL PLAN REVISIONS	△
5/00	CHJ	FINAL PLAN REVISIONS	△
12/00	CHJ	FINAL PLAN REVISIONS	△
1/25/01	CHJ	FINAL PLAN REVISIONS	△
7/01	CHJ	ADD REVISIONS	△
1/06	CHJ	MISCELLANEOUS REVISIONS	△
3/06	CHJ	MISCELLANEOUS REVISIONS	△
4/06	CHJ	MISCELLANEOUS REVISIONS	△

EDWARD W. BOUTELLE
AND SON
CIVIL ENGINEERS AND SURVEYORS
423 KENWOOD AVENUE
DELMAR, NEW YORK
TEL.(518) 439-9981 FAX.(518) 439-9982
A DIVISION OF J. KENNETH FRASER AND ASSOCIATES, P.E., L.S., L.A., P.C.

FINAL PLAN
AMENDED
CARRIAGE HILL
SUBDIVISION
MAP OF LANDS OF
CHARLEW
CONSTRUCTION CORP.

TOWN OF BETHLEHEM COUNTY OF ALBANY
STATE OF NEW YORK

SCALE: AS NOTED

PROJ. SURVEYOR: CHJ
DRAWN BY: TWK
ASSEMBLED BY: TWK
CHECKED BY: CHJ

PROJECT NO.: 99-020
CAD FILE NAME: 4103-018

SHEET TITLE: PLAN & PROFILE
MORGAN ROAD AND TROTTER CIRCLE

DATE: NOVEMBER 1995 SHEET 18 OF 31