

GENERAL NOTES

UNAUTHORIZED ALTERATIONS OR ADDITIONS TO THIS DOCUMENT IS A VIOLATION OF SECTION 7209 SUBDIVISION 2 OF THE NEW YORK STATE EDUCATION LAW.

REVISIONS

DATE	BY	DESCRIPTION	SYMBOL
8/99	CHU	FINAL PLAN REVISIONS	△
10/99	CHU	FINAL PLAN REVISIONS	△
9/00	CHU	FINAL PLAN REVISIONS	△
12/00	CHU	FINAL PLAN REVISIONS	△
1/26/01	CHU	FINAL PLAN REVISIONS	△
10/04	CHU	FINAL PLAN REVISIONS	△
5/05	CHU	LOT LINE CHANGES	△
1/06	CHU	MISCELLANEOUS REVISIONS	△
3/06	CHU	MISCELLANEOUS REVISIONS	△
4/06	CHU	MISCELLANEOUS REVISIONS	△

EDWARD W. BOUTELLE AND SON
CIVIL ENGINEERS AND SURVEYORS
423 KENWOOD AVENUE
DELMAR, NEW YORK
TEL.(518) 439-9981 FAX.(518) 439-9982
A DIVISION OF J. KENNETH FRASER AND ASSOCIATES, P.E., L.S., L.A., P.C.

FINAL PLAN
AMENDED
CARRIAGE HILL
SUBDIVISION
MAP OF LANDS OF
CHARLEW
CONSTRUCTION CORP.

TOWN OF BETHLEHEM COUNTY OF ALBANY
STATE OF NEW YORK


SCALE: AS NOTED

PROJ. SURVEYOR: CHU
DRAWN BY: TWK
ASSEMBLED BY: TWK
CHECKED BY: CHU


PROJECT NO.: 99-020
CAD FILE NAME: 4103-020

SHEET TITLE: PLAN & PROFILE
DRAINAGE EASEMENTS "C" AND "D"


DATE: NOVEMBER 1995 SHEET 20 OF 31

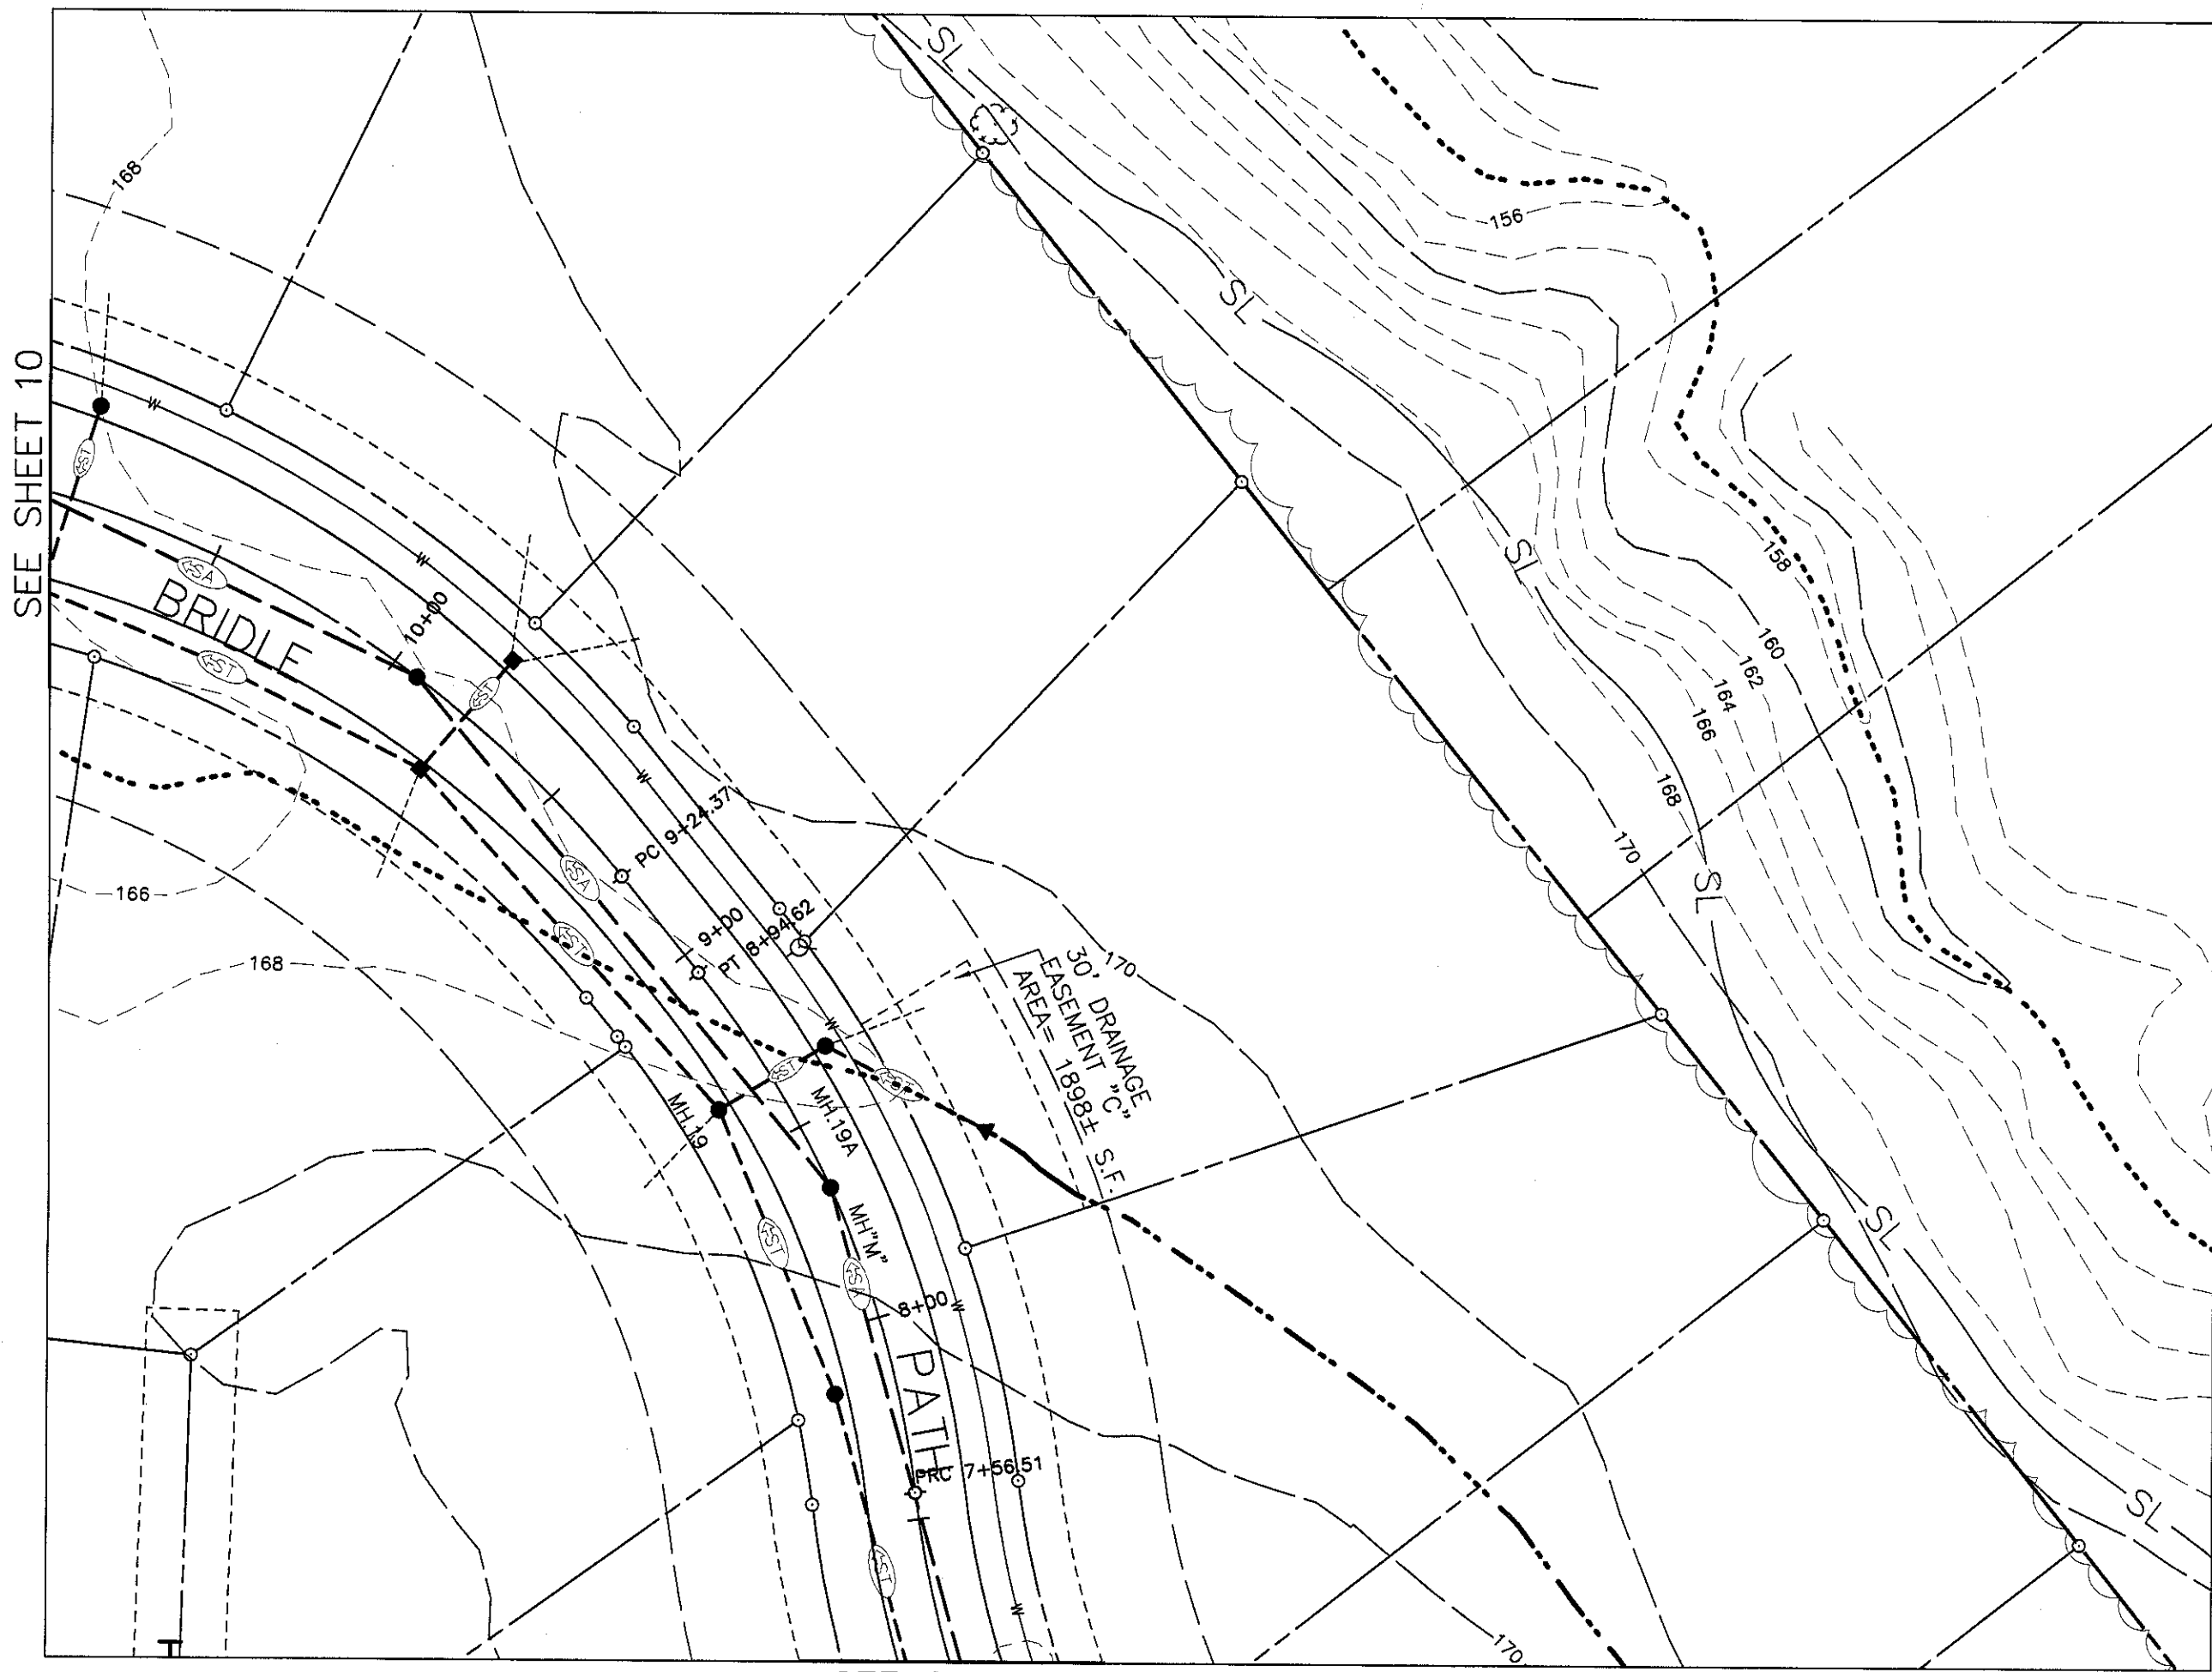


GENERAL PLAN - DRAINAGE EASEMENT "C"
SCALE: 1" = 40'

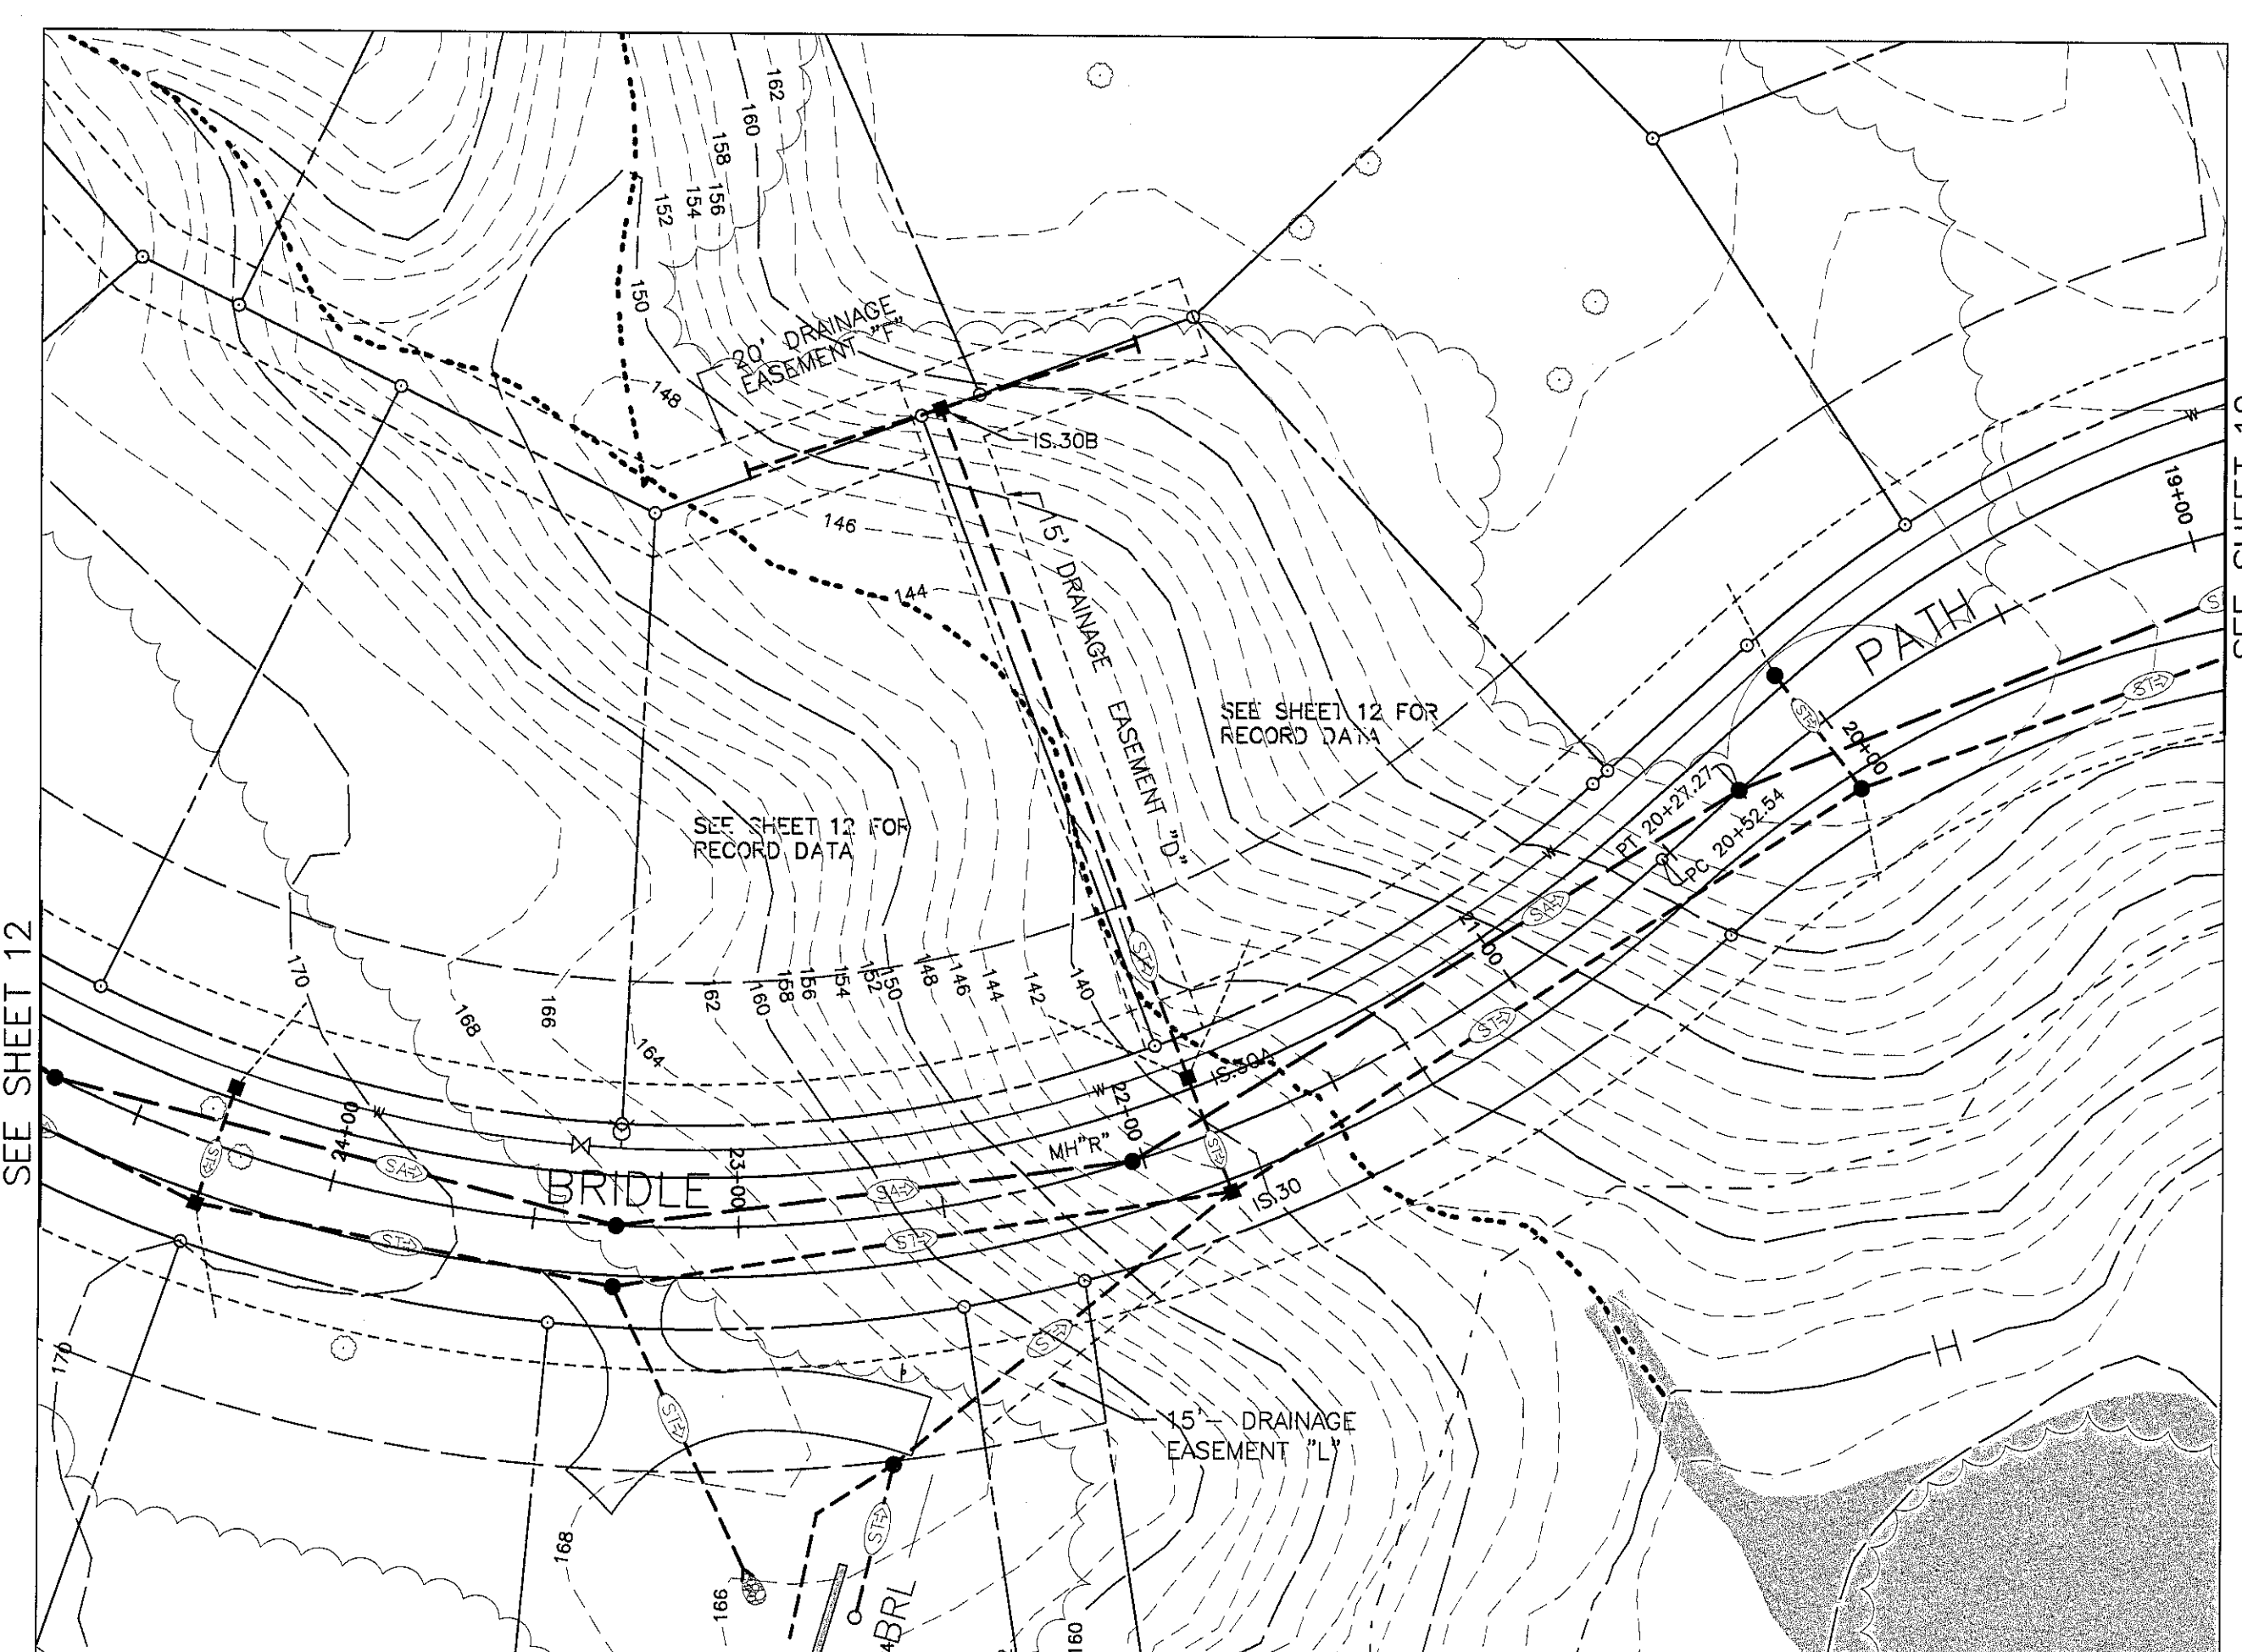

GENERAL PLAN - DRAINAGE EASEMENT "D"
SCALE: 1" = 40'

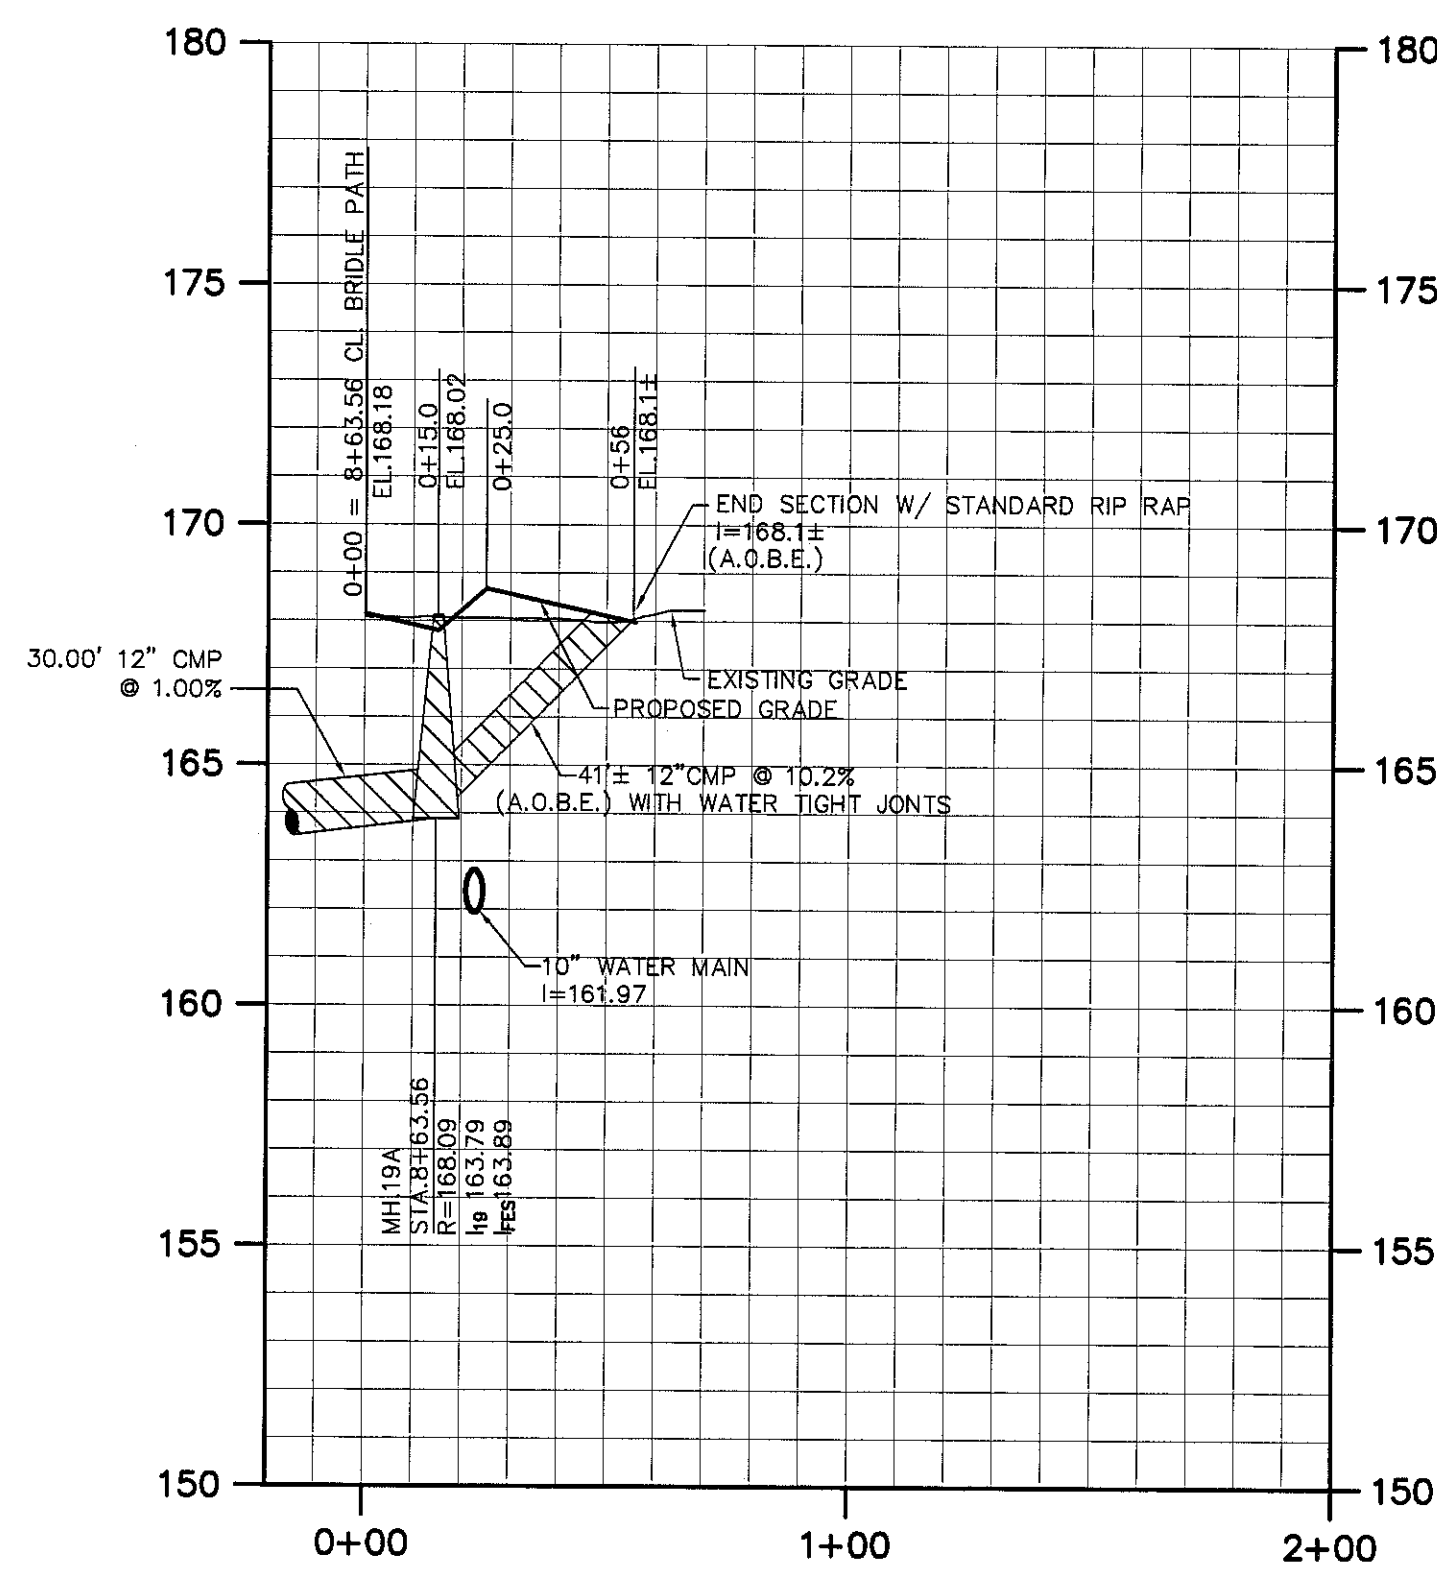

PROFILE - EASEMENT "C"
SCALE: 1"=4' VERT. / 1"=40' HORIZ.

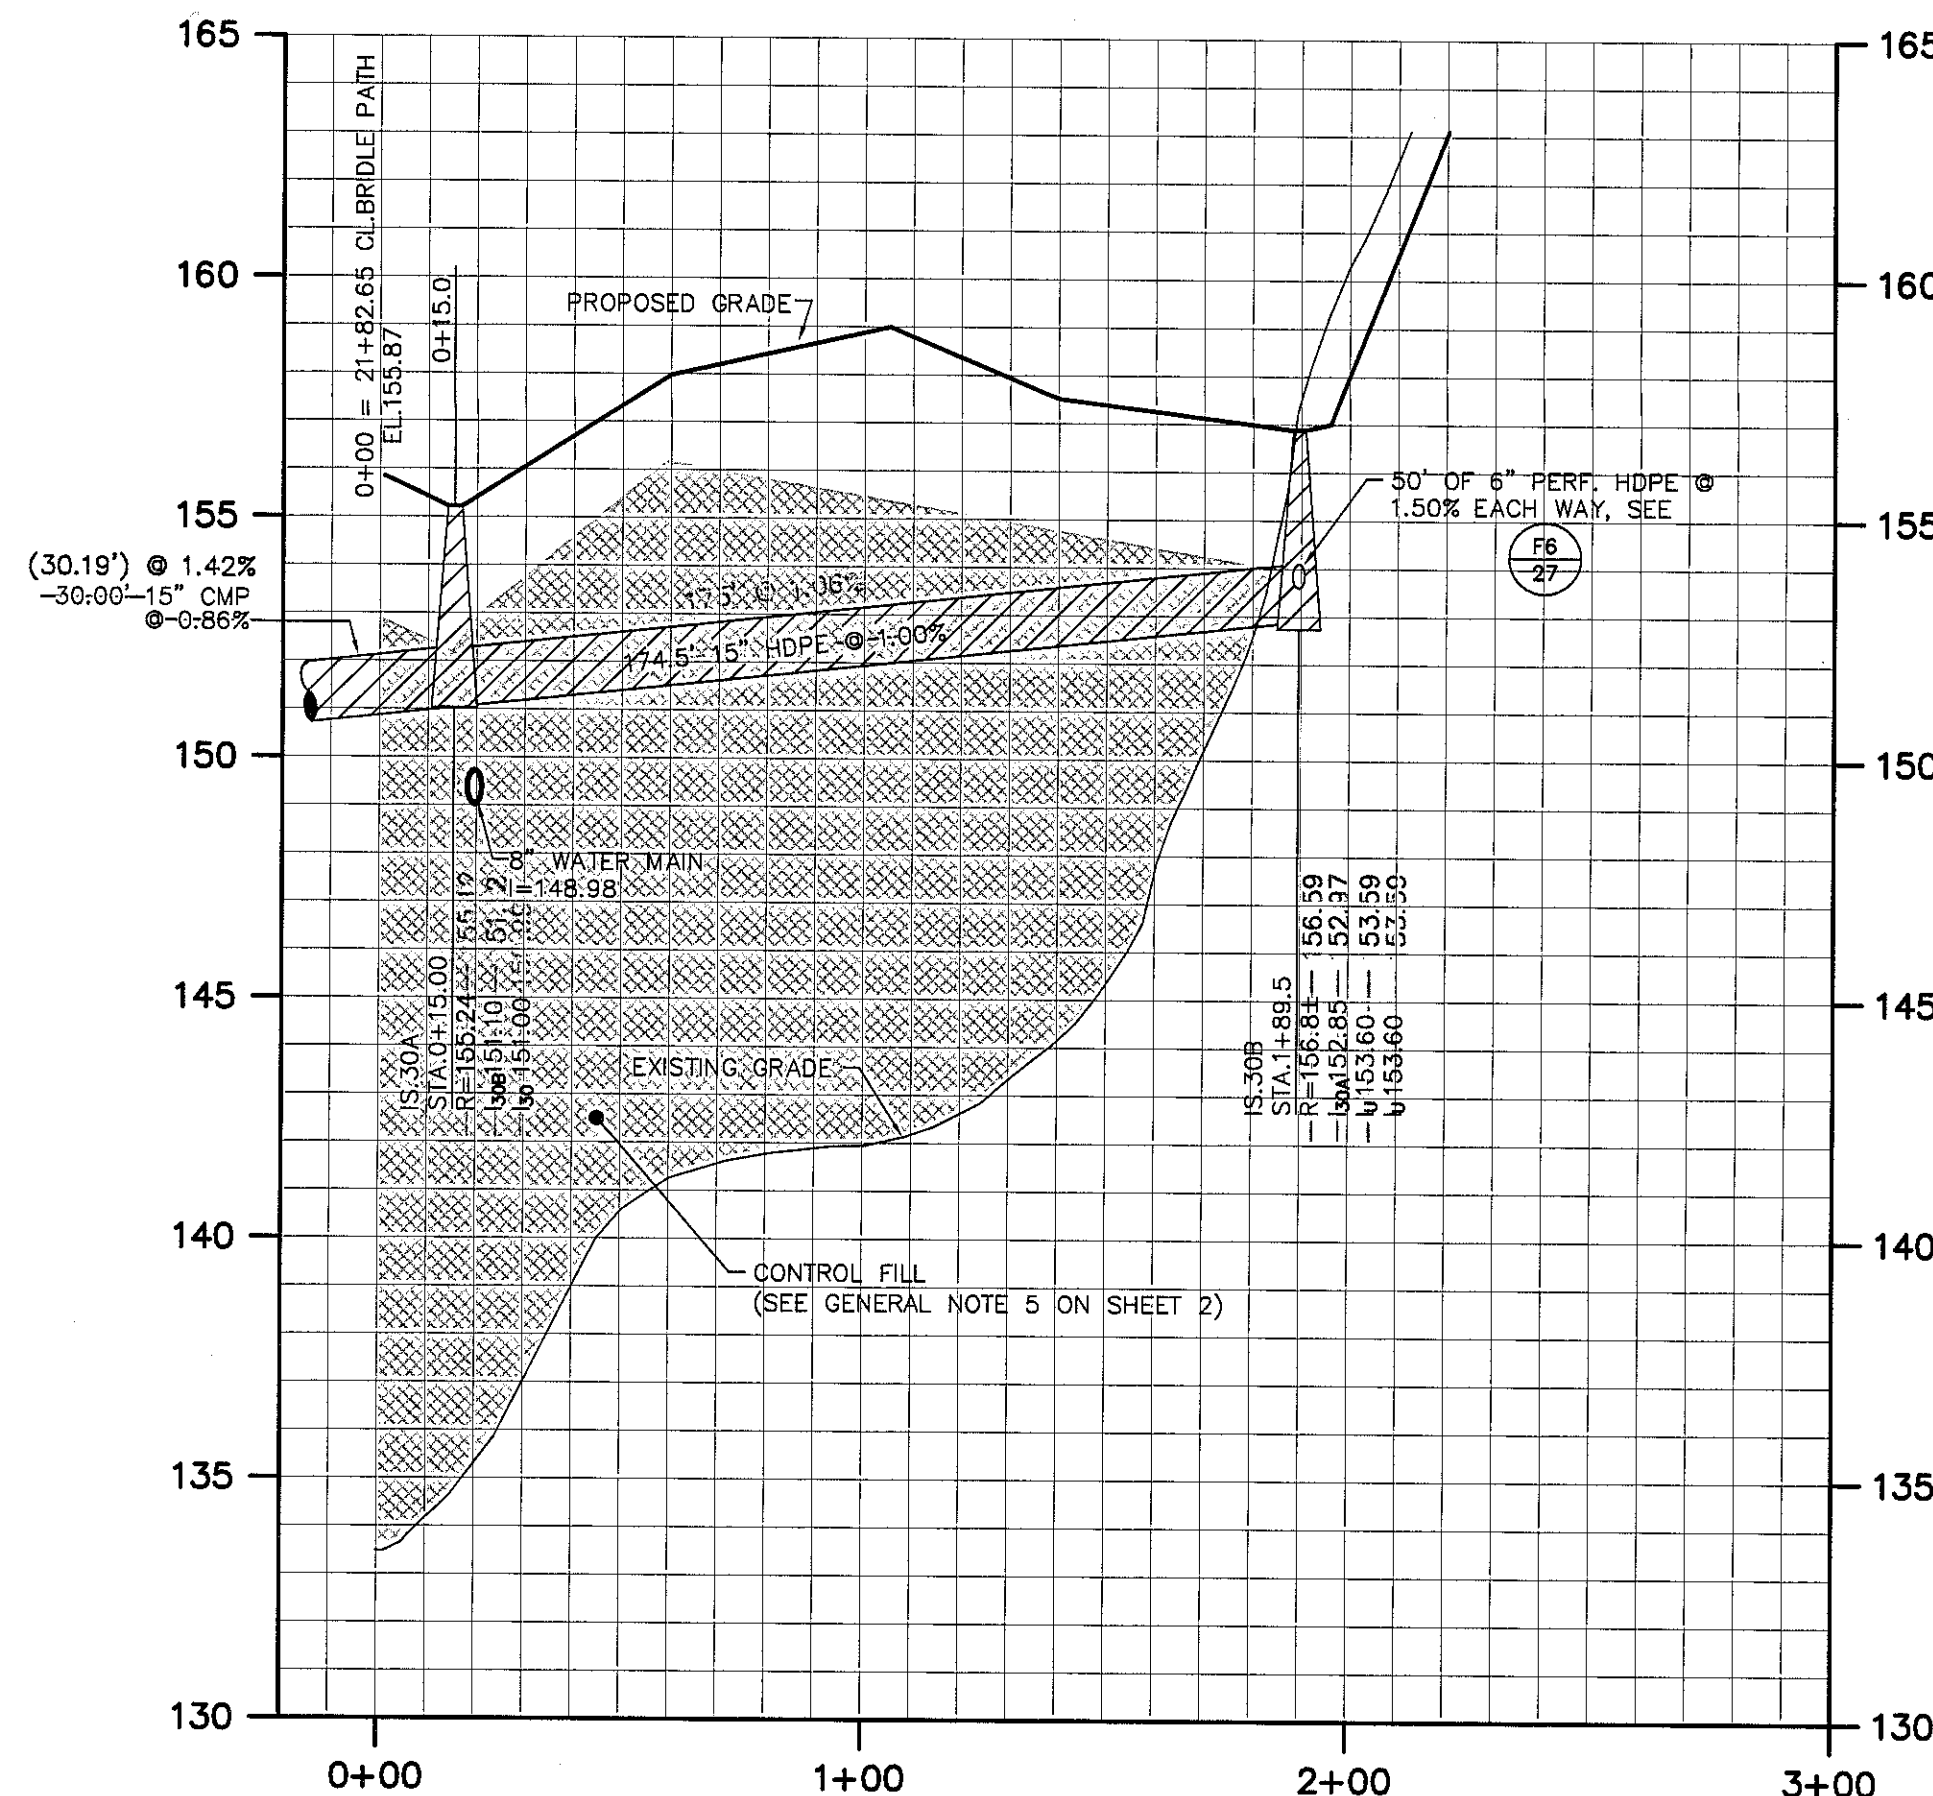

PROFILE - EASEMENT "D"
SCALE: 1"=4' VERT. / 1"=40' HORIZ.

RECORD
DRAWING
ALL INFORMATION SHOWN IN RED
ON THESE DRAWINGS REPRESENT
RECORD INFORMATION OBTAINED
BY THE FIELD CREWS OF
C.T. MALE ASSOCIATES, P.C.
DURING THE MONTH OF OCTOBER 2008.

