


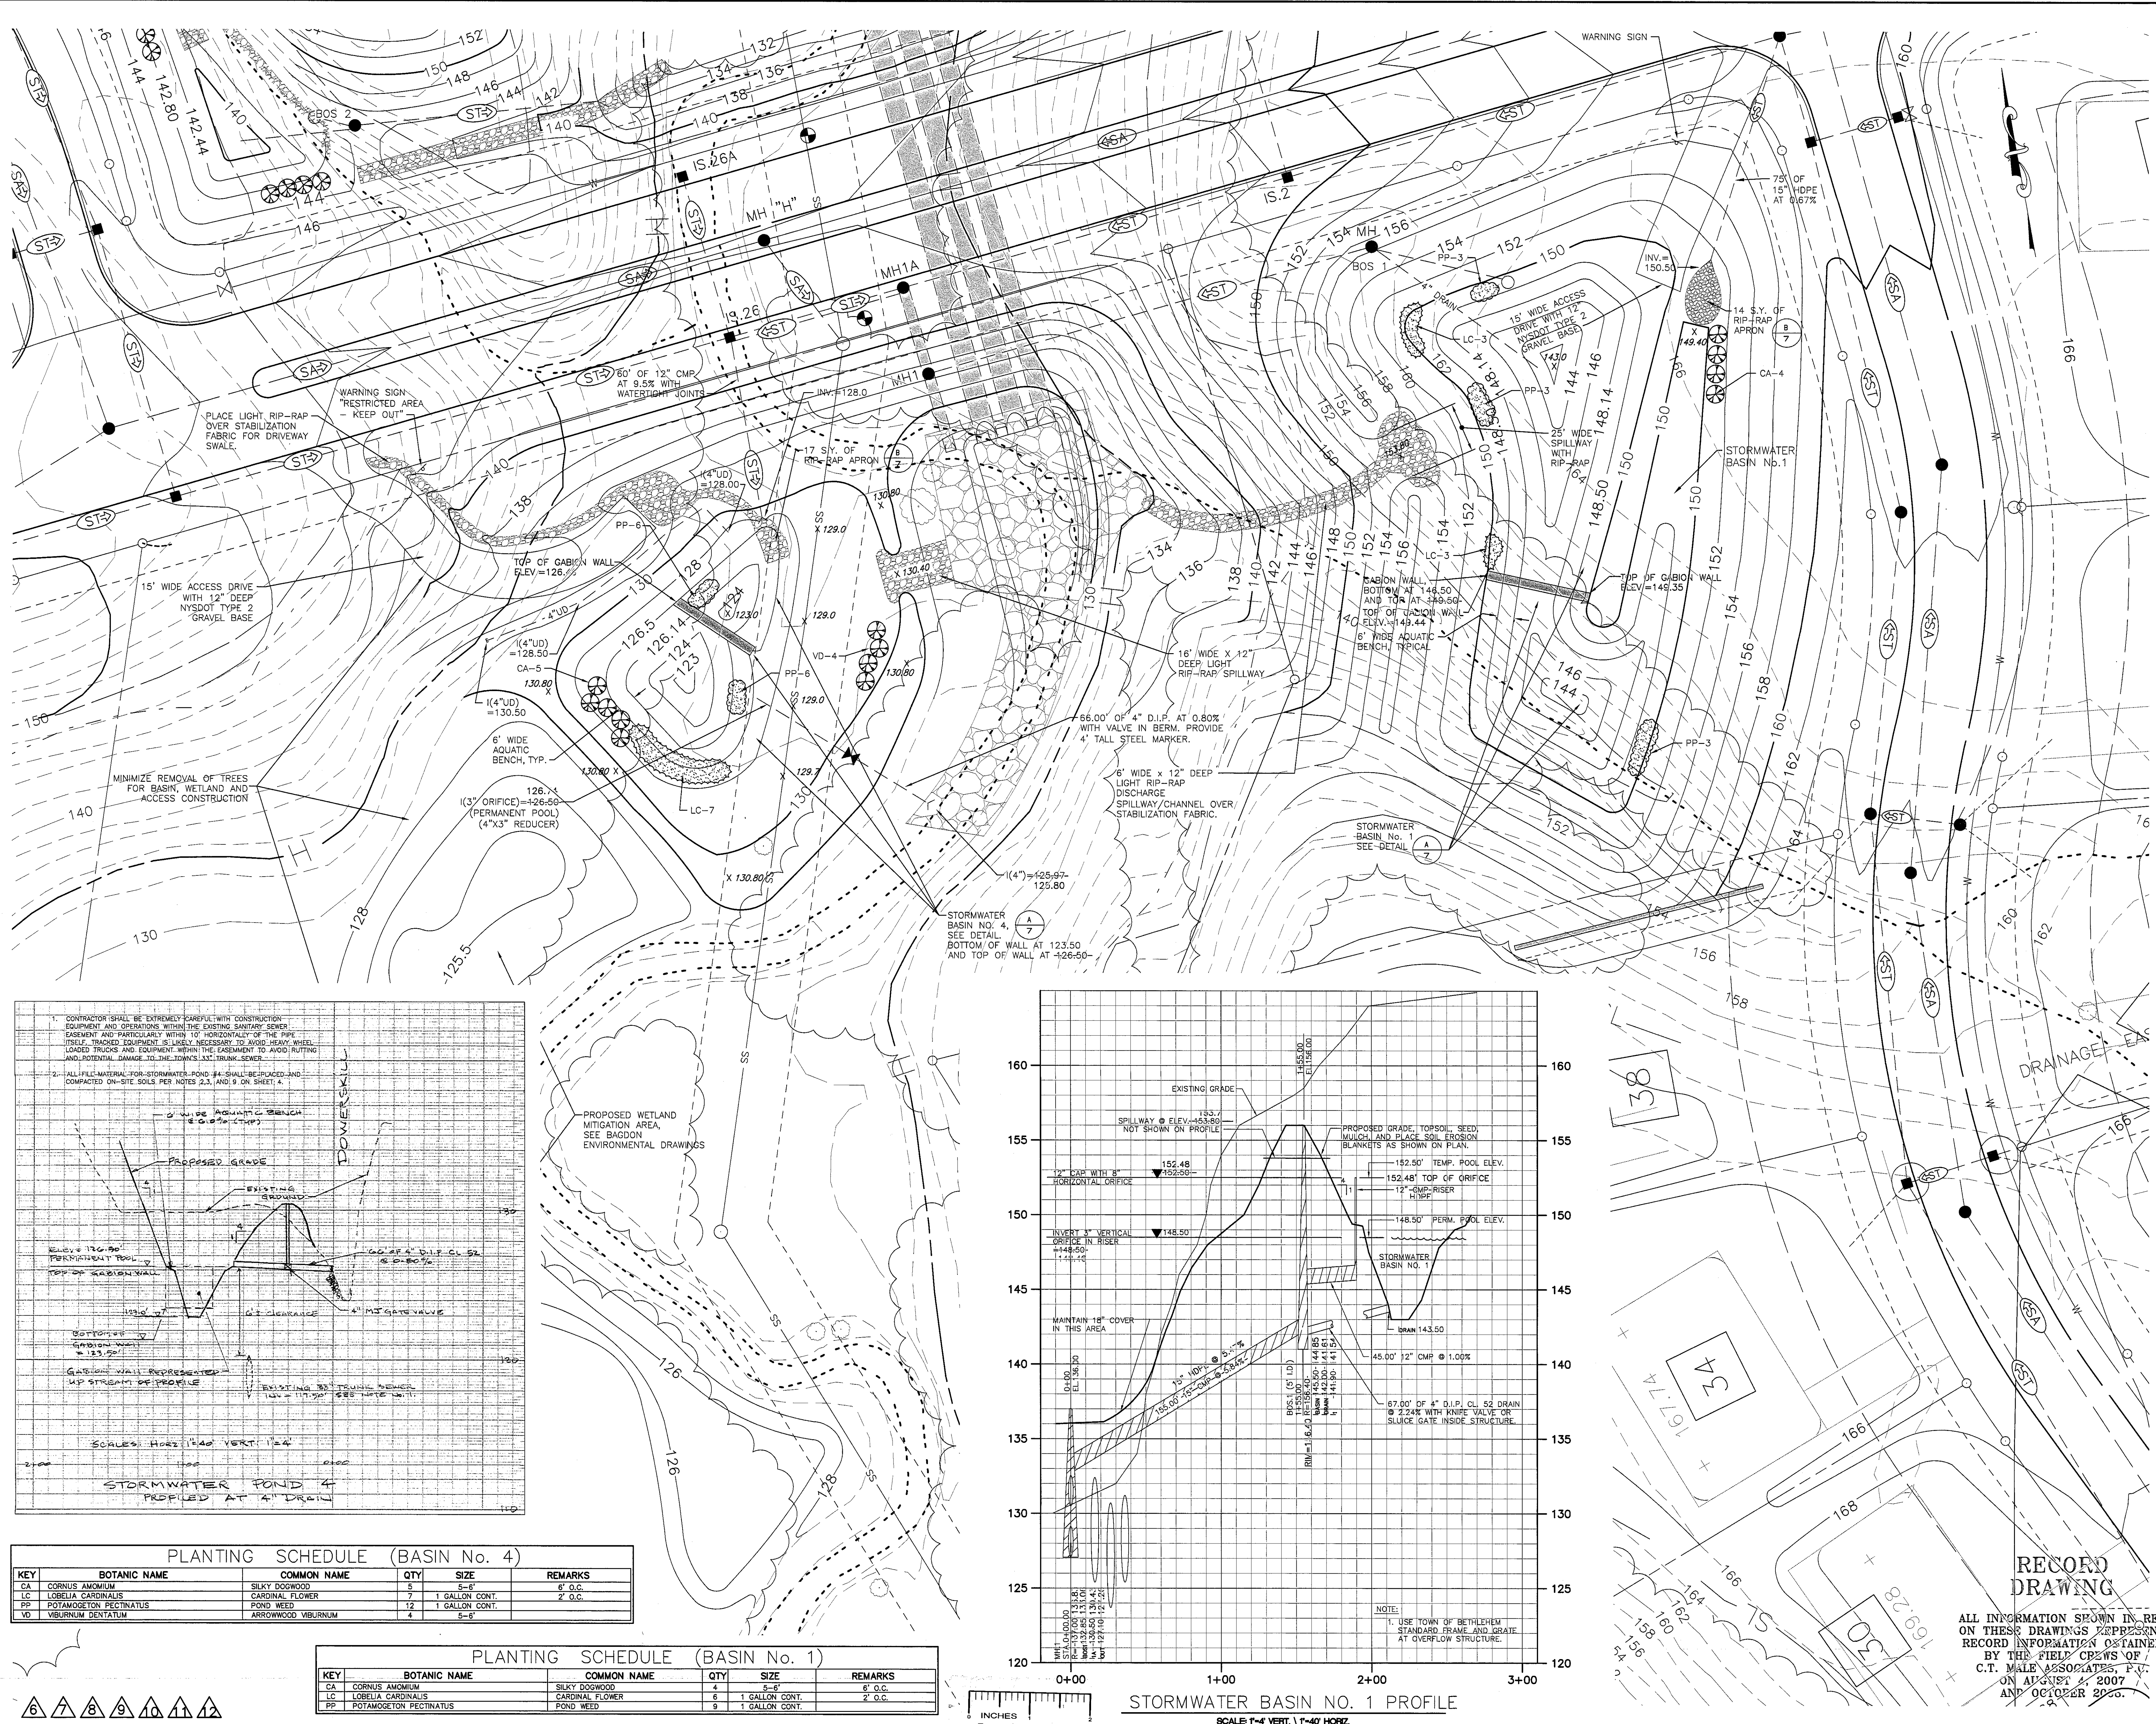

GENERAL NOTES

LEGEND

NOTE:

UNAUTHORIZED ALTERATIONS OR ADDITIONS TO THIS DOCUMENT IS A VIOLATION OF SECTION 7209 SUBDIVISION 2 OF THE NEW YORK STATE EDUCATION LAW.

REVISIONS

DATE	BY	DESCRIPTION	SYMBOL
6/99	CHJ	FINAL PLAN REVISIONS	△
10/99	CHJ	FINAL PLAN REVISIONS	△
3/00	CHJ	FINAL PLAN REVISIONS	△
12/00	CHJ	FINAL PLAN REVISIONS	△
1/26/01	CHJ	FINAL PLAN REVISIONS	△
10/04	CHJ	NEW SHEET ISSUED	△
12/10/04	BOG	ADDED AQUATIC BENCH PER NYSDOT	△
1/06	BOG	MISCELLANEOUS	△
3/06	CHJ	STORMWATER POND 4 & LOT 38 GRADING	△
6/06	BOG	REVISED PER DEC COMMENTS	△
6/28/06	CHJ	REVISED PER TOWN COMMENTS	△

EDWARD W. BOUTELLE AND SON
CIVIL ENGINEERS AND SURVEYORS
423 KENWOOD AVENUE
DELMAR, NEW YORK
TEL.(518) 439-9981 FAX.(518) 439-9982
A DIVISION OF J. KENNETH FRASER AND ASSOCIATES, P.C.

FINAL PLAN AMENDED
CARRIAGE HILL SUBDIVISION
MAP OF LANDS OF CHARLEW CONSTRUCTION CORP.

TOWN OF BETHLEHEM COUNTY OF ALBANY
STATE OF NEW YORK

SCALE: 1"=20'

RECORD DRAWING

ALL INFORMATION SHOWN IN RED ON THESE DRAWINGS REPRESENTS RECORD INFORMATION OBTAINED BY THE FIELD CREWS OF C.T. MALE ASSOCIATES, P.C. ON AUGUST 2007 AND OCTOBER 2006.

PROJ. SURVEYOR: CHJ
DRAWN BY: TWK
ASSEMBLED BY: TWK
CHECKED BY: CHJ


PROJECT NO.: 99-020
CAD FILE NAME: 4103-028

SHEET TITLE:
PARTIAL PLAN AND PROFILE
STORMWATER BASINS 1 AND 4

DATE: NOVEMBER 1995 SHEET 28 OF 31

PLANTING SCHEDULE (BASIN No. 4)					
KEY	BOTANIC NAME	COMMON NAME	QTY	SIZE	REMARKS
CA	CORNUS AMOMUM	SILKY DOGWOOD	5	5-6"	8" O.C.
LC	LOBELIA CARDINALIS	CARDINAL FLOWER	7	1 GALLON CONT.	2" O.C.
PP	POTAMOGETON PECTINATUS	POND WEED	12	1 GALLON CONT.	
VD	VIORNIUM DENTATUM	ARROWWOOD VIBURNUM	4	5-6"	

PLANTING SCHEDULE (BASIN No. 1)					
KEY	BOTANIC NAME	COMMON NAME	QTY	SIZE	REMARKS
CA	CORNUS AMOMUM	SILKY DOGWOOD	4	5-6"	8" O.C.
LC	LOBELIA CARDINALIS	CARDINAL FLOWER	6	1 GALLON CONT.	2" O.C.
PP	POTAMOGETON PECTINATUS	POND WEED	9	1 GALLON CONT.	

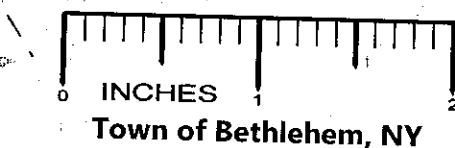

STORMWATER BASIN NO. 1 PROFILE
SCALE: 1"=4' VERT. 1"=40' HORIZ.

RECORD
DRAWING

ALL INFORMATION SHOWN IN RED ON THESE DRAWINGS REPRESENTS RECORD INFORMATION OBTAINED BY THE FIELD CREWS OF C.T. MALE ASSOCIATES, P.C. ON AUGUST 2007 AND OCTOBER 2006.