


STORMWATER BASIN NO. 3 ENLARGEMENT PLAN
SCALE: 1"= 20'

KEY	BOTANIC NAME	COMMON NAME	QTY	SIZE	REMARKS
LC	LOBELIA CARDINALIS	CARDINAL FLOWER	12	1 GALLON CONT.	2' G.C.
PP	POTAMOGETON PECTINATUS	POND WEED	12	1 GALLON CONT.	
VD	VIBURNUM DENTATUM	ARROWWOOD VIBURNUM	2	4"-5"	

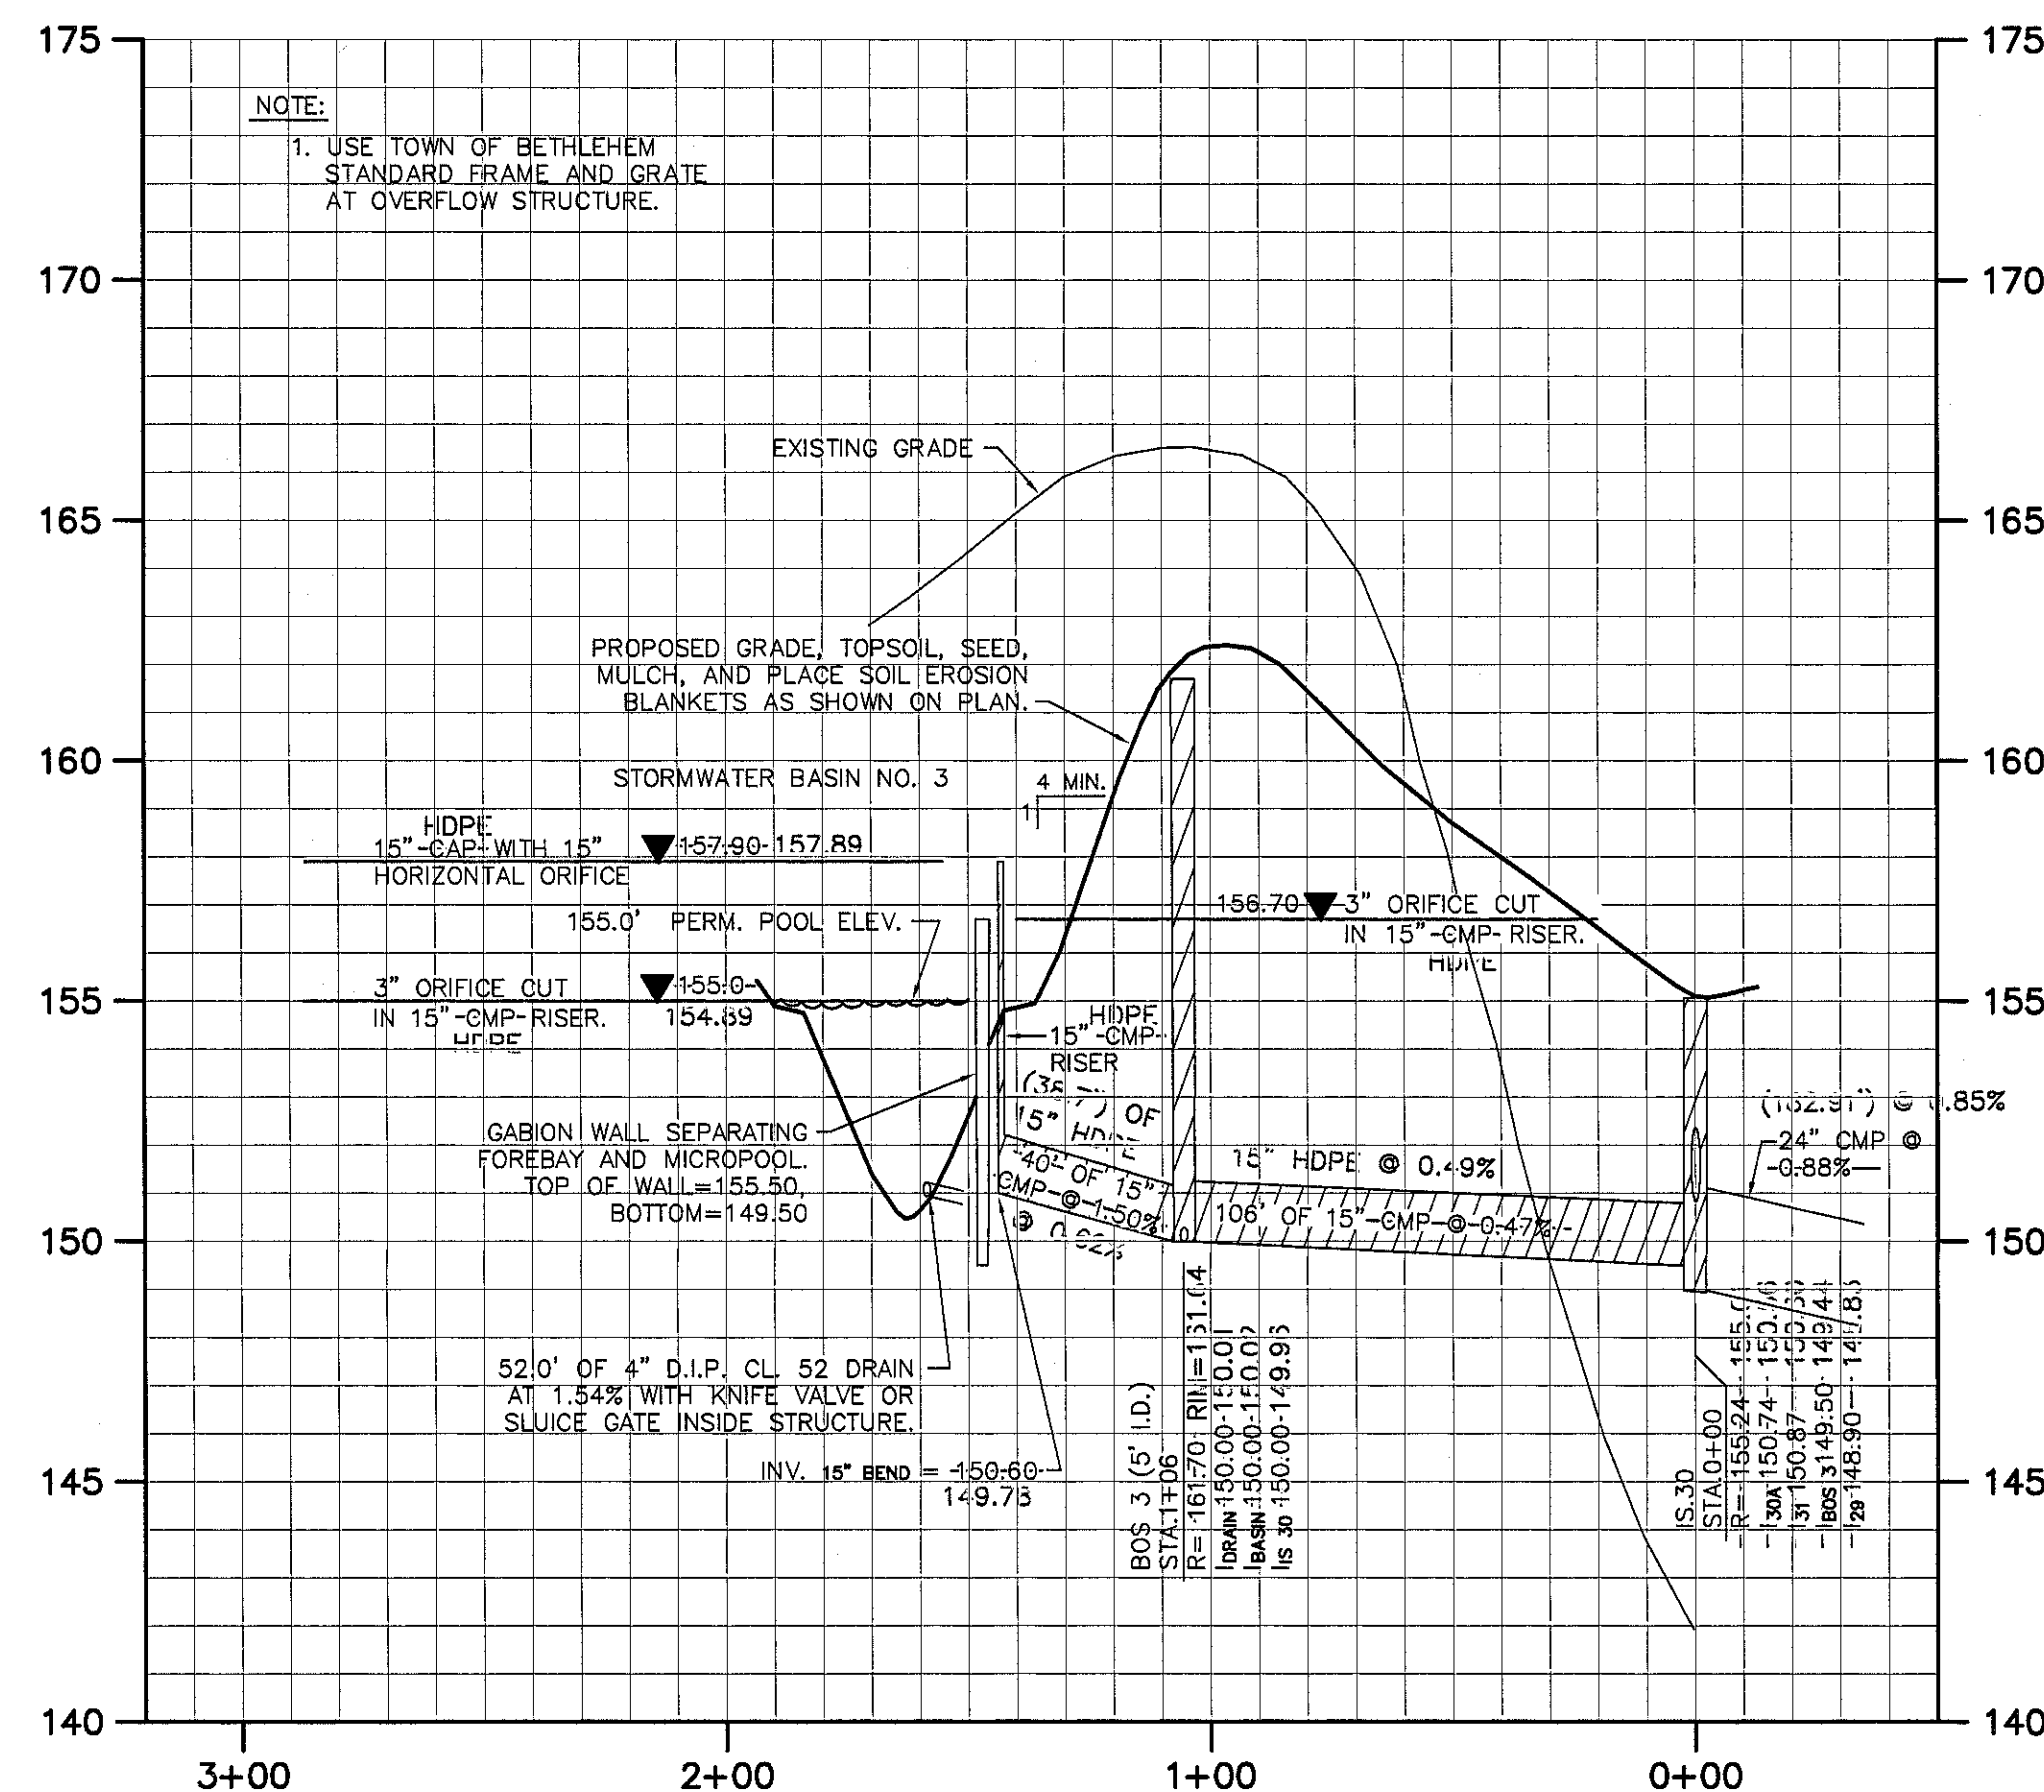

STORMWATER BASIN NO. 3 PROFILE
SCALE: 1"=4' VERT. \ 1"=40' HORIZ.

LEGEND	
PROPOSED MANHOLE	PROPOSED INLET WITH FOOTING DRAIN
PROPOSED INLET	PROPOSED MANHOLE WITH FOOTING DRAIN
EROSION CONTROL AT CATCH BASIN	FENCING
WATER VALVE	EASEMENT LINE
FIRE HYDRANT	SETBACK LINE
PROPERTY LINE	STREAM
WATER MAIN	TREE LINE
SANITARY SEWER	CLOSING LIMIT
STORM SEWER	CONTOUR (PRO)
PROPOSED END SECTION	CONTOUR LINE
SEWER DISTRICT	SPOT ELEVATION
SEWER DISTRICT	TREE (DECIDUOUS)
ZONING DISTRICT	LOT NUMBER
YEAR FLOOD PLAN	SUBCATCHMENT
15% SLOPE LINE-SEE NOTE 22	PRESERVED FEDERAL RIGHT-OF-WAY
TEMPORARY SWALE	APPROXIMATE LOCATION BUILDING ENVELOPE
SEWAGE TREATMENT PLANT	TEMPORARY RIPRAP OUTLET SEDIMENT TRAP
WELL WATER	CHECK DAM
DRAINAGE LIMITS	EXISTING WETLAND BOUNDARY
SLT FENCE	
PROPOSED ELEVATION	
PROPOSED FINISHED FLOOR GRADE	

NOTE:
THE SWPPP, "CONSTRUCTION PHASE OPERATION AND MAINTENANCE MANUAL" AND THE "POST CONSTRUCTION PHASE OPERATION AND MAINTENANCE MANUAL" INDICATE THAT THE DEVELOPER IS RESPONSIBLE FOR INSPECTION AND MAINTENANCE OF THE STORMWATER SYSTEM UNTIL THE TOWN HAS AGREED TO TAKE OVER THE SYSTEM, WHICH WILL OCCUR AT A MINIMUM OF 1 YEAR AFTER FULL-BUILDOUT OF THE HOMES WITHIN THE SUBDIVISION IS ACHIEVED. THE DEVELOPER SHALL SUPPLY A MAINTENANCE BOND TO THE TOWN DURING THIS PERIOD. THE STORMWATER BASINS SHALL BE CONVEYED TO THE TOWN, ALONG WITH THE ROAD RIGHTS-OF-WAY, BEFORE A BUILDING PERMIT IS ISSUED.

UNAUTHORIZED ALTERATIONS OR ADDITIONS TO THIS DOCUMENT IS A VIOLATION OF SECTION 7209 SUBDIVISION 2 OF THE NEW YORK STATE EDUCATION LAW

REVISIONS			
DATE	BY	DESCRIPTION	SYMBOL
6/99	CHJ	FINAL PLAN REVISIONS	△
10/99	CHJ	FINAL PLAN REVISIONS	△
5/00	CHJ	FINAL PLAN REVISIONS	△
12/00	CHJ	FINAL PLAN REVISIONS	△
1/26/01	CHJ	FINAL PLAN REVISIONS	△
10/04	CHJ	ADDED NEW SHEET	△
12/10/04	BOG	ADDED AQUATIC BENCH PER NYSDC	△
1/06	BOG	MISCELLANEOUS	△
3/06	CHJ	MISCELLANEOUS	△
4/06	CHJ	MISCELLANEOUS REVISIONS	△
6/06	BOG	REVISED PER DEC COMMENTS	△
6/28/06	CHJ	REVISED PER TOWN COMMENTS	△

EDWARD W. BOUTELLE
AND SON
CIVIL ENGINEERS AND SURVEYORS
423 KENWOOD AVENUE
DELMAR, NEW YORK
TEL.(518) 439-9981 FAX.(518) 439-9982
A DIVISION OF J. KENNETH FRASER AND ASSOCIATES, P.C., L.L.C.

FINAL PLAN
AMENDED
CARRIAGE HILL
SUBDIVISION
MAP OF LANDS OF
CHARLEW
CONSTRUCTION CORP.

TOWN OF BETHLEHEM COUNTY OF ALBANY
STATE OF NEW YORK

SCALE: 1"=20'

RECORD
DRAWING

ALL INFORMATION SHOWN IN RED
ON THESE DRAWINGS REPRESENT
RECORD INFORMATION OBTAINED
BY THE FIELD CREWS OF
C.T. MALE ASSOCIATES, P.C.
ON AUGUST 4, 2007 AND
OCTOBER 2008.

PROJ. SURVEYOR: CHJ
DRAWN BY: TWK
ASSEMBLED BY: TWK
CHECKED BY: CHJ

PROJECT NO.: 99-020
CAD FILE NAME: 4103-030

SHEET TITLE:
PARTIAL PLAN AND PROFILE
STORMWATER BASIN 3

DATE: NOVEMBER 1995 SHEET 30 OF 31

COPYRIGHT 1999 J. KENNETH FRASER AND ASSOCIATES, P.C.