

GENERAL NOTES

UNAUTHORIZED ALTERATIONS OR ADDITIONS TO THIS DOCUMENT IS A VIOLATION OF SECTION 7209 SUBDIVISION 2 OF THE NEW YORK STATE EDUCATION LAW

REVISIONS

DATE	BY	DESCRIPTION	SYMBOL
8/99	CHJ	FINAL PLAN REVISIONS	△
10/99	CHJ	FINAL PLAN REVISIONS	△
5/00	CHJ	FINAL PLAN REVISIONS	△
12/00	CHJ	FINAL PLAN REVISIONS	△
1/28/01	CHJ	FINAL PLAN REVISIONS	△
10/04	CHJ	FINAL PLAN REVISIONS	△
9/05	CHJ	LOT LINE CHANGES	△
1/06	CHJ	MISCELLANEOUS REVISIONS	△
3/06	CHJ	MISCELLANEOUS REVISIONS	△
4/06	CHJ	MISCELLANEOUS REVISIONS	△
6/28/06	CHJ	REVISED PER TOWN COMMENTS	△

EDWARD W. BOUTELLE
AND SON
CIVIL ENGINEERS AND SURVEYORS
423 KENWOOD AVENUE
DELMAR, NEW YORK
TEL.(516) 439-9981 FAX.(516) 439-9982
A DIVISION OF J. KENNETH FRASER AND ASSOCIATES, P.E., L.L.P.

FINAL PLAN
AMENDED
CARRIAGE HILL
SUBDIVISION
MAP OF LANDS OF
CHARLEW
CONSTRUCTION CORP.

TOWN OF BETHLEHEM COUNTY OF ALBANY
STATE OF NEW YORK


SCALE: AS NOTED

PROJ. SURVEYOR: CHJ
DRAWN BY: TWK
ASSEMBLED BY: TWK
CHECKED BY: CHJ


PROJECT NO.: 99-020
CAD FILE NAME: 4103-019

SHEET TITLE: PLAN & PROFILE
DRAINAGE EASEMENTS "A", "B" AND "F"


DATE: NOVEMBER 1995 SHEET 19 OF 31

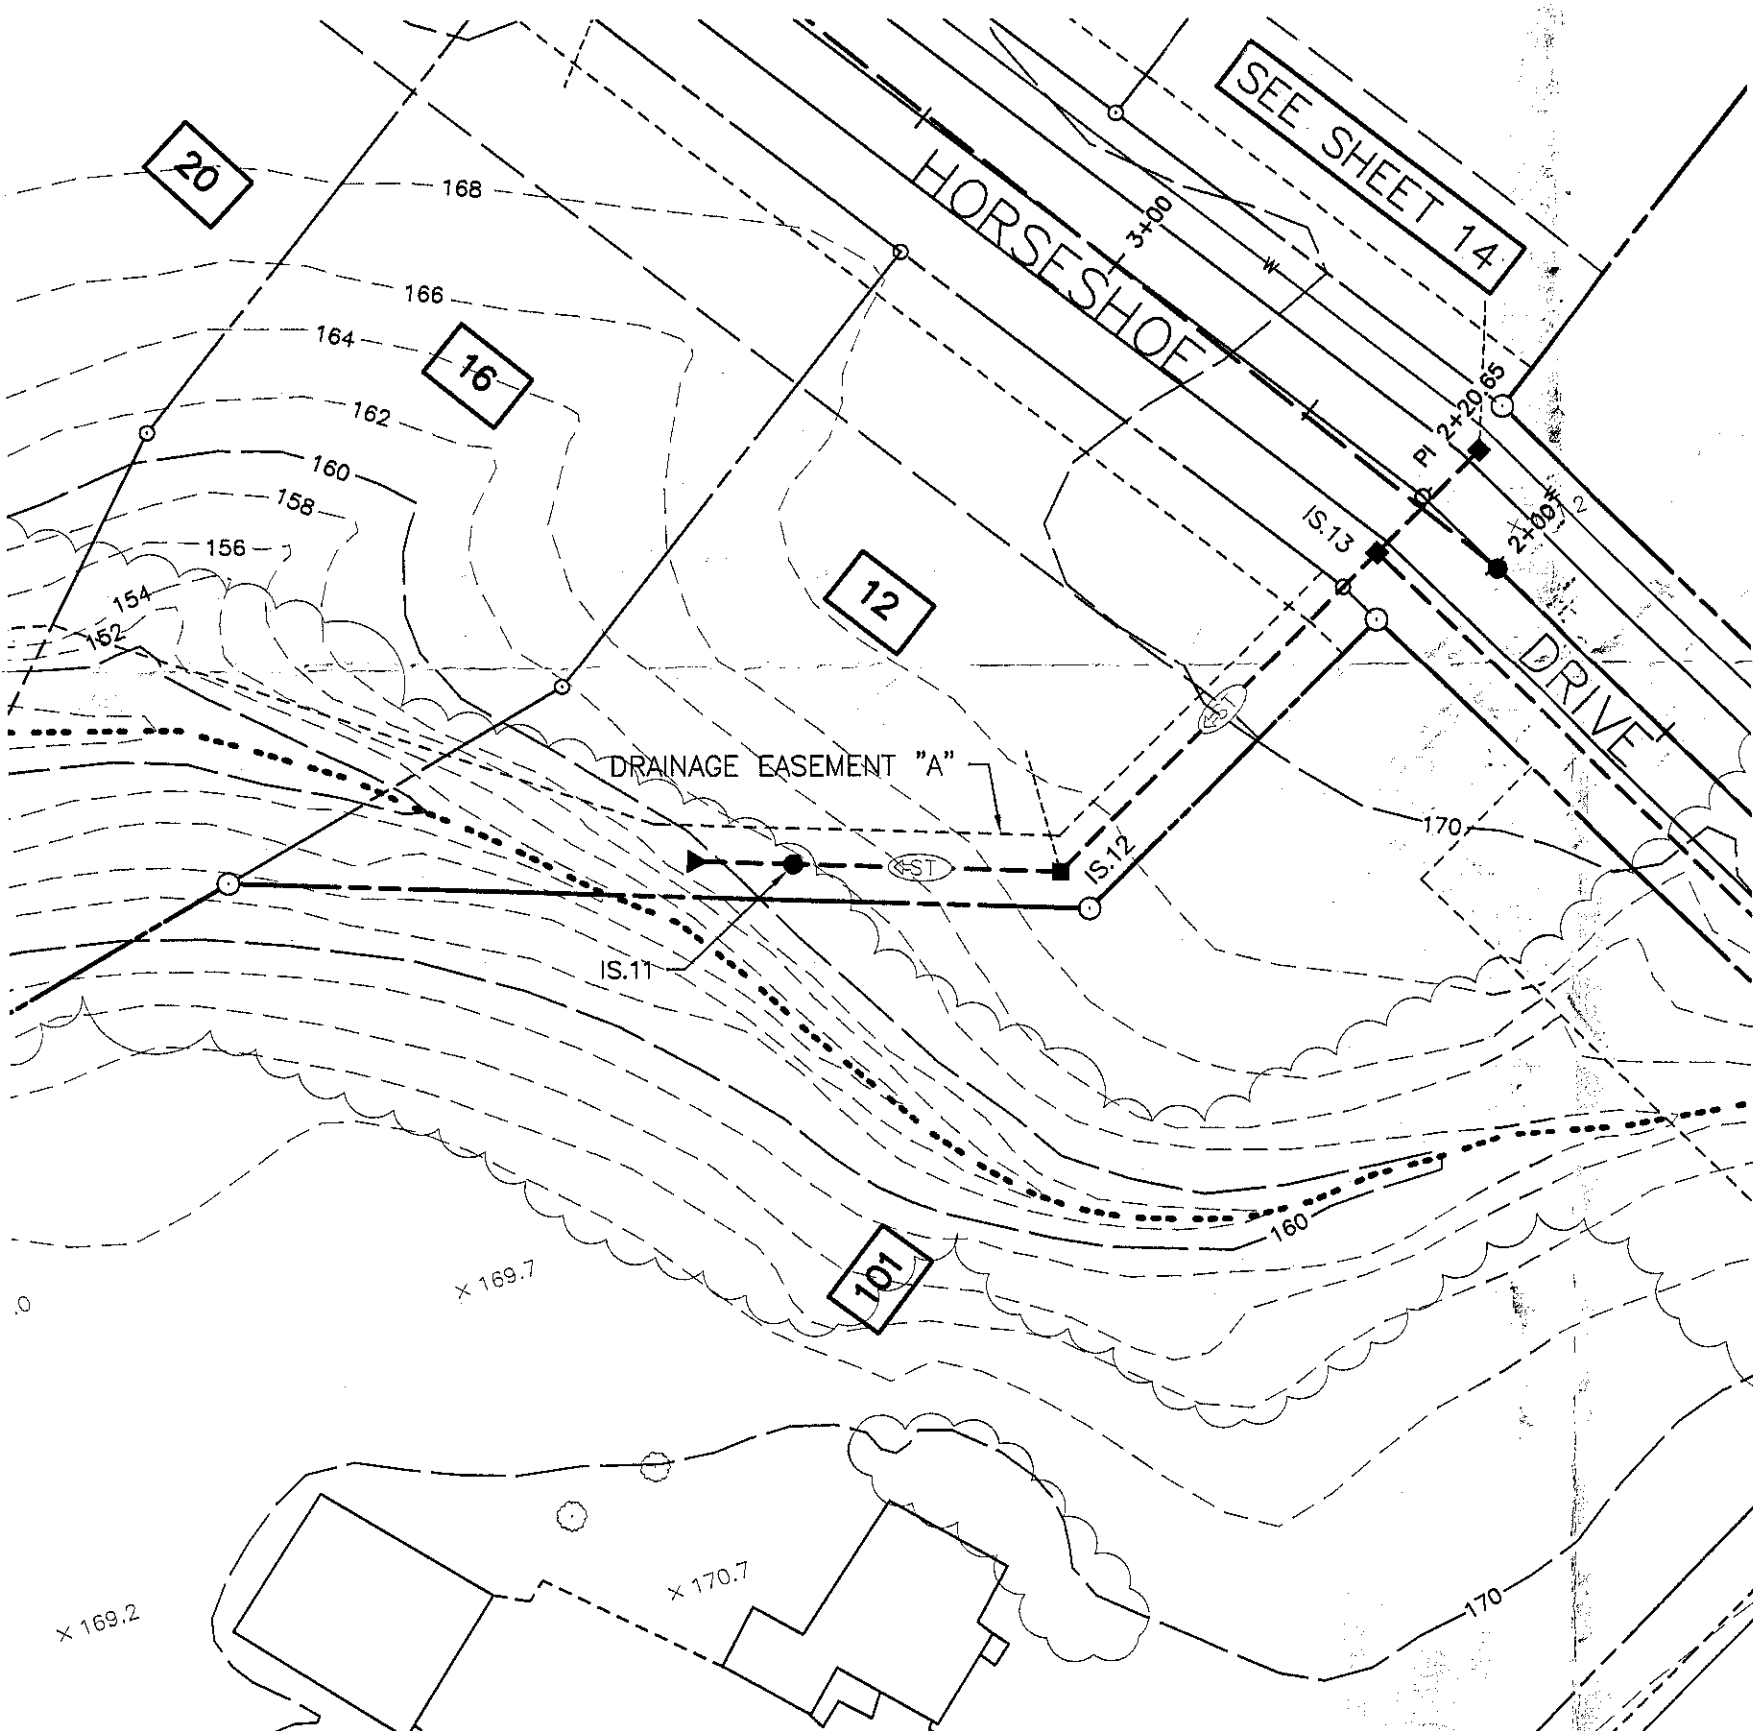


GENERAL PLAN - DRAINAGE EASEMENT "A"
SCALE: 1" = 40'

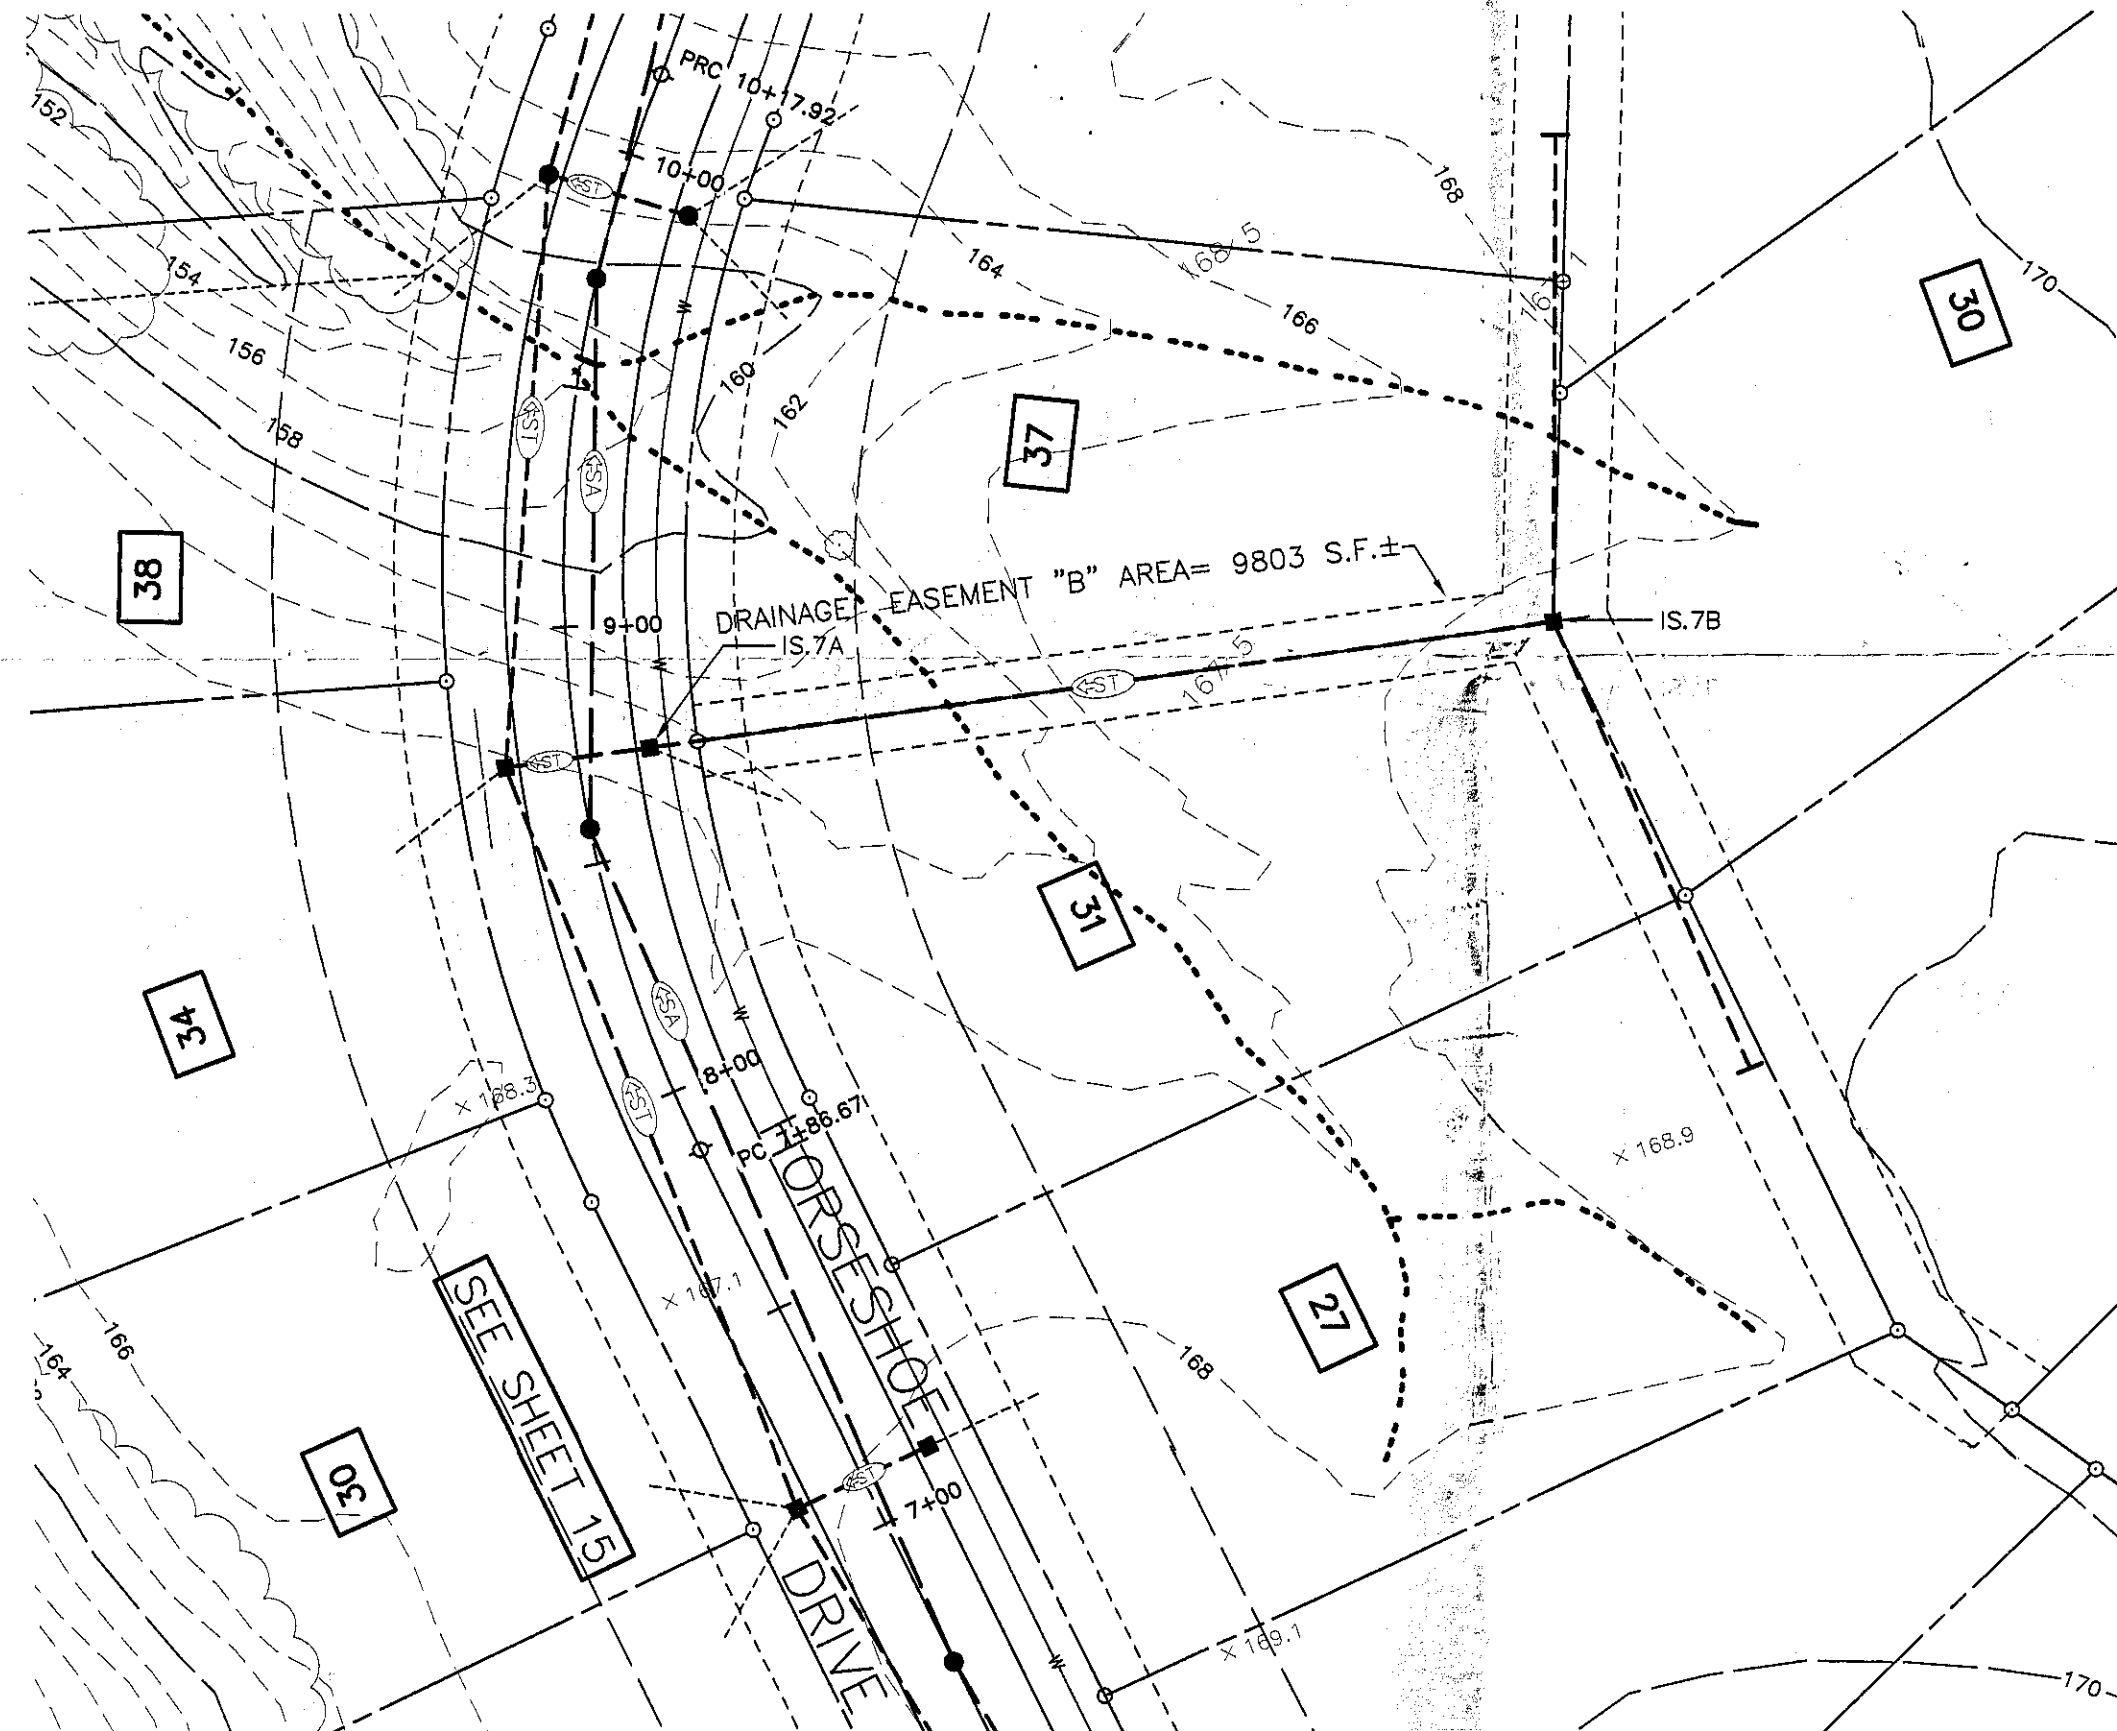


GENERAL PLAN - DRAINAGE EASEMENT "B"
SCALE: 1" = 40'

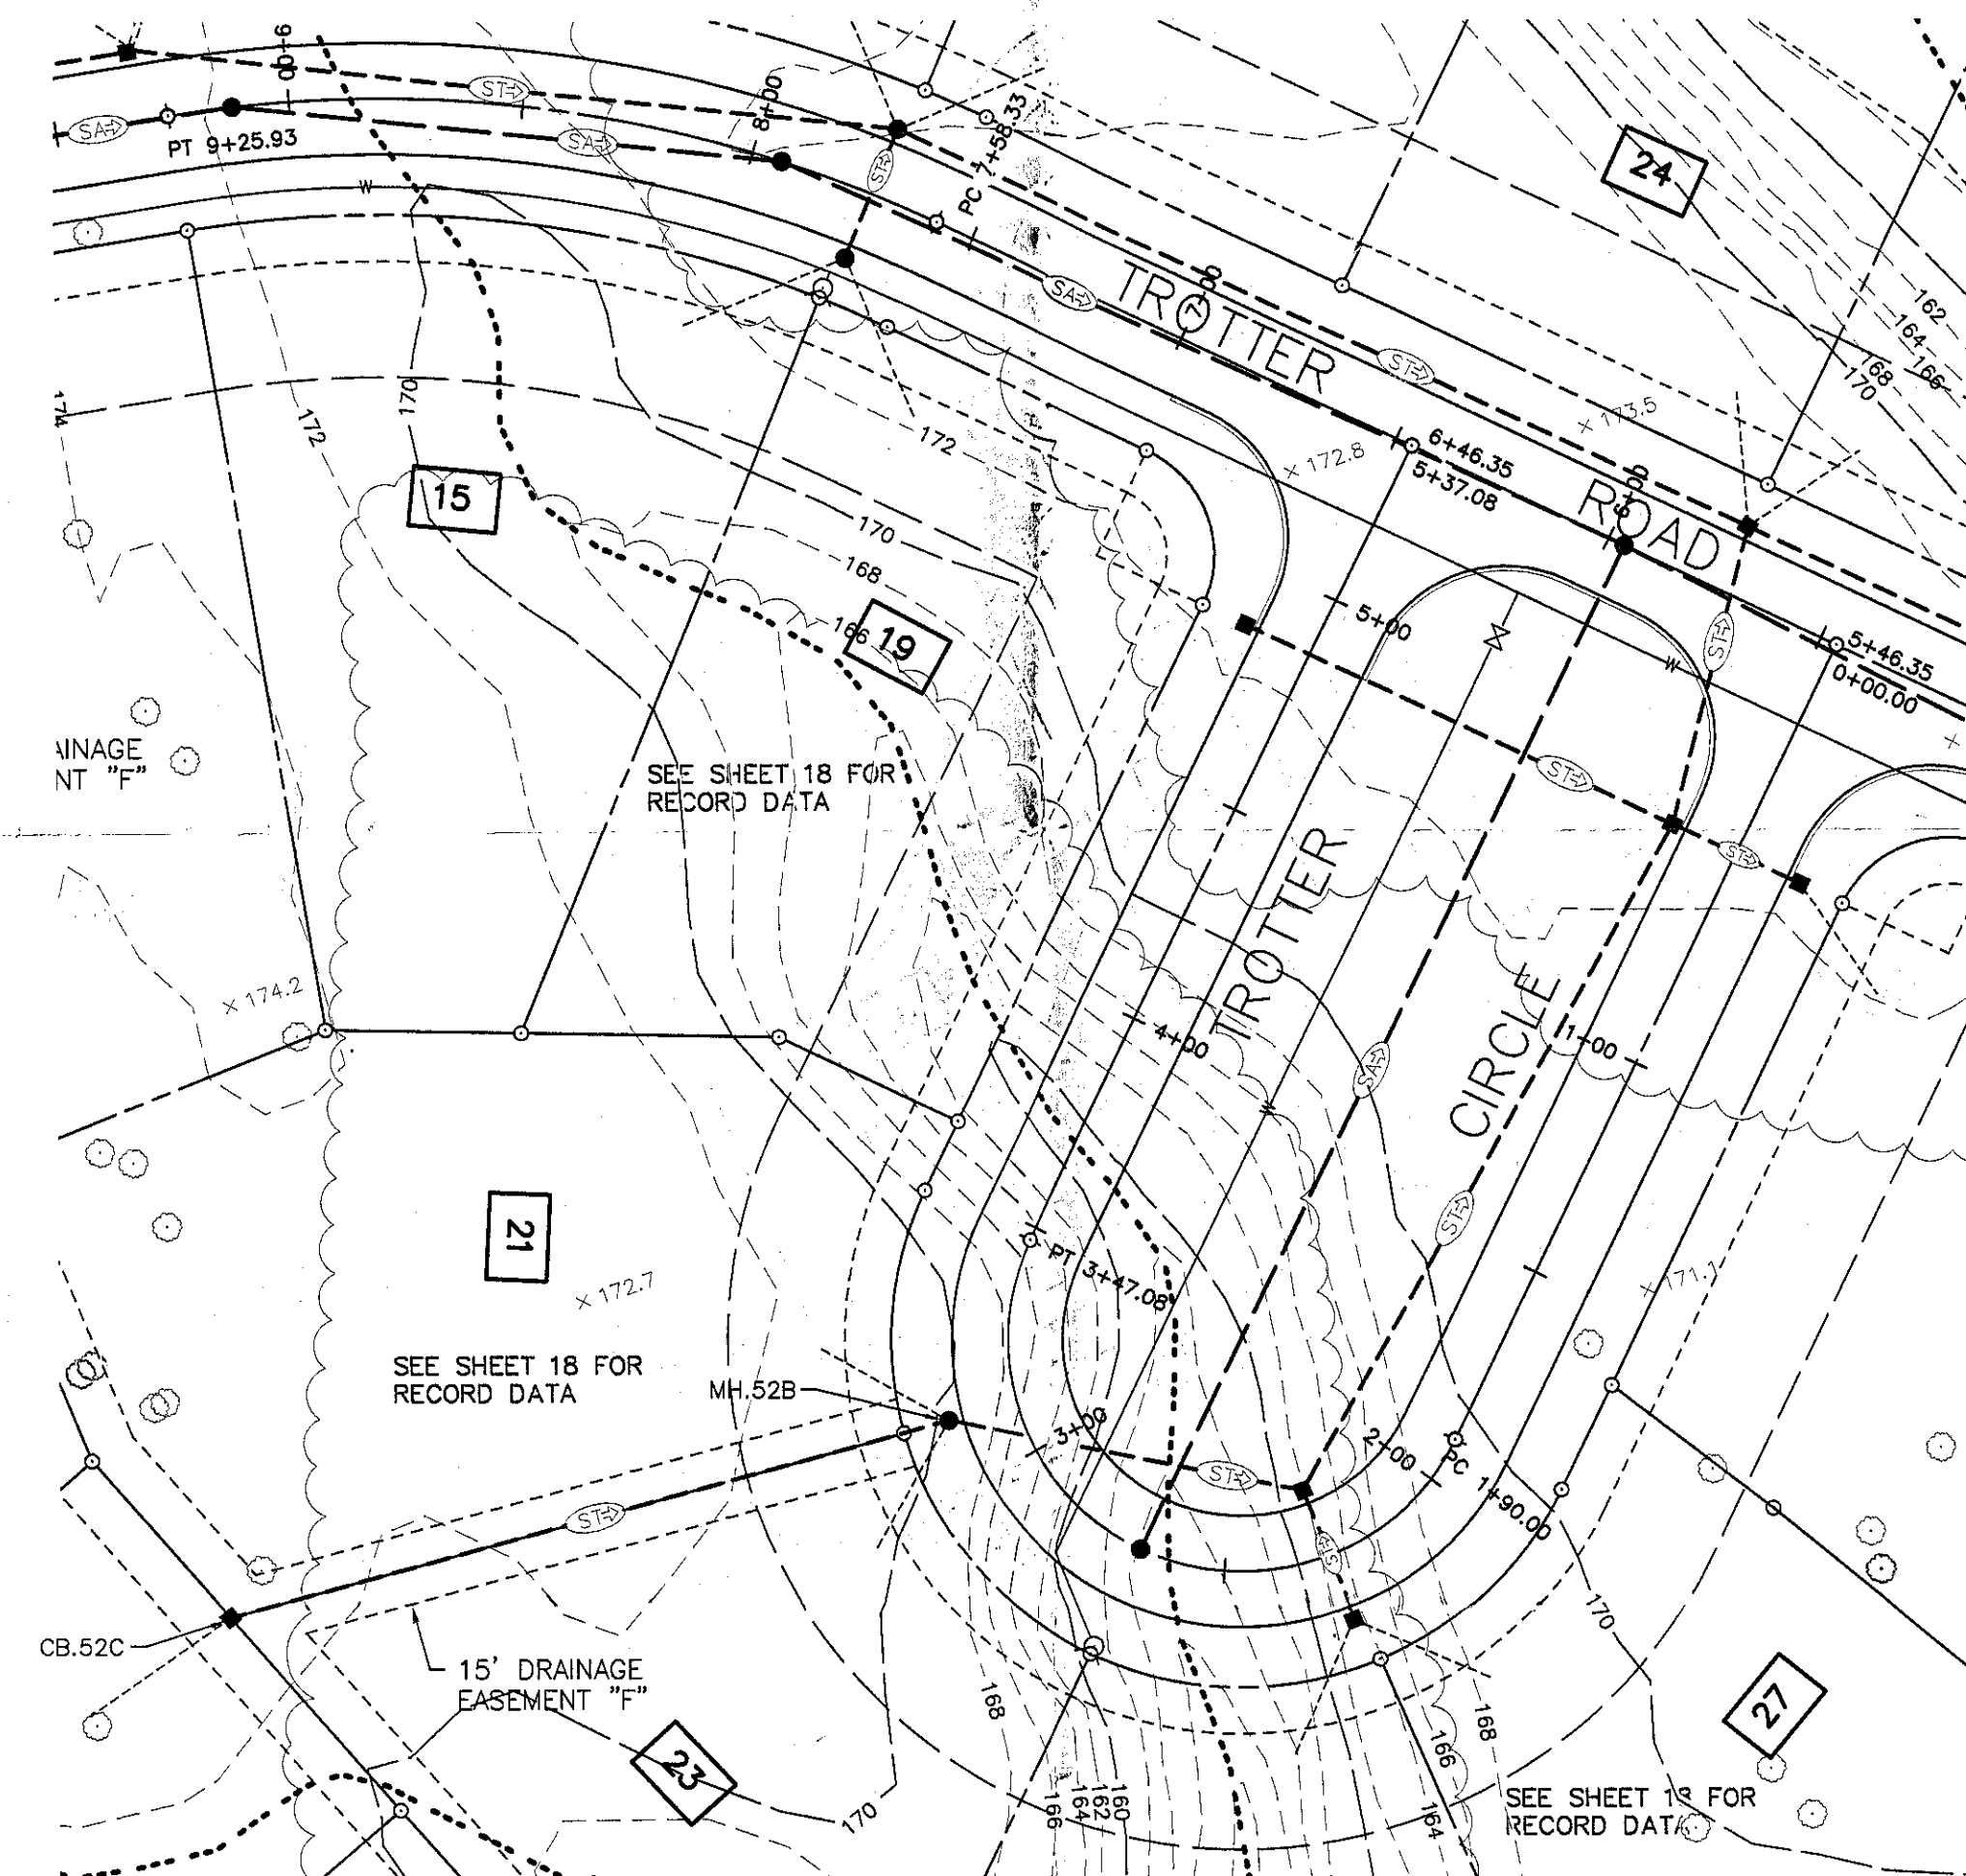


GENERAL PLAN - DRAINAGE EASEMENT "F"
SCALE: 1" = 40'

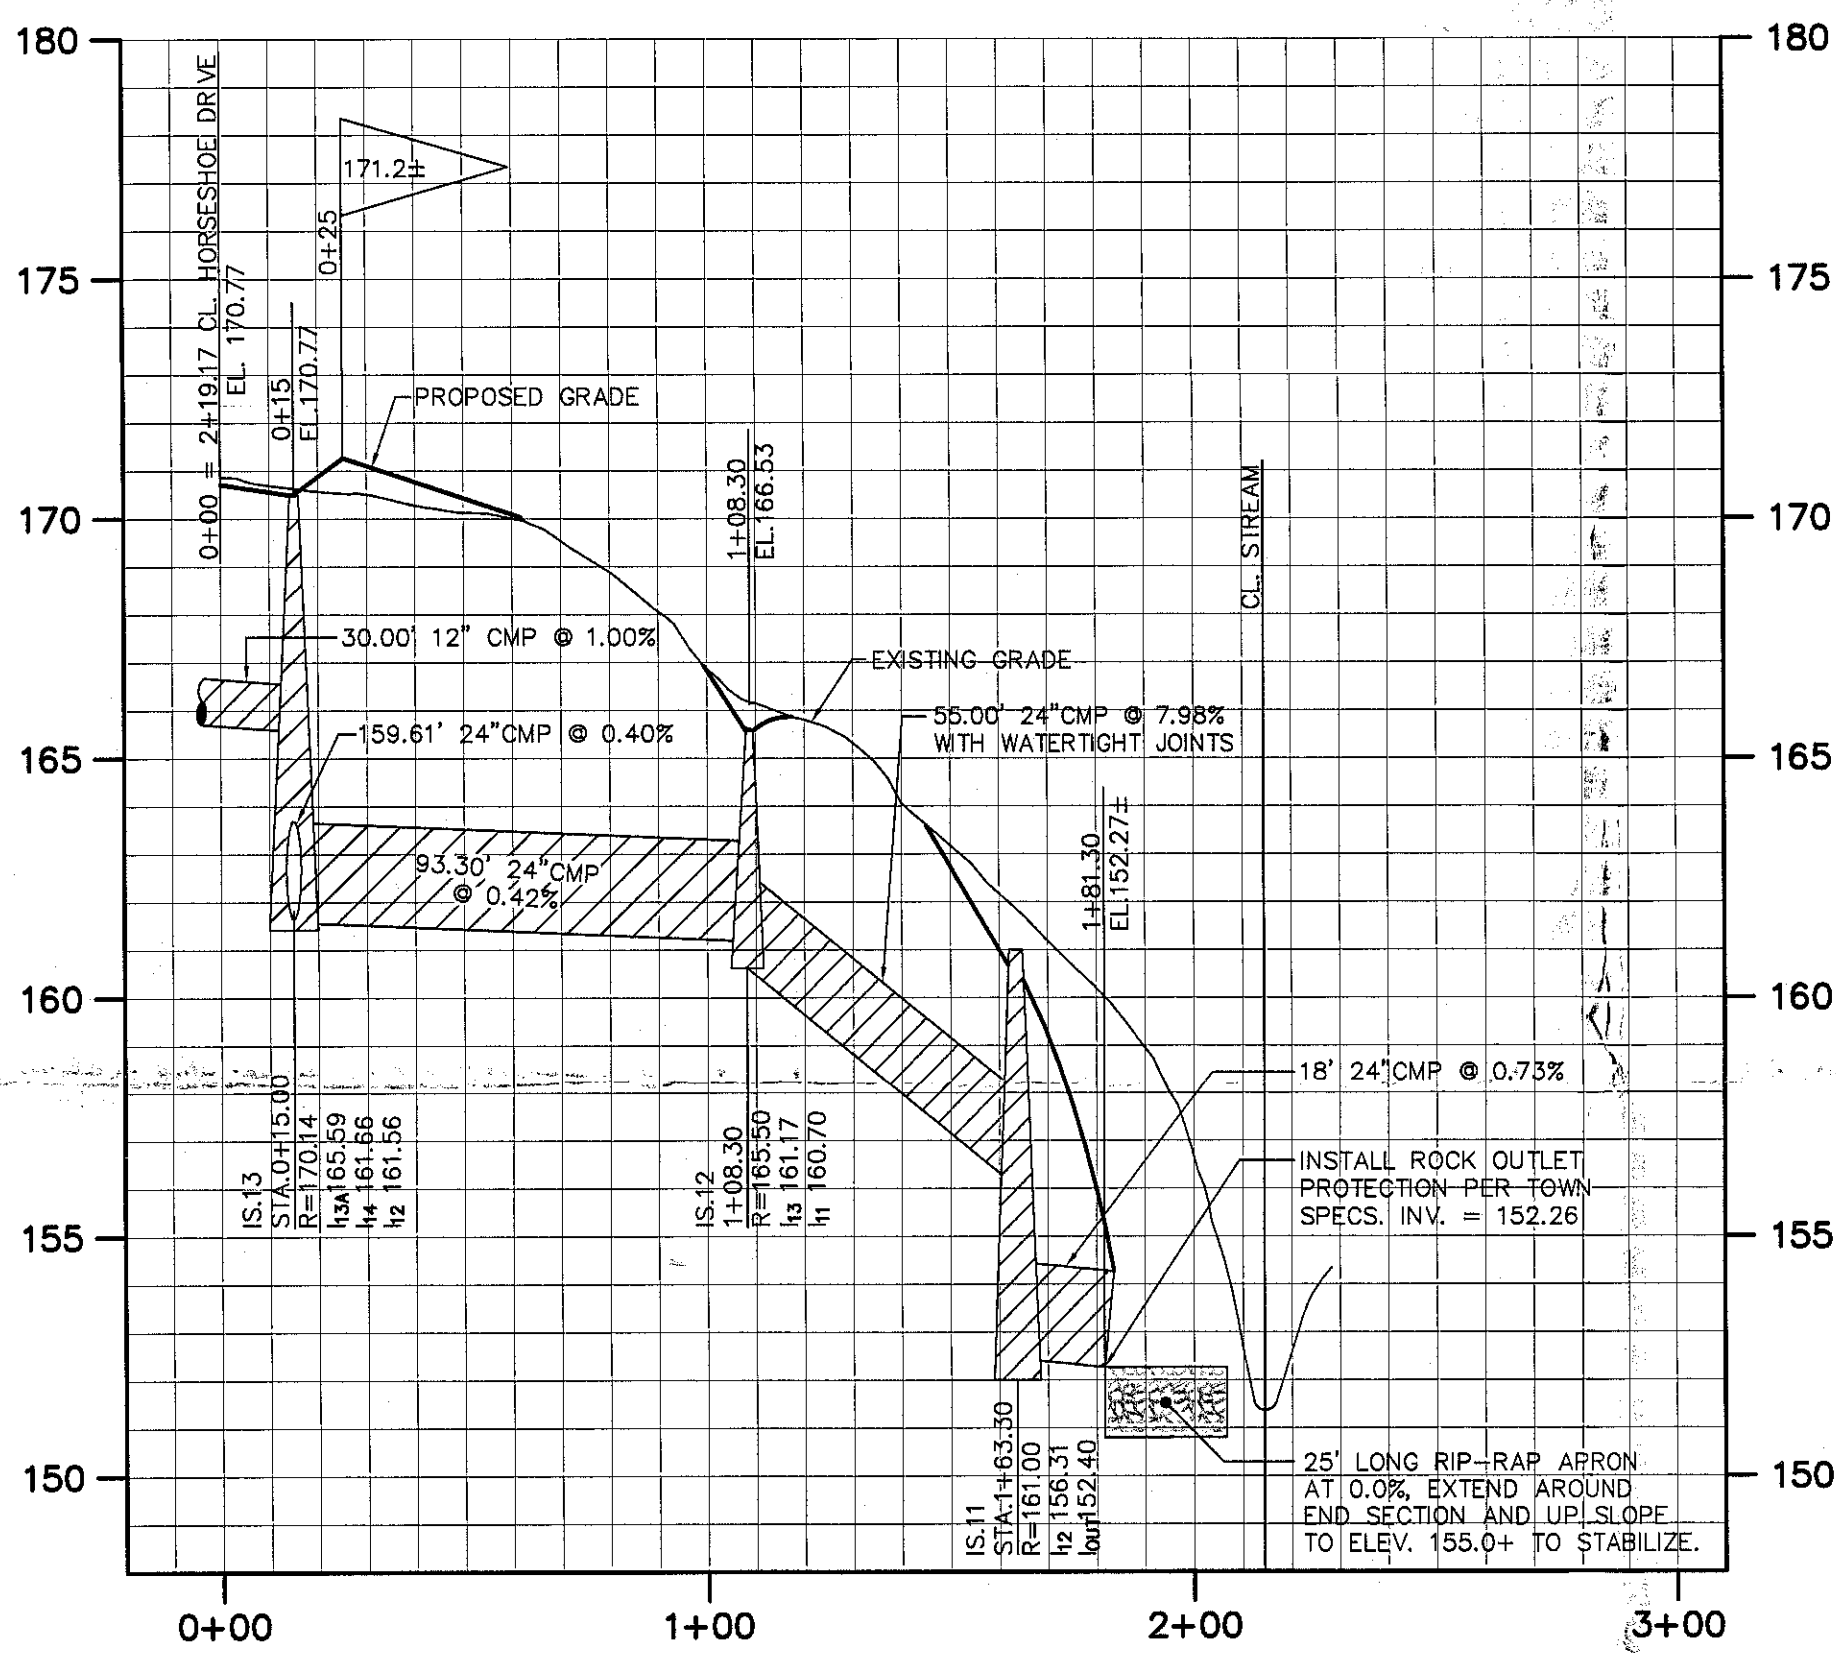

PROFILE - EASEMENT "A"
SCALE: 1"=4' VERT. / 1"=40' HORIZ.

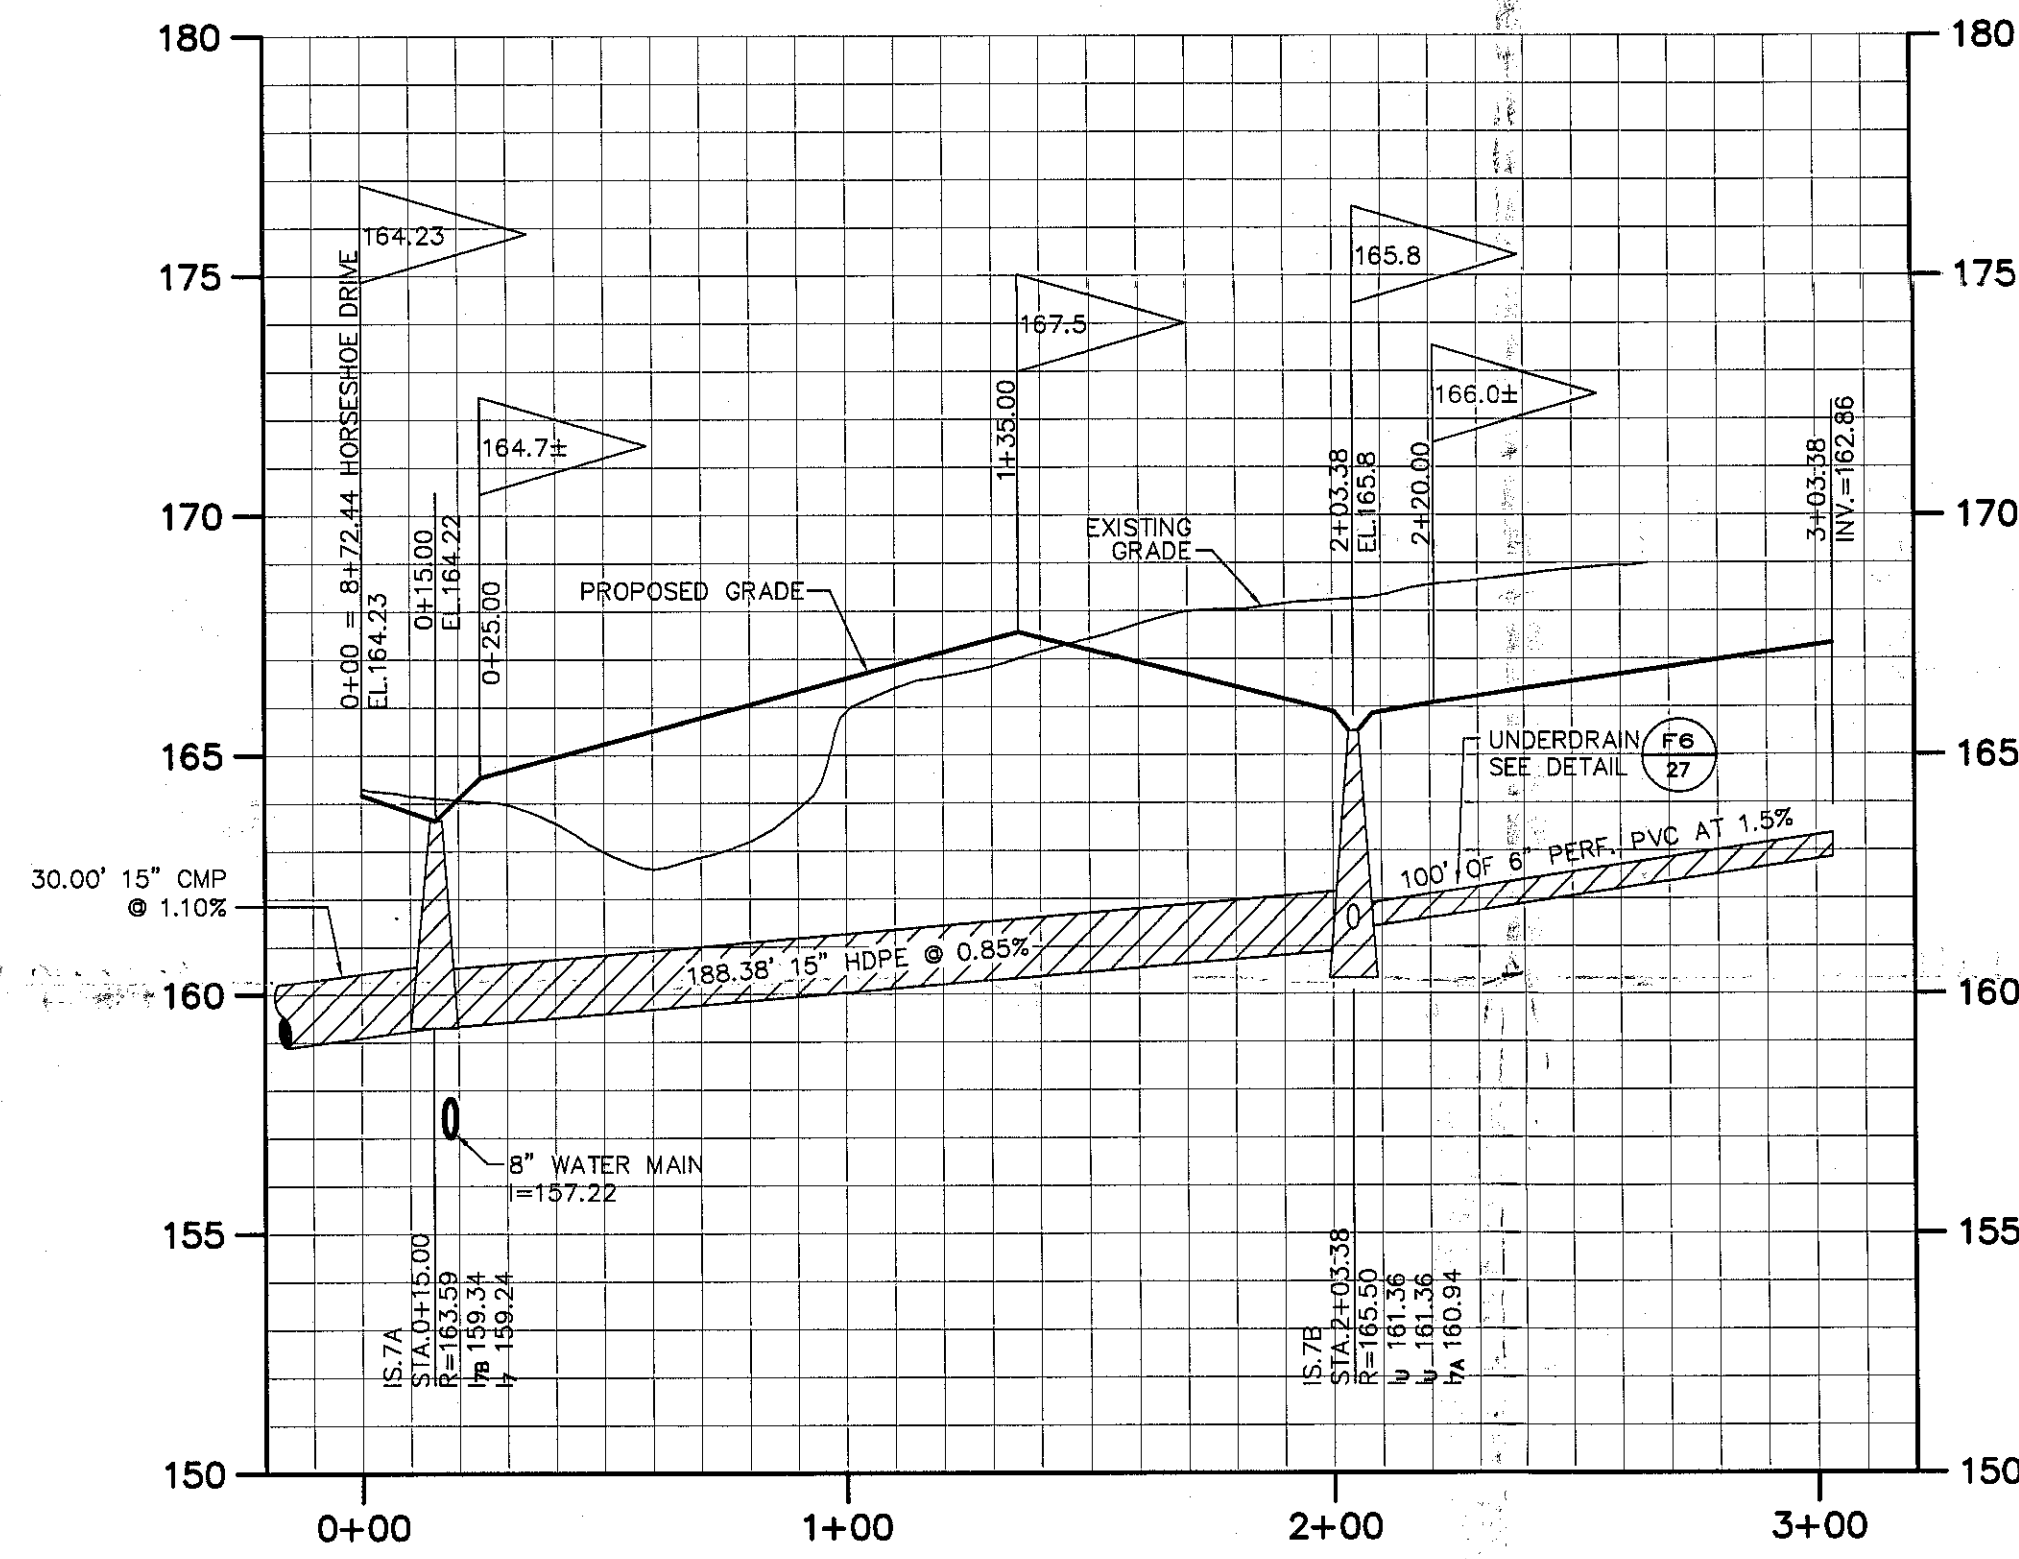


PROFILE - EASEMENT "B"
SCALE: 1"=4' VERT. / 1"=40' HORIZ.

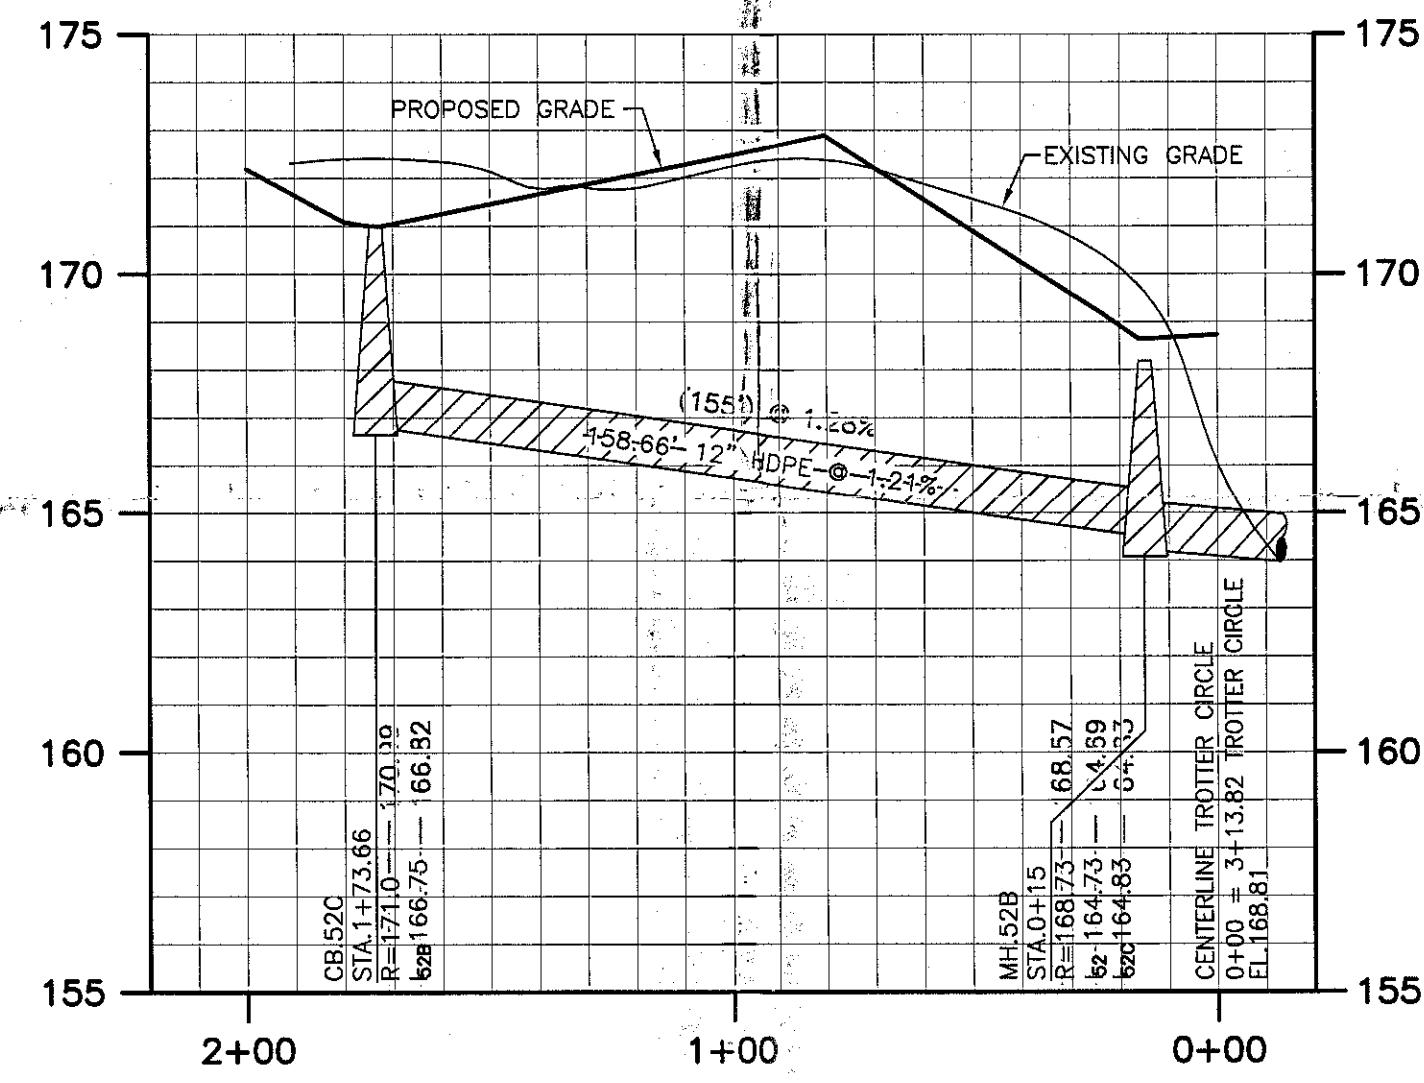

PROFILE - EASEMENT "F"
SCALE: 1"=4' VERT. / 1"=40' HORIZ.

RECORD
DRAWING

ALL INFORMATION SHOWN IN RED
ON THESE DRAWINGS REPRESENT
RECORD INFORMATION OBTAINED
BY THE FIELD CREWS OF
C.T. MALE ASSOCIATES, P.C.
DURING THE MONTH AUGUST 2010.

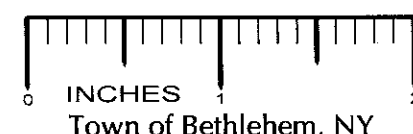

COPYRIGHT 1999 J. KENNETH FRASER AND ASSOCIATES, P.C.