


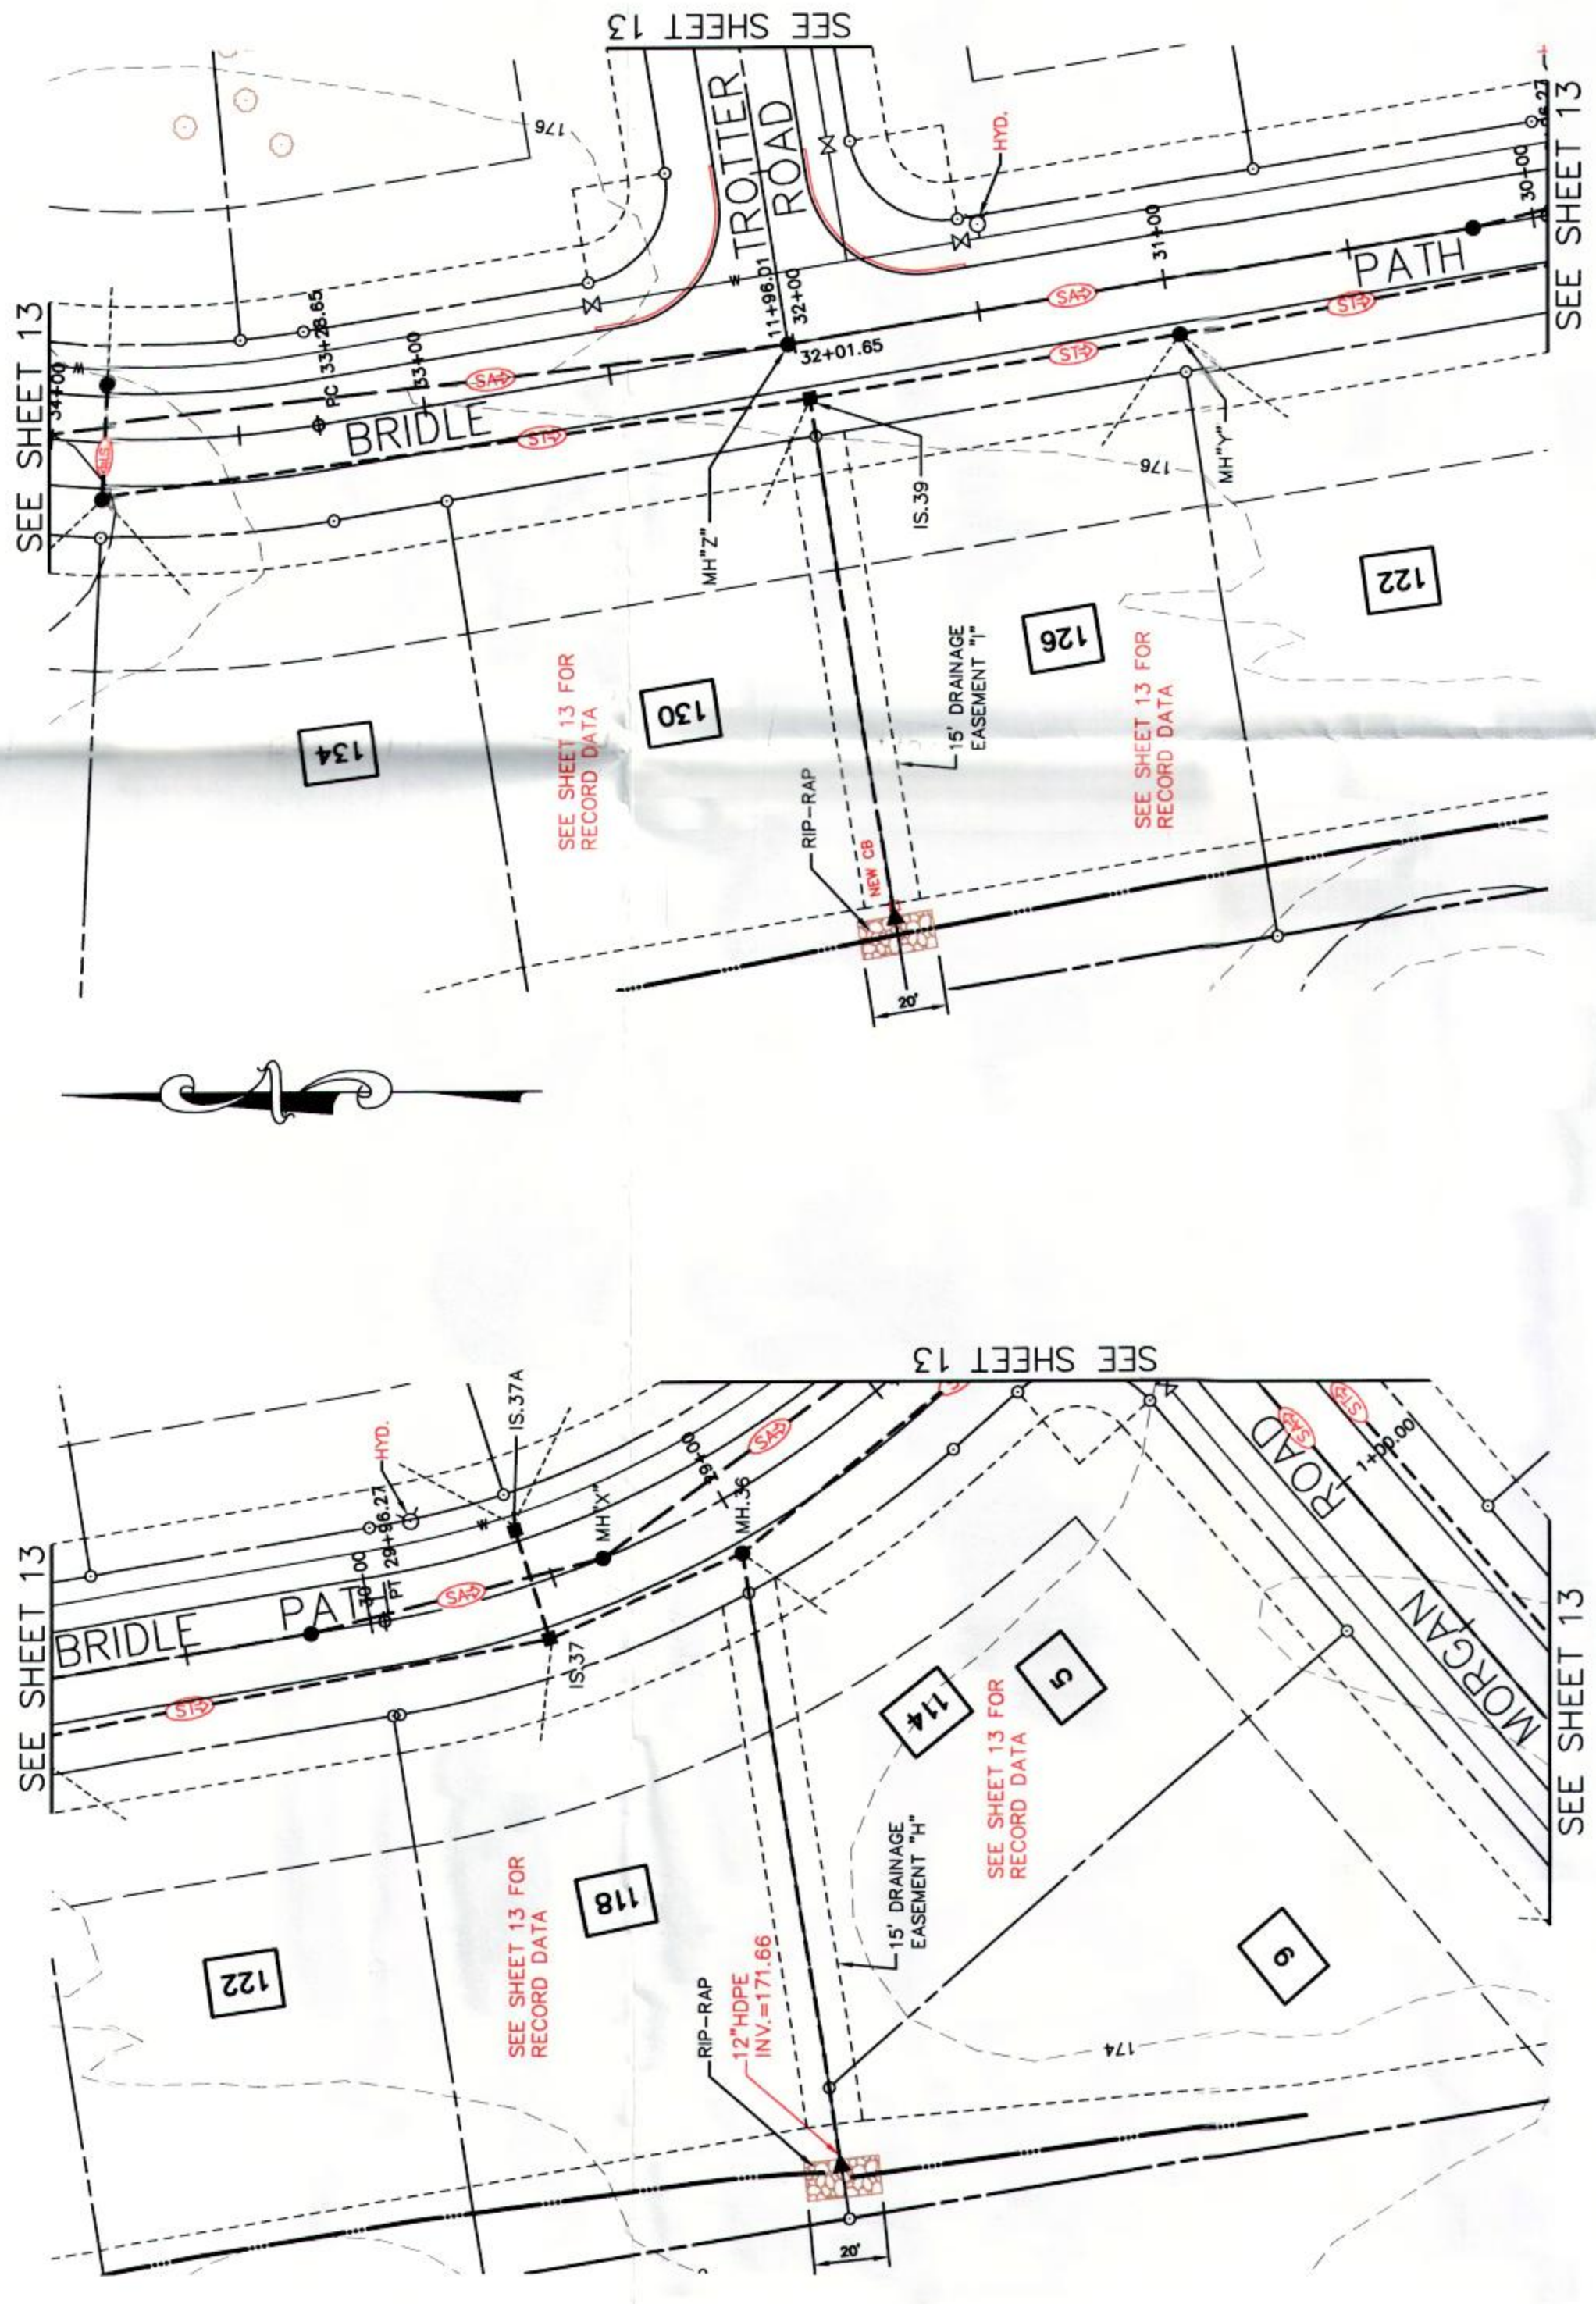

GENERAL PLAN - DRAINAGE EASEMENT "H"

GENERAL PLAN – DRAINAGE EASEMENT "I"


SCALE: 1" = 40'

DATE	BY	DESCRIPTION	SYMBOL
6/99	CHJ	FINAL PLAN REVISIONS	△
10/99	CHJ	FINAL PLAN REVISIONS	△
5/00	CHJ	FINAL PLAN REVISIONS	△
12/00	CHJ	FINAL PLAN REVISIONS	△
1/29/01	CHJ	FINAL PLAN REVISIONS	△
10/04	CHJ	FINAL PLAN REVISIONS	△
1/08	CHJ	MISCELLANEOUS	△
3/08	CHJ	MISCELLANEOUS	△

**EDWARD W. BOUTELLE
AND SON**
CIVIL ENGINEERS AND SURVEYORS
423 KENWOOD AVENUE
DELMAR, NEW YORK
TEL. (518) 439-9981 FAX. (518) 439-9982
A DIVISION OF J. KENNETH FRASER AND ASSOCIATES, P.E., L.L.C.

TOWN OF BETHLEHEM COUNTY OF ALBANY
STATE OF NEW YORK

PROJ. SURVEYOR: CHJ DRAWN BY: TWK ASSEMBLED BY: TWK CHECKED BY: CHJ	PROJECT NO.: 98-020 CAD FILE NAME: 4103-021
SHEET TITLE: PLAN & PROFILE DRAINAGE EASEMENTS	
DATE: NOVEMBER 1995	SHEET 21 OF 31

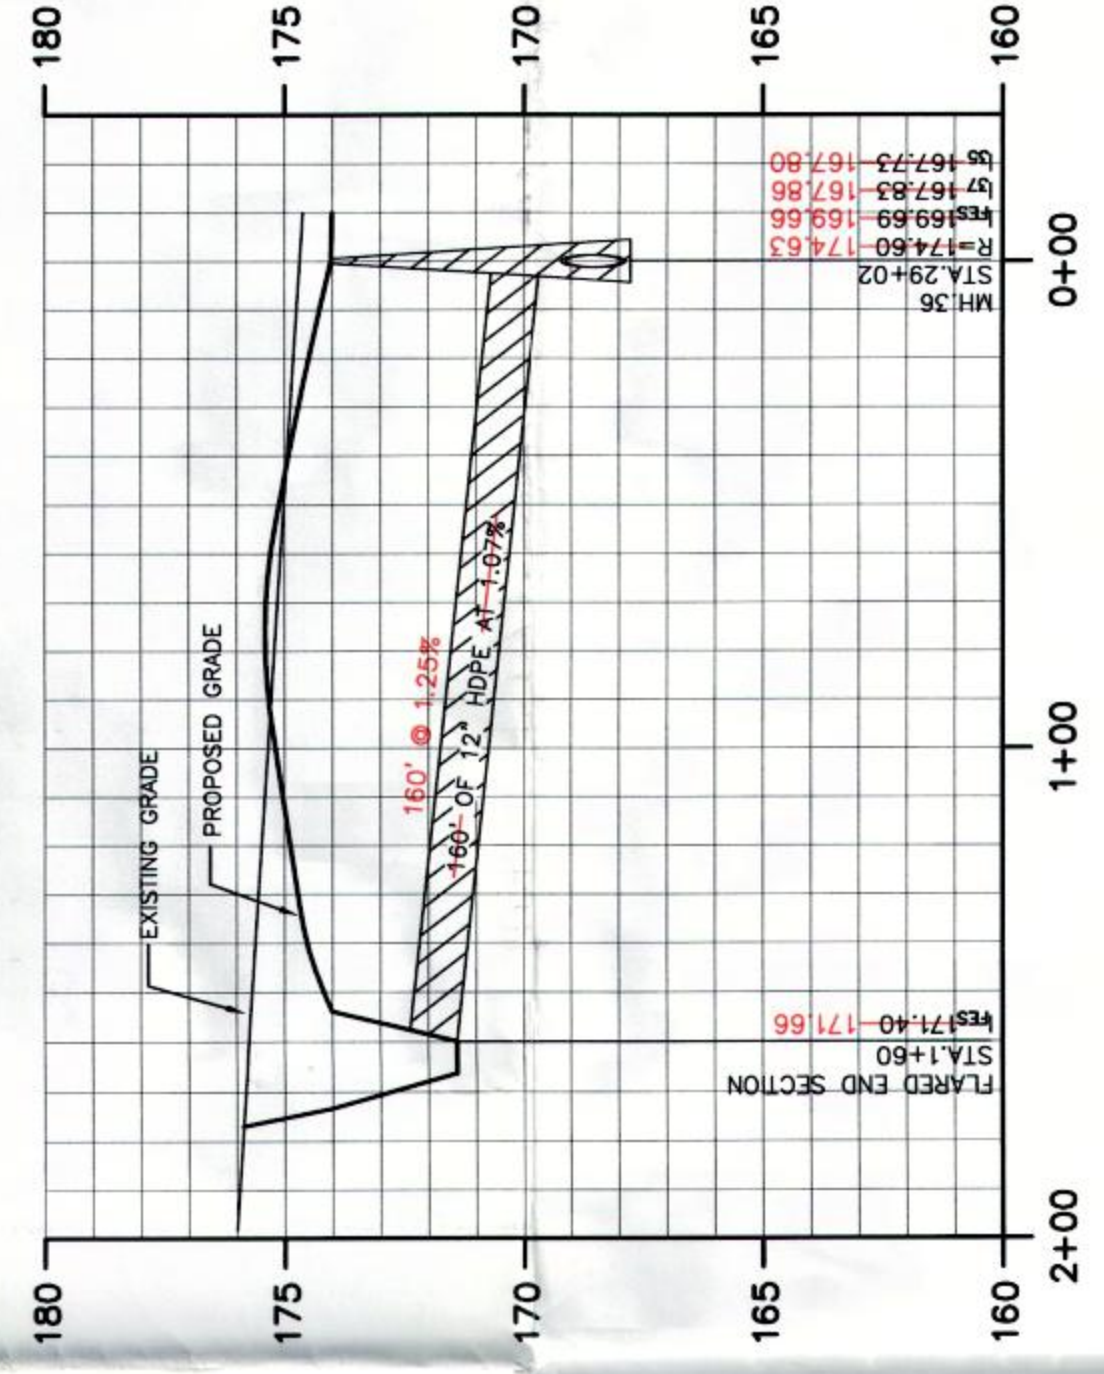

PROFILE - EASEMENT "G" 

SCALE: 1"=4' VERT. / 1"=40' HORIZ.

PROFILE — EASEMENT —
SCALE: 1"=4' VERT. / 1"=40' HORIZ.

[illegible]