



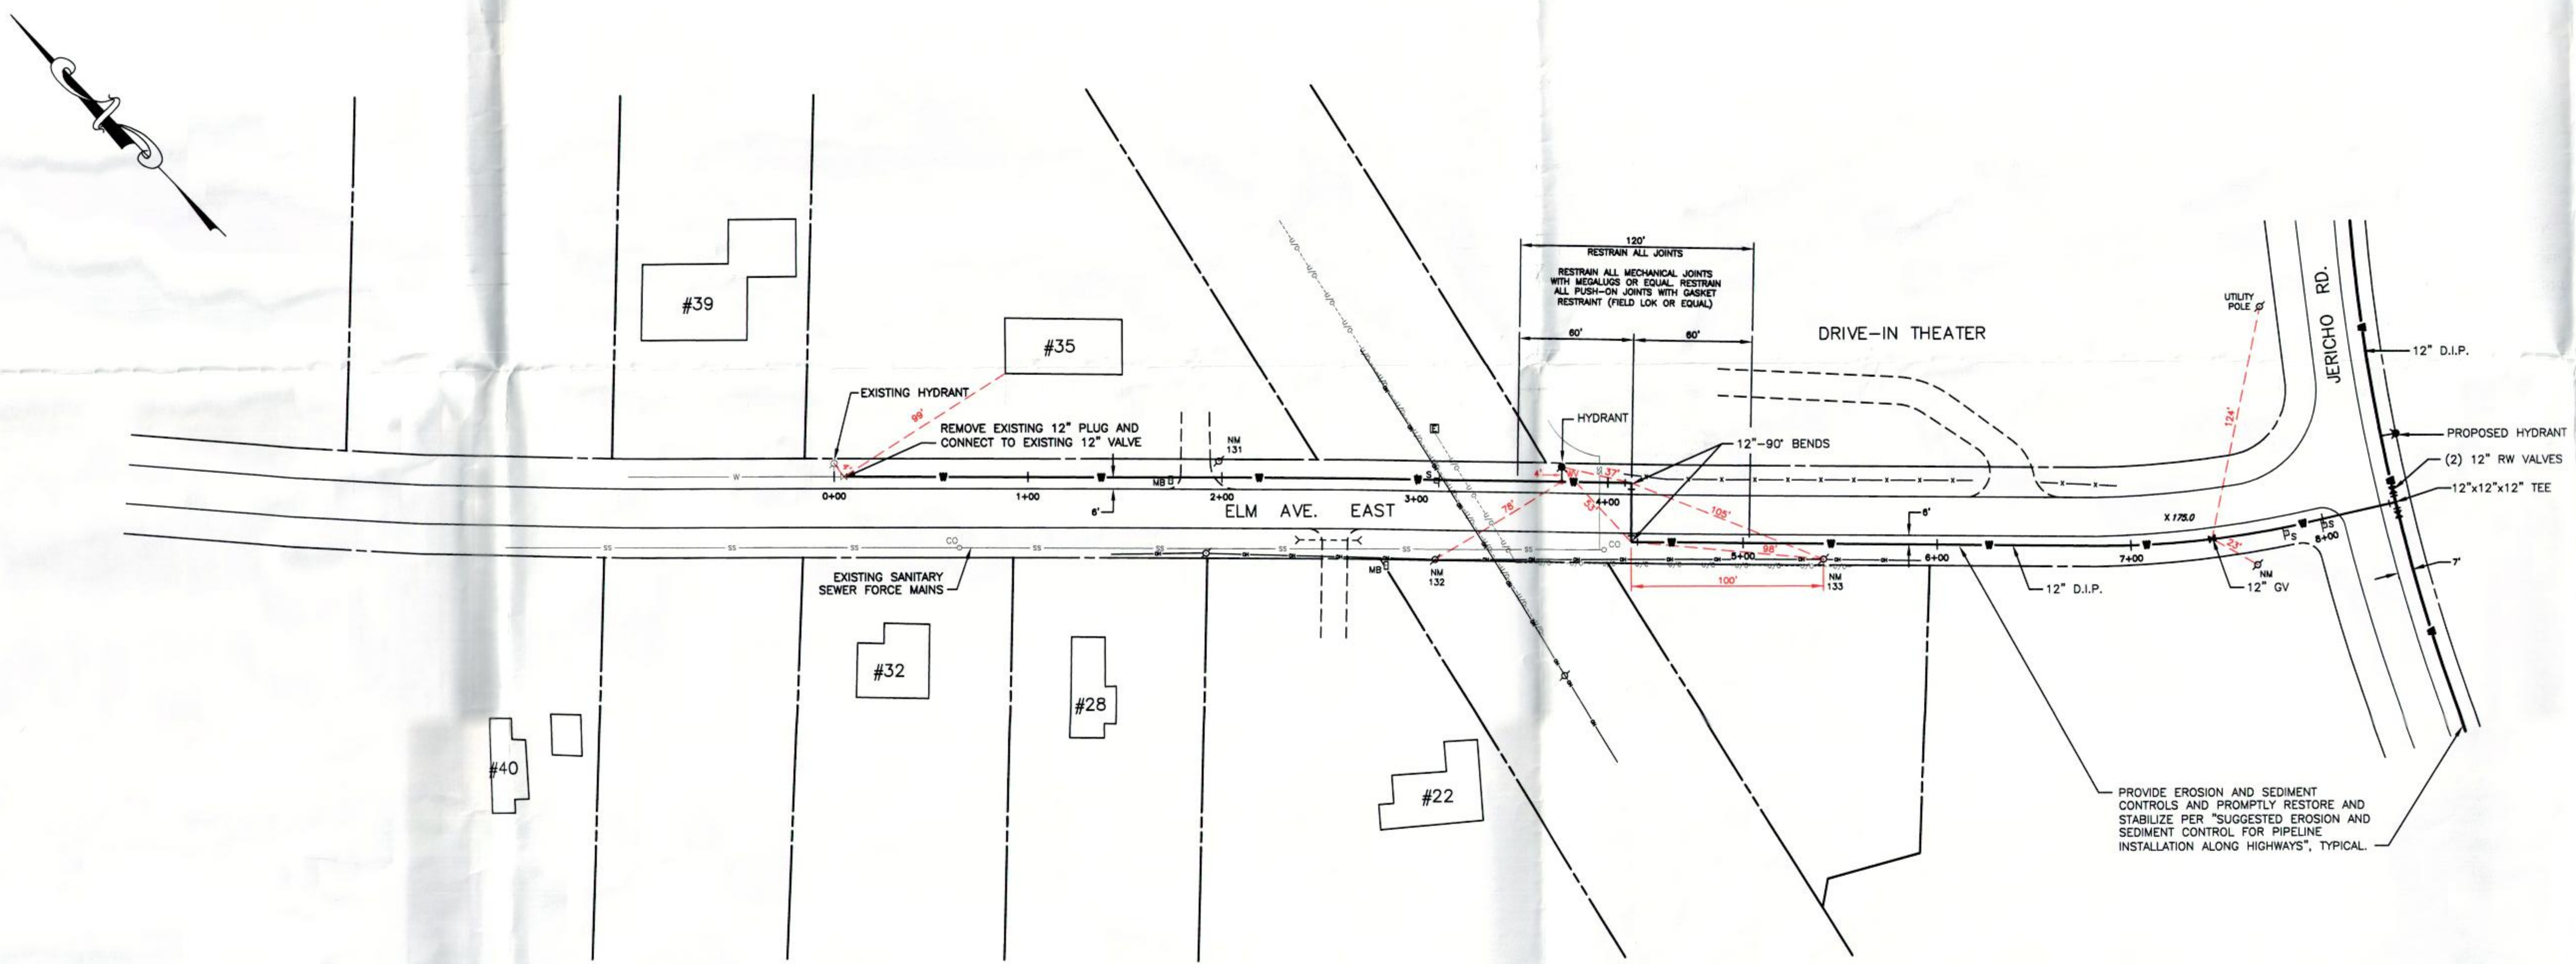

PLAN
SCALE: 1"=50'

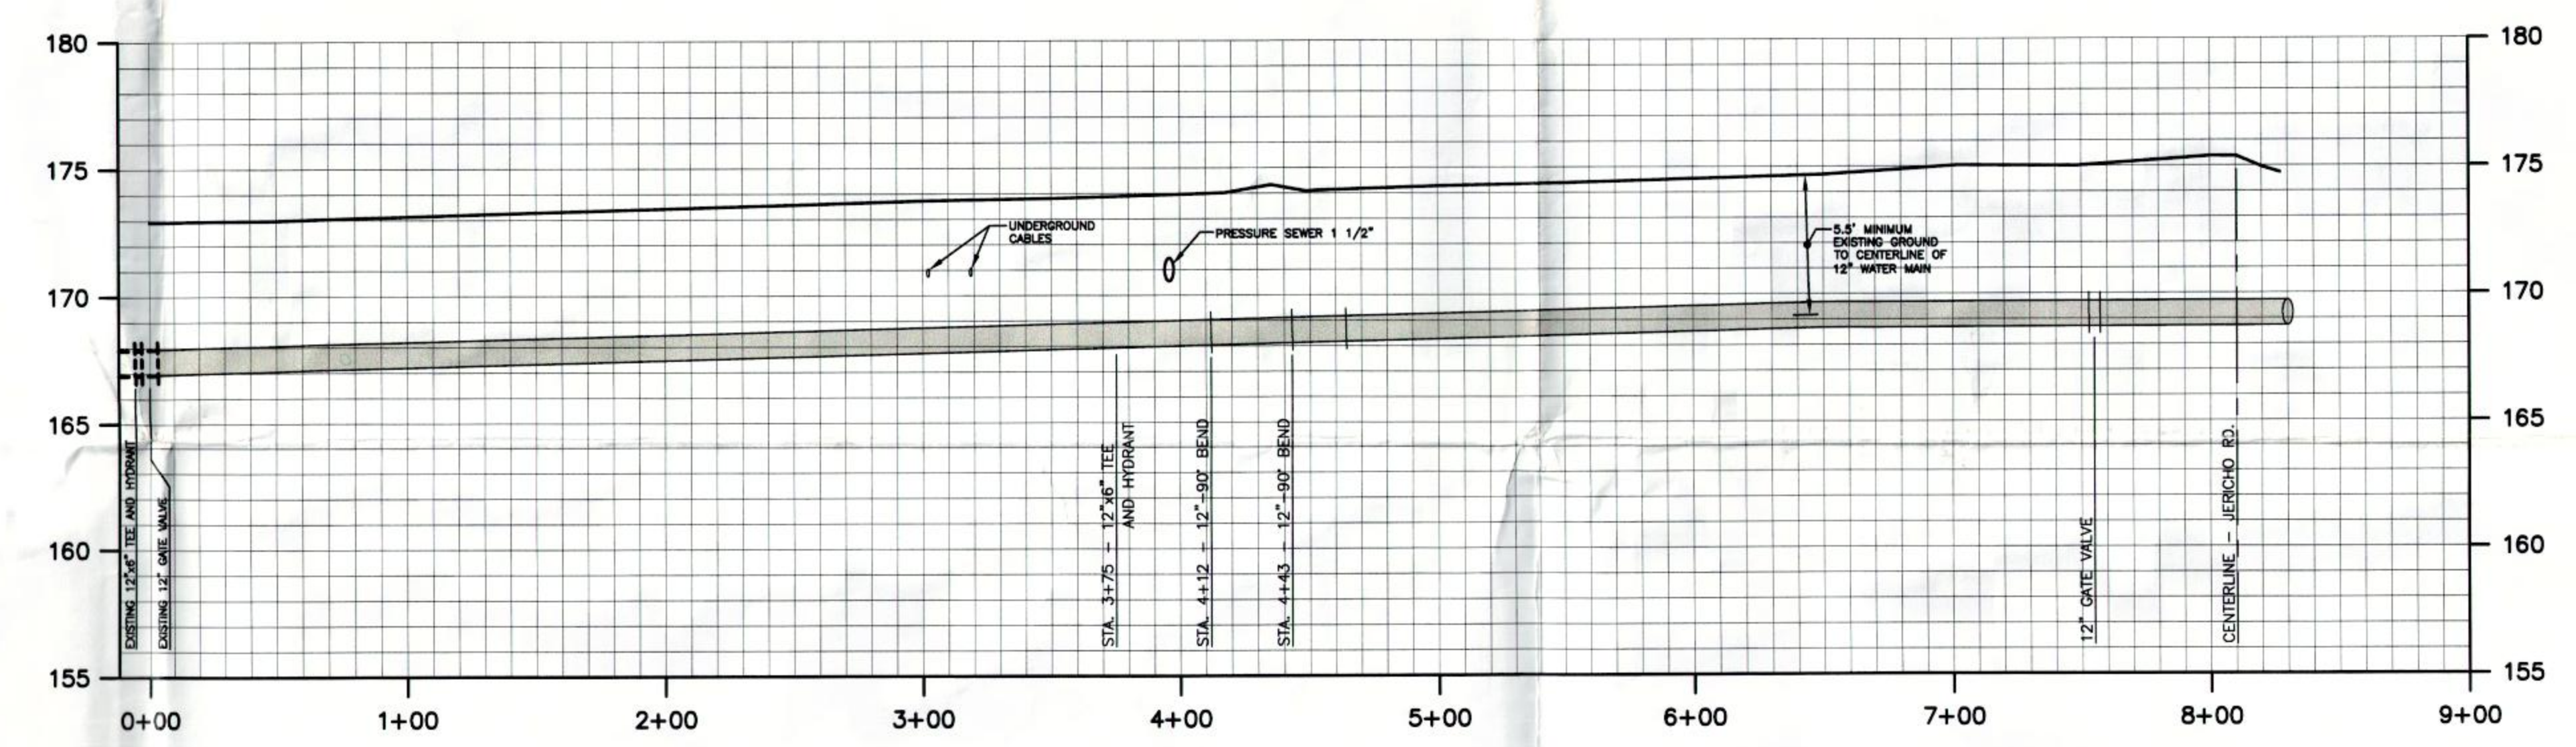

WATER MAIN PROFILE - ELM AVE. EAST
SCALE: 1"=5' VERT.
1"=50' HORIZ.

**RECORD
DRAWING**

ALL INFORMATION SHOWN IN RED
ON THESE DRAWINGS REPRESENT
RECORD INFORMATION OBTAINED
BY THE FIELD CREWS OF
C.T. MALE ASSOCIATES, P.C.
DURING THE MONTH OF SEPTEMBER 2010.
ADDITIONAL RECORD DATA ADDED JANUARY 14, 2011

GENERAL NOTES

LEGEND

UNAUTHORIZED ALTERATIONS OR ADDITIONS TO THIS DOCUMENT IS A VIOLATION OF SECTION 7209 SUBDIVISION 2 OF THE NEW YORK STATE EDUCATION LAW

REVISIONS

EDWARD W. BOUTELLE AND SON
CIVIL ENGINEERS AND SURVEYORS
423 KENWOOD AVENUE
DELMAR, NEW YORK
TEL.(518) 439-9981 FAX.(518) 439-9982
A DIVISION OF J. KENNETH FRASER AND ASSOCIATES, P.E., L.S., L.A., P.C.

FINAL PLAN
AMENDED
CARRIAGE HILL
SUBDIVISION
MAP OF LANDS OF
CHARLEW
CONSTRUCTION CORP.

TOWN OF BETHLEHEM COUNTY OF ALBANY
STATE OF NEW YORK

SCALE: AS SHOWN

PROJ. SURVEYOR: CHJ
DRAWN BY: TWK
ASSEMBLED BY: TWK
CHECKED BY: CHJ

PROJECT NO.: 99-020
CAD FILE NAME: 4103-026

SHEET TITLE:
ELM EAST WATER EXTENSION

DATE: OCTOBER 2000 SHEET 26 OF 31