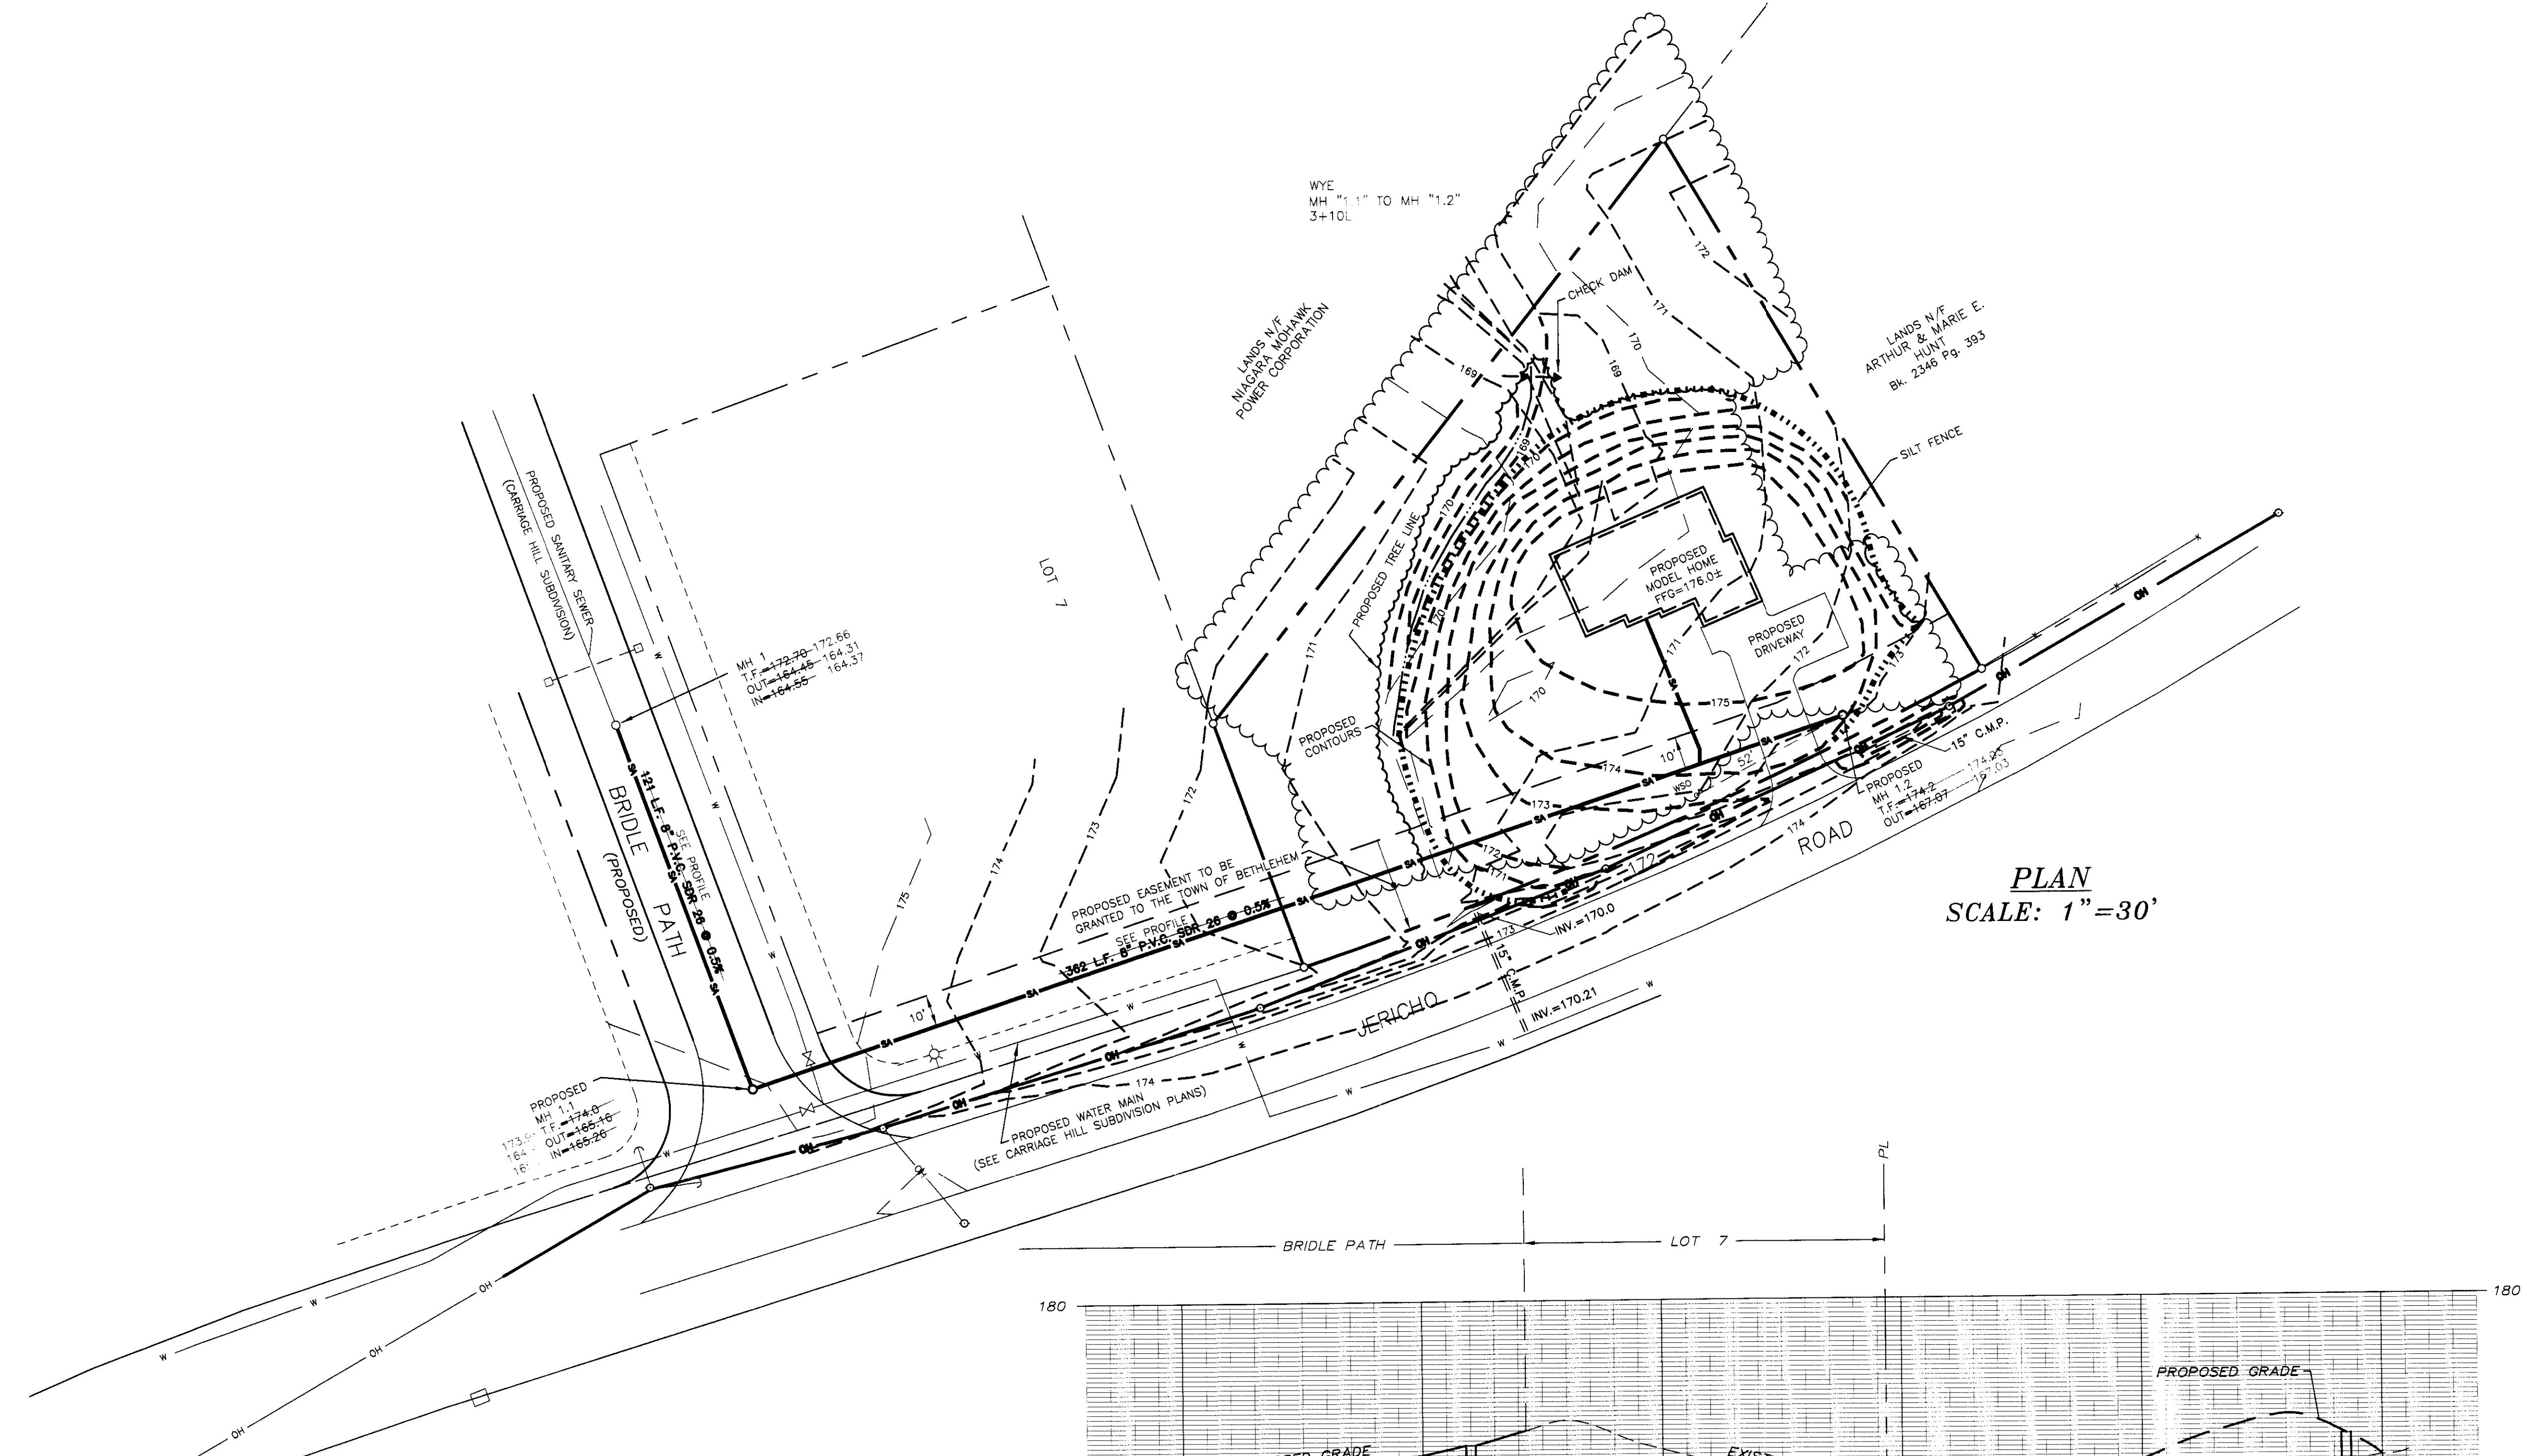




DEED

PLAN  
SCALE: 1"=30'TOWN OF BETHLEHEM  
STANDARD NOTES FOR PLANS:

- 1) ALL UTILITIES TO BE INSTALLED IN ACCORDANCE WITH "TOWN STANDARD DETAILS" AND "SPECIFICATIONS". PRIOR TO CONSTRUCTION, THE CONTRACTOR SHALL OBTAIN THESE TWO DOCUMENTS FOR USE ON THE JOB.
- 2) ALL ELEVATIONS SHOWN ARE ON USGS ELEVATION BASE.
- 3) ALL GRADING TO BE 3:1 (HORIZONTAL:VERTICAL) MAXIMUM SLOPE. GRADED LAWN/YARD AREAS SHALL HAVE A MINIMUM SLOPE OF 2%.
- 4) PRIOR TO ANY WORK IN THE TOWN RIGHT-OF-WAY, THE CONTRACTOR SHALL OBTAIN A HIGHWAY WORK PERMIT FROM THE TOWN HIGHWAY SUPERINTENDENT.
- 5) PRIOR TO ANY WORK ON SANITARY SEWER AND WATER, THE CONTRACTOR SHALL OBTAIN THE NECESSARY PERMITS FROM THE TOWN DEPARTMENT OF PUBLIC WORKS.
- 6) PRIOR TO ANY EXCAVATION, THE CONTRACTOR SHALL CALL THE UFGO TWO WORKING DAYS PRIOR TO THE WORK TO HAVE UNDERGROUND UTILITIES LOCATED IN THE FIELD. CALL 1-800-932-7932.
- 7) NO SUMP PUMP, ROOF DRAINS, CELLAR DRAINS OR FOOTING DRAINS SHALL BE CONNECTED TO THE SANITARY SEWER SYSTEM.

## GENERAL NOTES:

- 1) UTILITY INFORMATION SHOWN HEREON HAS BEEN OBTAINED FROM RECORD DRAWINGS AND FIELD INSPECTIONS. ALL EXISTING UTILITIES ON OR ADJACENT TO THIS SITE MAY NOT BE SHOWN HEREON. CONTRACTOR IS RESPONSIBLE FOR NOTIFYING AND COORDINATING WITH ALL RESPECTIVE UTILITIES PRIOR TO EXCAVATION. CONTRACTOR IS ALSO RESPONSIBLE FOR DETERMINING EXACT LOCATION AND DEPTH OF ALL UTILITIES BEFORE EXCAVATING.

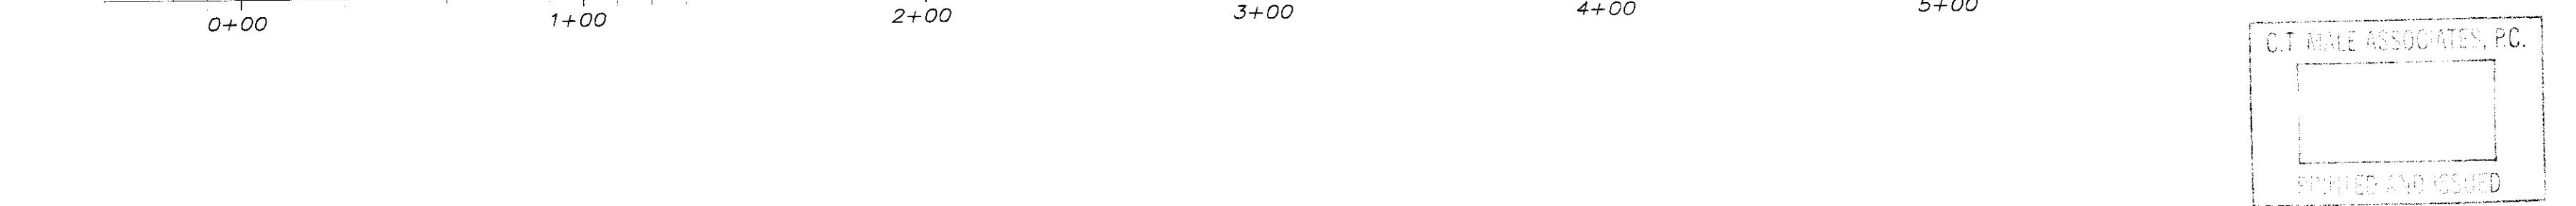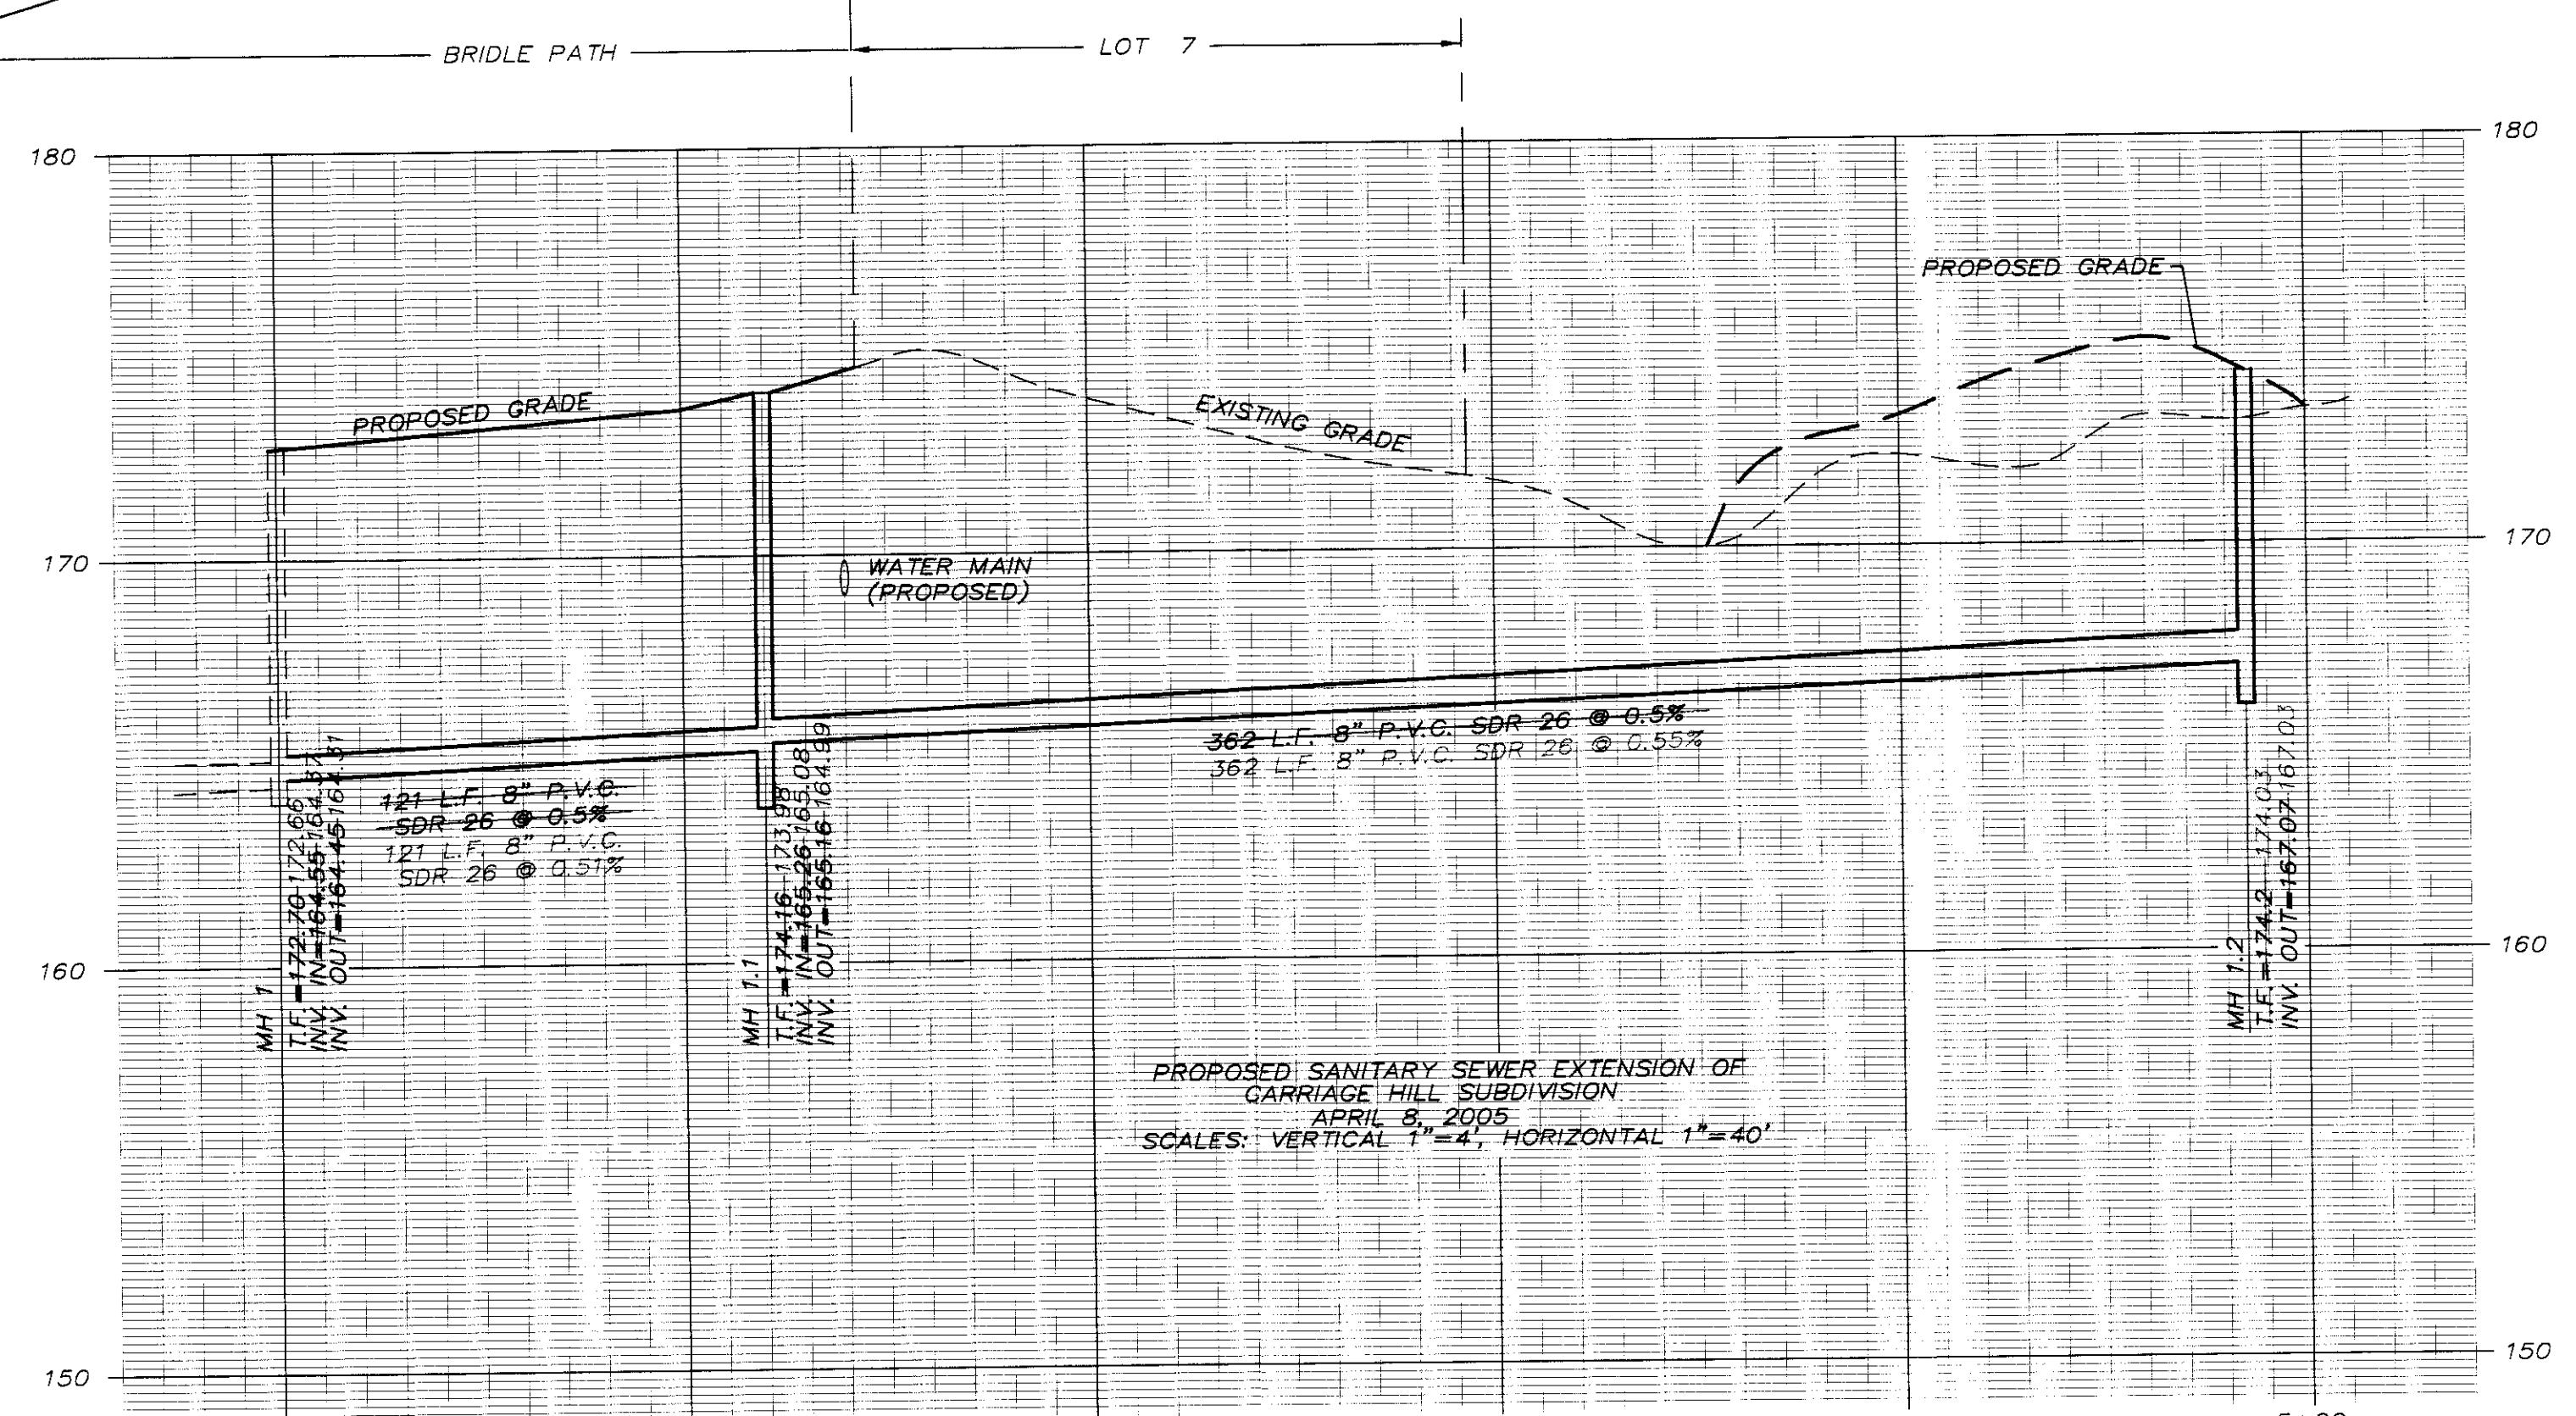RECORD  
DRAWING

ALL INFORMATION SHOWN IN RED ON THESE DRAWINGS REPRESENT RECORD INFORMATION OBTAINED BY THE FIELD CREWS OF C.T. MALE ASSOCIATES, P.C. DURING THE MONTH OF DECEMBER 2006. ADDITIONAL FIELD LOCATIONS OBTAINED IN MARCH 2007.

PROJ. SURVEYOR: CHJ  
DRAWN BY: TWK  
ASSEMBLED BY: TWK  
CHECKED BY: CHJ  
PROJECT NO.: 99-020  
CAD FILE NAME: 4103-008

SHEET TITLE: PLAN AND PROFILE  
JERICHO ROAD SANITARY SEWER EXT.  
C.T. MALE ASSOCIATES, P.C.

DATE: APRIL 25, 2006 SHEET 31 OF 31

UNAUTHORIZED ALTERATIONS OR ADDITIONS TO THIS DOCUMENT IS A VIOLATION OF SECTION 87(2)(b) OF THE NEW YORK STATE EDUCATION LAW

## REVISIONS


DATE	BY	DESCRIPTION	SYMBOL
6/06	BOD	REVISED PER DEC COMMENTS	△

EDWARD W. BOUTELLE  
AND SON

CIVIL ENGINEERS AND SURVEYORS

423 KENWOOD AVENUE  
DELMAR, NEW YORK  
TEL. (518) 439-9981 FAX. (518) 439-9982  
A DIVISION OF J. KENNETH FRASER AND ASSOCIATES, P.E. LS, I.A. P.C.FINAL PLAN  
AMENDEDCARRIAGE HILL  
SUBDIVISIONMAP OF LANDS OF  
CHARLEW  
CONSTRUCTION CORP.TOWN OF BETHLEHEM COUNTY OF ALBANY  
STATE OF NEW YORK

SCALE: SEE PLAN

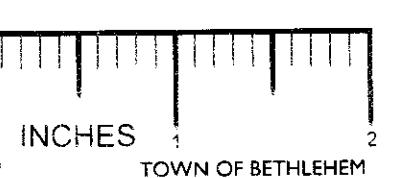

COPYRIGHT 1999 J. KENNETH FRASER AND ASSOCIATES, P.C.