

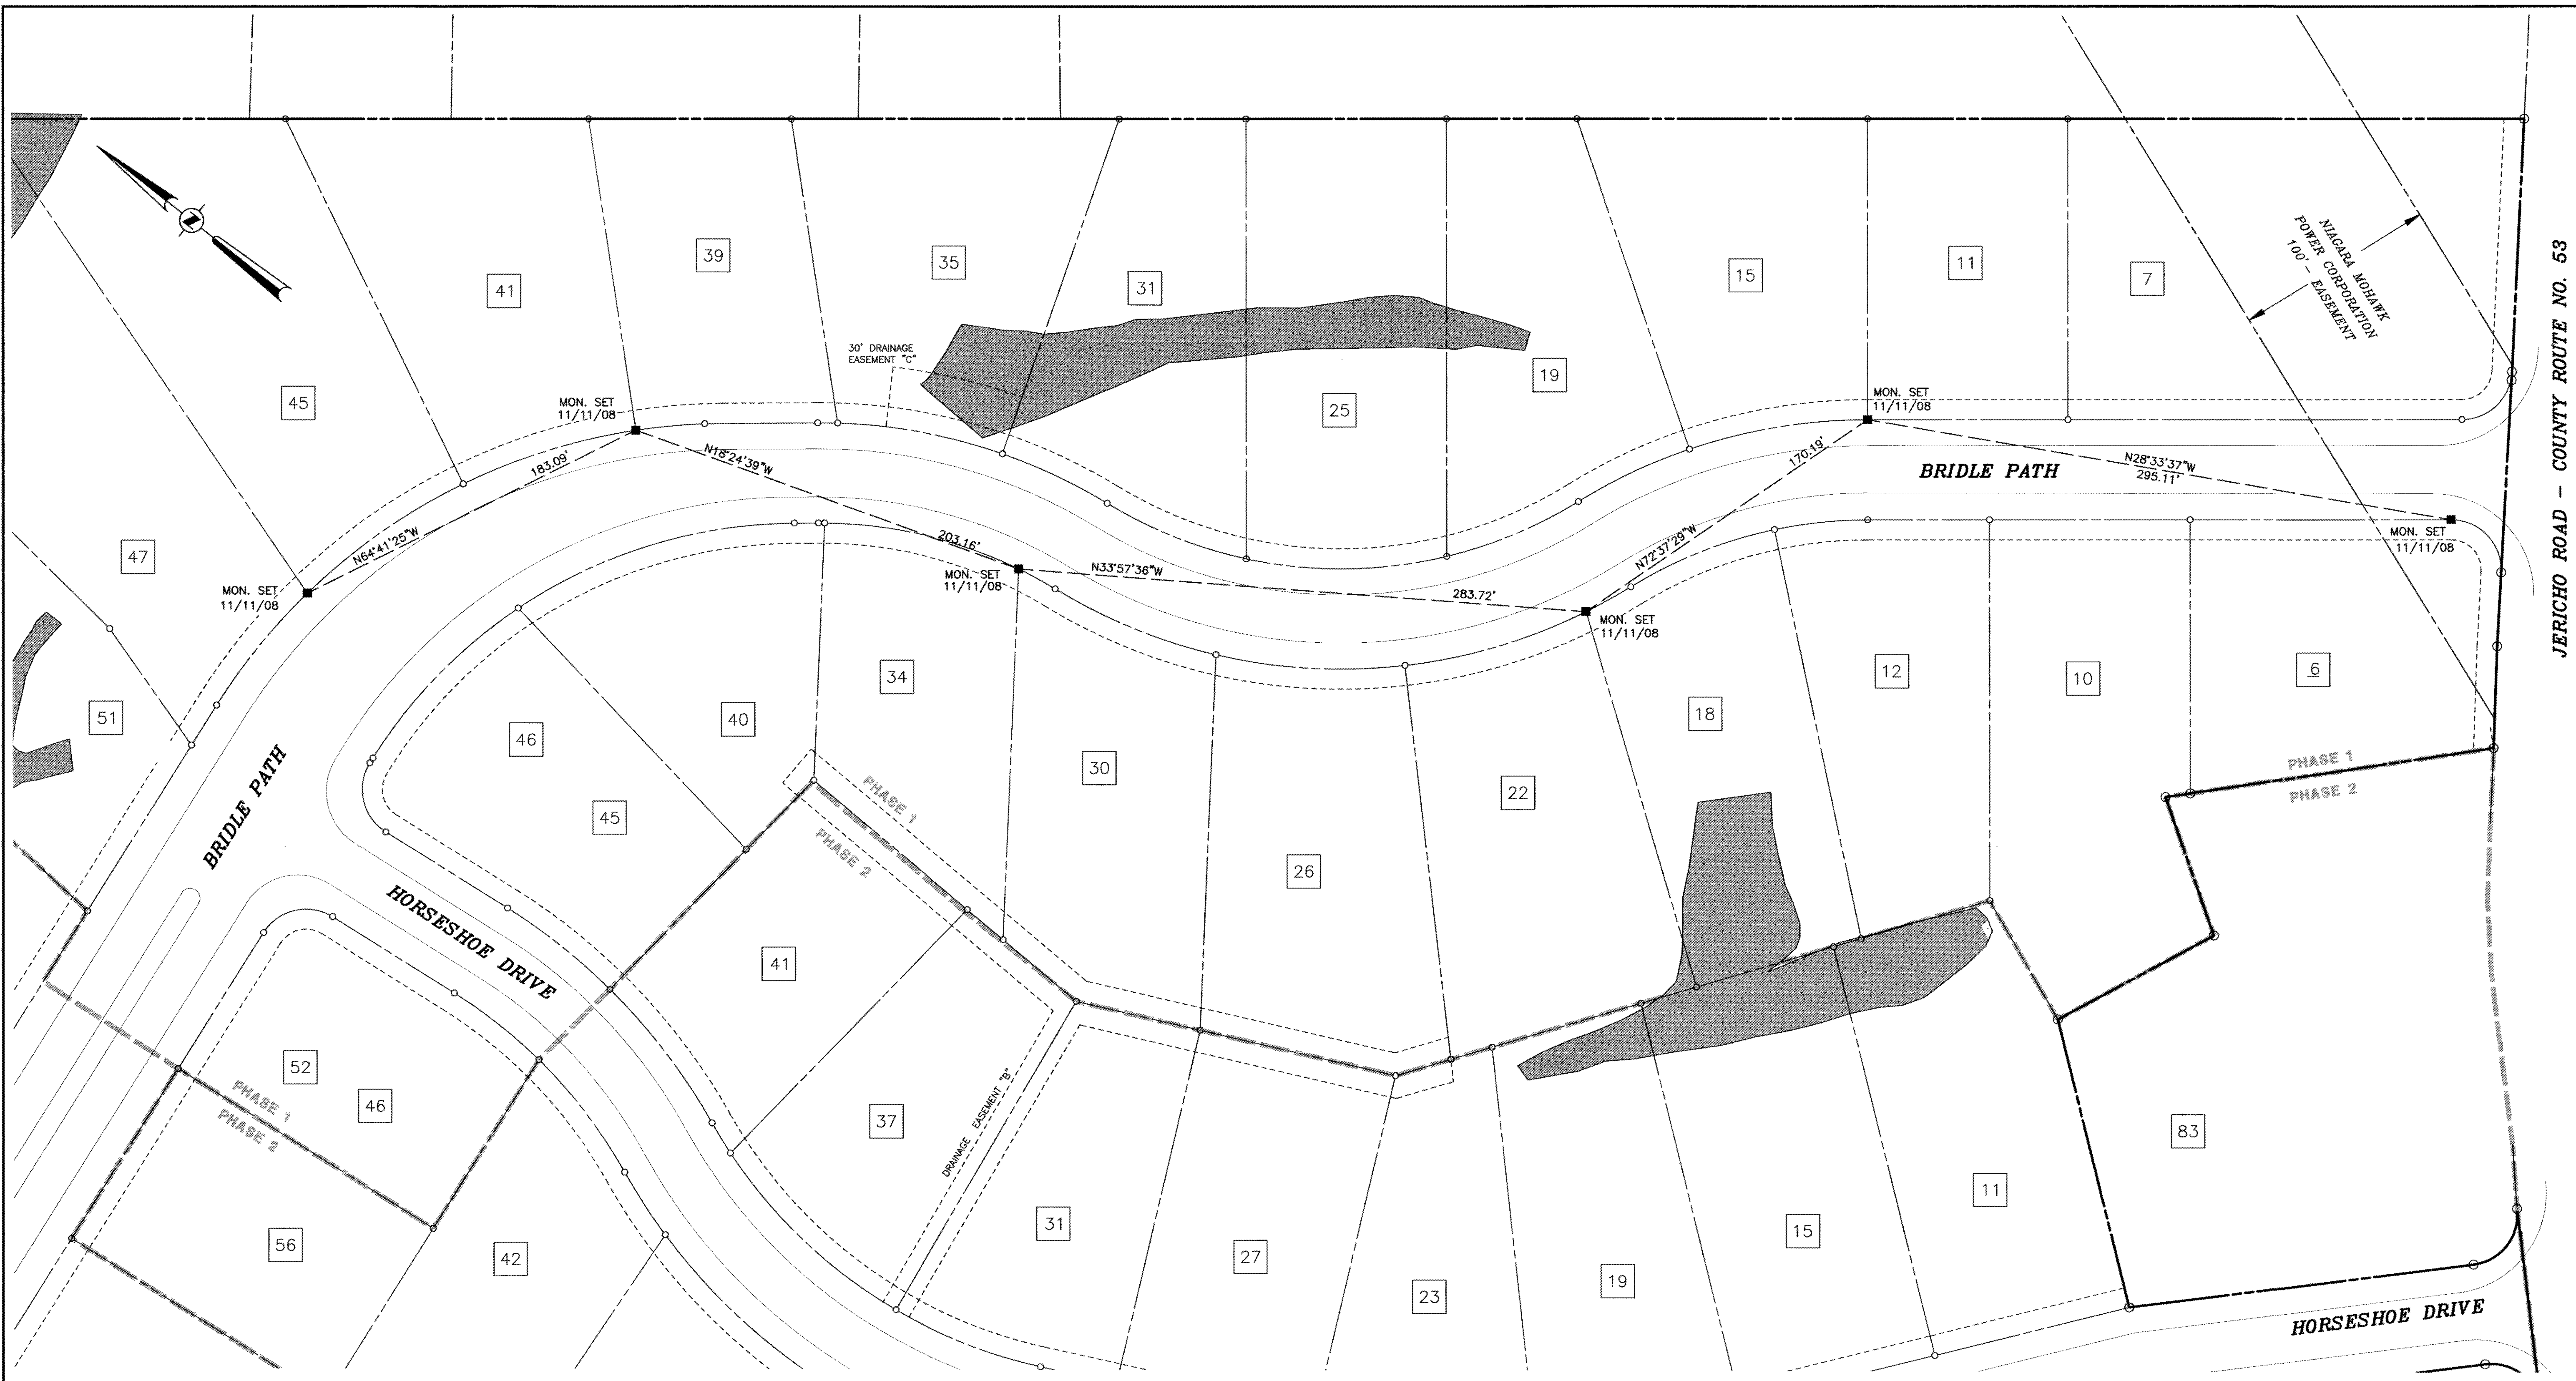


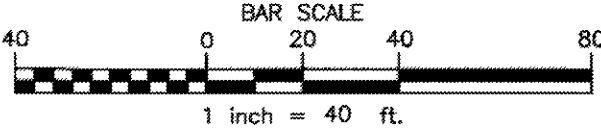

MAP REFERENCES:

- 1. "Final Plan Amended Carriage Hill Subdivision Map of Lands of Charlew Construction Corp." Town of Bethlehem Albany County, NY prepared by Edward W. Boutelle and Son dated November 14, 1995 last revised March 2006 and filed in the Albany County Clerk's Office on November 1, 2006 in Drawer 172 as Map No. 11898.

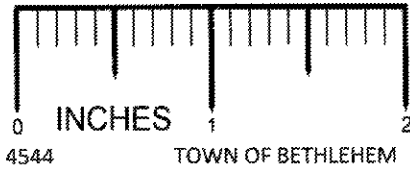

■ DENOTES CONCRETE MONUMENT SET

WILLIAM J. NETTLETON
PLS 49513

DATE	REVISIONS RECORD/DESCRIPTION	DRAFTER	CHECK	APPR.
10/28/08	REVISED MON. LOCATIONS PER T/O BETHLEHEM	MDD	W/JN	W/JN
11/11/08	MONUMENTS SET AS SHOWN	MDD	W/JN	

UNAUTHORIZED ALTERATION OR ADDITION TO THIS DOCUMENT IS A VIOLATION OF SECTION 2209 SUBDIVISION 2 OF THE NEW YORK STATE EDUCATION LAW.
© 2008
C.T. MALE ASSOCIATES, P.C.
APPROVED:
DRAFTED : MDD
CHECKED : W/JN
PROJ. NO: 06/6137
SCALE : 1"=40'
DATE : OCT. 23, 2008

HIGHWAY MONUMENTATION
FINAL AMENDED PLAN - CARRIAGE HILL SUBDIVISION
MAP OF LANDS OF CHARLEW CONSTRUCTION CORPORATION
PHASE I

TOWN OF BETHLEHEM
C.T. MALE ASSOCIATES, P.C.
50 CENTURY HILL DRIVE, P.O. BOX 727, LATHAM, NY 12110
518.786.7400 • FAX 518.786.7299
ARCHITECTURE & BUILDING SYSTEMS ENGINEERING • CIVIL ENGINEERING
ENVIRONMENTAL SERVICES • SURVEY & LAND INFORMATION SERVICES

SHEET 1 OF 1
DWG. NO: 08-644