


As-Built Survey
Sanitary Sewer Components
Millwood Estates

TOWN OF BETHLEHEM, ALBANY COUNTY, NEW YORK
SCALE: 1" = 30'
SHEET 2 OF 3
JUNE 28, 2013
MAP NO. 2013-051A

BRIAN R. HOLBRITTER
P.L.S.
LAND SURVEYING & SITE DEVELOPMENT
34 CENTER STREET
SCHAGHTICOKE, NY 12154
PHONE: 518-753-7592

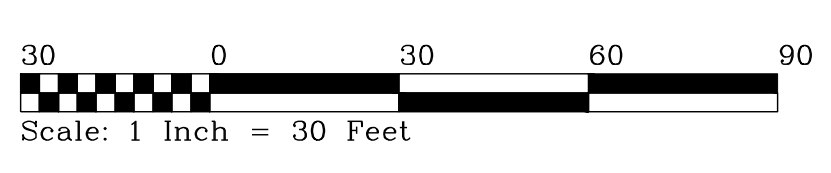

BRIAN R. HOLBRITTER P.L.S. #237