


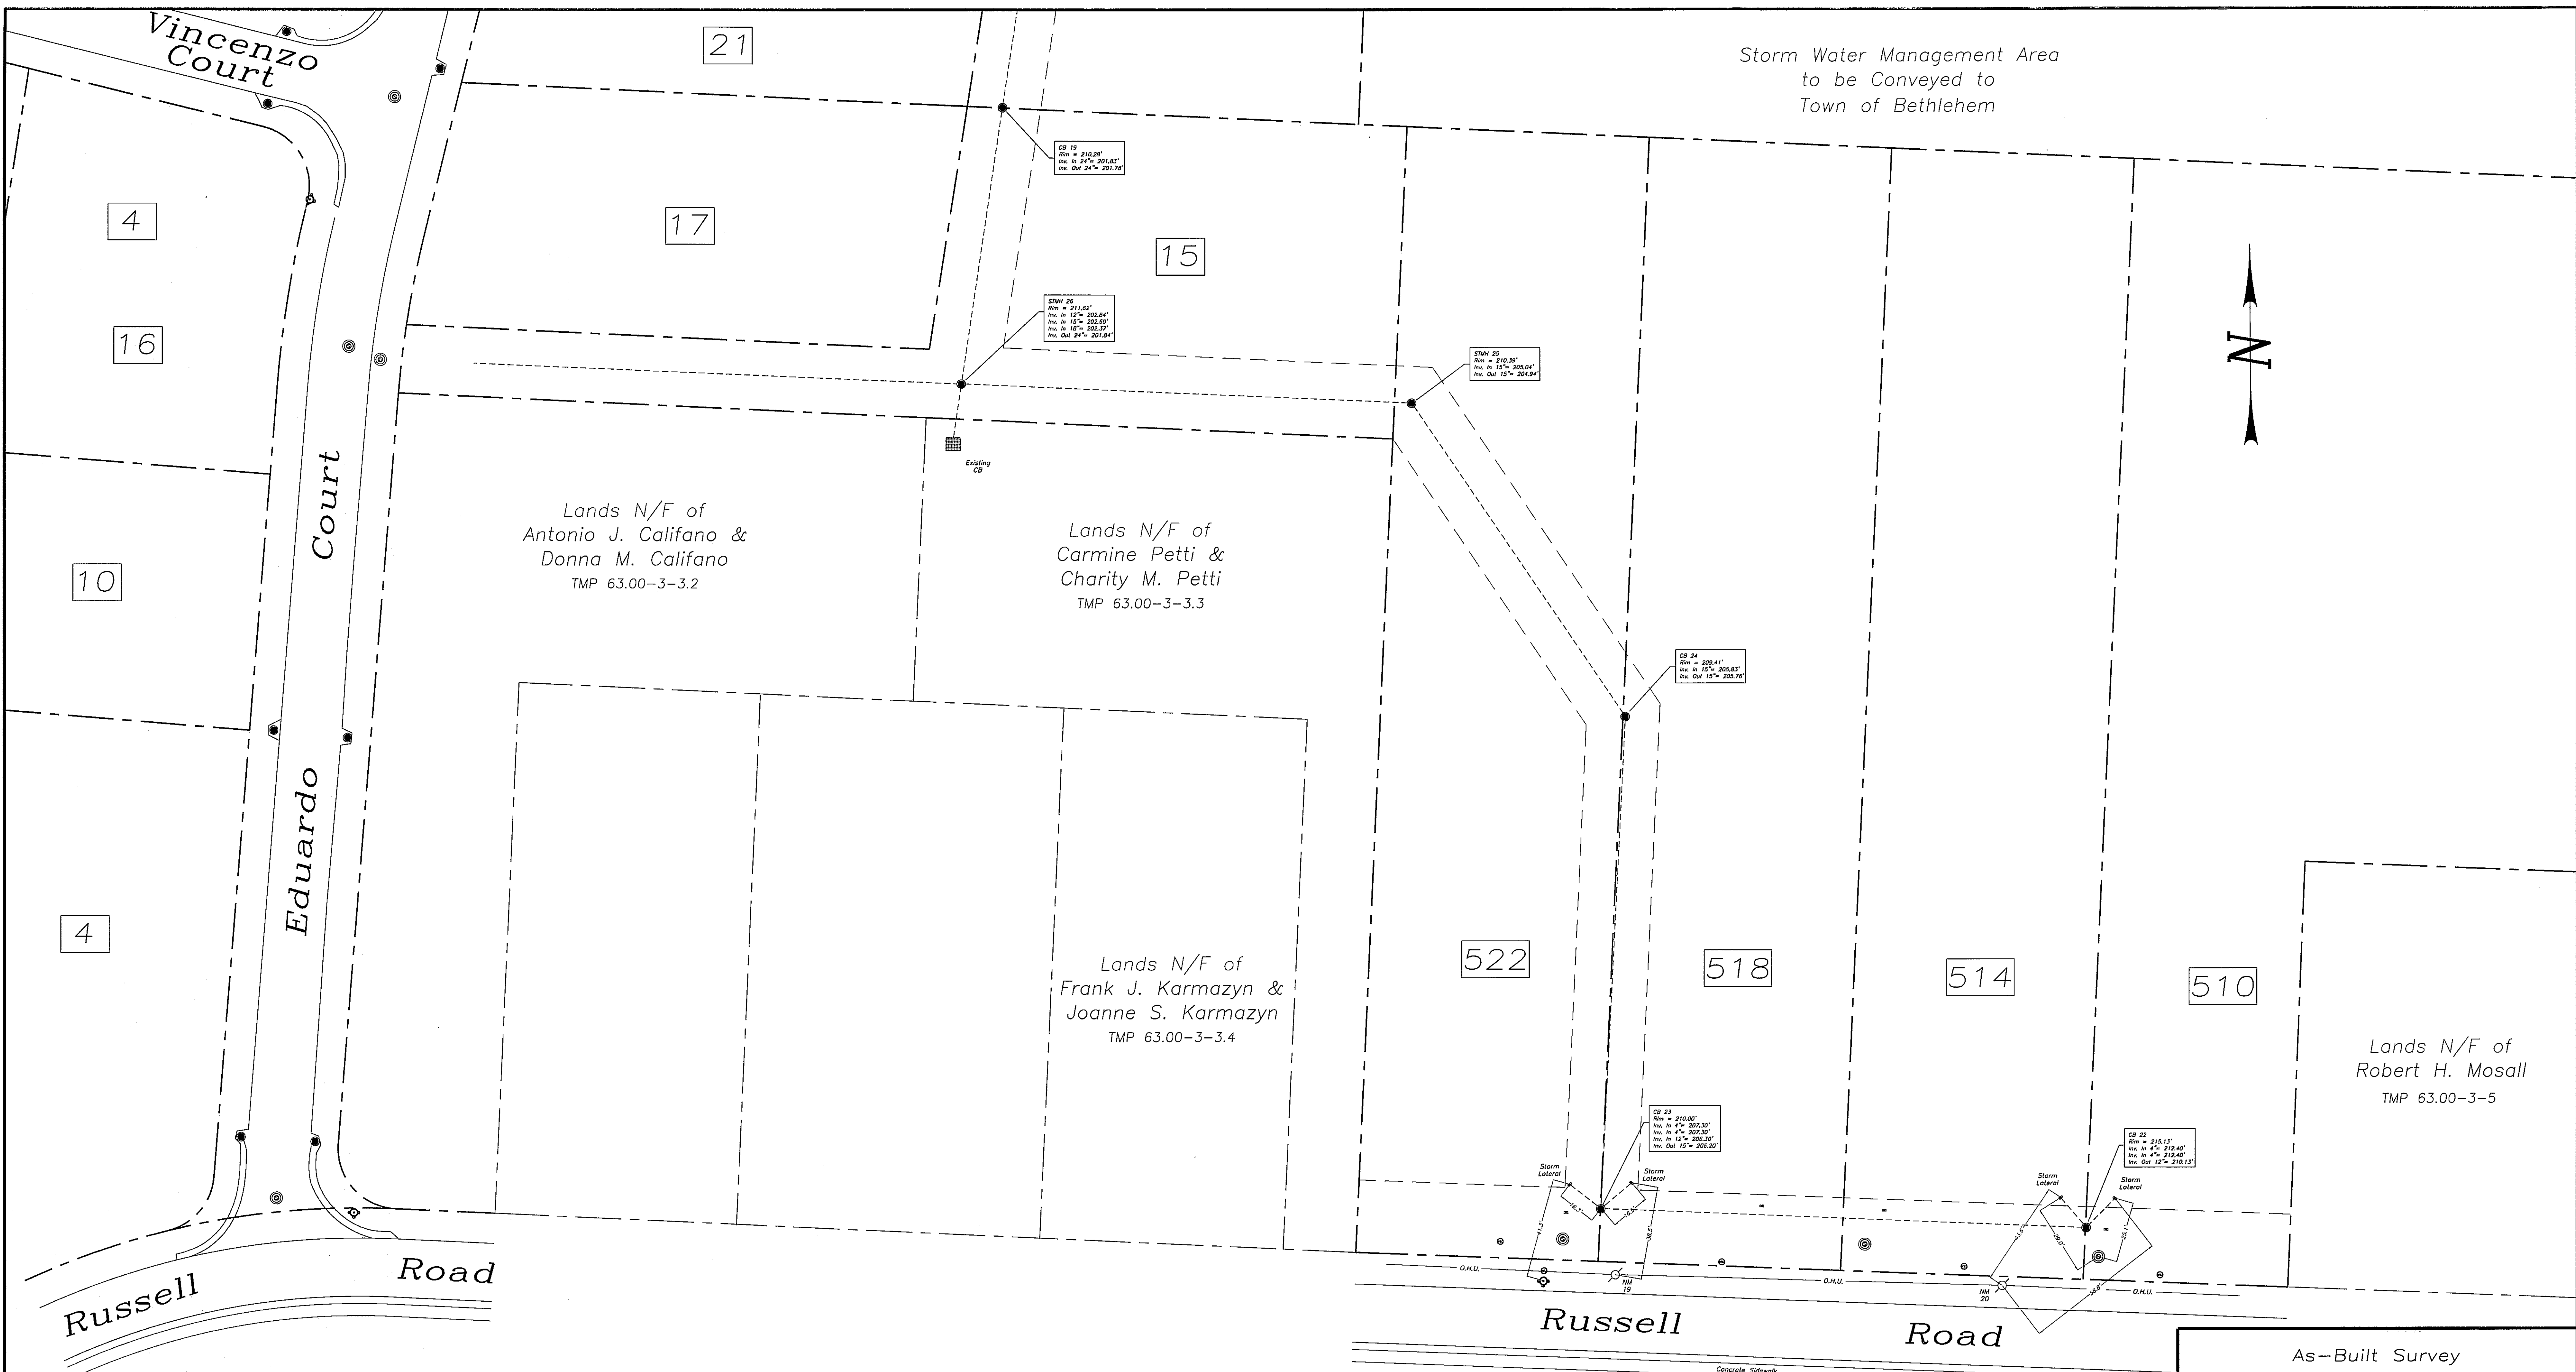

Vincenzo Court

4

16

10

4

Eduardo Court

21

17

15

Lands N/F of
Antonio J. Califano &
Donna M. Califano
TMP 63.00-3-3.2

Lands N/F of
Carmine Petti &
Charity M. Petti
TMP 63.00-3-3.3

Lands N/F of
Frank J. Karmazyn &
Joanne S. Karmazyn
TMP 63.00-3-3.4

522

518

514

510

Lands N/F of
Robert H. Mosall
TMP 63.00-3-5

Russell Road

Russell Road

