


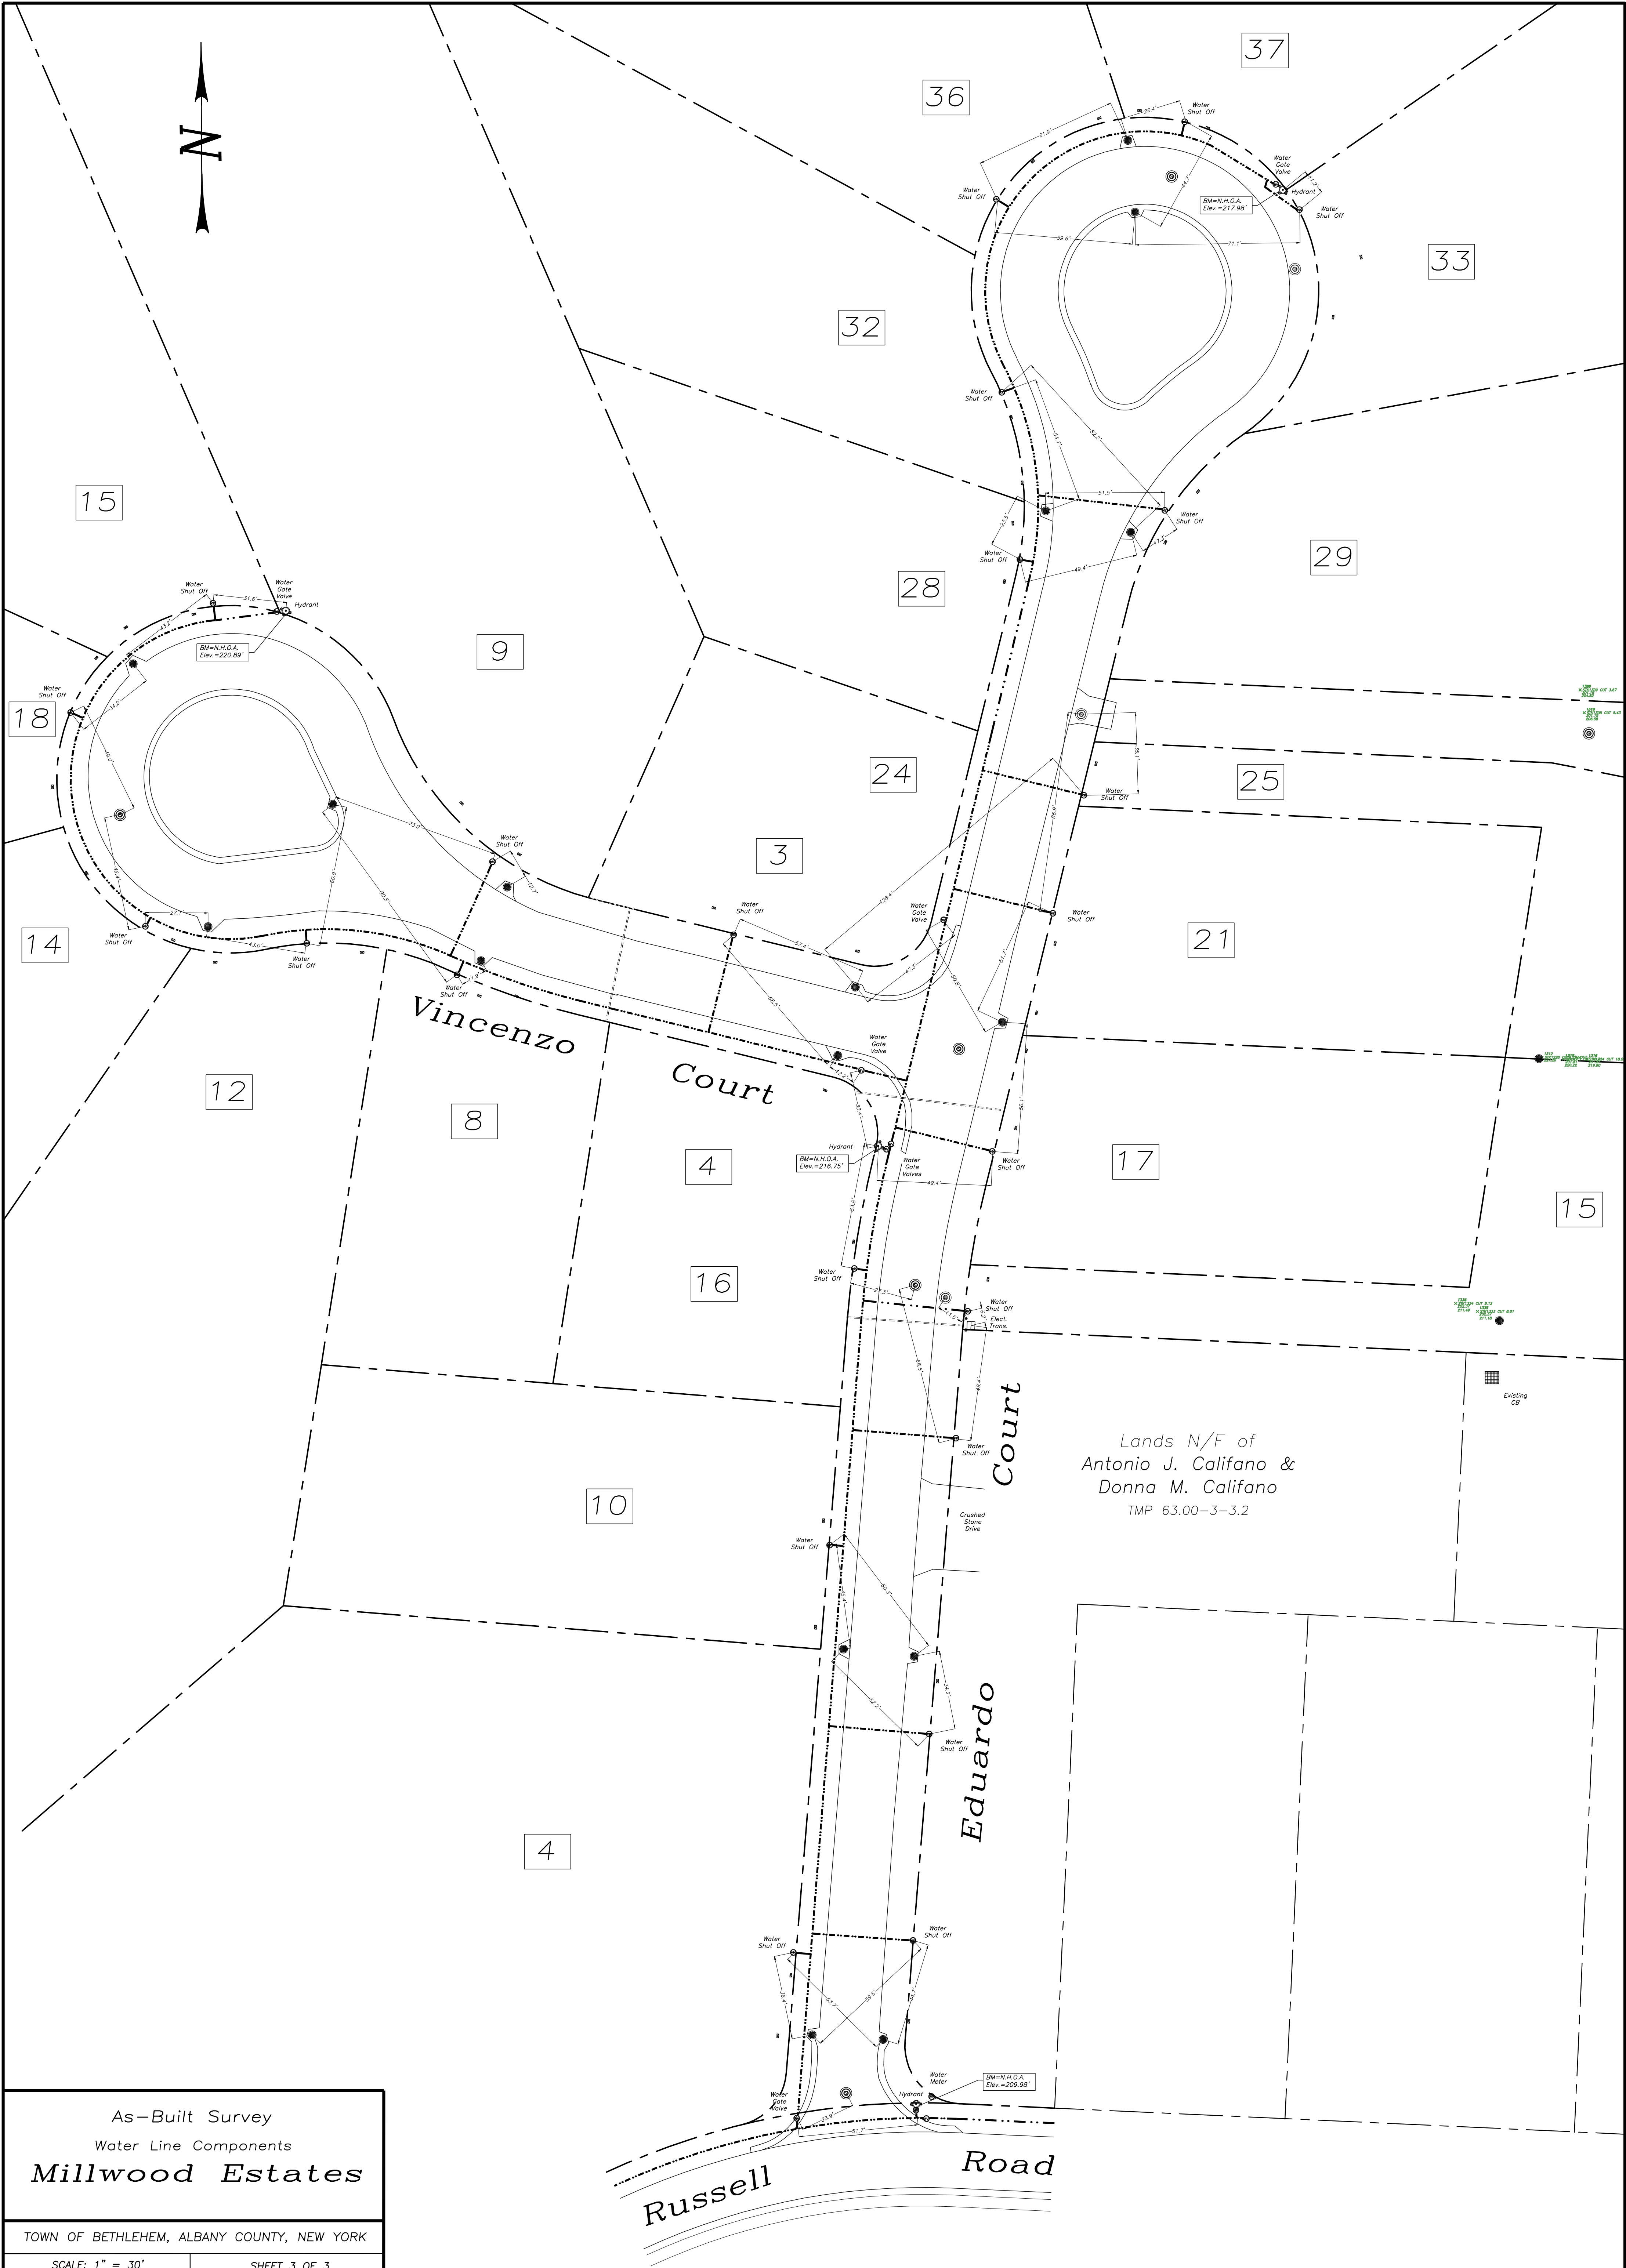

As-Built Survey

Water Line Components

Millwood Estates

TOWN OF BETHLEHEM, ALBANY COUNTY, NEW YORK

SCALE: 1" = 30'

JUNE 28, 2013

SHEET 3 OF 3

MAP NO. 2013-051A

BRIAN R. HOLBRITTER

PLS

LAND SURVEYING & SITE DEVELOPMENT

34 CENTER STREET

SCHAGHTICOKE, NY 12154

PHONE: 518-753-7592

BRIAN R. HOLBRITTER P.L.S. #737

