


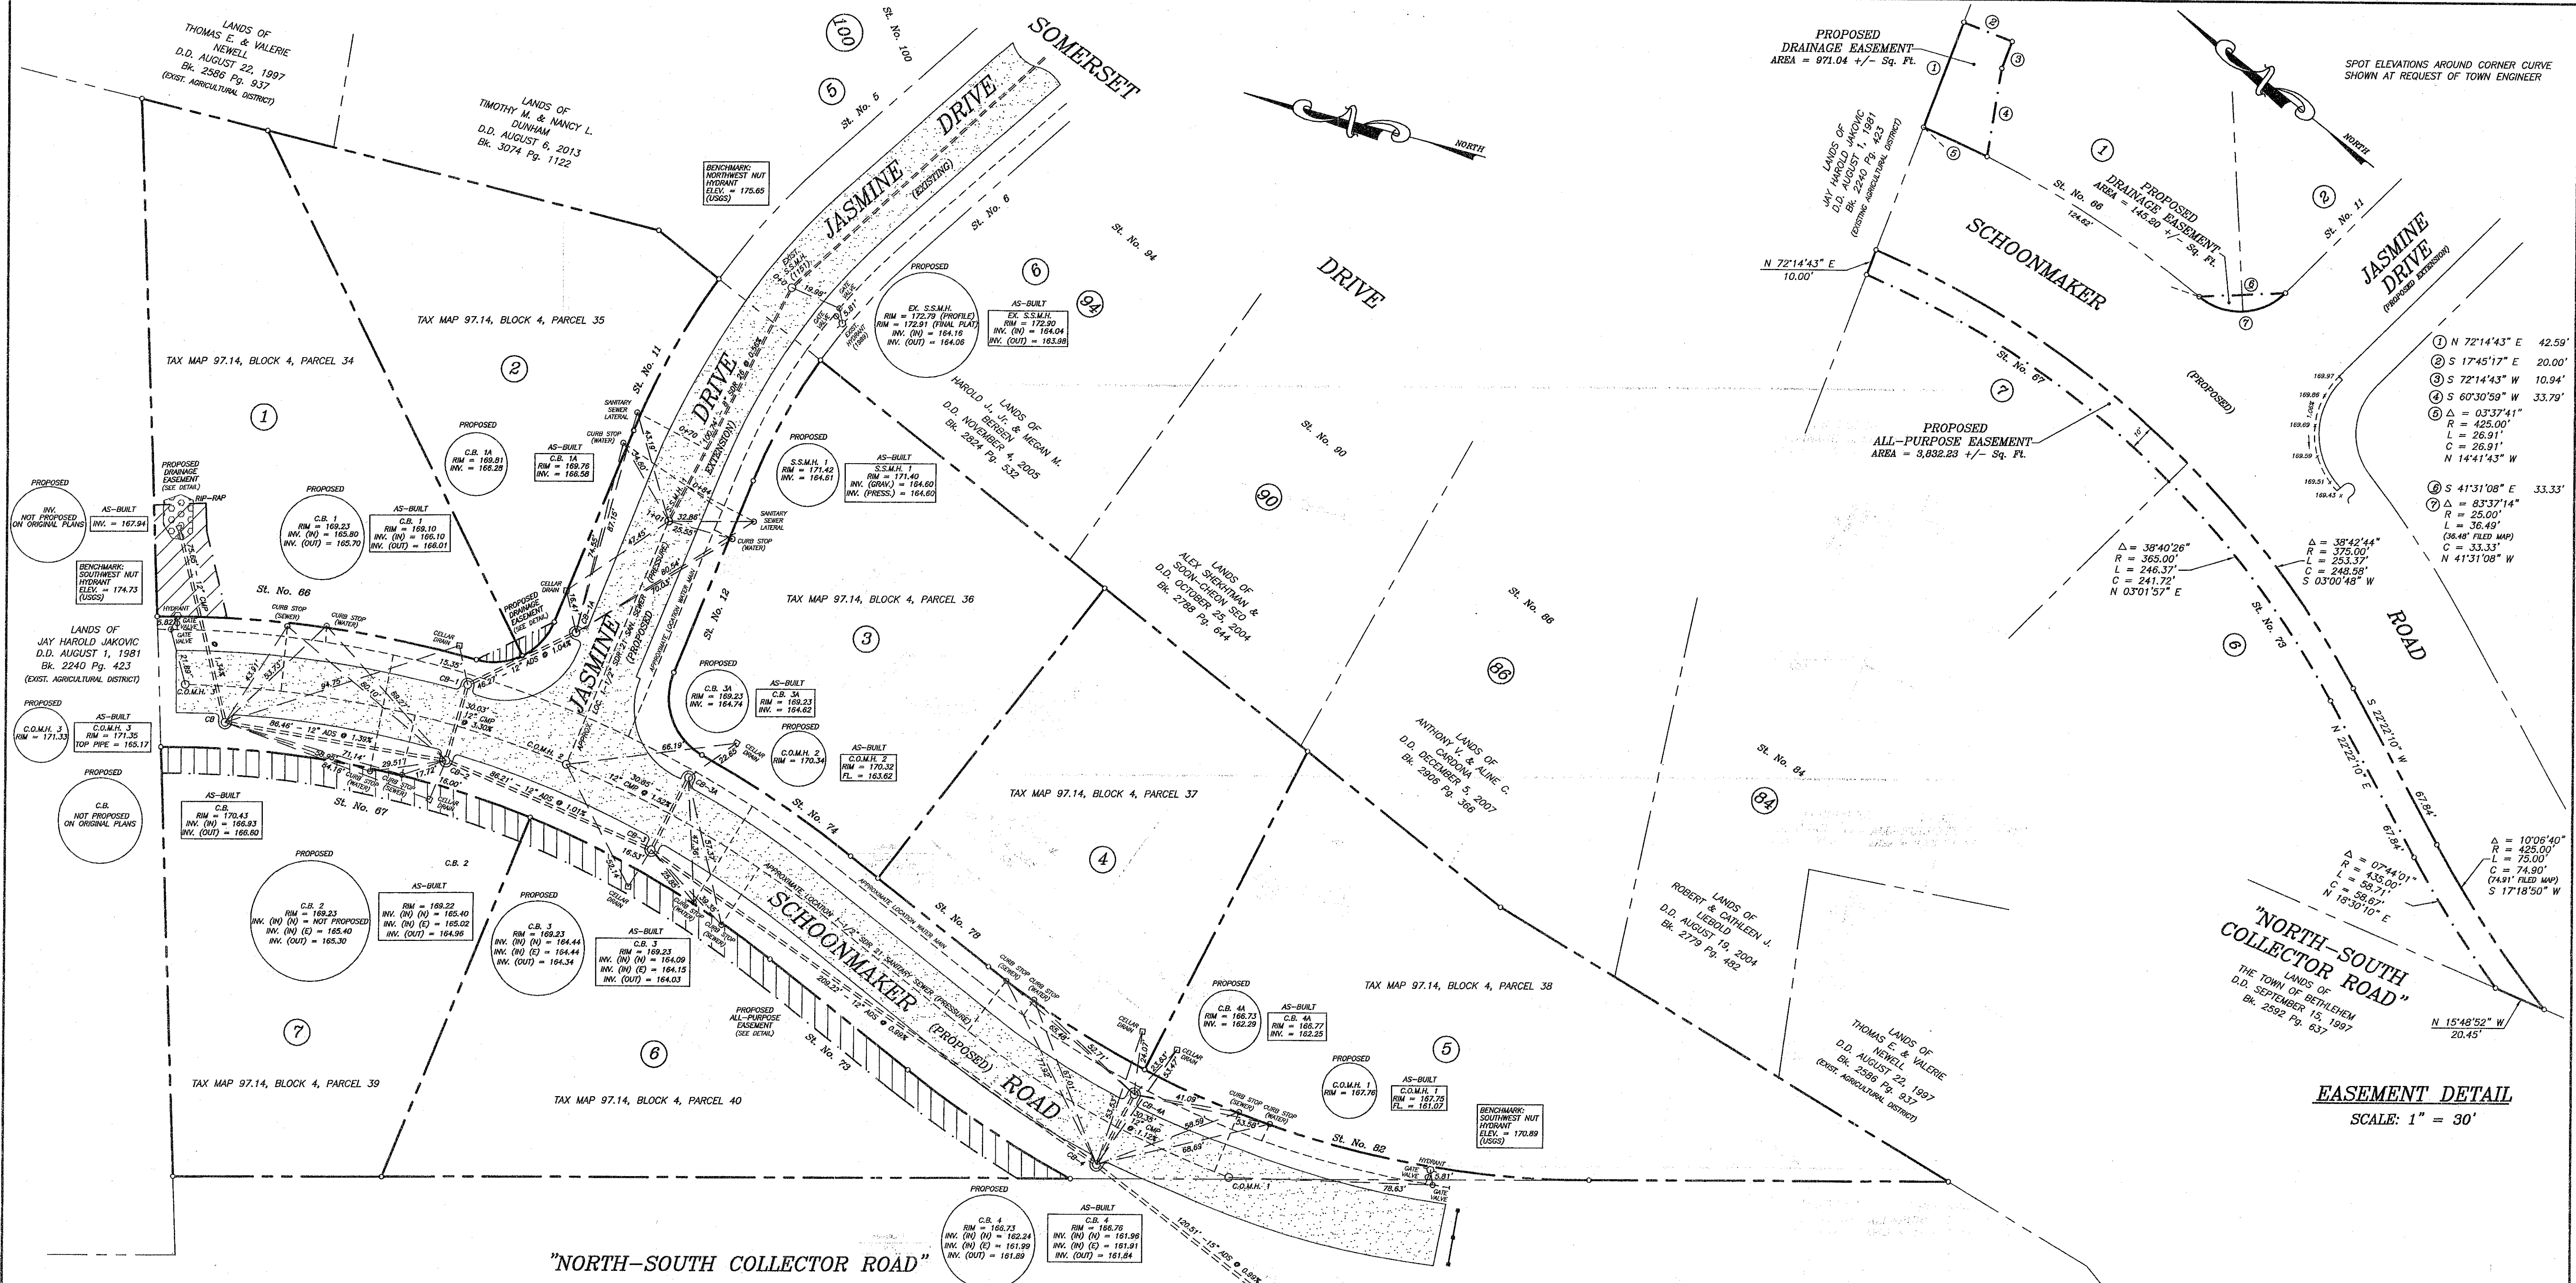

NOTES:

Sanitary Sewer:

Main - 1 1/2" SDR-21 PVC (Pressure)
Main - 8" SDR 26 PVC (Gravity)

Laterals - 1 1/4" SDR 21 (Pressure)
Laterals - 6" SDR 26 PVC (Gravity)

Water:


Main - 8" HDPE DR 11
Lateral - 1" HDPE

Location of Sanitary Sewer and Water Laterals as shown are approximate.

SUB 241

INCHES

Town of Bethlehem, NY

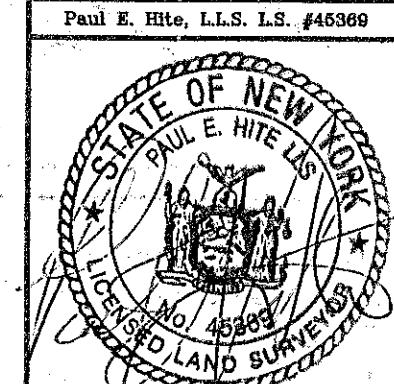

MAP OF
AS-BUILT SURVEY
UTILITIES
"MEADOWVIEW II"
SUBDIVISION
TOWN OF BETHLEHEM

COUNTY:	ALBANY
STATE:	NEW YORK
SCALE:	1" = 30'
DATE:	DECEMBER 8, 2014
DRAWN BY:	JHD
MAP NO.:	566-ASB

MAP PREPARED BY:
PAUL E. HITE
LICENSED LAND SURVEYOR
230 DELAWARE AVENUE
DELMAR, NEW YORK 12054
(518) 439-4989