



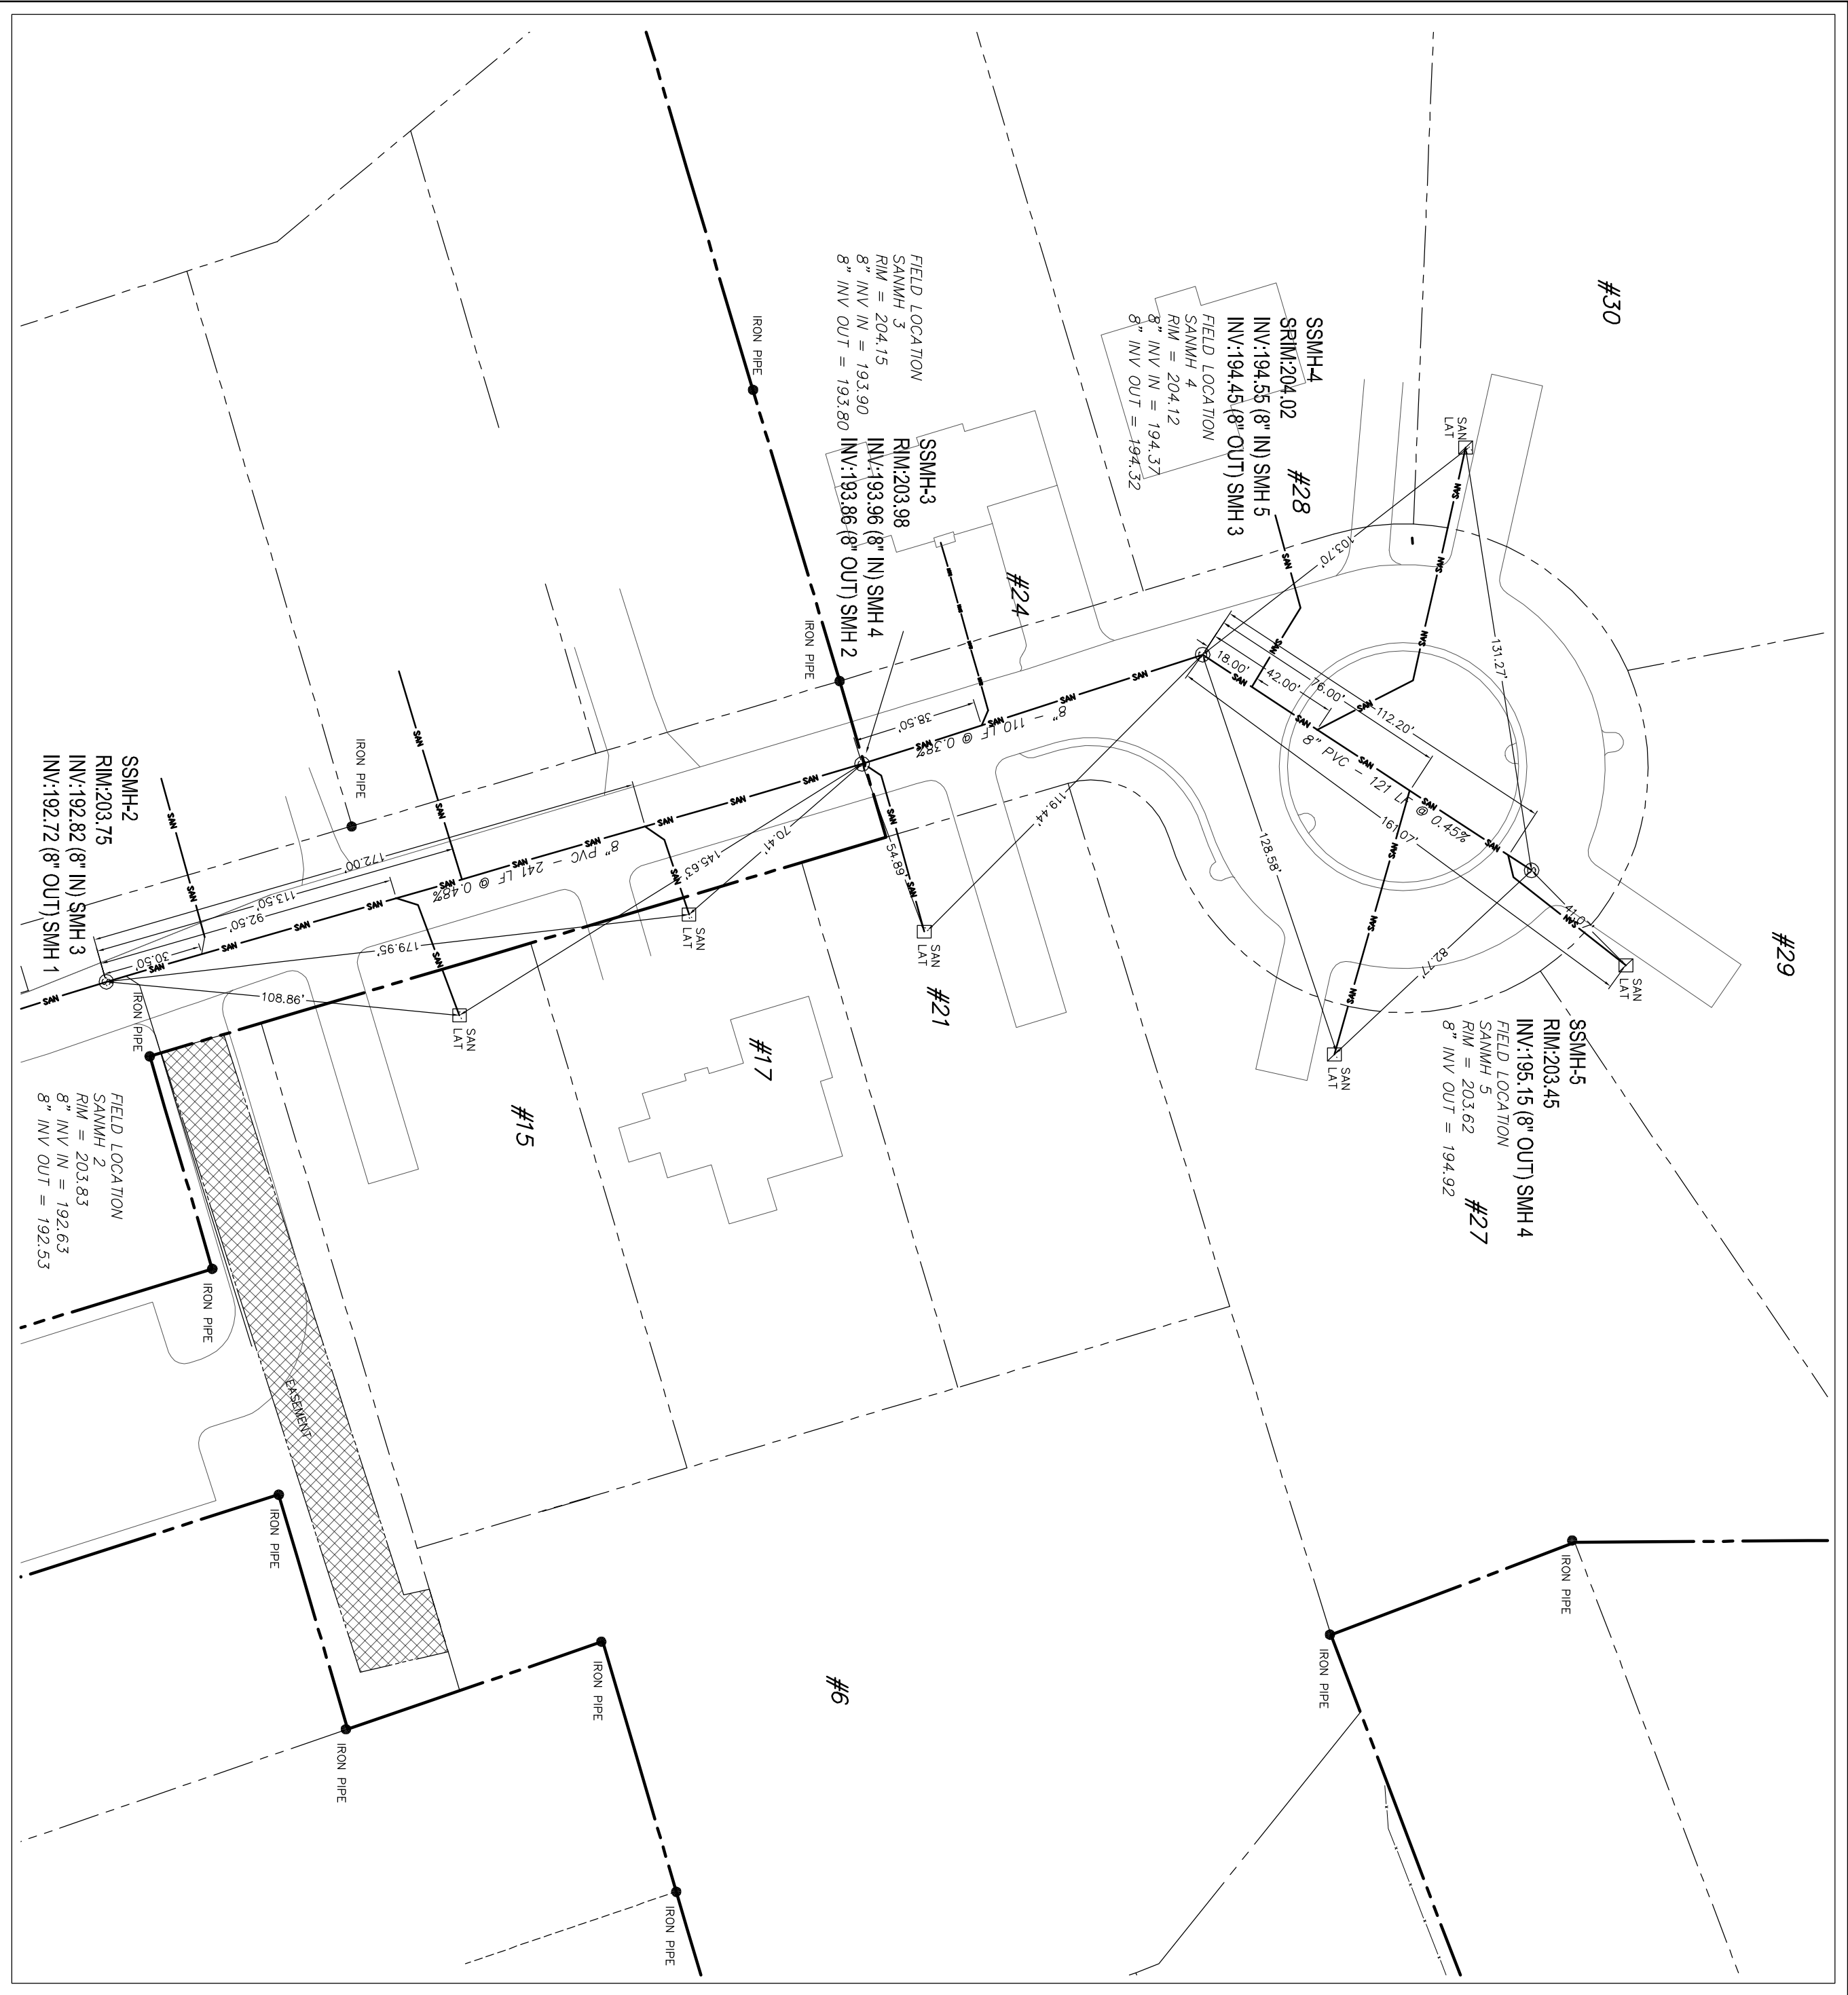


MAP REFERENCES:

- 1) MAP ENTITLED "THE PINES AT NORMANSIDE - LEONARD PLACE - FINAL SUBDIVISION PLANS" AS PREPARED BY CREIGHTON MANNING ENGINEERS LLP ON NOVEMBER 7, 2011 AND LAST REVISED ON JUNE 6, 2012.

NOTES:

- 1) SURVEY PREPARED BY GERALD R GRAY, PLS, FROM A JUNE 2014 FIELD SURVEY.
- 2) NORTH IS BASED ON MAP REFERENCE 1. ELEVATION DATUM IS NGVD 1929 PER MAP REFERENCE 1.
- 3) SUBJECT TO ALL RIGHTS, EASEMENTS, COVENANTS OR RESTRICTIONS, RECORDED OR UNRECORDED.
- 4) UNDERGROUND UTILITIES IF SHOWN HEREON ARE BASED ON VISIBLE PHYSICAL EVIDENCE. THEY SHOULD BE CONSIDERED SCHEMATIC ONLY AND ARE SHOWN TO DEPICT GENERAL UTILITY CONNECTIONS RATHER THAN EXACT UNDERGROUND LOCATIONS. GERALD R GRAY PLS MAKES NO CERTIFICATION AS TO THE ACCURACY OF THE UNDERGROUND UTILITY LOCATIONS AND OTHER UTILITIES MAY EXIST THAT ARE NOT SHOWN ON THIS MAP. CALL DIGSAFE FOR FURTHER VERIFICATION.
- 5) SURVEY IS PREPARED IN ACCORDANCE WITH THE NEW YORK STATE ASSOCIATION OF PROFESSIONAL LAND SURVEYORS CODE OF PRACTICE FOR LAND SURVEYS AS ADOPTED IN OCTOBER OF 1966 AND LAST REVISED ON JULY 16, 1997.
- 6) ORIGINAL WATERLINE ALONG LEONARD PLACE TO BE ABANDONED IN PLACE

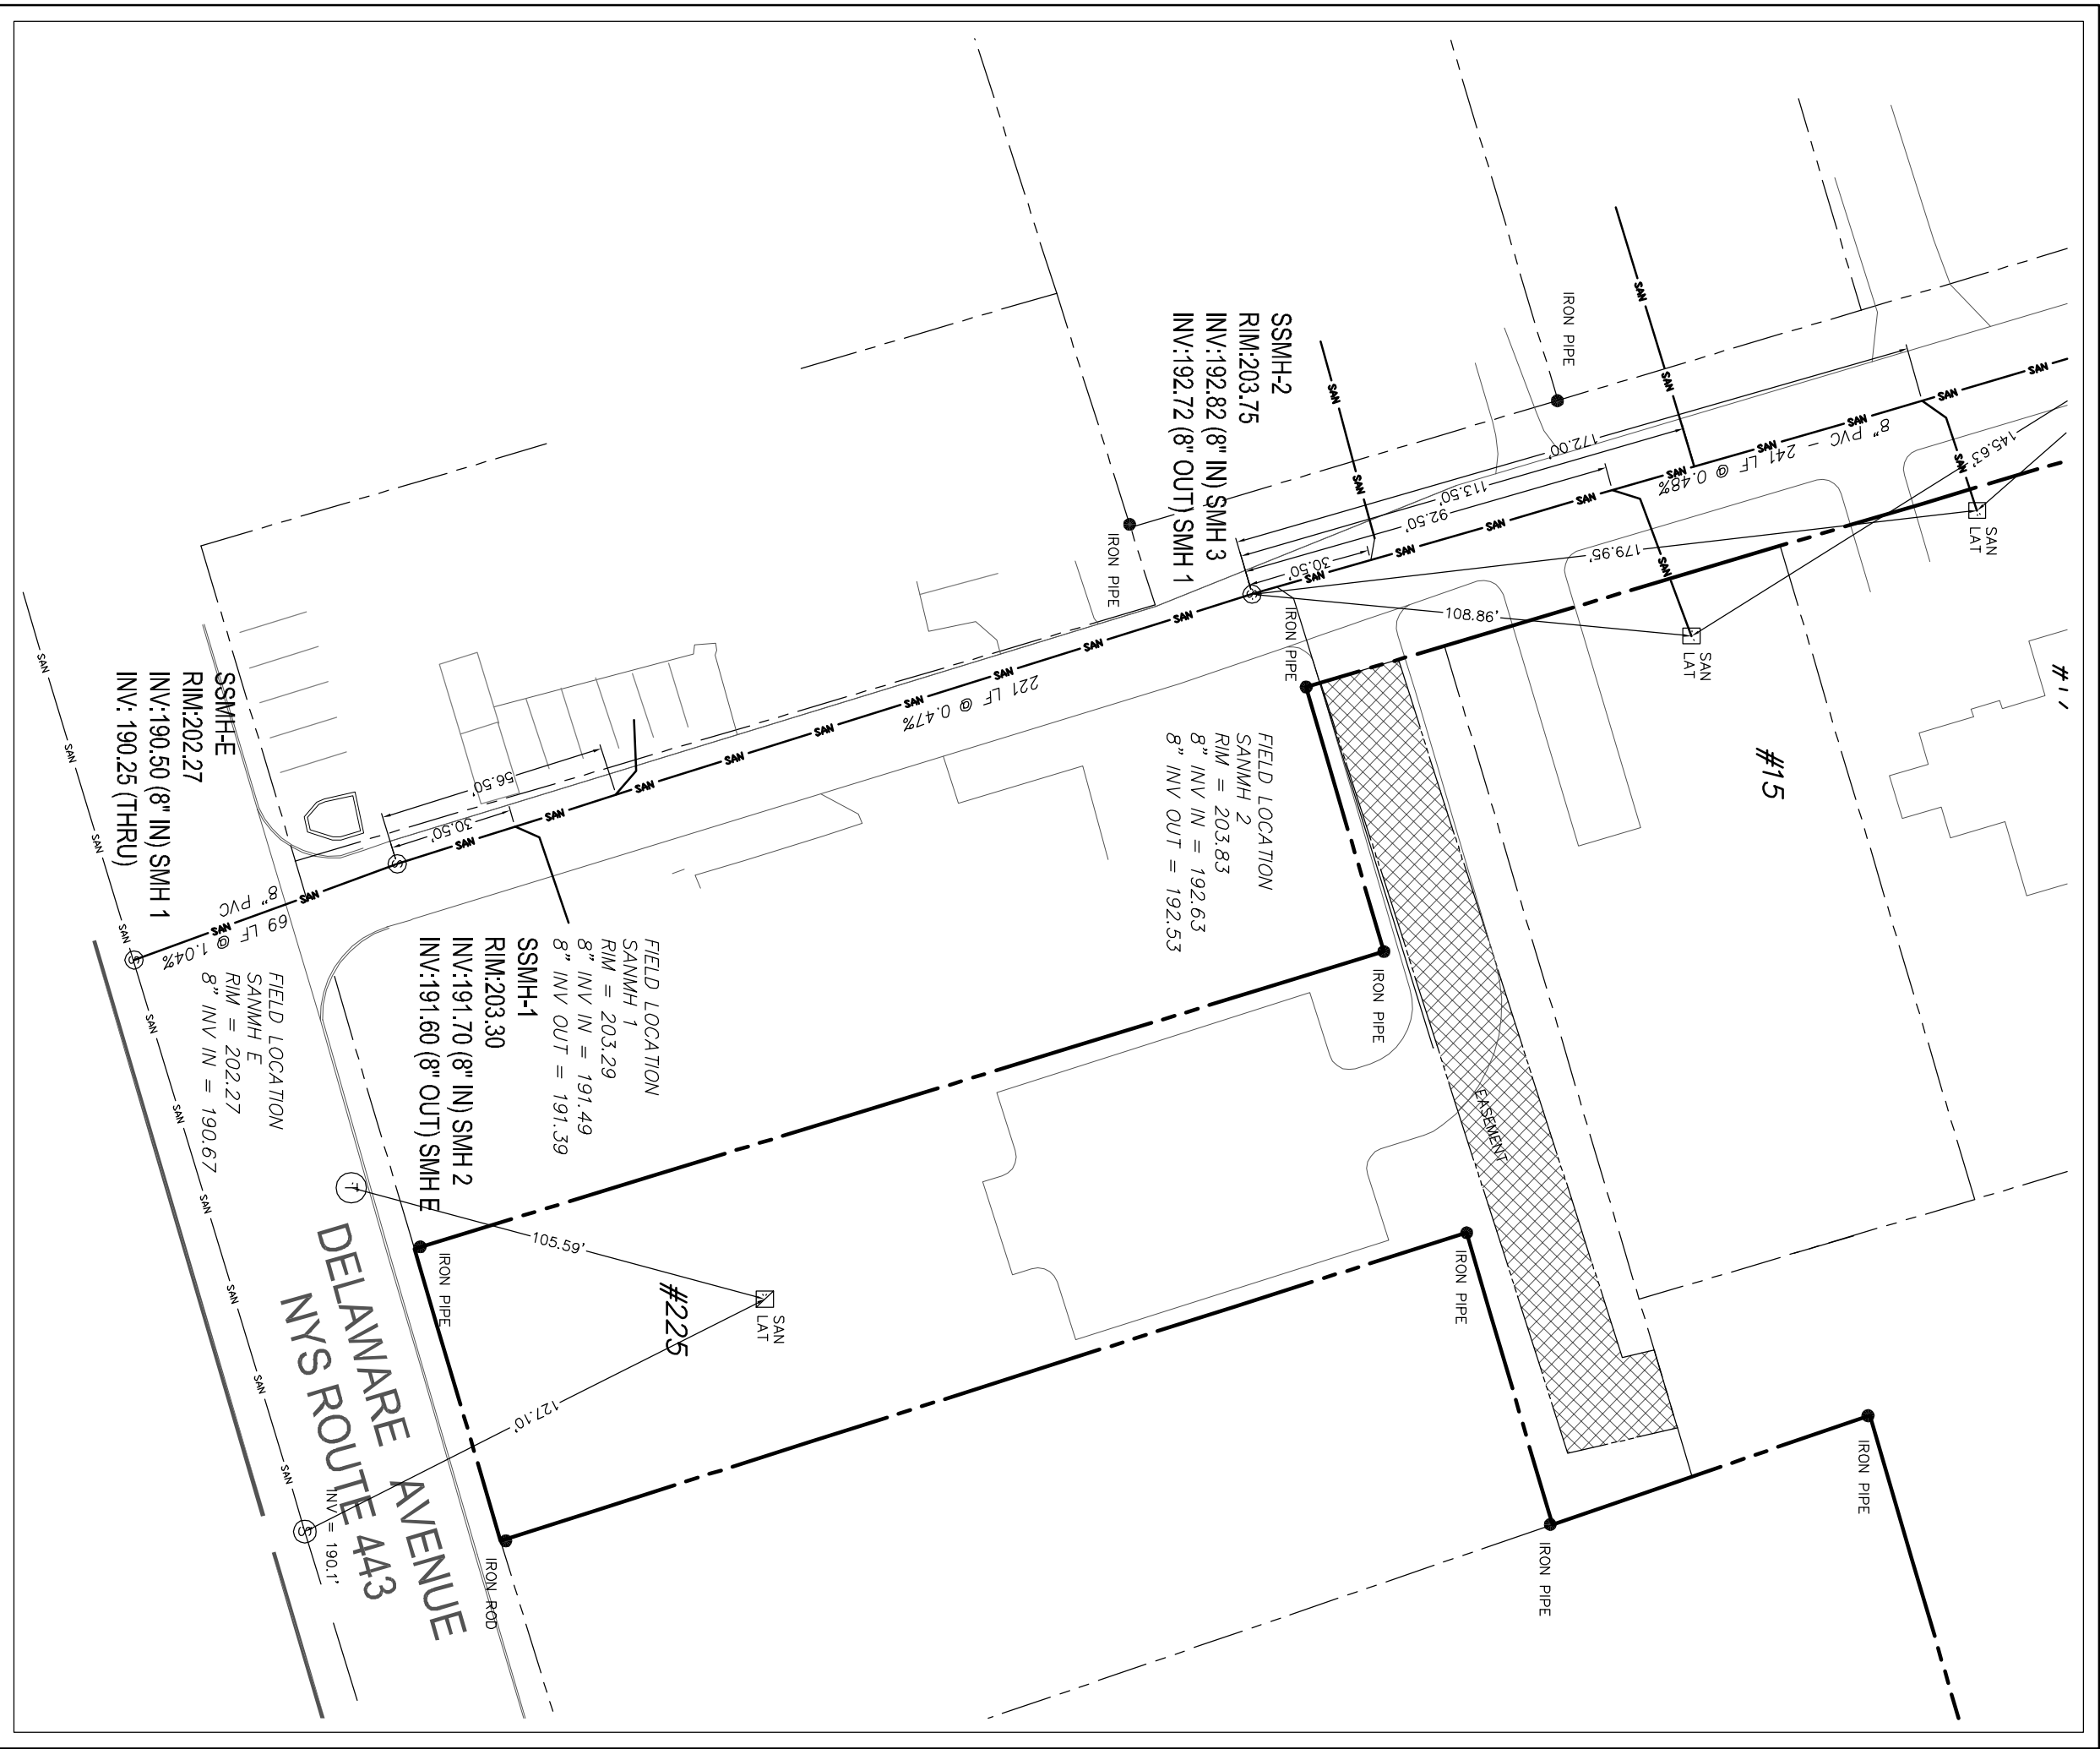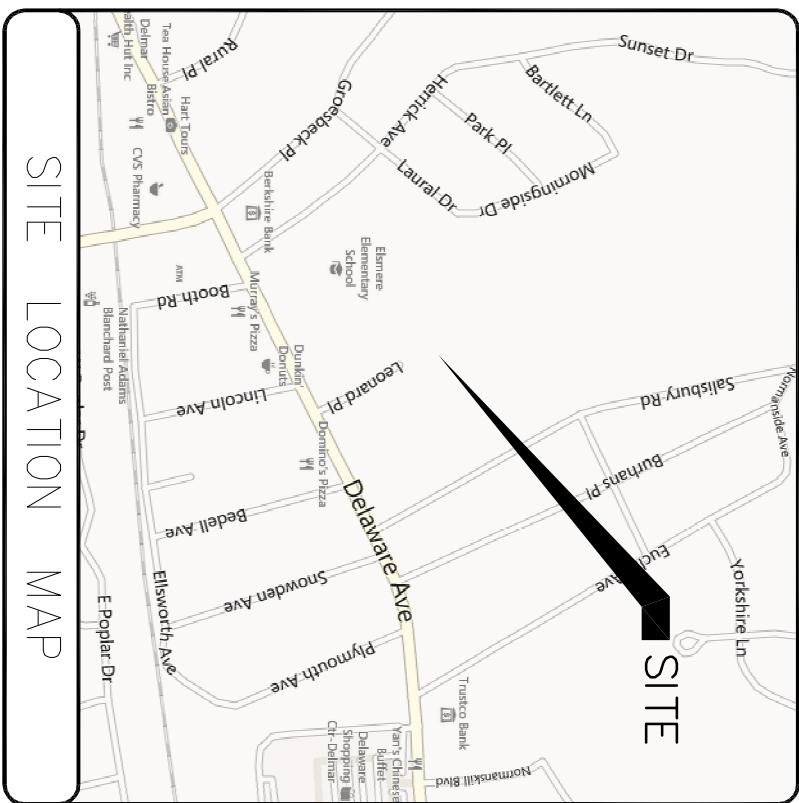

Gerald R Gray, PLS
Licensed Land Surveyor
Latham, New York 518 - 312 - 1335
COPYRIGHT © 2014

UNAUTHORIZED ALTERATION OR ADDITION TO THIS SURVEY MAP IS A VIOLATION OF NEW YORK STATE EDUCATION LAW. COPIES OF THIS SURVEY MAP NOT BE LOANED, REPRODUCED, COPIED, OR OTHERWISE USED WITHOUT THE WRITTEN CONSENT OF GERALD R GRAY, PLS. THE SURVEY IS PREPARED FOR WHOM THE SURVEY IS PREPARED. ADDITIONAL PARTIES LISTED HEREON, TO ADDITIONAL PARTIES NOT ASSOCIATED WITH THIS SURVEY, ARE NOT ASSOCIATED WITH THIS SURVEY, AND ARE NOT ASSOCIATED WITH THIS SURVEY.

No.	Submittal Revision	App'd	Date
1			
2			
3			
4			
5			
6			
7			
8			
9			
10			

Drawn: GRG Date: 12/31/14
Designed: Date:
Checked: GRG Date: 12/31/14

Project Number

Project Title
The Pines at Normanside
Leonard Place
Town of Bethlehem
State of New York

Prepared For
Keystone
Builders

Drawing Title
Record Survey
Sanitary Sewer

Drawing Scale:

1" = 40'

Date:

12/3/2014

Drawing Number

1