



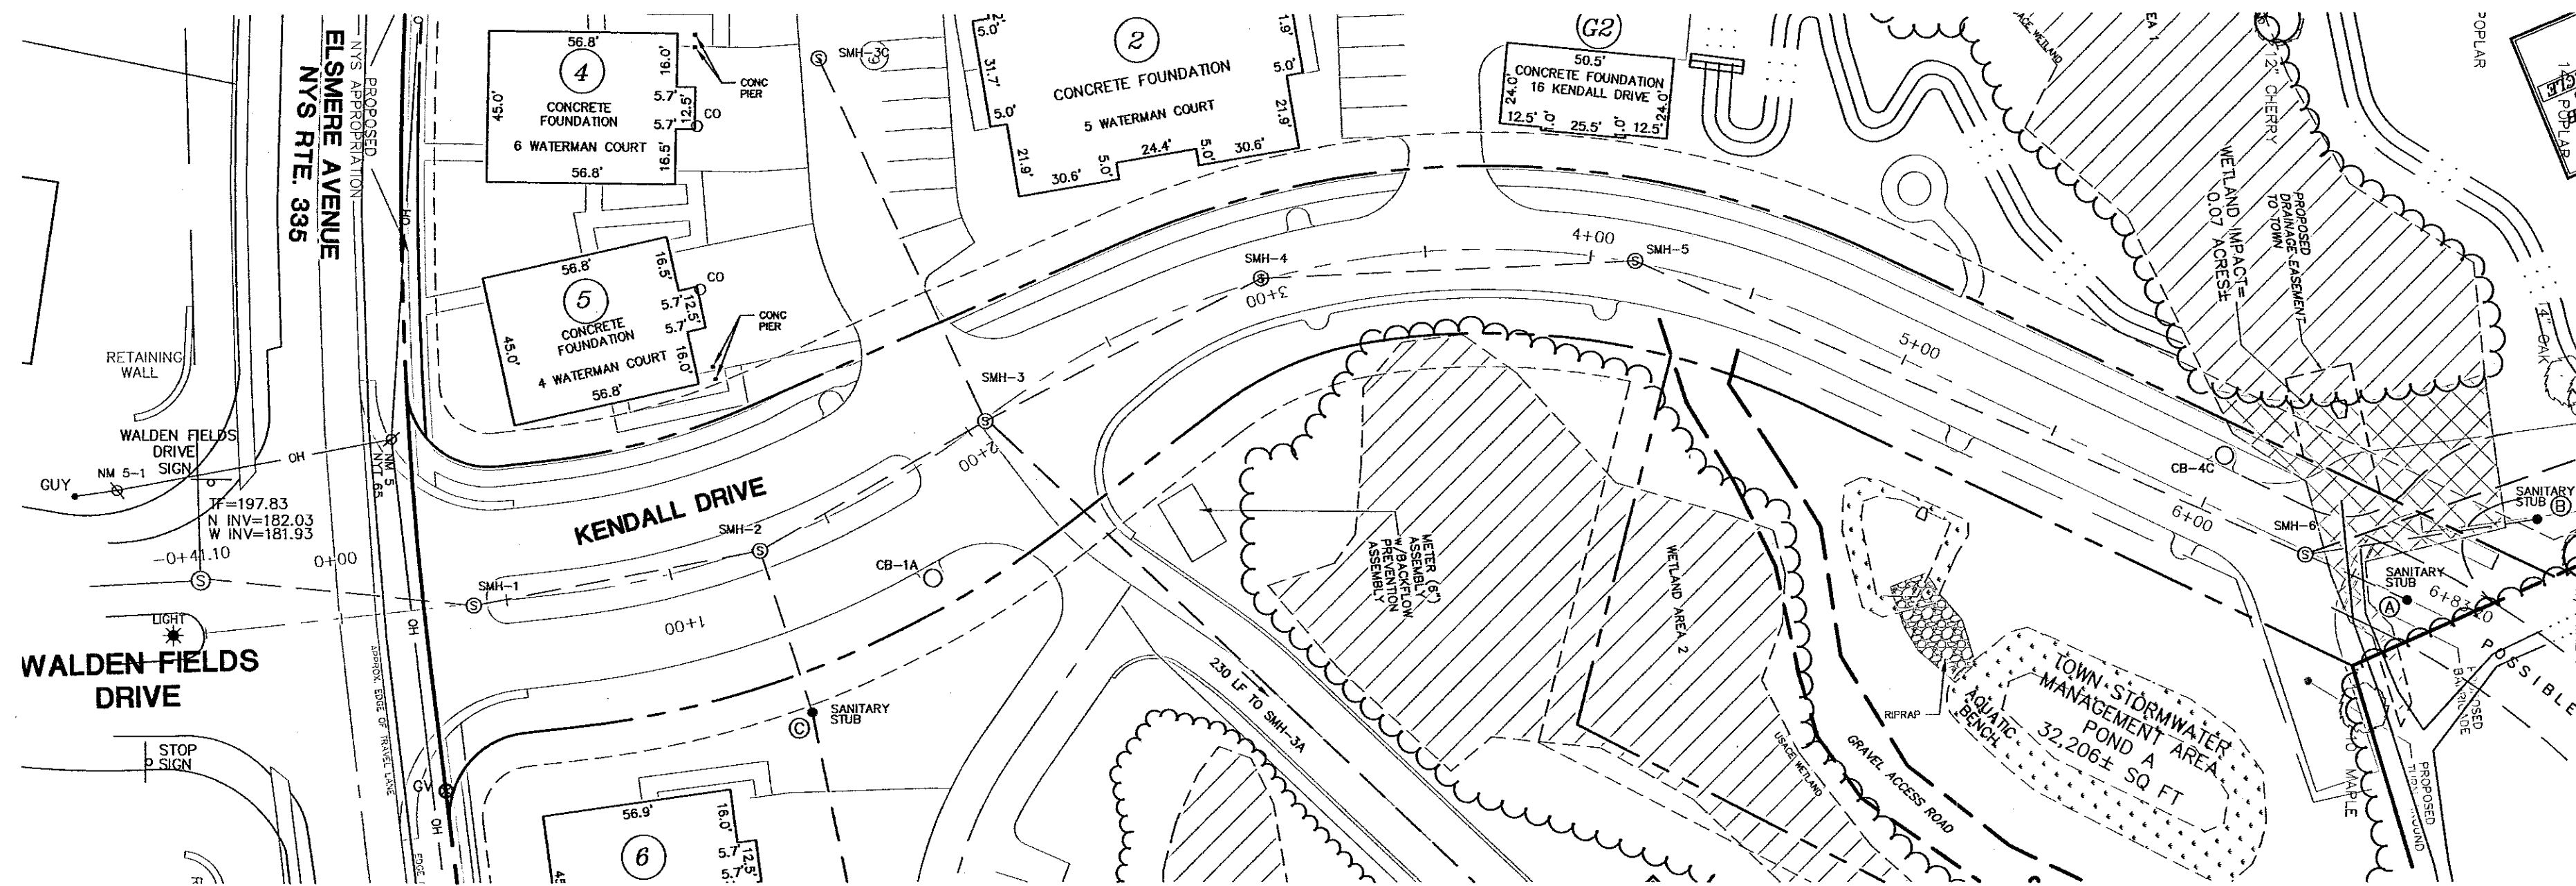


TOWN ROAD PLAN VIEW
SCALE: VERT. 1" = 4'
HORIZ. 1" = 40'

SANITARY SEWER TIES					
NO.	DIST. (FT.)	UTILITY	DIST. (FT.)	UTILITY	DESCRIPTION
A	33.6	SMH-6	70.0	CB-4C	STUB
B	70.7	SMH-6	96.2	CB-4C	STUB
C	50.8	SMH-2	54.0	CB-1A	STUB

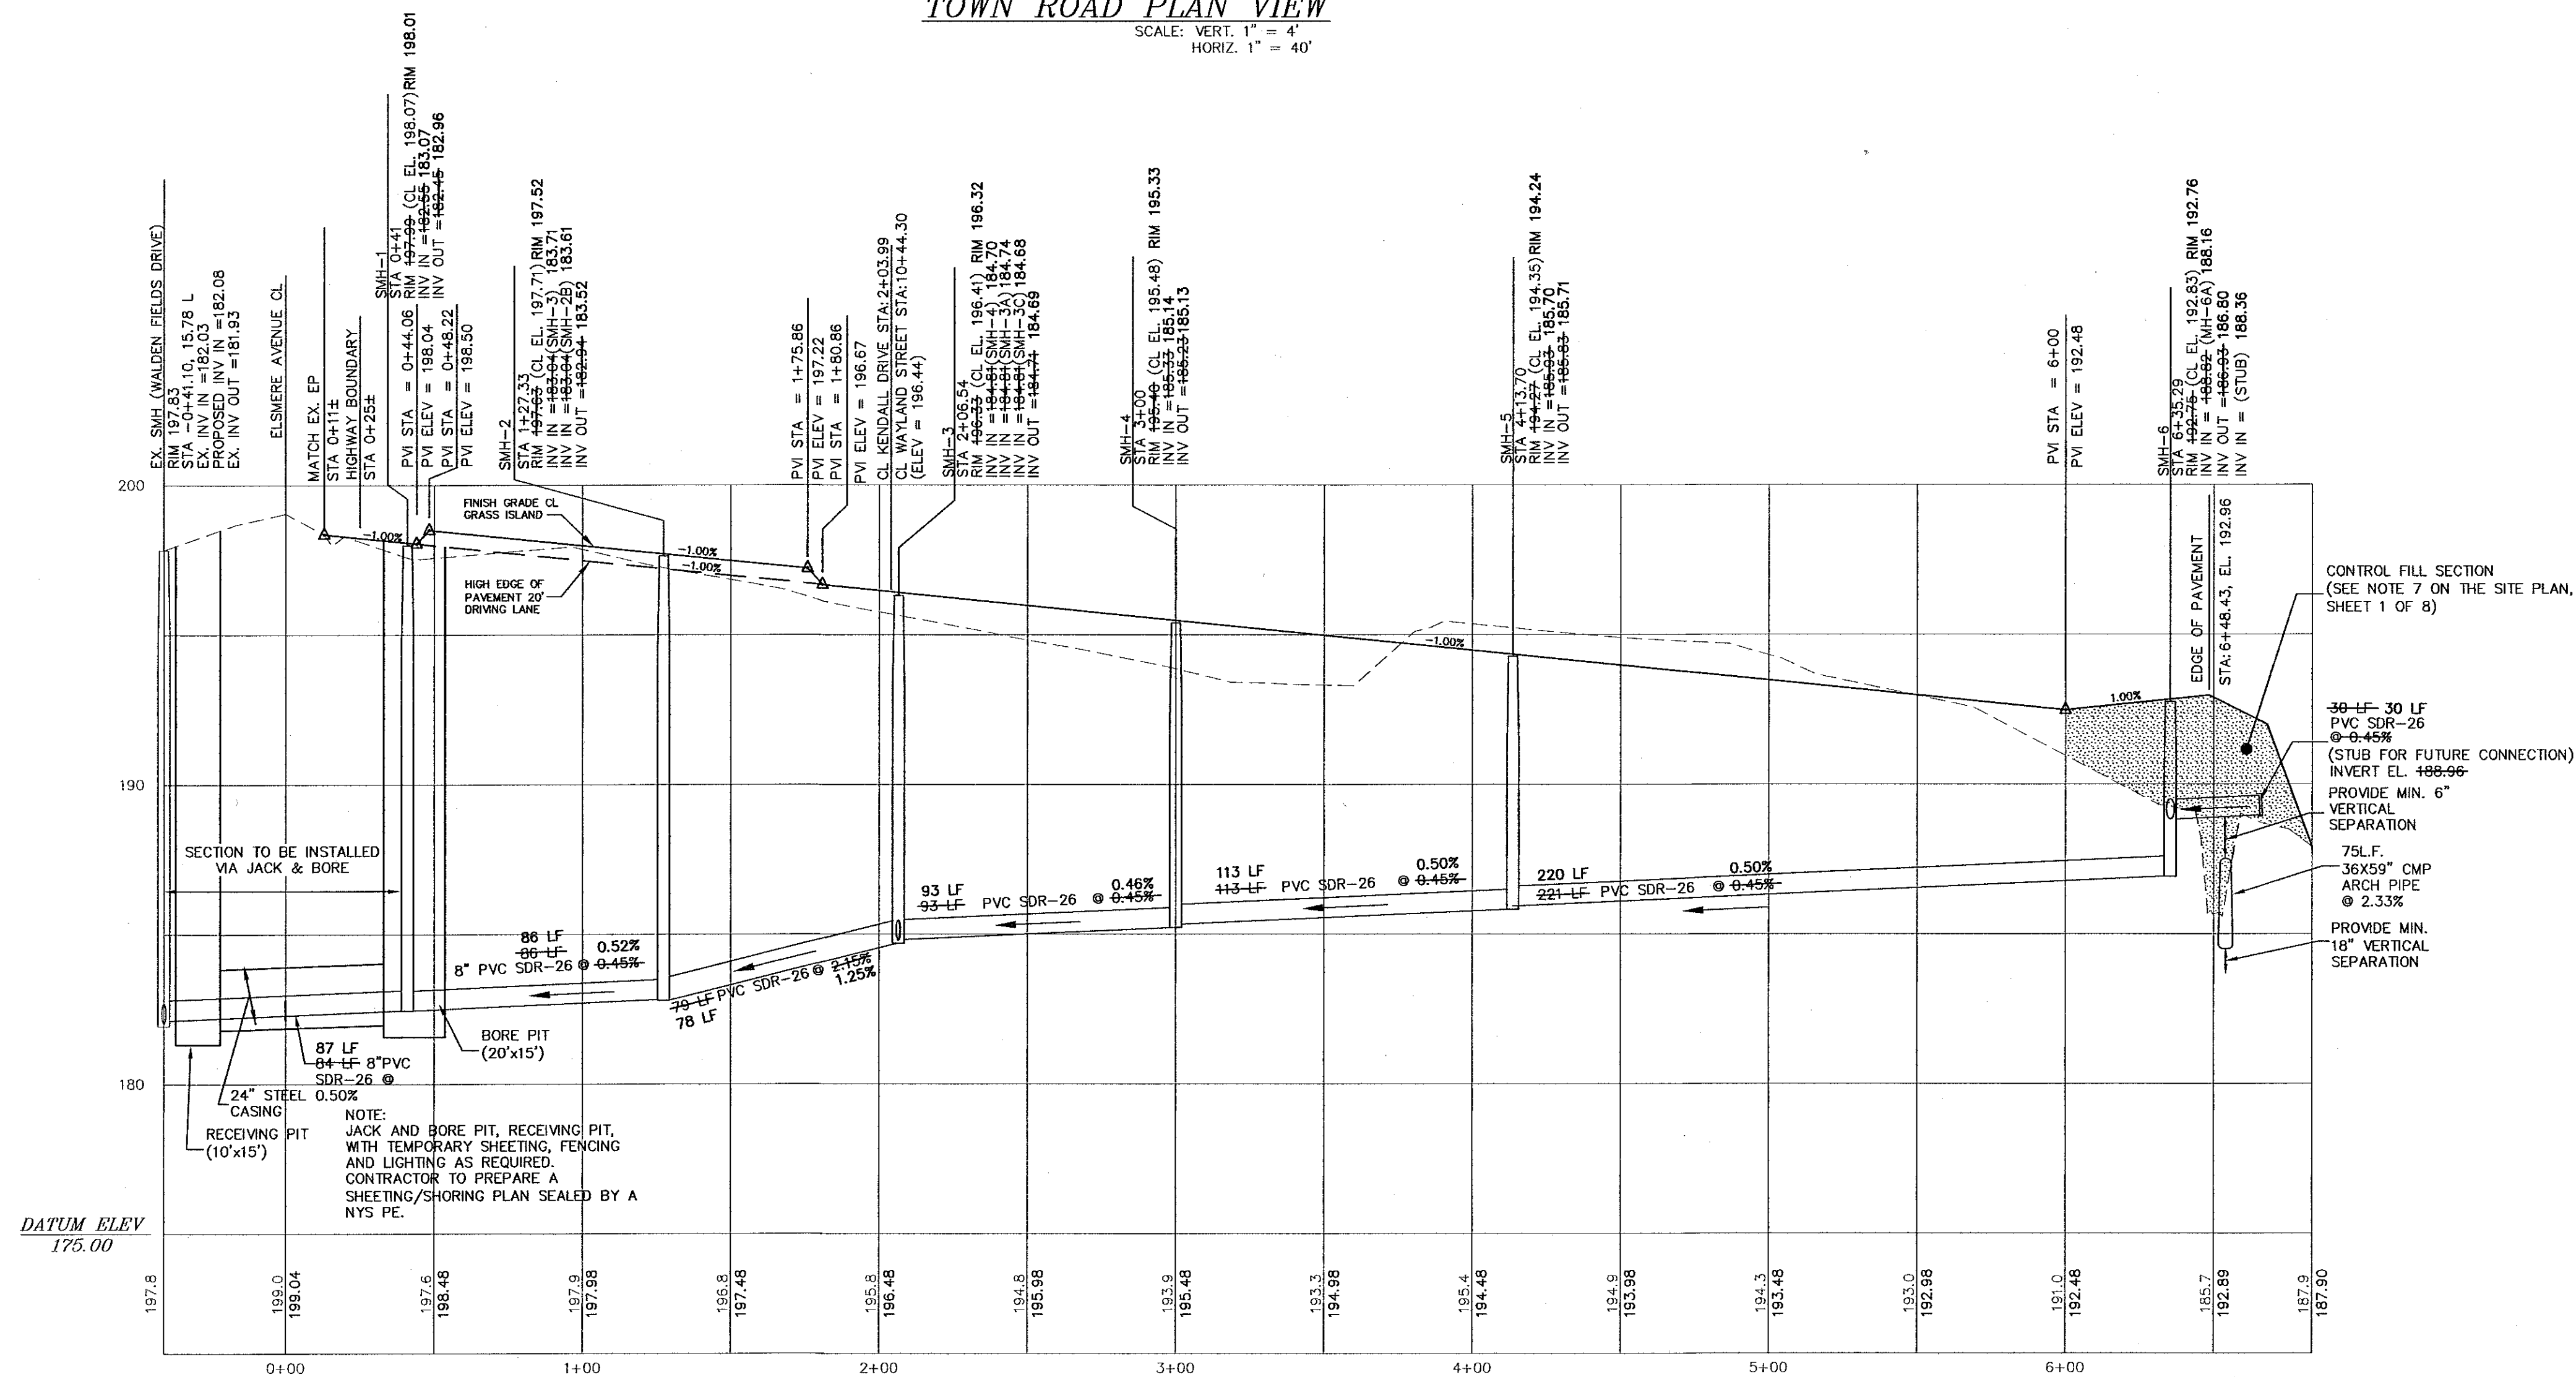


KENDALL DRIVE
SCALE: VERT. 1" = 4'
HORIZ. 1" = 40'

SUB 253

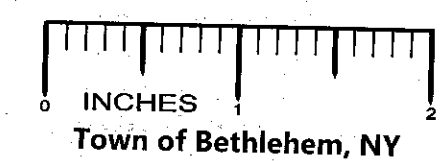

FOR INFORMATION ONLY
NOT FOR CONSTRUCTION

UNAUTHORIZED ALTERATION OR ADDITION TO THIS DRAWING IS A VIOLATION OF SECTION 7209 SUBDIVISION 2, OF THE NEW YORK STATE EDUCATION LAW. ONLY COPIES MADE FROM THE ORIGINAL OF THIS DRAWING BEARING AN ORIGINAL INKED OR EMBOSSED SEAL AND SIGNATURE SHALL BE CONSIDERED TO BE VALID TRUE COPIES.		
© Copyright 2011 - Ingalls & Associates, LLP - All rights reserved.		
NO.	DATE:	REVISIONS
BY:		

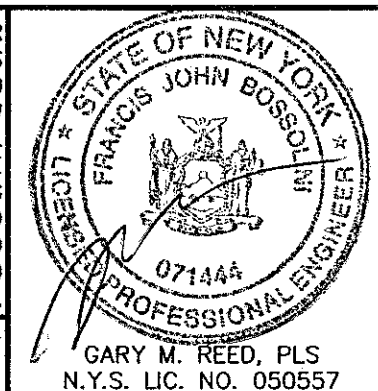

ingalls & associates, LLP
engineers / surveyors
2603 GUILDERLAND AVENUE
SCHENECTADY, N.Y. 12306
PHONE: (518) 393-7725
FAX: (518) 393-8524

RECORD PLAN - PROFILE
SANITARY SEWER - KENDALL DRIVE
KENDALL SQUARE HAMLET
TOWN OF BETHEHEM
COUNTY OF ALBANY STATE OF NEW YORK

DATE: JANUARY 3, 2011	CHECKED BY: GMR JOB NO. 08-065	SCALE: AS NOTED
DRAWN BY: RDF CADD FILE: 08-065 AS-BUILT	SHEET 1 OF 1	