

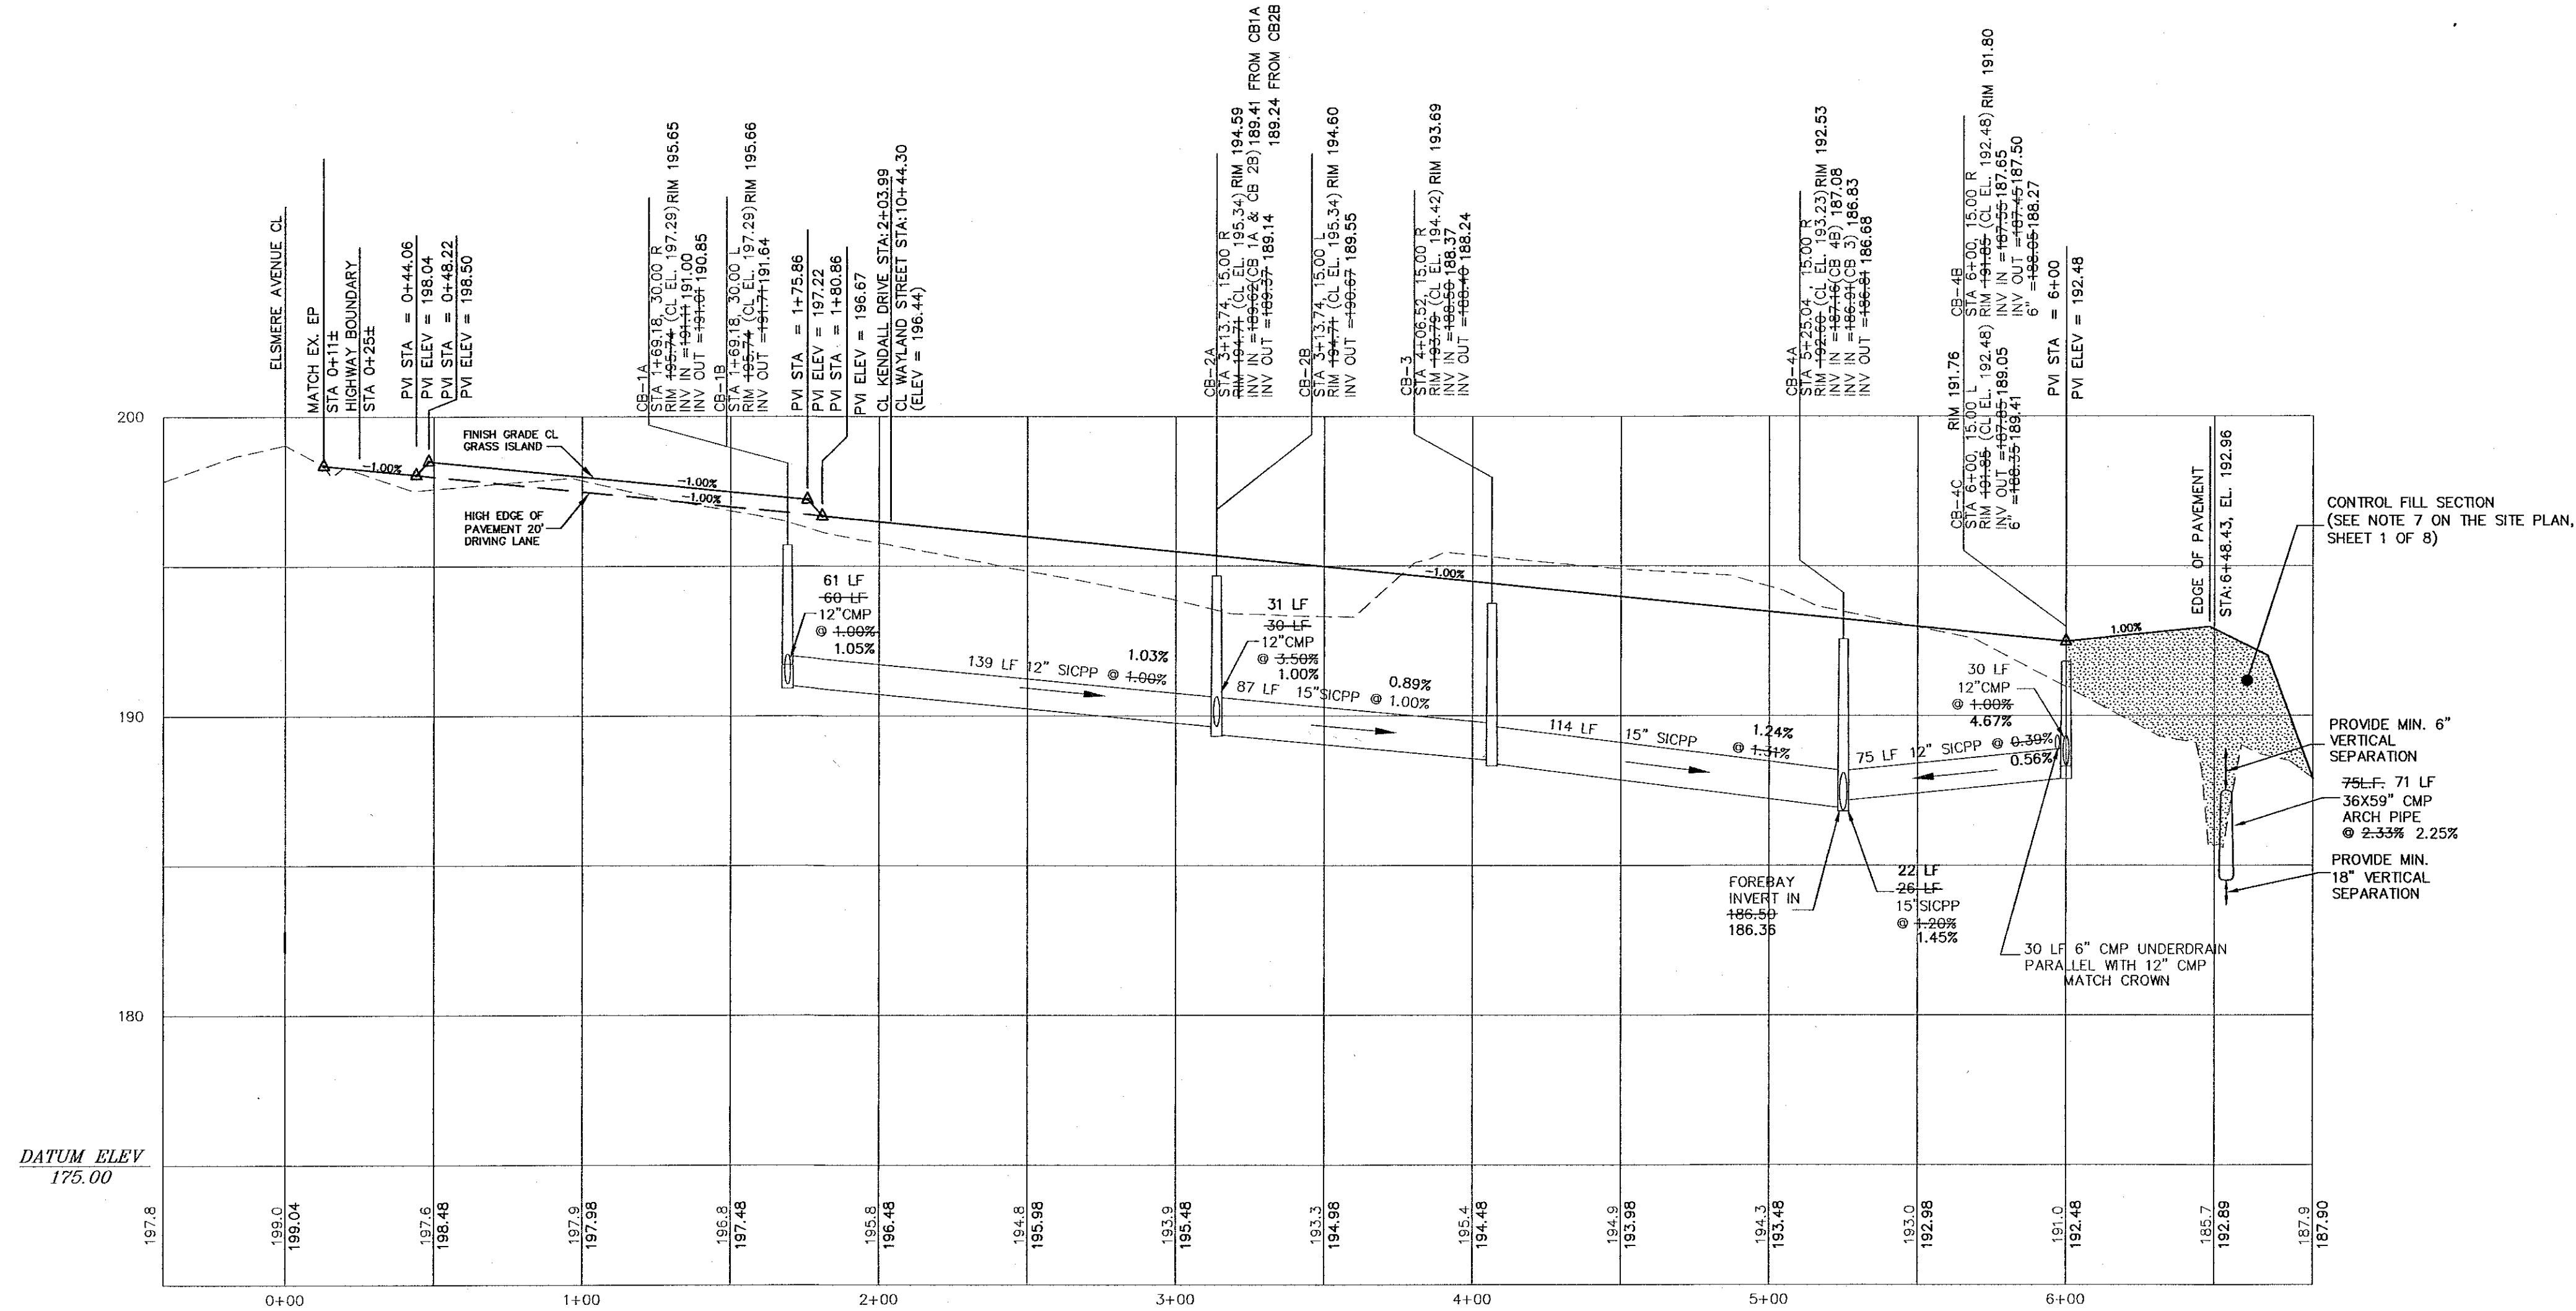


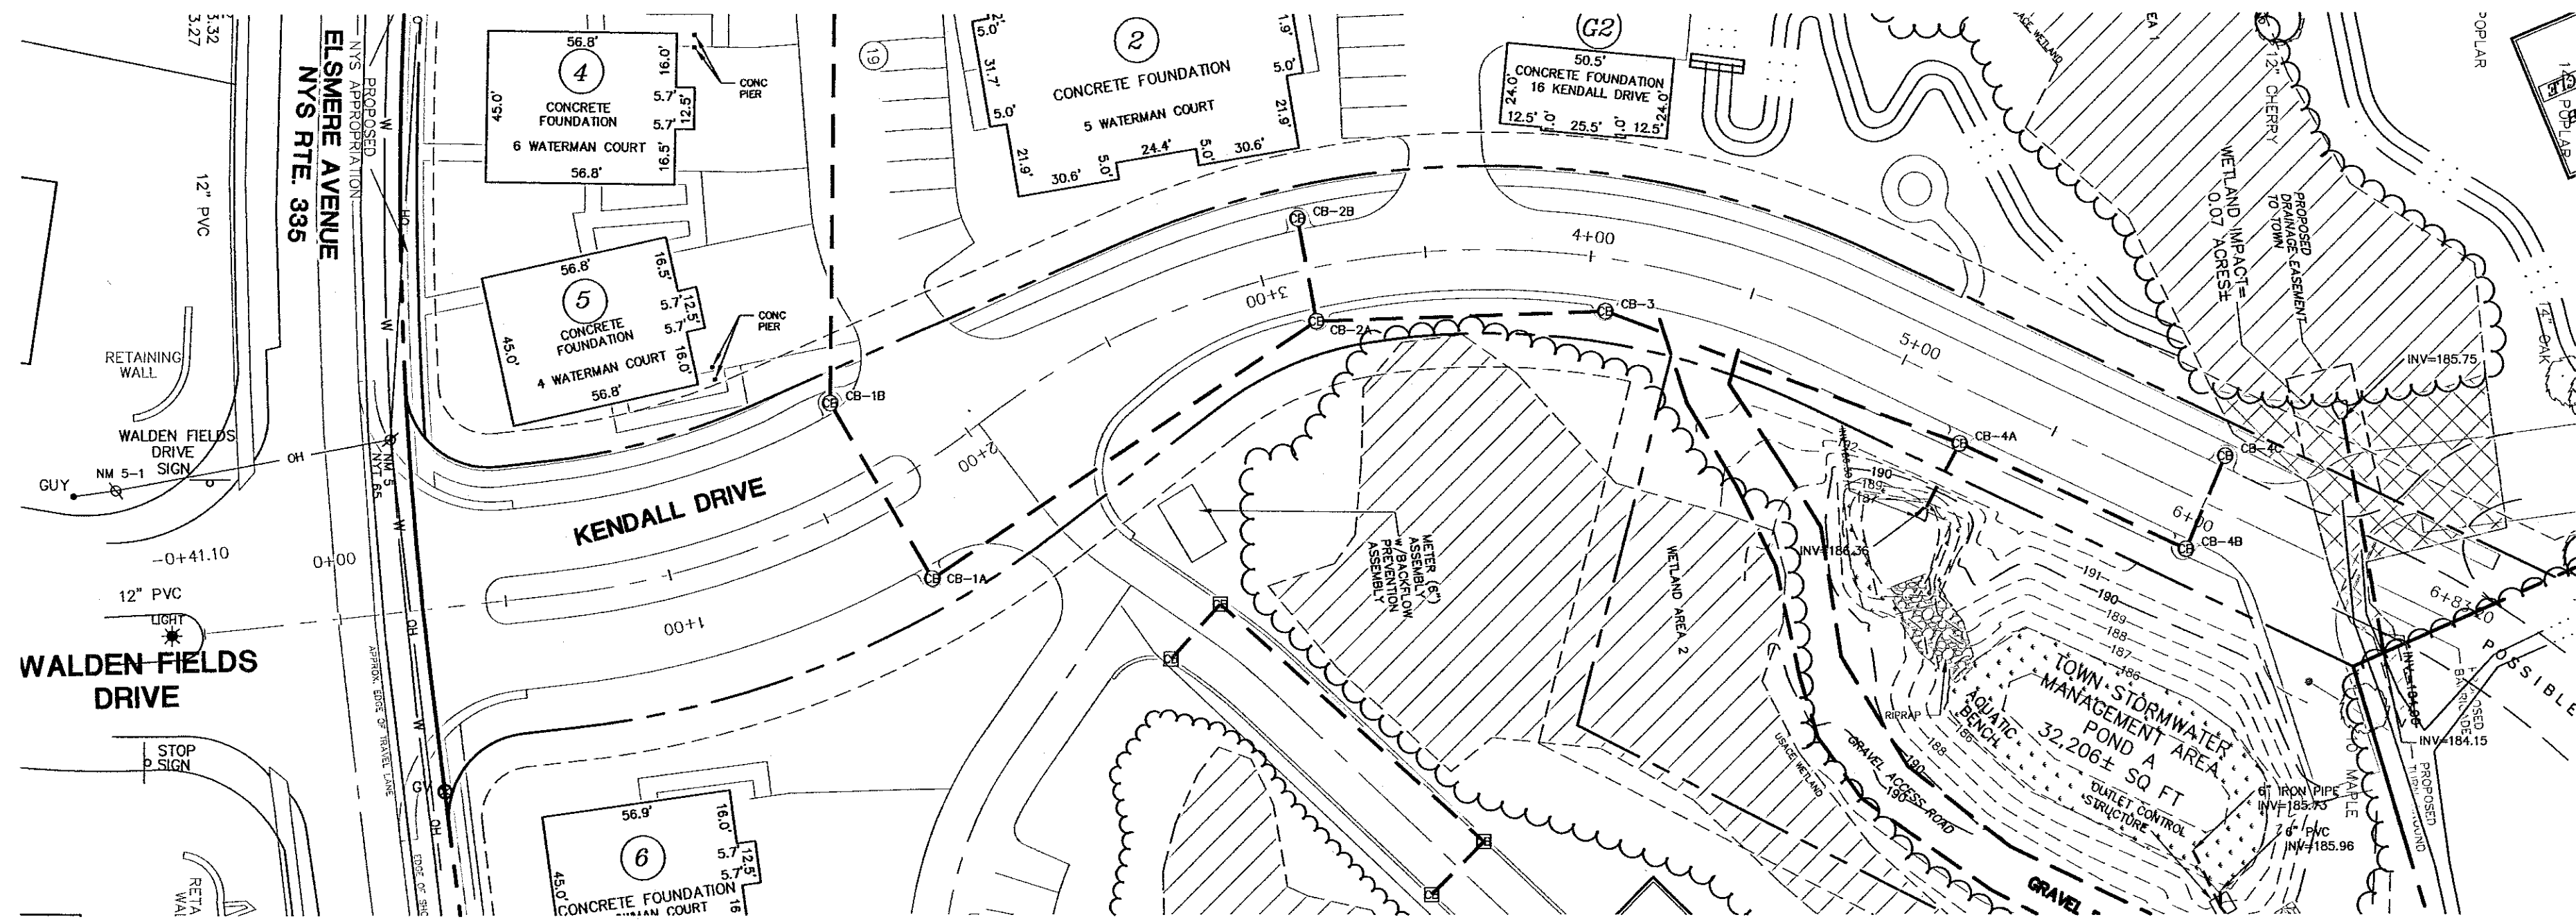

Sub 253

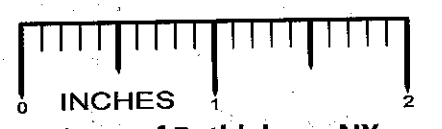


FOR INFORMATION ONLY
NOT FOR CONSTRUCTION

KENDALL DRIVE

SCALE: VERT. 1" = 4'
HORIZ. 1" = 40'

UNAUTHORIZED ALTERATION OR ADDITION TO THIS DRAWING IS A VIOLATION OF SECTION 7209 SUBDIVISION 2, OF THE NEW YORK STATE EDUCATION LAW. ONLY COPIES MADE FROM THE ORIGINAL OF THIS DRAWING BEARING AN ORIGINAL INKED OR EMBOSSED SEAL AND SIGNATURE SHALL BE CONSIDERED TO BE VALID TRUE COPIES.		
© Copyright 2011 - Ingalls & Associates, LLP - All rights reserved		
NO.	DATE:	REVISIONS
BY:		

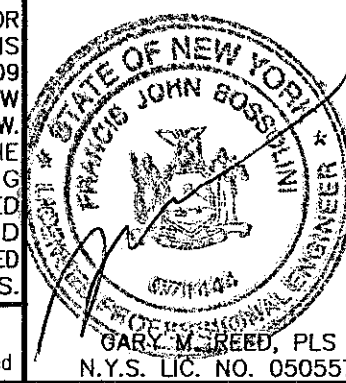

ia
ingalls & associates, LLP
engineers / surveyors
2803 GUILDFORD AVENUE
SCHENECTADY, N.Y. 12306
PHONE: (518) 393-7725
FAX: (518) 393-9924

RECORD PLAN - PROFILE
STORM SEWER - KENDALL DRIVE
KENDALL SQUARE HAMLET

TOWN OF BETHEHEM
COUNTY OF ALBANY STATE OF NEW YORK

DATE: JANUARY 3, 2011
CHECKED BY: GMR
JOB NO. 08-065
DRAWN BY: RDB
CADD FILE: 08-065 AS-BUILT
SCALE: AS NOTED
SHEET 1 OF 1