



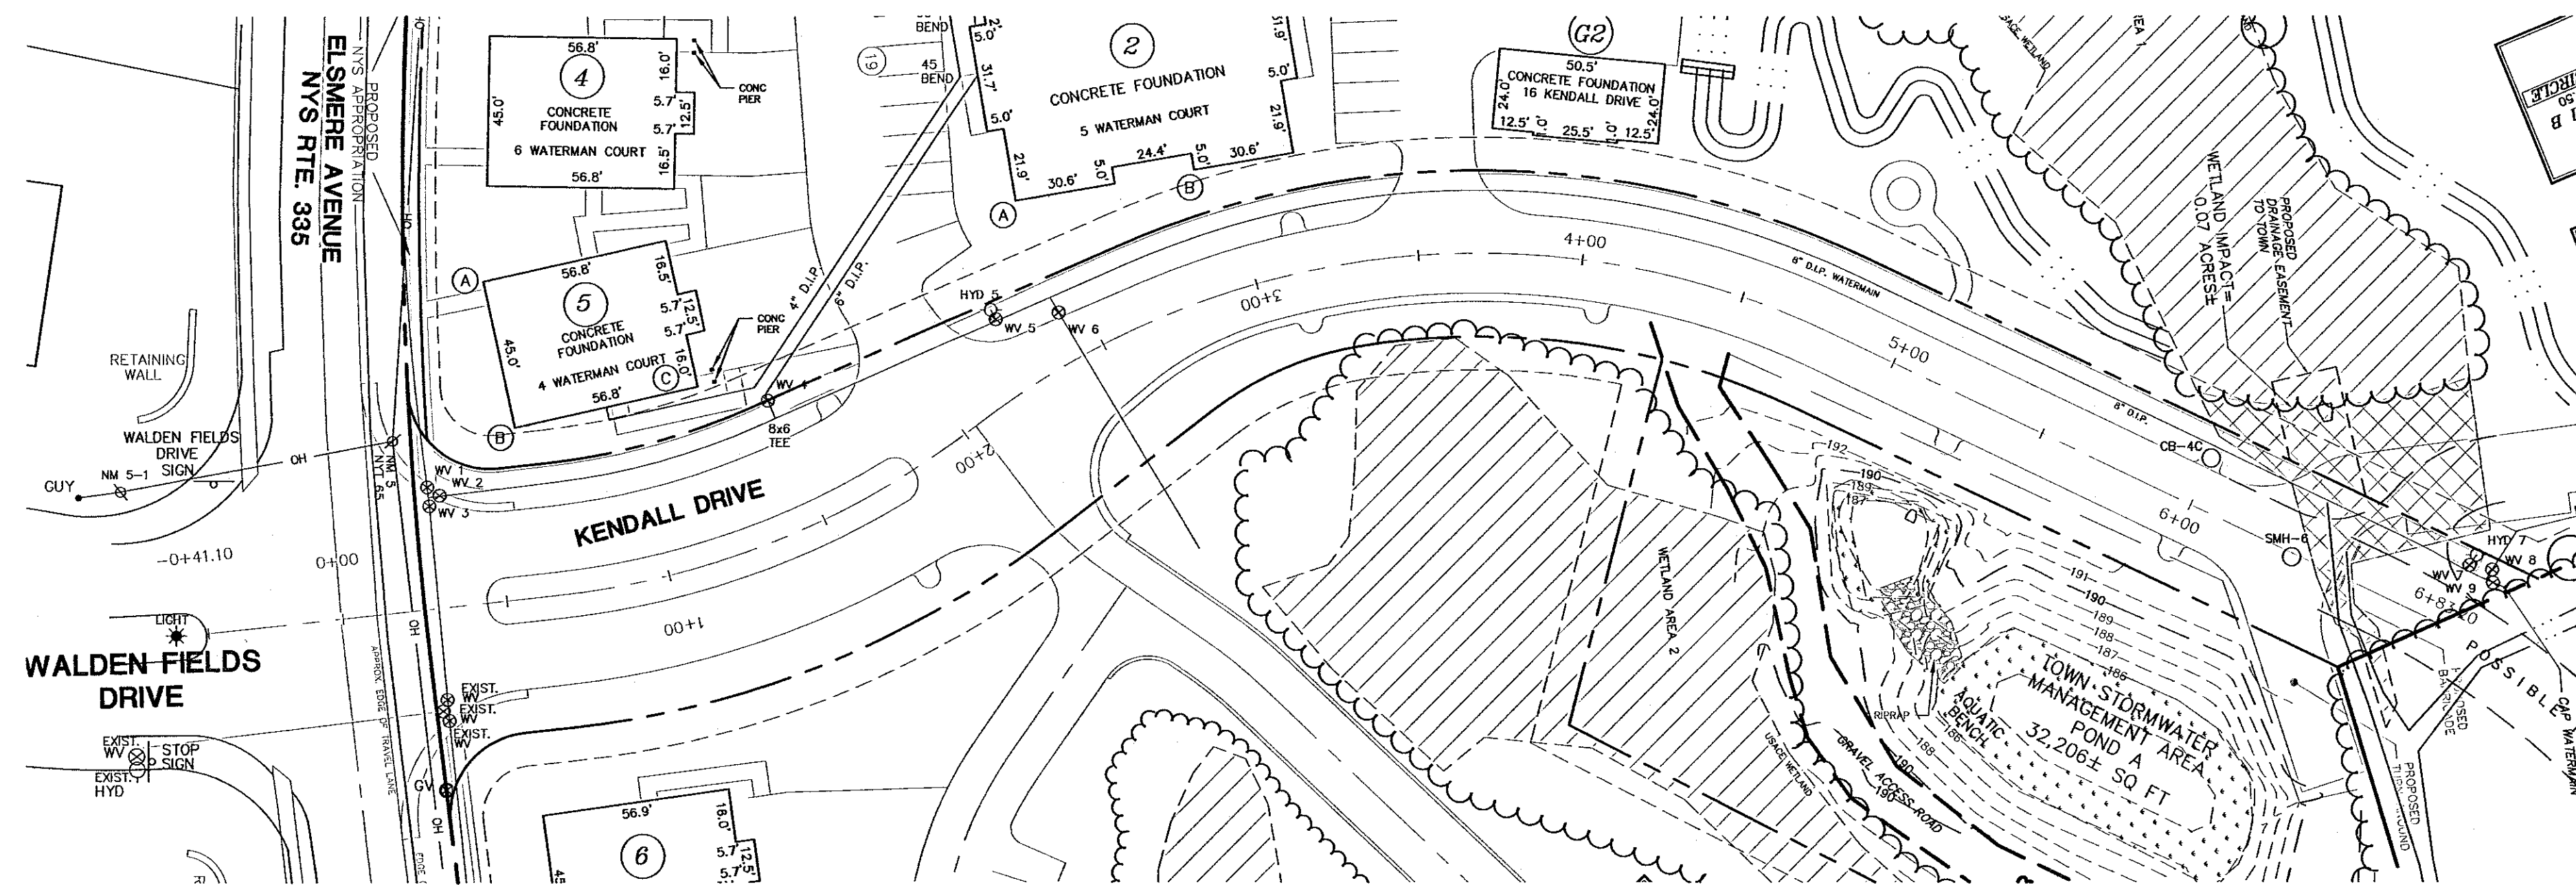


TOWN ROAD PLAN VIEW
SCALE: VERT. 1" = 4'
HORIZ. 1" = 40'

HYDRANTS & VALVES					
NO.	DIST (FT.)	BLDG. ORN.	DIST (FT.)	BLDG. ORN.	DESCRIPTION
1	64.1	5-A	32.0	5-B	GATE VALVE
2	65.7	5-A	30.6	5-B	GATE VALVE
3	69.4	5-A	35.0	5-B	GATE VALVE
4	77.2	5-B	21.7	5-C	GATE VALVE
5	33.8	2-A	74.7	2-B	HYDRANT
5	36.2	2-A	75.1	2-B	VALVE
6	36.2	2-A	59.4	2-B	GATE VALVE
		UTILITY		UTILITY	
7	56.3	SMH-6	85.8	CB-4C	HYDRANT
7	54.2	SMH-6	84.9	CB-4C	VALVE
8	61.1	SMH-6	91.8	CB-4C	GATE VALVE
9	61.8	SMH-6	93.5	CB-4C	GATE VALVE

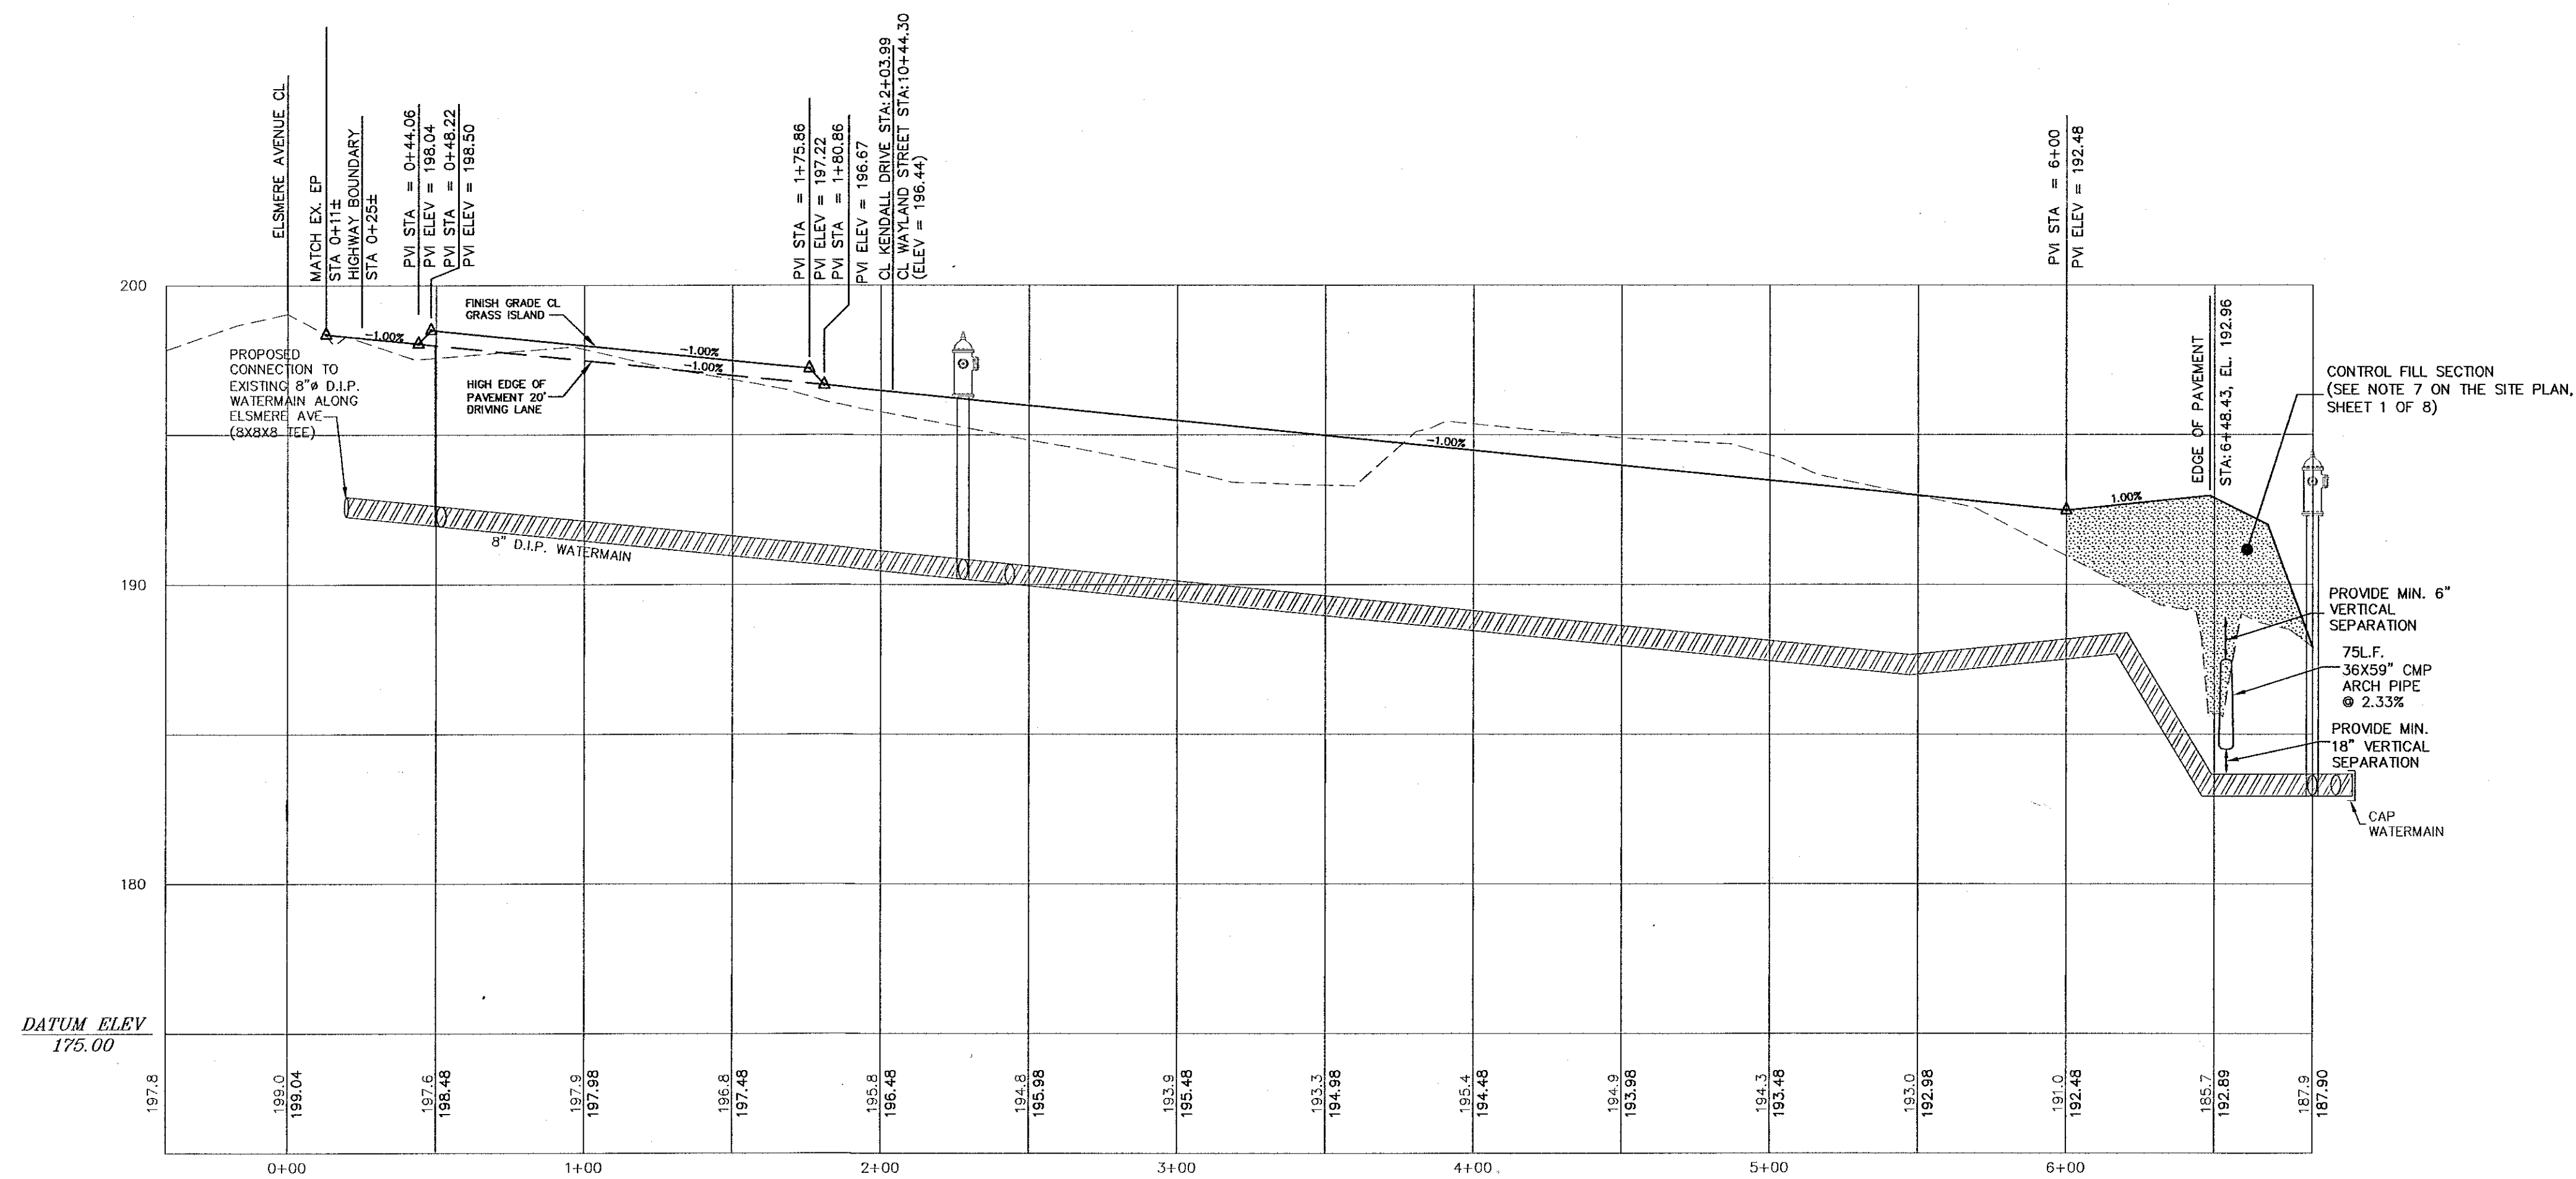

KENDALL DRIVE
SCALE: VERT. 1" = 4'
HORIZ. 1" = 40'

Sub 253

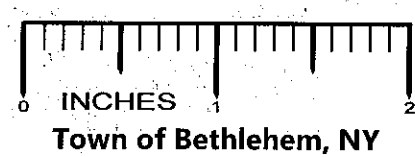


FOR INFORMATION ONLY
NOT FOR CONSTRUCTION

NO.	DATE	REVISIONS	BY

UNAUTHORIZED ALTERATION OR ADDITION TO THIS DRAWING IS A VIOLATION OF SECTION 7209 SUBDIVISION 2, OF THE NEW YORK STATE EDUCATION LAW. ONLY COPIES MADE FROM THE ORIGINAL OF THIS DRAWING BEARING AN ORIGINAL INKED OR EMBOSSED SEAL AND SIGNATURE SHALL BE CONSIDERED TO BE VALID TRUE COPIES.

© Copyright 2011 - Ingalls & Associates, LLP - All rights reserved.

GARY M. REED, PLS
N.Y.S. LIC. NO. 050557

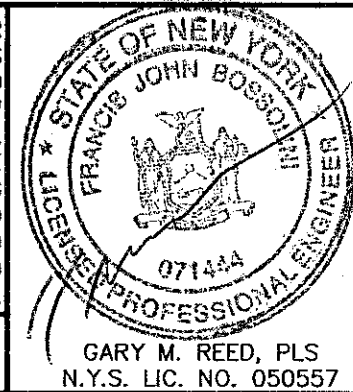

ia
ingalls & associates, LLP
engineers / surveyors
2803 CHILDERLAND AVENUE
SCHENECTADY, N.Y. 12306
PHONE: (518) 393-7725
FAX: (518) 393-2324

RECORD PLAN - PROFILE		
WATER MAIN - KENDALL DRIVE KENDALL SQUARE HAMLET		
TOWN OF BETHEHEM		
COUNTY OF ALBANY STATE OF NEW YORK		
DATE: JANUARY 3, 2011	CHECKED BY: GMR JOB NO. 08-065	SCALE: AS NOTED
DRAWN BY: RDF CADD FILE: 08-065 AS-BUILT	SHEET 1 OF 1	