

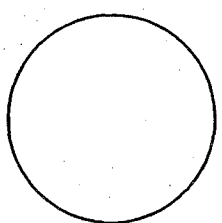



INLET DETAIL

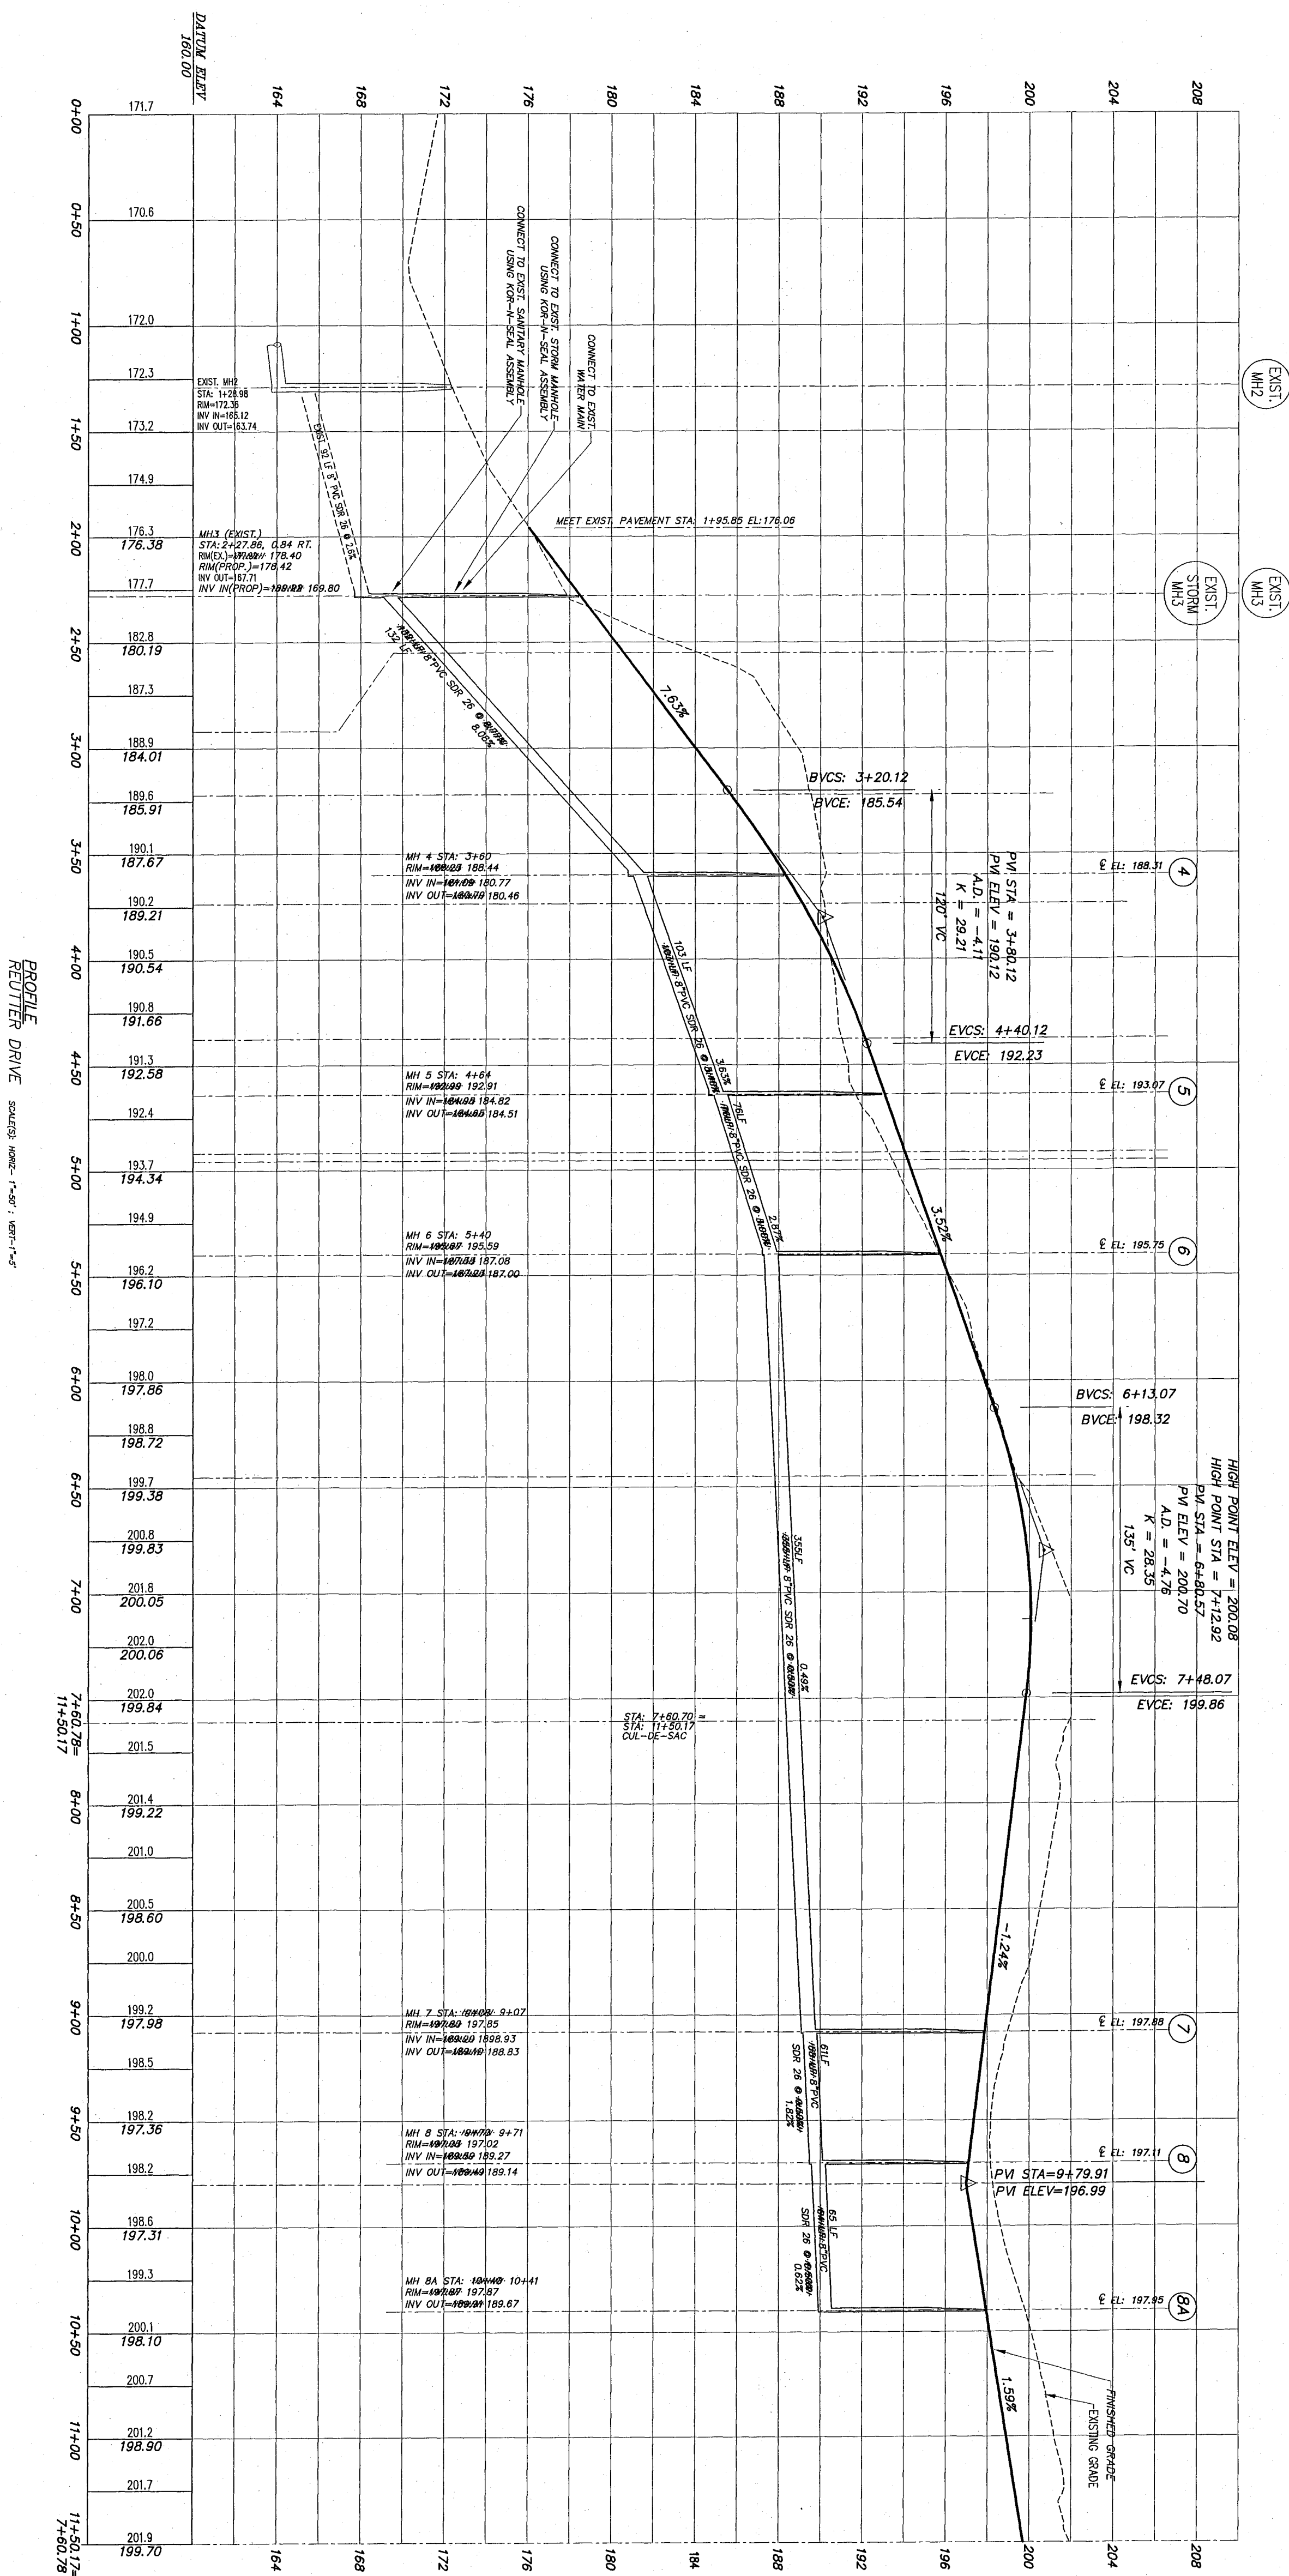


12" DIA. STEEL PIPE, 8' LONG
CONCRETE, 12" DIA. STEEL PIPE
CONCRETE (12")

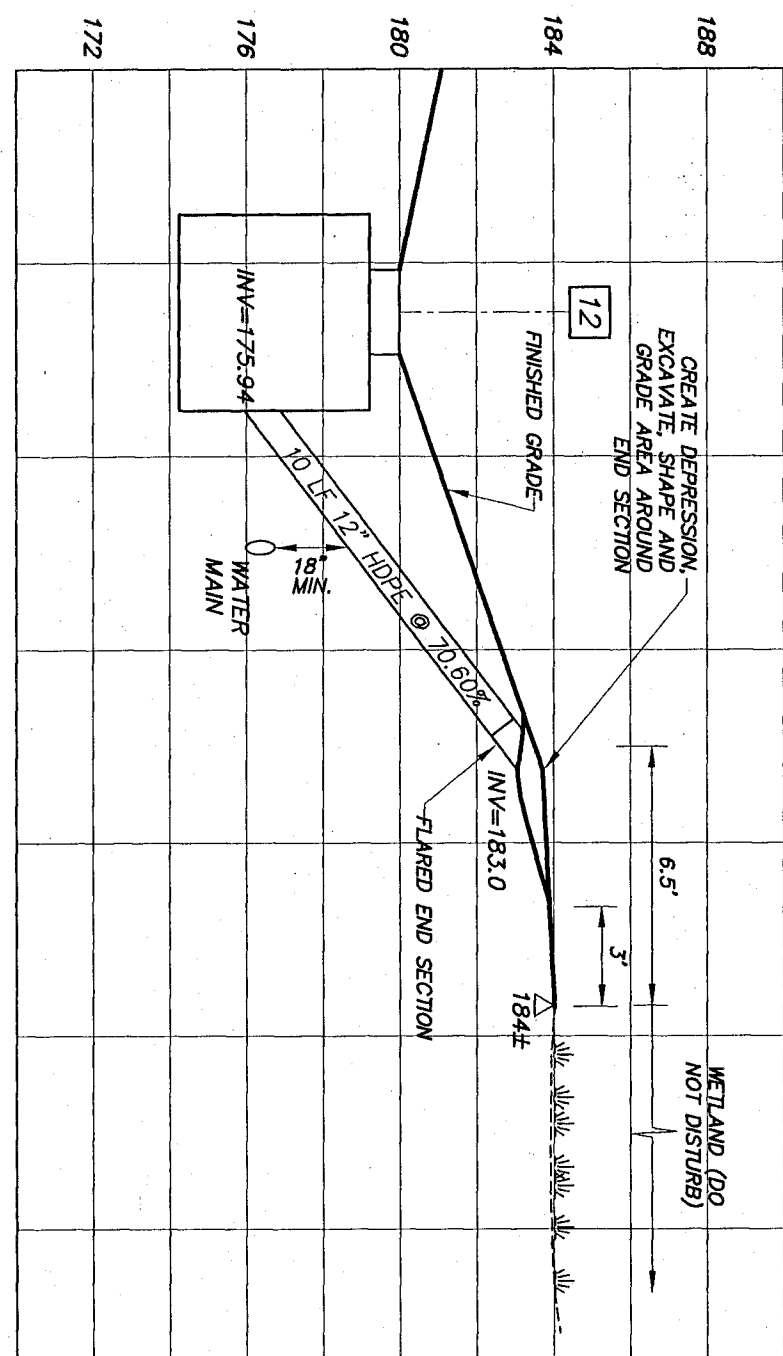

TOWN OF REUTER, NEW YORK
- OFFICE COPY -
1 INCHES = 2'

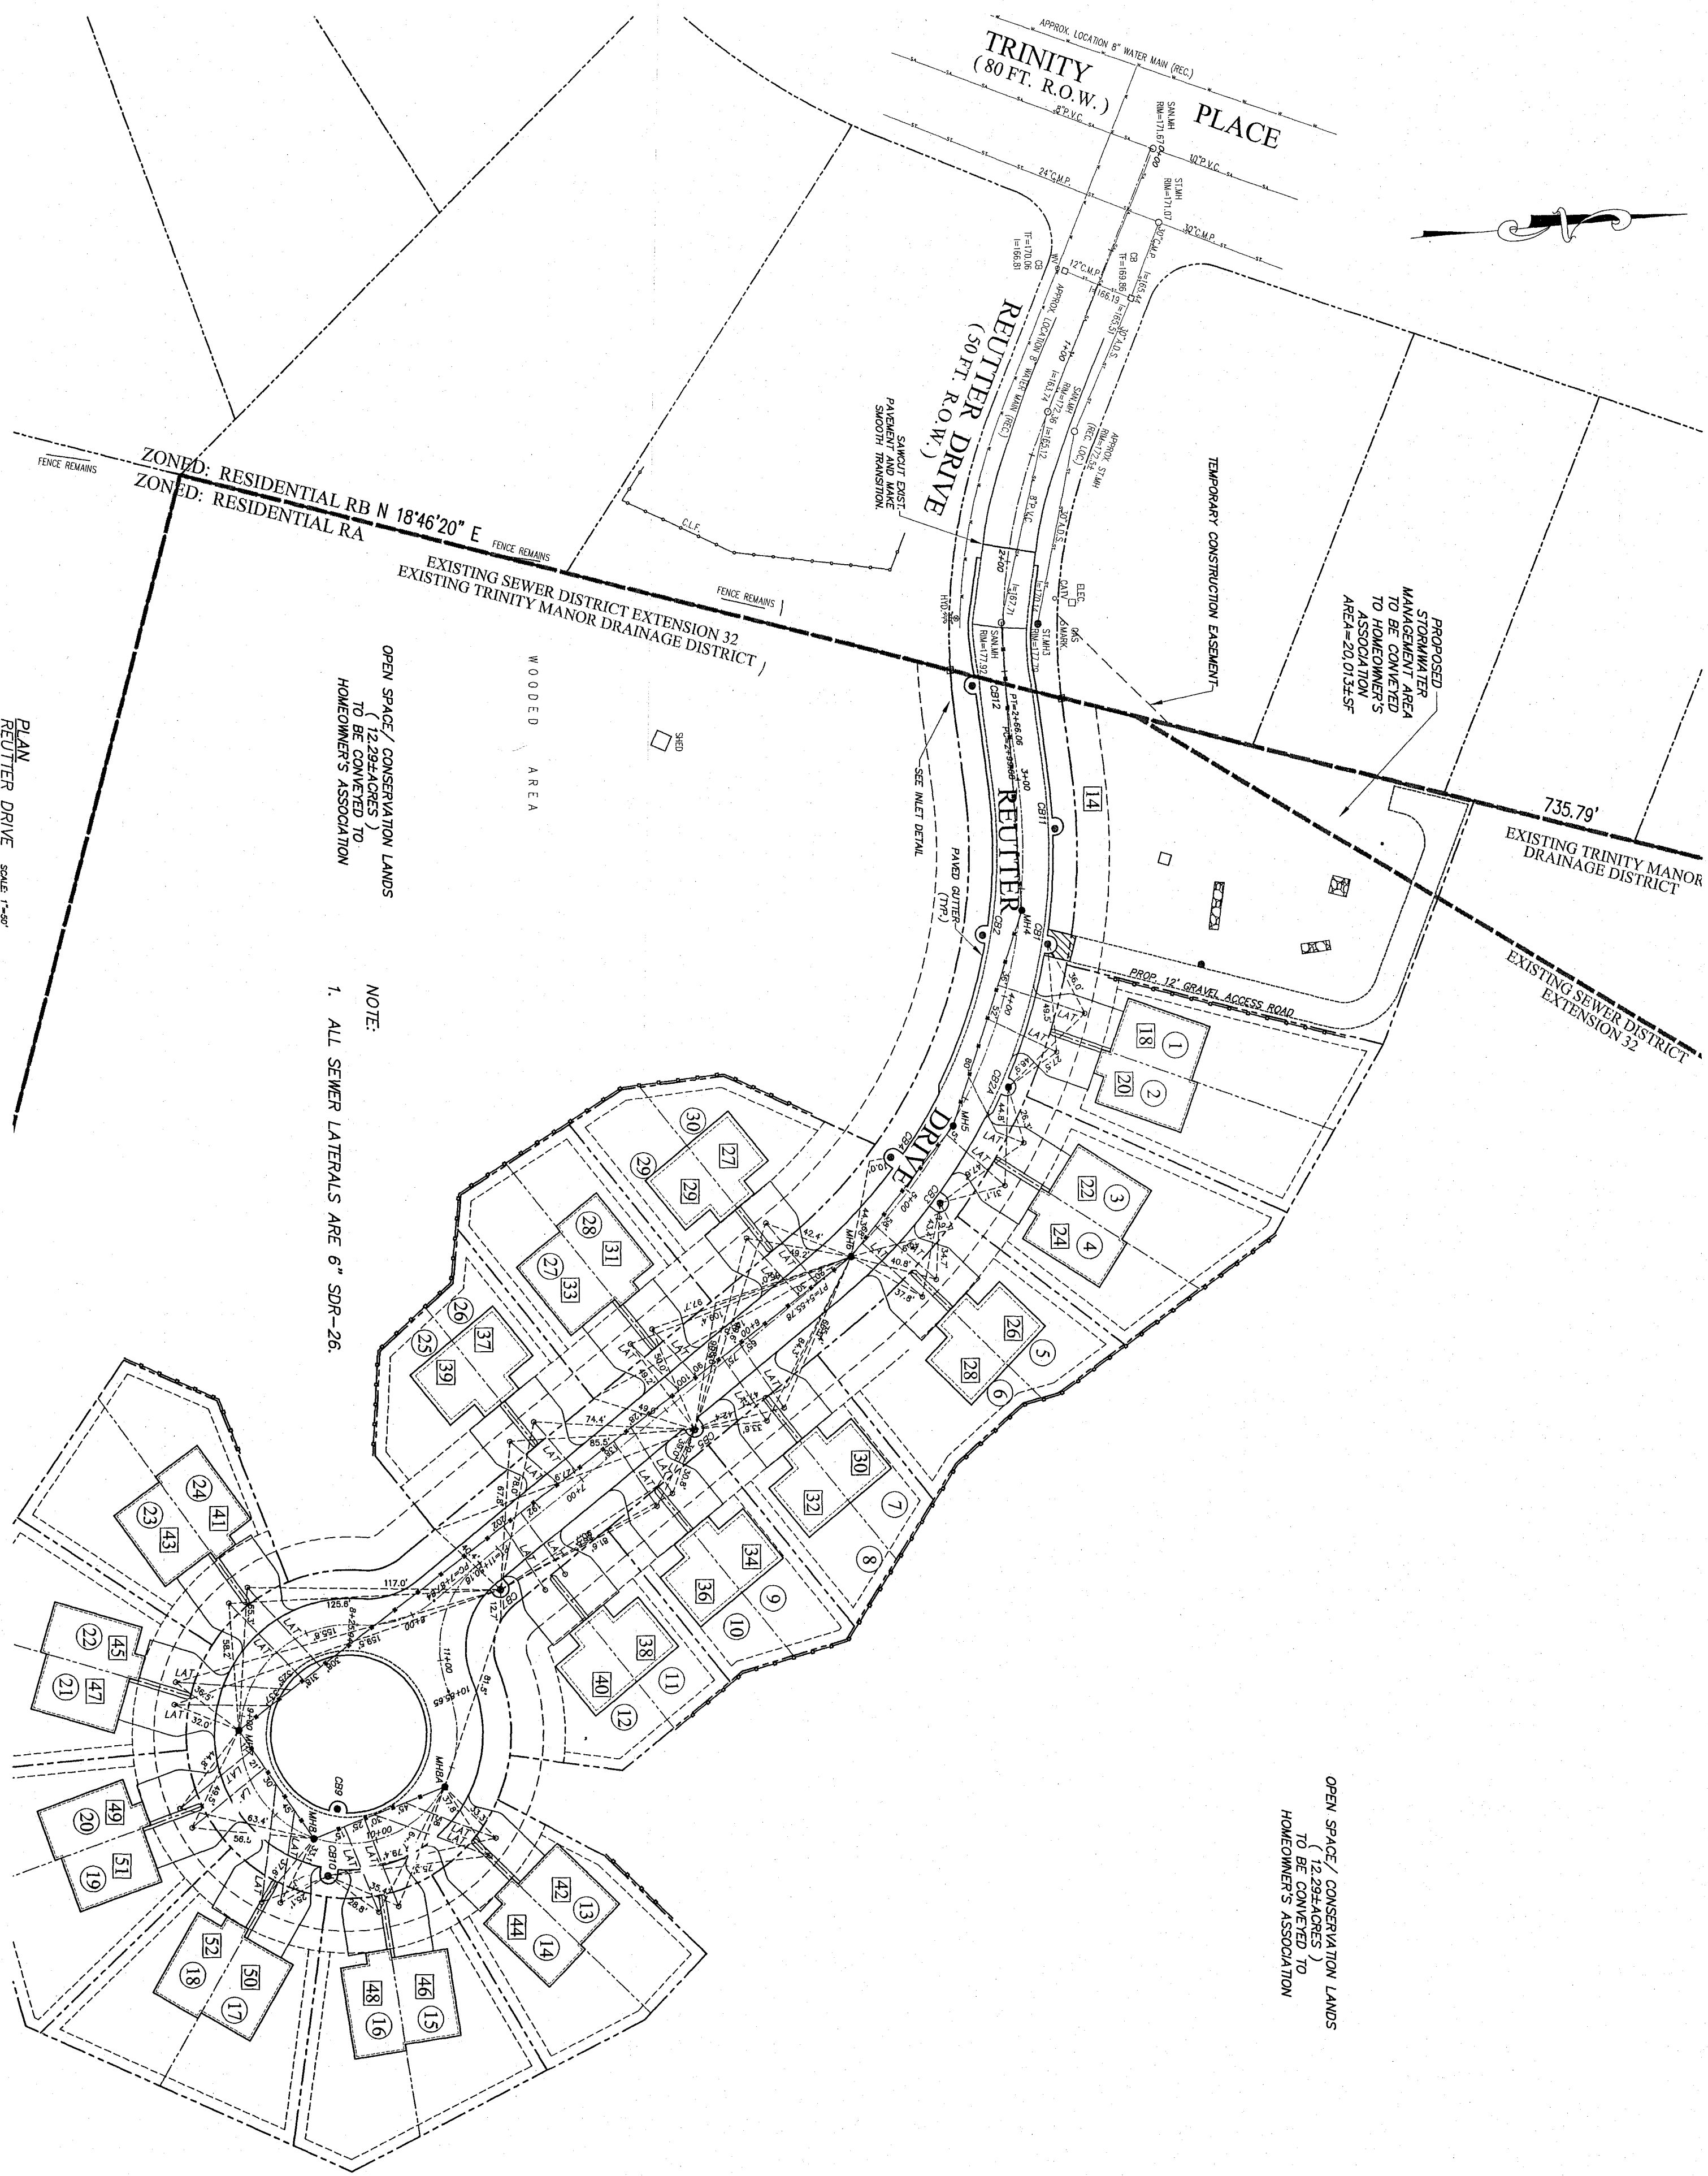


NOTES:
1. FOR WATER AND SEWER SERVICE LOCATIONS SEE
TYPICAL LOT LAYOUT.

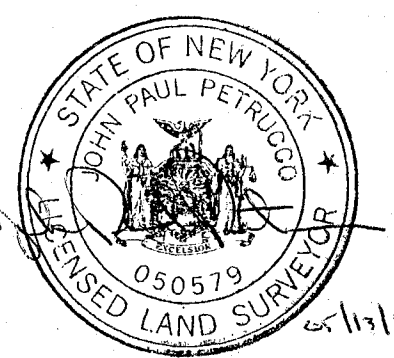

SAINTARY SEWER RECORD MAP

TRINITY MANOR SUBDIVISION
PHASE 5 - RESUBDIVISION 1
FINAL PLAT-PLAN/PROFILE REUTER DRIVE

TOWN OF ALBANY
COUNTY OF ALBANY
DATE: NOVEMBER, 2013

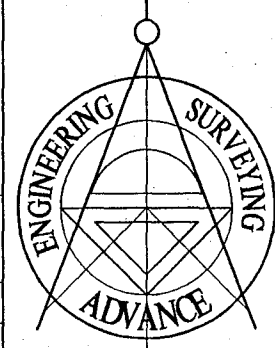

Design of:
ADVANCE ENGINEERING & SURVEYING, PLLC
CONSULTING IN -
CIVIL & ENVIRONMENTAL ENGINEERING
LAND SURVEYING & DEVELOPMENT
COMMERCIAL AND RESIDENTIAL
11 HERBERT DRIVE, LATHAM, N.Y. 12110
PHONE: (518) 698-3772

NICHOLAS COSTA, P.E.

Copyright 2013
All rights reserved.
Unauthorized duplication is a
violation of copyright laws.
It is a violation of the Engineer,
Law of the State of New York, for
any person, other than a duly
licensed Professional Engineer,
to use this document in any way.

NO.	REVISION	BY	APPD.	DATE
A	ISSUED FOR REVIEW	JPP	NC	12/18/13
B	REVISED PER TOWN COMMENTS DATED 2/11/14	JPP	NC	3/12/14
C	REVISED PER TOWN COMMENTS DATED 5/8/14	JPP	NC	5/26/14
D	REVISED PER TOWN COMMENTS DATED 6/13/14	JPP	NC	7/26/14

NO.	REVISION	BY	APPD.	DATE

PROF
SHEET NO.
5 OF 8