

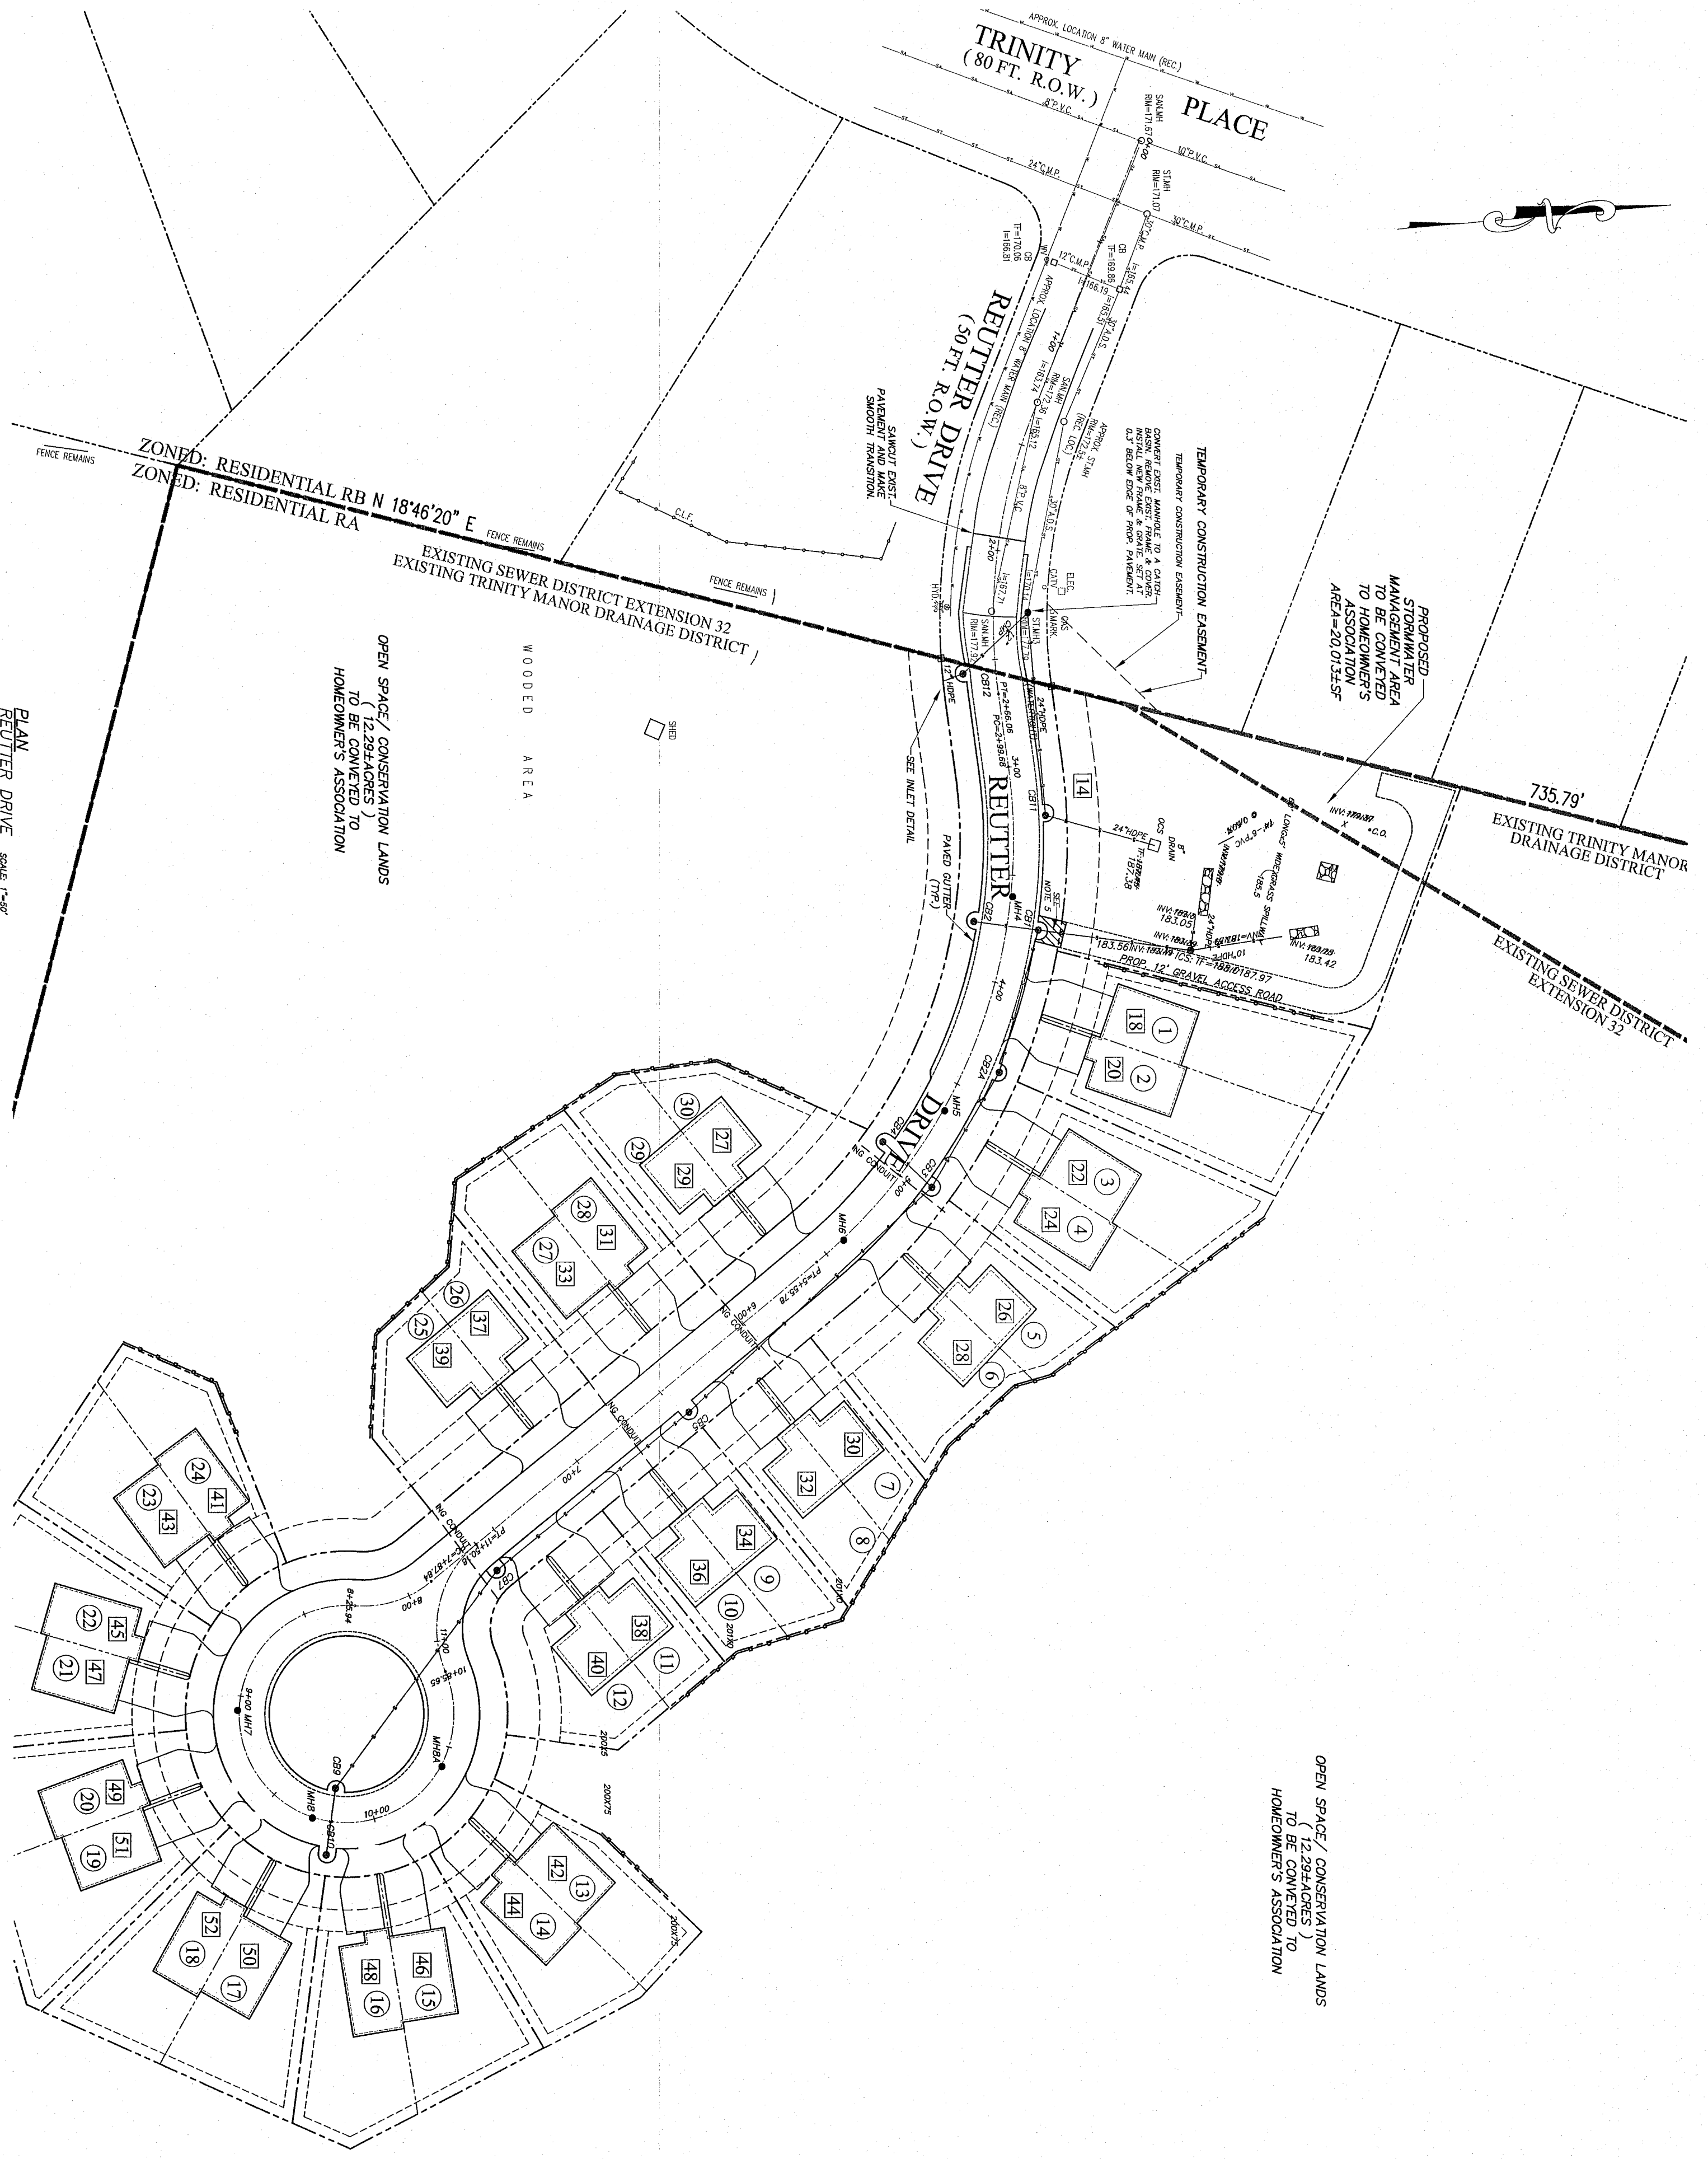


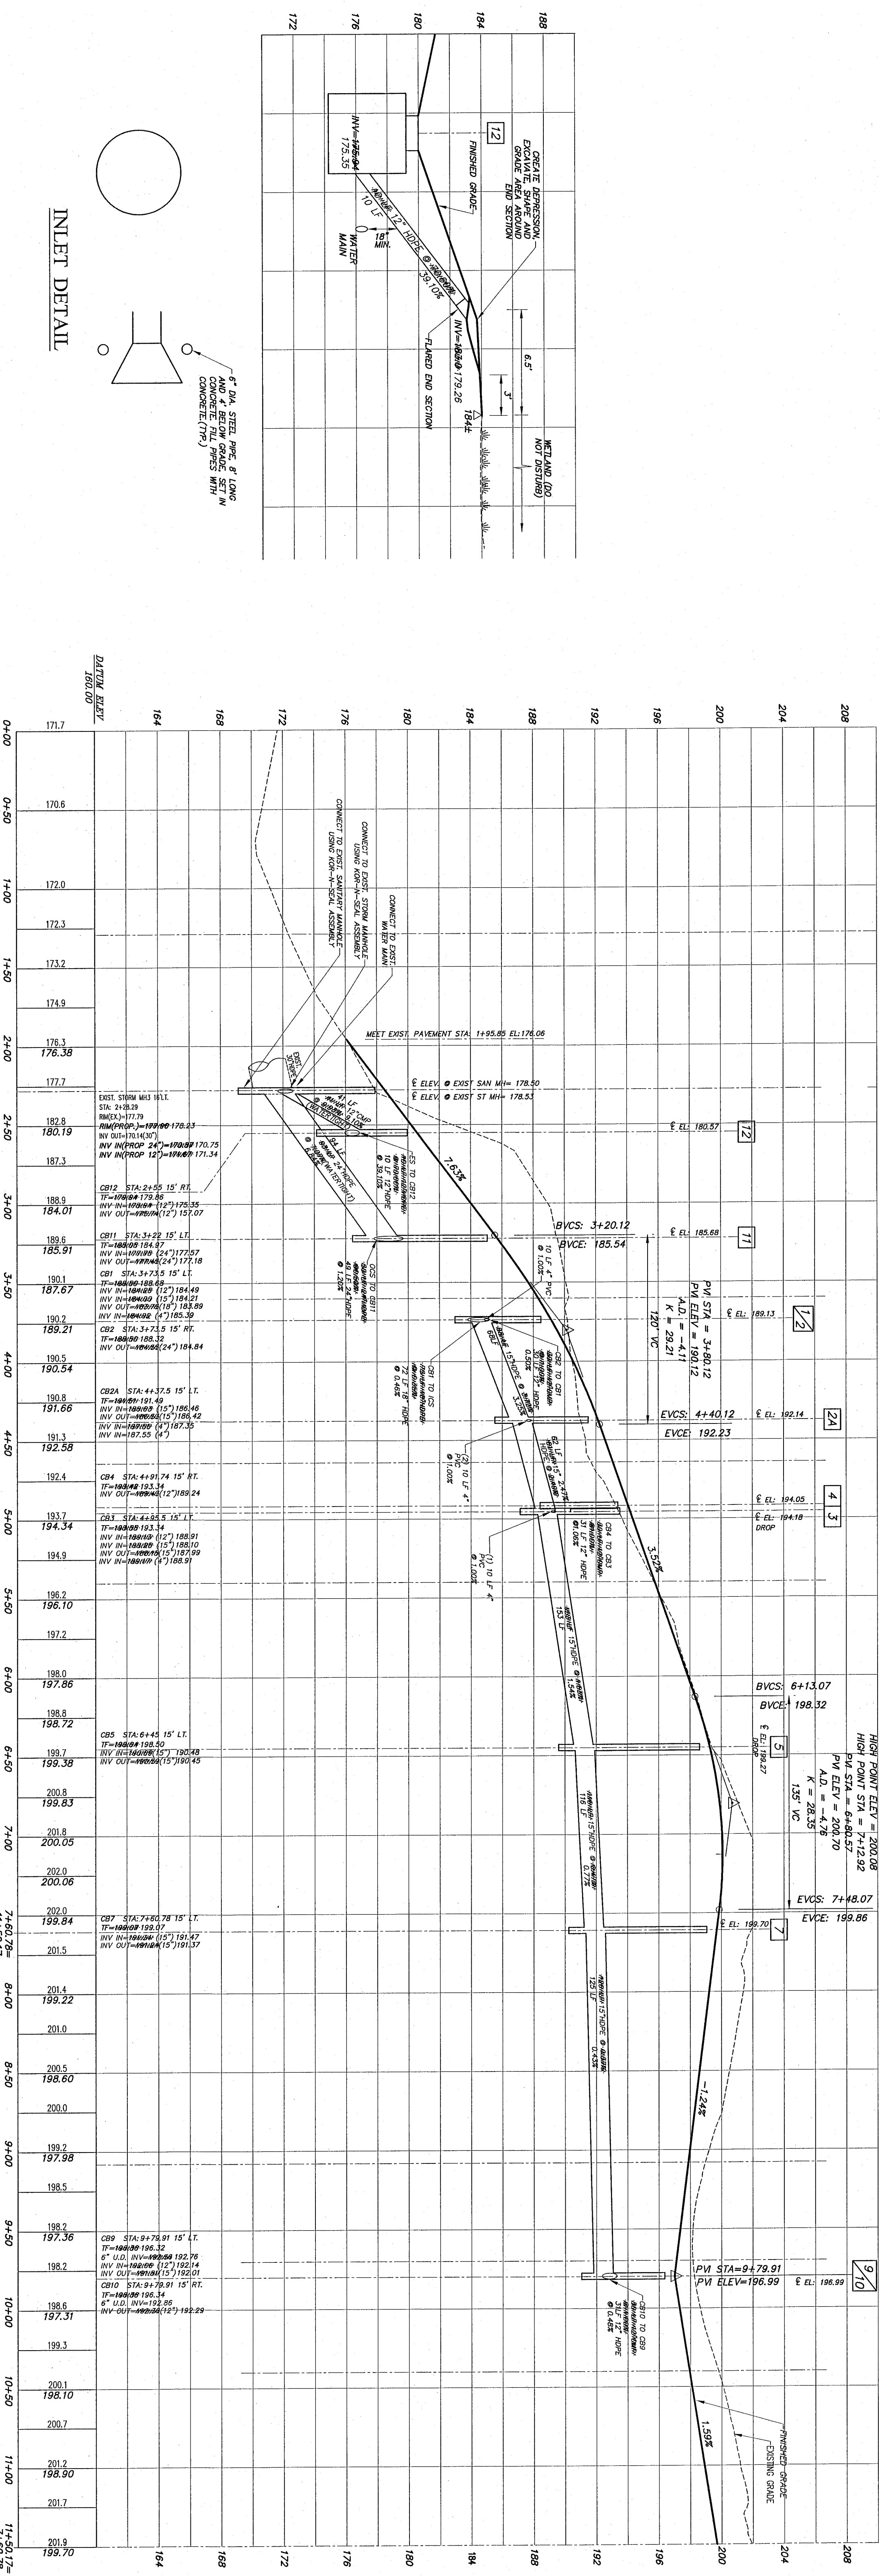

NOTES:
1. FOR WATER AND SEWER SERVICE LOCATIONS SEE TYPICAL LOT LAYOUT.

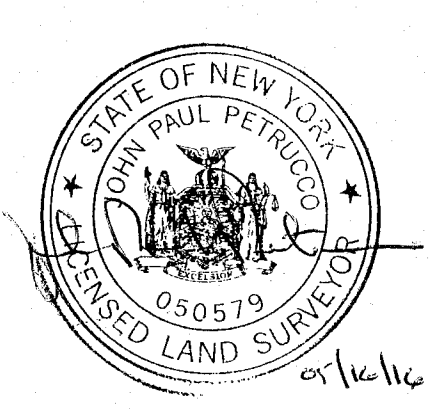


STORM SEWER RECORD MAP

PROF
SHEET NO. 5 OF 8

TRINITY MANOR SUBDIVISION
PHASE 5 - RESUBDIVISION 1
FINAL PLAT-PLAN/PROFILE REUTTER DRIVE

TOWN OF BETHLEHEM
COUNTY OF ALBANY
DATE: NOVEMBER, 2013
SCALE: AS SHOWN
SHEET 5 OF 8

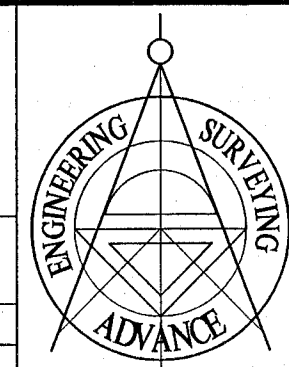

Design of:
ADVANCE ENGINEERING & SURVEYING, PLLC
CONSULTING IN -
CIVIL & ENVIRONMENTAL ENGINEERING
LAND SURVEYING & DEVELOPMENT
COMMERCIAL AND RESIDENTIAL
11 HERBERT DRIVE, LATHAM, N.Y. 12110
PHONE: (518) 698-3772

COPYRIGHT 2013
ADVANCE ENGINEERING & SURVEYING, PLLC
ALL RIGHTS RESERVED
UNAUTHORIZED REPRODUCTION IS A
VIOLATION OF APPLICABLE LAWS.
It is a violation of the Education
Law of the State of New York, for
any person, unless he is acting
under the direction of a Licensed
Professional Engineer, to alter this
document in any way.

NO.	REVISION	BY	APPD.	DATE
A	ISSUED FOR REVIEW	JPP	NC	12/16/13
B	REVISED PER TOWN COMMENTS DATED 2/11/14	JPP	NC	3/12/14
C	REVISED PER TOWN COMMENTS DATED 5/6/14	JPP	NC	5/24/14
D	REVISED PER TOWN COMMENTS DATED 6/13/14	JPP	NC	7/24/14

NO.	REVISION	BY	APPD.	DATE