
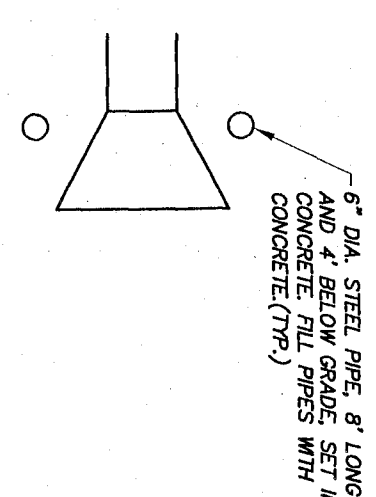


PROF  
5 OF 8

|                      |                   |
|----------------------|-------------------|
| TOWN OF BETHLEHEM    |                   |
| COUNTY OF ALBANY     | STATE OF NEW YORK |
| DATE: NOVEMBER, 2013 | SCALE: AS SHOWN   |
|                      | SHEET 5 OF 5      |

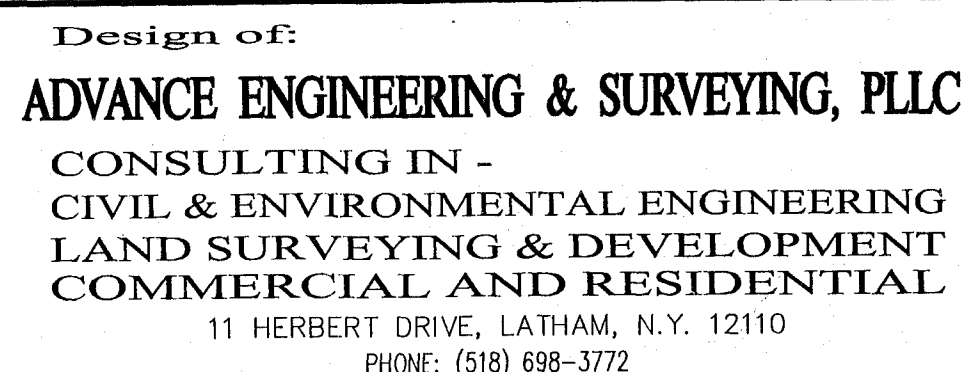

It is a violation of the Education Law of the State of New York, for any person, unless he is acting under the direction of a Licensed Professional Engineer, to offer this document in any way.

[illegible]