



IF THIS SHEET IS NOT 24"x36" IT IS A REDUCED PRINT -SCALE ACCORDINGLY

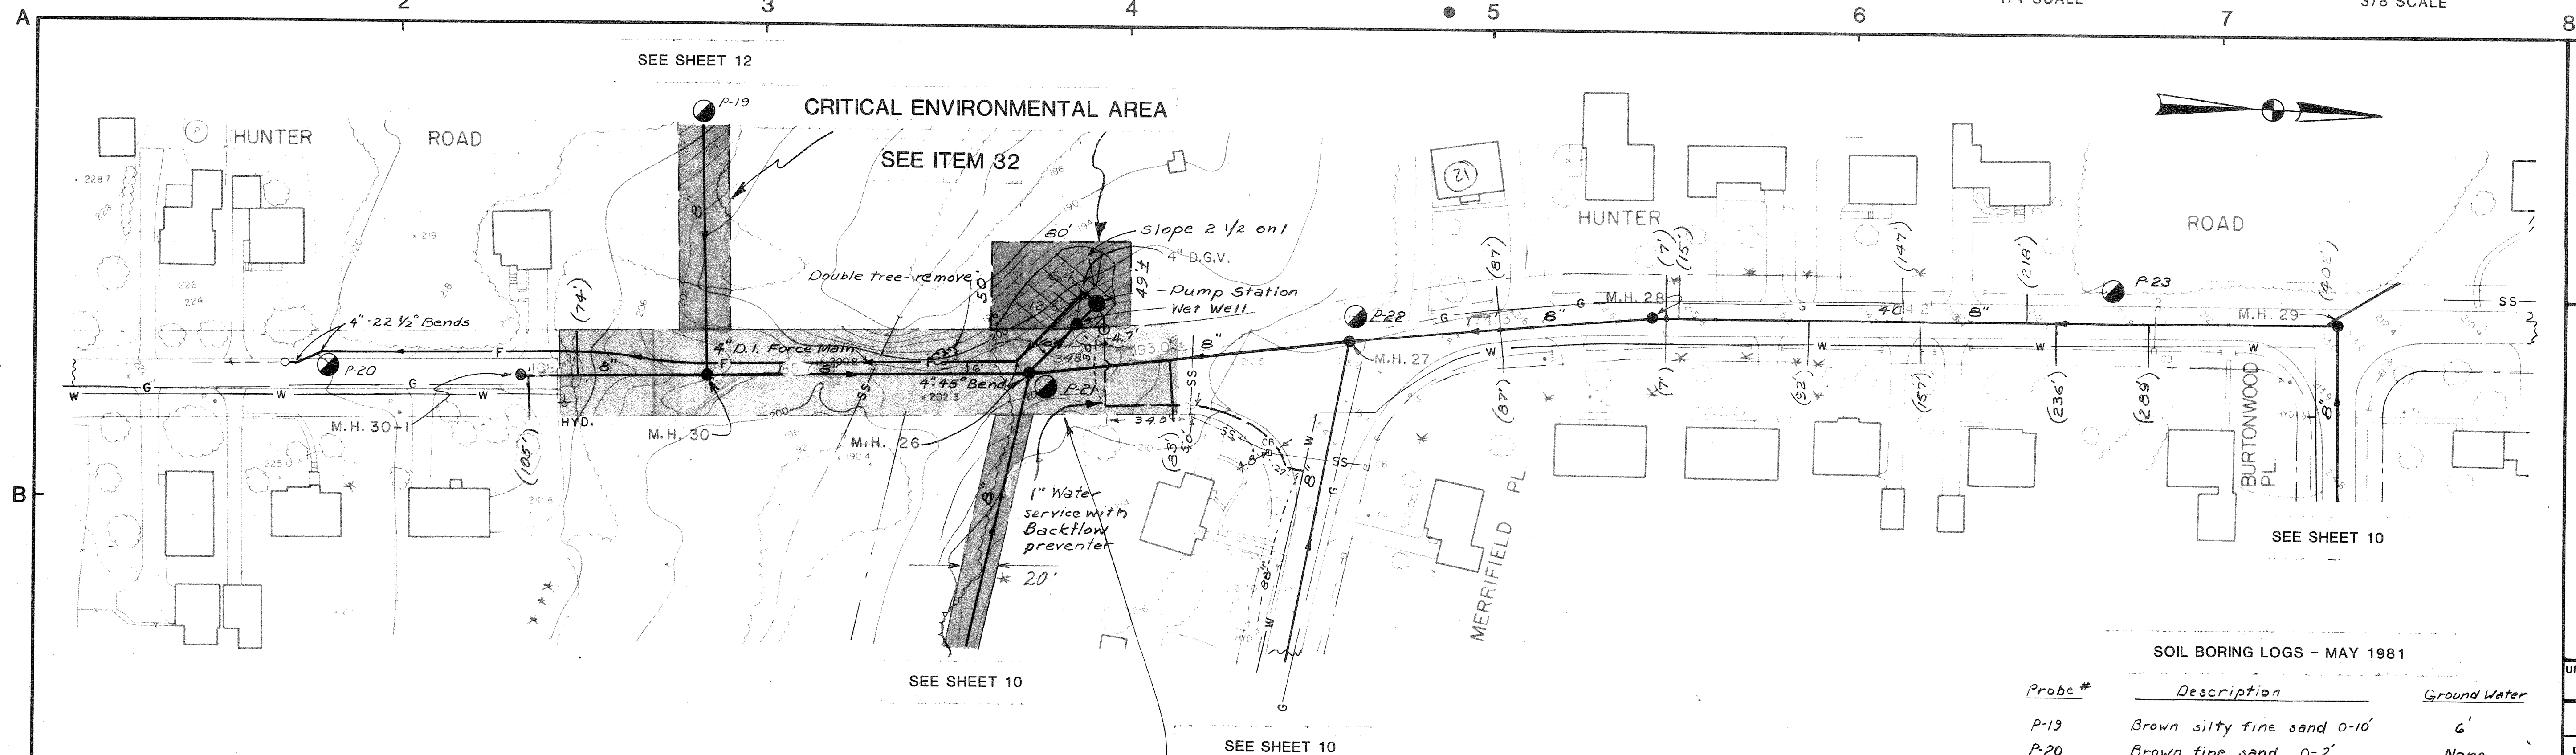


Note: For profile from Wet Well to M.H. 26 see Sheet 10.

SOIL BORING LOGS - MAY 1981

Probe #	Description	Ground Water
P-13	Brown silty fine sand 0-10'	6'
P-20	Brown fine sand 0-2' Brown silty clay 2'-10'	None
P-21	Brown fine sand 0-4' Brown silty clay 4'-10'	None
P-22	Gravel fill 0-4' Brown silty clay 4'-12'	None
P-23	Brown fine sand 0-2' Brown silty clay 2'-12'	None

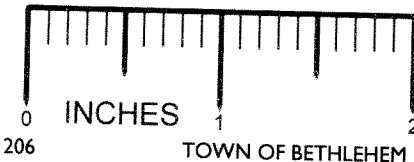

RECORD PLAN

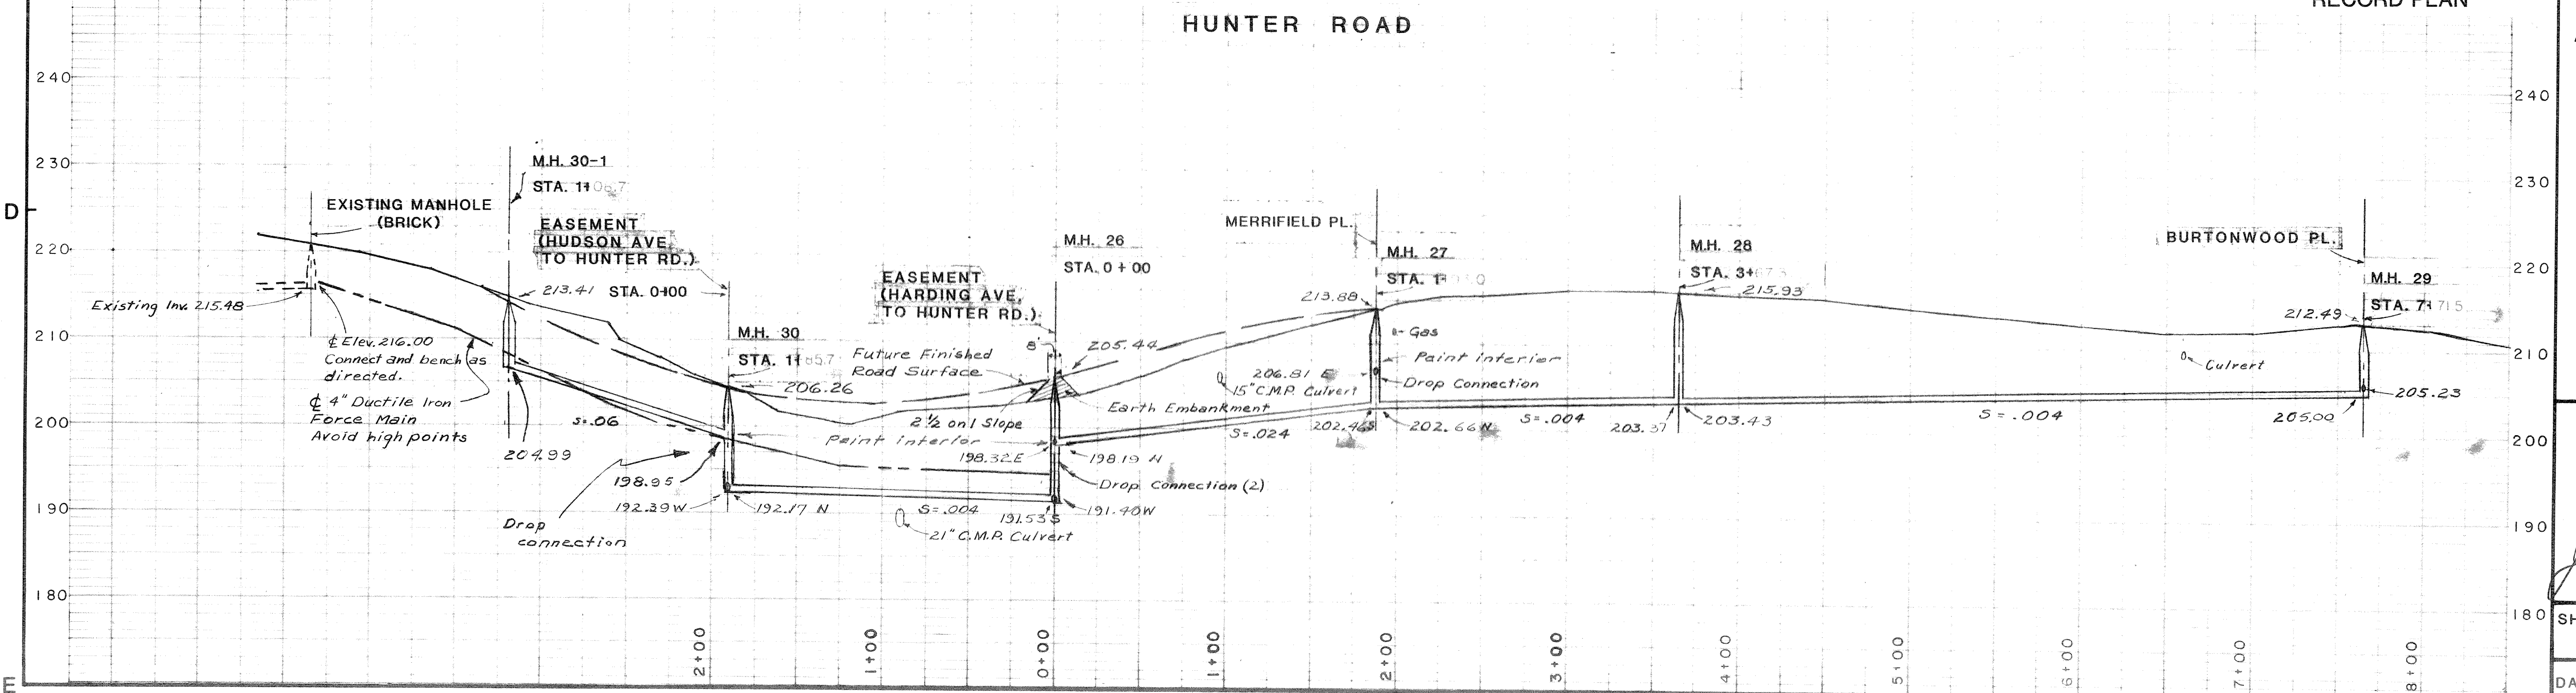

KEY PLAN

NOTES

UNAUTHORIZED ALTERATIONS OR ADDITIONS TO THIS DOCUMENT IS A VIOLATION OF SECTION 7209 SUBDIVISION 2 OF THE NEW YORK STATE EDUCATION LAW

REVISIONS

DATE	BY	DESCRIPTION	SYMBOL
11/83	E.O.	R.P.	

J. KENNETH FRASER
AND ASSOCIATES, P.C.


CONSULTING ENGINEERS
RENSSELAER, NEW YORK

BETHLEHEM
SEWER DISTRICT
TOWN OF BETHLEHEM
ALBANY COUNTY NEW YORK

USEPA-NYSDEC PROJECT C-36-1096

CONTRACT NO. 2
COLLECTING
SEWERS

SCALE: HORIZONTAL 1" = 50'
VERTICAL 1" = 10'

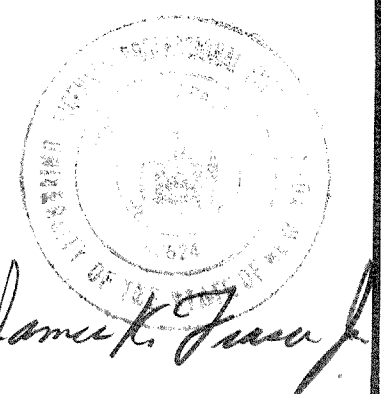

PROJ. ENG'R: W.T.B.
DRAWN BY: K.N.S.
TRACED BY: K.N.S.
CHECKED BY: W.T.B.
REF. No. 5106

SHEET TITLE: HUNTER RD.

DATE: JUNE 1981 SHEET 9 OF 32