

Section 6
Drawings

TOWN OF BETHLEHEM NEW SCOTLAND ROAD PUMP STATION

FILENAME	SH	DWGDESC2
140935-SCOTLAND-SCH-00	0	INDEX SHEET
140935-SCOTLAND-SCH-01	1	480 POWER DISTRIBUTION
140935-SCOTLAND-SCH-02	2	120 VAC & 24VDC POWER DISTRIBUTION
140935-SCOTLAND-SCH-03	3	VFD CONTROL WIRING
140935-SCOTLAND-SCH-04	4	SOFT START CONTROL
140935-SCOTLAND-SCH-05	5	PUMP CONTROL WIRING
140935-SCOTLAND-SCH-06	6	APP721 CONTROL WIRING
140935-SCOTLAND-SCH-07	7	ANALOG OUTPUT
140935-SCOTLAND-SCH-08	8	FLOAT BACKUP AND ALARM OUTPUTS
140935-SCOTLAND-SCH-09	9	SPARE
140935-SCOTLAND-SCH-10	10-14	ENCLOSURE LAYOUT

TAGS	QTY	CATALOG	DESC
FU-131	1	ATQR20	CLASS CC FUSE CARTRIDGE, 13/32"x1-1/2", TIME DELAY, 20 A
FU-222 FU-224 FU-226 FU-228 FU-258 FU-260	6	GDL1	G FUSE, U.S. SIZE 6.3x32mm, 1 A, 250V AC, TIME DELAY, GLASS TUBE
FU-256	1	GDL5	G FUSE, U.S. SIZE 6.3x32mm, 5 A, 250V AC, TIME DELAY, GLASS TUBE

VSGENVIROMATION
A ZELLER COMPANY

TOWN OF BETHLEHEM

JOB No. 140935 SERIAL No. 140935-0002


CONTROL CABINET	DUPLX PUMP CONTROL PANEL
POWER FEED	480VAC, 3PH & 120VAC, 1PH, 60Hz
DISCONNECT SW.	N/A
FULL LOAD AMPS	83 AMPS
LARGEST MOTOR FLA	40 AMPS
CONTROL VOLTAGE	120VAC / 24VDC
CONTROL XFMR.	N/A
INTERRUPTING CAPACITY	100 K.A.I.C.

PHONE 585-244-0450 FAX 585-254-4115

- NOTES:
- 230 OR 460 VAC POWER WIRING IS:
TYPE "MTW"; WIRE SIZE AS SHOWN ON THE SCHEMATIC.
PHASE-A - BLACK
PHASE-B - BLACK
PHASE-C - BLACK
 - AC CONTROL WIRING IS 16 AWG MINIMUM, TYPE "MTW", COLORS AS FOLLOWS:
120 VAC POWER - RED
120 VAC NEUTRAL - WHITE
FOREIGN VOLTAGES - ORANGE
GROUND - GREEN or GREEN/YELLOW
 - DC CONTROL WIRING IS 16 AWG MINIMUM, TYPE "MTW", COLORS AS FOLLOWS:
DC CONTROL HOT - BLUE
DC CONTROL COMMON - BLUE/WHITE
 - ANALOG SIGNAL WIRING IS SHIELDED TWISTED PAIR, 20 AWG MINIMUM.
 - POWER WIRING FOR DC DRIVES IS 14 AWG MINIMUM, TYPE "MTW"
DC MOTOR ARMATURE - BROWN
DC MOTOR FIELD - PURPLE
 - THIN LINES DENOTE PANEL WIRING
 - DOTTED LINES DENOTE FIELD WIRING
 - ⊗ TB3 DENOTES CONTROL PANEL TERMINAL AND TERMINAL STRIP NUMBER
 - TB4 DENOTES FIELD TERMINAL AND TERMINAL STRIP NUMBER
 - * DENOTES EXISTING FIELD DEVICE
 - PANEL DEVICE IDENTIFICATION NAMETAGS ARE ADHESIVE BACKED BRADY LABELS, WHITE LABELS WITH BLACK LETTERING.
 - ENGRAVED LAMICOID NAMETAGS ARE ADHESIVE BACKED, WHITE LABELS WITH BLACK LETTERING.
 - LINE REFERENCING:
THREE DIGIT
1st DIGIT - SHEET NUMBER
2nd & 3rd DIGITS - LINE REFERENCE
EXAMPLE - 150, SHEET 1, LINE 50

FOUR DIGIT
1st & 2nd DIGITS - SHEET NUMBER
3rd & 4th DIGITS - LINE REFERENCE
EXAMPLE - 2150, SHEET 21, LINE 50

ELECTRICAL SYMBOLS

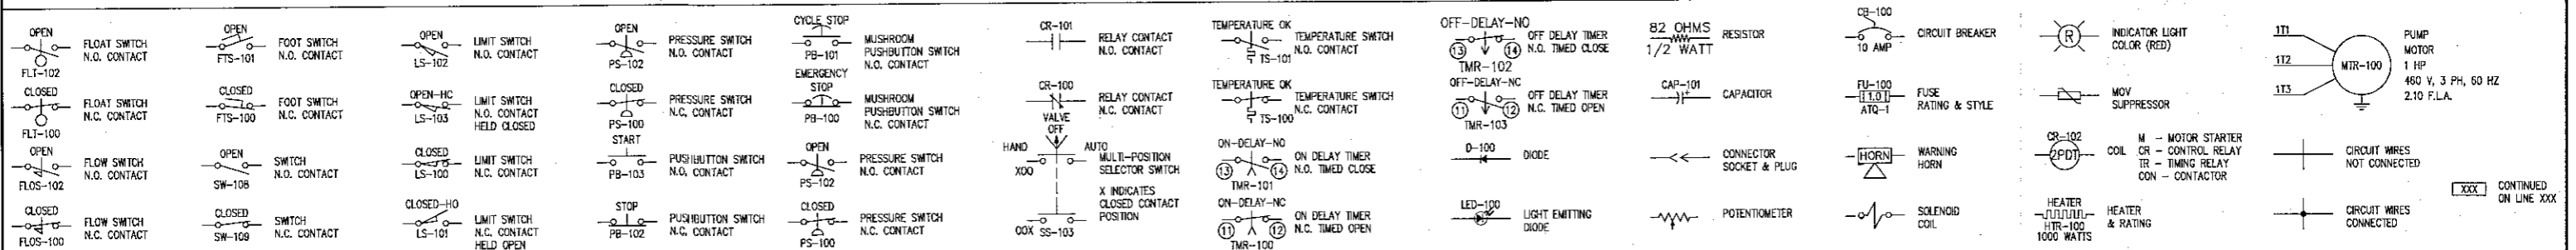

D	FIELD MODIFICATIONS	ECN-140935-0005	08-07-15
C	RECORD DRAWINGS	ECN-140935-0004	01-27-15
B	AS BUILT	ECN-140935-0003	10-23-14
A	ORIGINAL ISSUE	ECN-140935-0001	07-14-14
REV:	DESCRIPTION:	DOC. CONTROL No:	DATE:
DESIGNED ON: AUTOCAD ELECTRICAL 2012		DWG LAST SAVED ON: 08-07-2015 11:13a	


THIS DRAWING OR ANY REPRODUCTION OF IT SHALL NOT BE USED FOR MANUFACTURE, PRODUCTION, OR PROCUREMENT WITHOUT THE EXPRESS WRITTEN PERMISSION OF VSGENVIROMATION, INC. USE OR REPRODUCTION FOR USE, IN A MANNER ASSOCIATED WITH GOODS OR SERVICES FURNISHED BY VSGENVIROMATION, INC. IS APPROVED.

VSGENVIROMATION
A ZELLER COMPANY

1000 UNIVERSITY AVENUE
SUITE 800
ROCHESTER, NY 14607
TEL.: 585-244-0450
FAX: 585-254-0982


CUSTOMER: FLYGT, A XYLEM BRAND
STREET: 600 MILE CROSSING BLVD, SUITE 3
CITY / STATE: ROCHESTER NY 14624
TOWN OF BETHLEHEM
NEW SCOTLAND ROAD PUMP STATION
DUPLX PUMP CONTROL PANEL
INDEX SHEET

DRAWN BY: RJY	DRAWN DATE: 07-14-14	MODEL-PART NUMBER: UL 698A LISTED CABINET
CHECKED BY: DL	CHECKED DATE: 07-30-14	DRAWING NUMBER: 140935-SCOTLAND-SCH
FILE REFERENCE: 140935-SCOTLAND-SCH-000	PAGES: 0 OF 14	SCALE: PAGE: REVISION: N/A 0 D

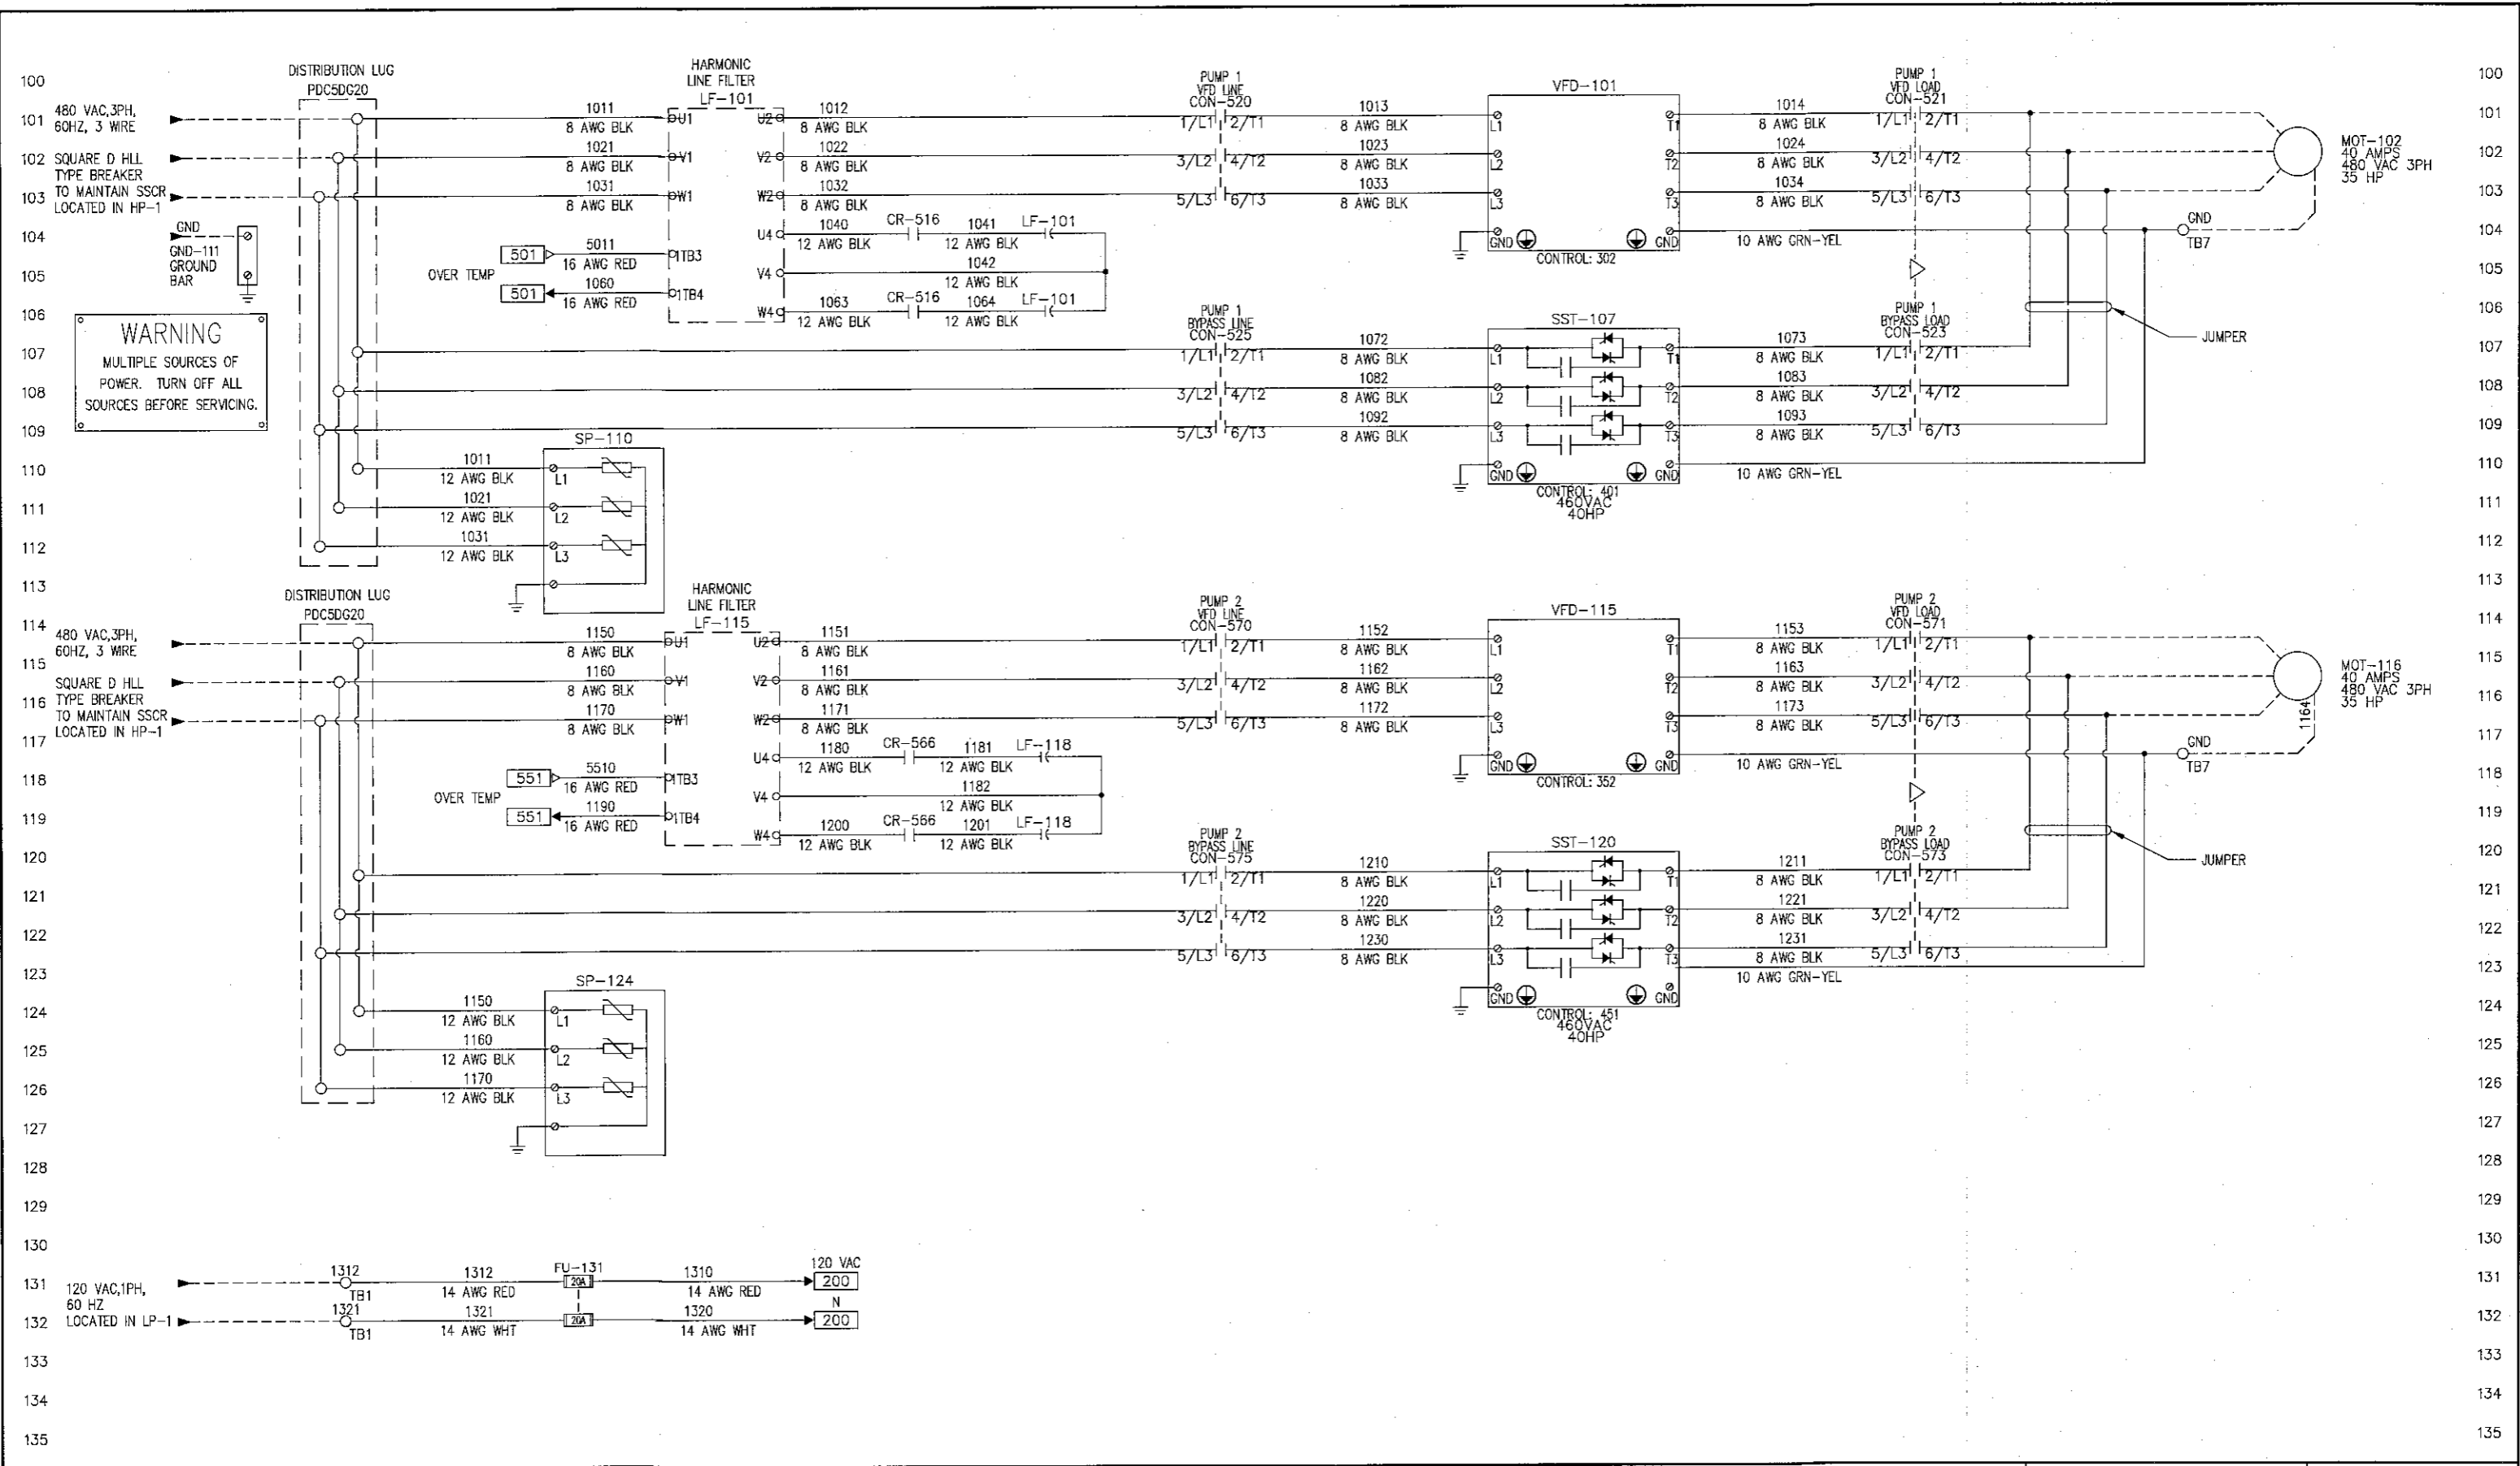

D	FIELD MODIFICATIONS	ECN-140935-0005	08-07-15
C	RECORD DRAWINGS	ECN-140935-0004	01-27-15
B	AS BUILT	ECN-140935-0003	10-23-14
A	ORIGINAL ISSUE	ECN-140935-0001	07-14-14
REV#	DESCRIPTION:	DOC. CONTROL No:	DATE:
	DESIGNED ON: AUTOCAD ELECTRICAL 2012	DWG LAST SAVED ON: 08-07-2015	11:13a



THIS DRAWING OR ANY REPRODUCTION OF IT SHALL NOT BE USED FOR MANUFACTURE, PRODUCTION, OR PROCUREMENT WITHOUT THE EXPRESS WRITTEN PERMISSION OF VSGENVIROMATION, INC. USE OR REPRODUCTION FOR USE, IN A MANNER ASSOCIATED WITH GOODS OR SERVICES FURNISHED BY VSGENVIROMATION, INC. IS APPROVED.


VSGENVIROMATION
 A ZELLER COMPANY

1000 UNIVERSITY AVENUE
SUITE 800
ROCHESTER, NY 14607
TEL.: 585-244-0450
FAX: 585-254-0982


CUSTOMER: FLYGT, A XYLEM BRAND
STREET: 600 MILE CROSSING BLVD, SUITE 3
CITY / STATE: ROCHESTER NY 14624
TOWN OF BETHLEHEM
NEW SCOTLAND ROAD PUMP STATION
DUPLIX PUMP CONTROL PANEL
480 POWER DISTRIBUTION

DRAWN BY:	RJY	DRAWN DATE:	07-14-14	MODEL-PART NUMBER:	UL 698A LISTED CABINET
CHECKED BY:	DL	CHECKED DATE:	07-30-14	DRAWING NUMBER:	140935-SCOTLAND-SCH
FILE REFERENCE:	140935-SCOTLAND-SCH-01D	SCALE:	N/A	PAGE:	1
SERIAL/PROJECT NUMBER:	140935-0002	PAGES:	1 OF 14	REVISION:	D

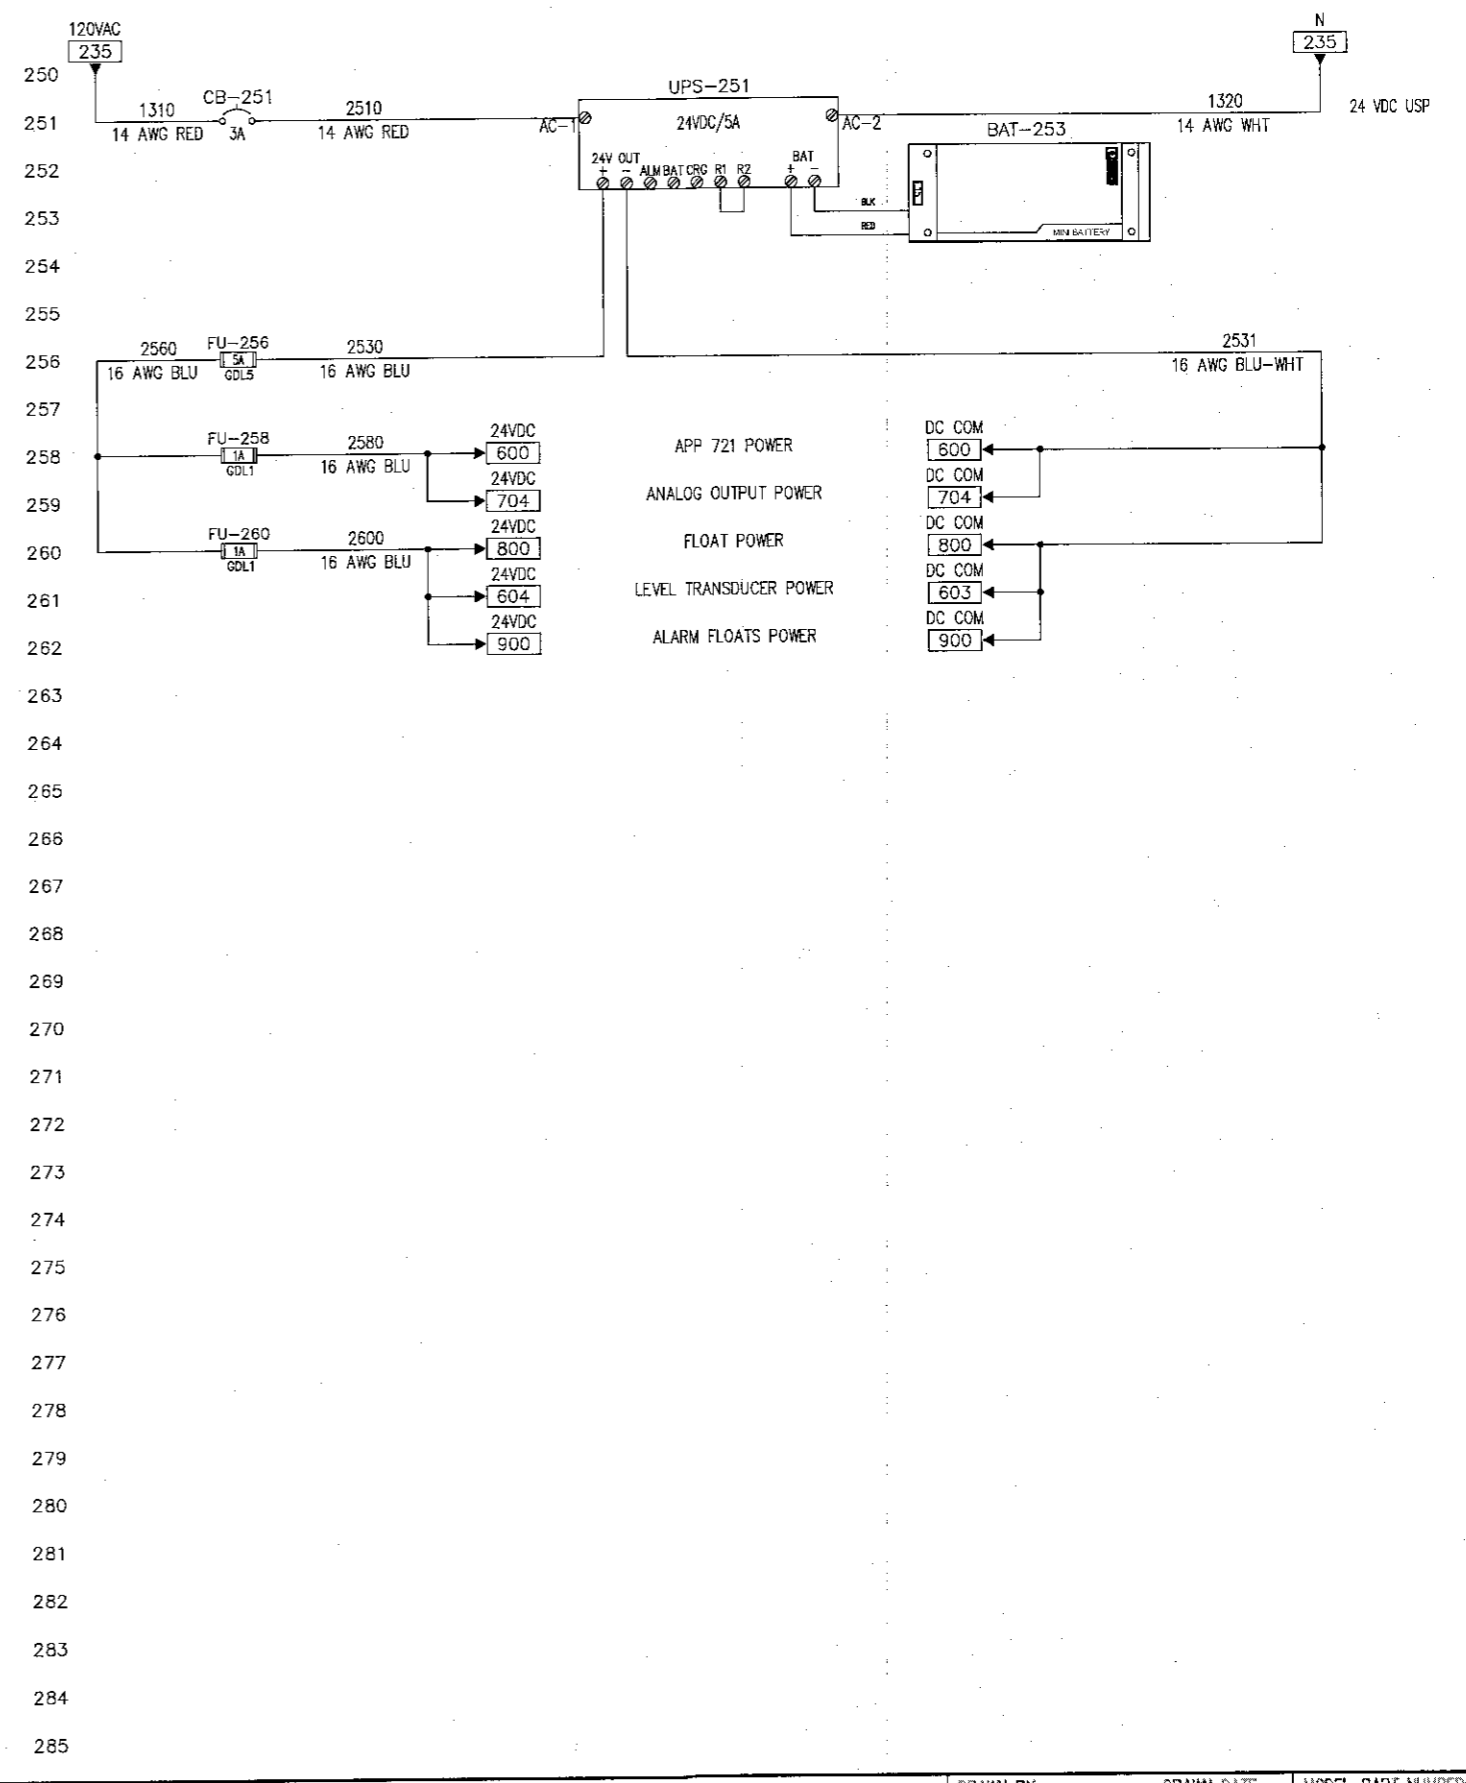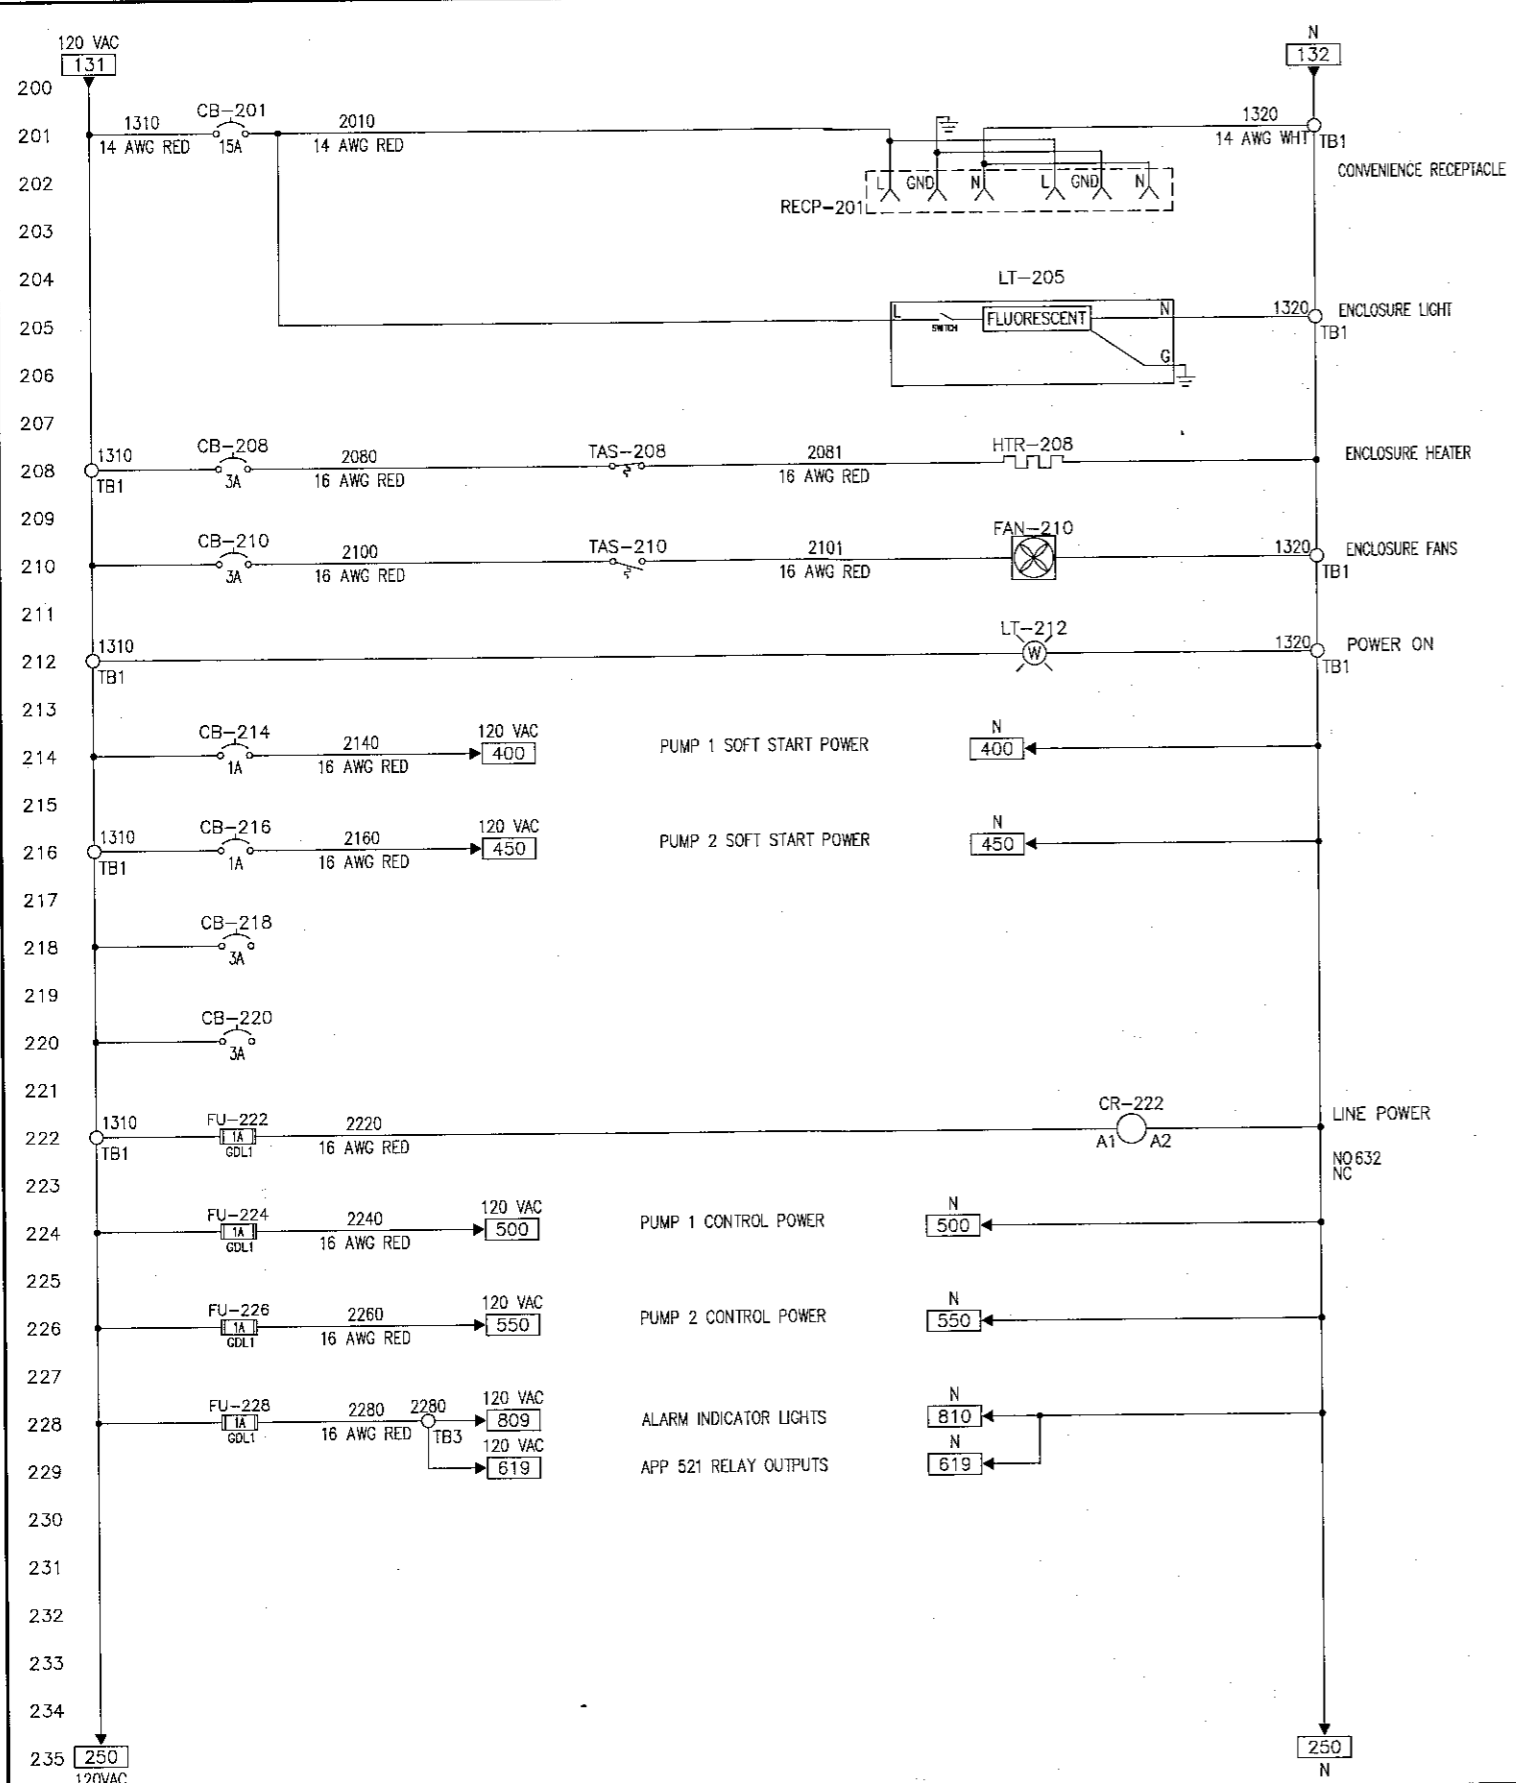

D	FIELD MODIFICATIONS	ECN-140935-0005	08-07-15
C	RECORD DRAWINGS	ECN-140935-0004	01-27-15
B	AS BUILT	ECN-140935-0003	10-23-14
A	ORIGINAL ISSUE	ECN-140935-0001	07-14-14
REV:	DESCRIPTION:	DOC. CONTROL No:	DATE:
DESIGNED ON: AUTOCAD ELECTRICAL 2012		DWG LAST SAVED ON: 08-07-2015 11:13g	

THIS DRAWING OR ANY REPRODUCTION OF IT SHALL NOT BE USED FOR MANUFACTURE, PRODUCTION, OR PROCUREMENT WITHOUT THE EXPRESS WRITTEN PERMISSION OF VSGENVIRONMENT, INC. USE OR REPRODUCTION FOR USE, IN A MANNER ASSOCIATED WITH GOODS OR SERVICES FURNISHED BY VSGENVIRONMENT, INC. IS APPROVED.



VSGENVIRONMENT
 A ZELLER COMPANY

1000 UNIVERSITY AVENUE
 SUITE 800
 ROCHESTER, NY 14607
 TEL.: 585-244-0450
 FAX: 585-254-0982

CUSTOMER: FLYGT, A XYLEM BRAND
 STREET: 600 MILE CROSSING BLVD, SUITE 3
 CITY / STATE: ROCHESTER NY 14624
 TOWN OF BETHLEHEM
 NEW SCOTLAND ROAD PUMP STATION
 DUPLEX PUMP CONTROL PANEL


120 VAC & 24VDC POWER DISTRIBUTION

DRAWN BY: RJY	DRAWN DATE: 07-14-14	MODEL-PART NUMBER: UL 698A LISTED CABINET
CHECKED BY: DL	CHECKED DATE: 07-30-14	DRAWING NUMBER: 140935-SCOTLAND-SCH
FILE REFERENCE: 140935-SCOTLAND-SCH-02D	SCALE: N/A	PAGE: 2
SERIAL/PROJECT NUMBER: 140935-0002	PAGES: 2 OF 14	REVISION: D

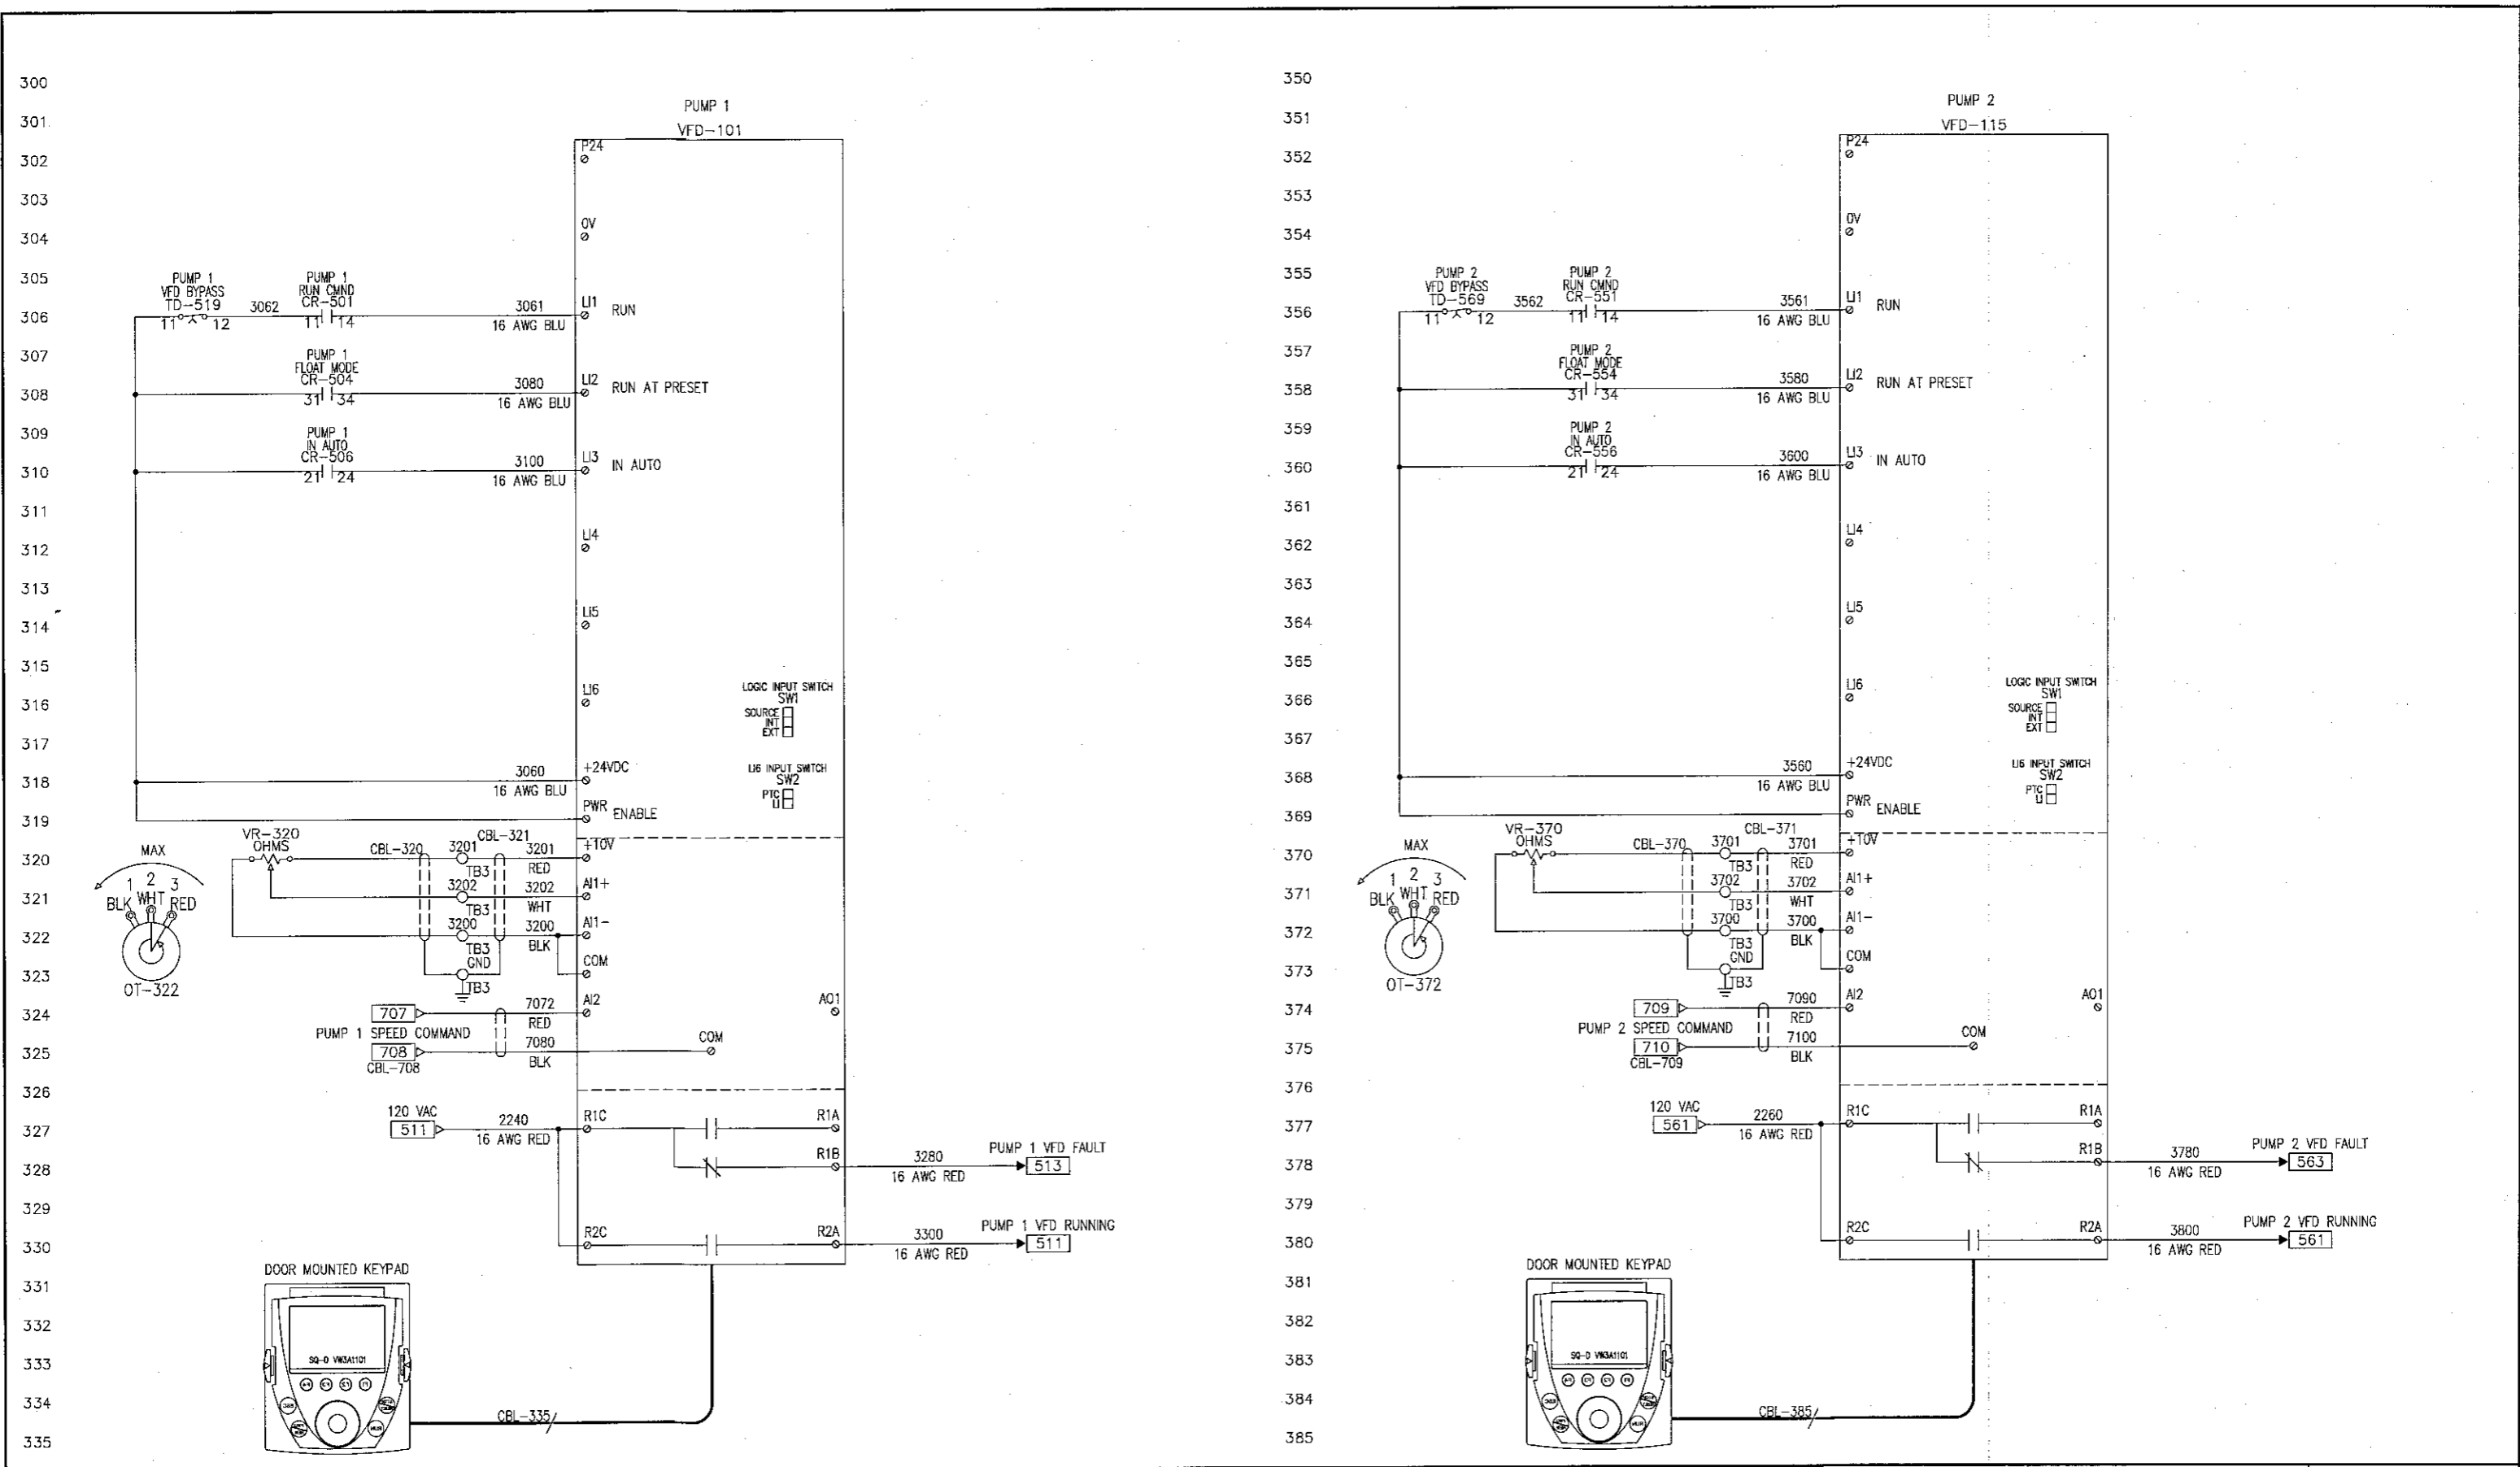

D	FIELD MODIFICATIONS	ECN-140935-0005	08-07-15
B	RECORD DRAWINGS	ECN-140935-0004	01-27-15
C	AS BUILT	ECN-140935-0003	10-23-14
A	ORIGINAL ISSUE	ECN-140935-0001	07-14-14
REV:	DESCRIPTION:	DOC. CONTROL No:	DATE:
DESIGNED ON: AUTOCAD ELECTRICAL 2012		DWG LAST SAVED ON: 08-07-2015 11:13a	



THIS DRAWING OR ANY REPRODUCTION OF IT SHALL NOT BE USED FOR MANUFACTURE, PRODUCTION, OR PROCUREMENT WITHOUT THE EXPRESS WRITTEN PERMISSION OF VSGENVIRONMENT, INC. USE OR REPRODUCTION FOR USE, IN A MANNER ASSOCIATED WITH GOODS OR SERVICES FURNISHED BY VSGENVIRONMENT, INC. IS APPROVED.


VSGENVIRONMENT
 A ZELLER COMPANY

1000 UNIVERSITY AVENUE
 SUITE 800
 ROCHESTER, NY 14607
 TEL.: 585-244-0450
 FAX: 585-254-0982


CUSTOMER: FLYGT, A XYLEM BRAND
 STREET: 600 MILE CROSSING BLVD, SUITE 3
 CITY / STATE: ROCHESTER NY 14824
 TOWN OF BETHLEHEM
 NEW SCOTLAND ROAD PUMP STATION
 DUPLEX PUMP CONTROL PANEL
 VFD CONTROL WIRING

DRAWN BY:	RJY	DRAWN DATE:	07-14-14	MODEL-PART NUMBER:	UL 698A LISTED CABINET
CHECKED BY:	DL	CHECKED DATE:	07-30-14	DRAWING NUMBER:	140935-SCOTLAND-SCH
FILE REFERENCE:	140935-SCOTLAND-SCH-03D	SCALE:	N/A	PAGE:	3
SERIAL/PROJECT NUMBER:	140935-0002	PAGES:	3 OF 14	REVISION:	D

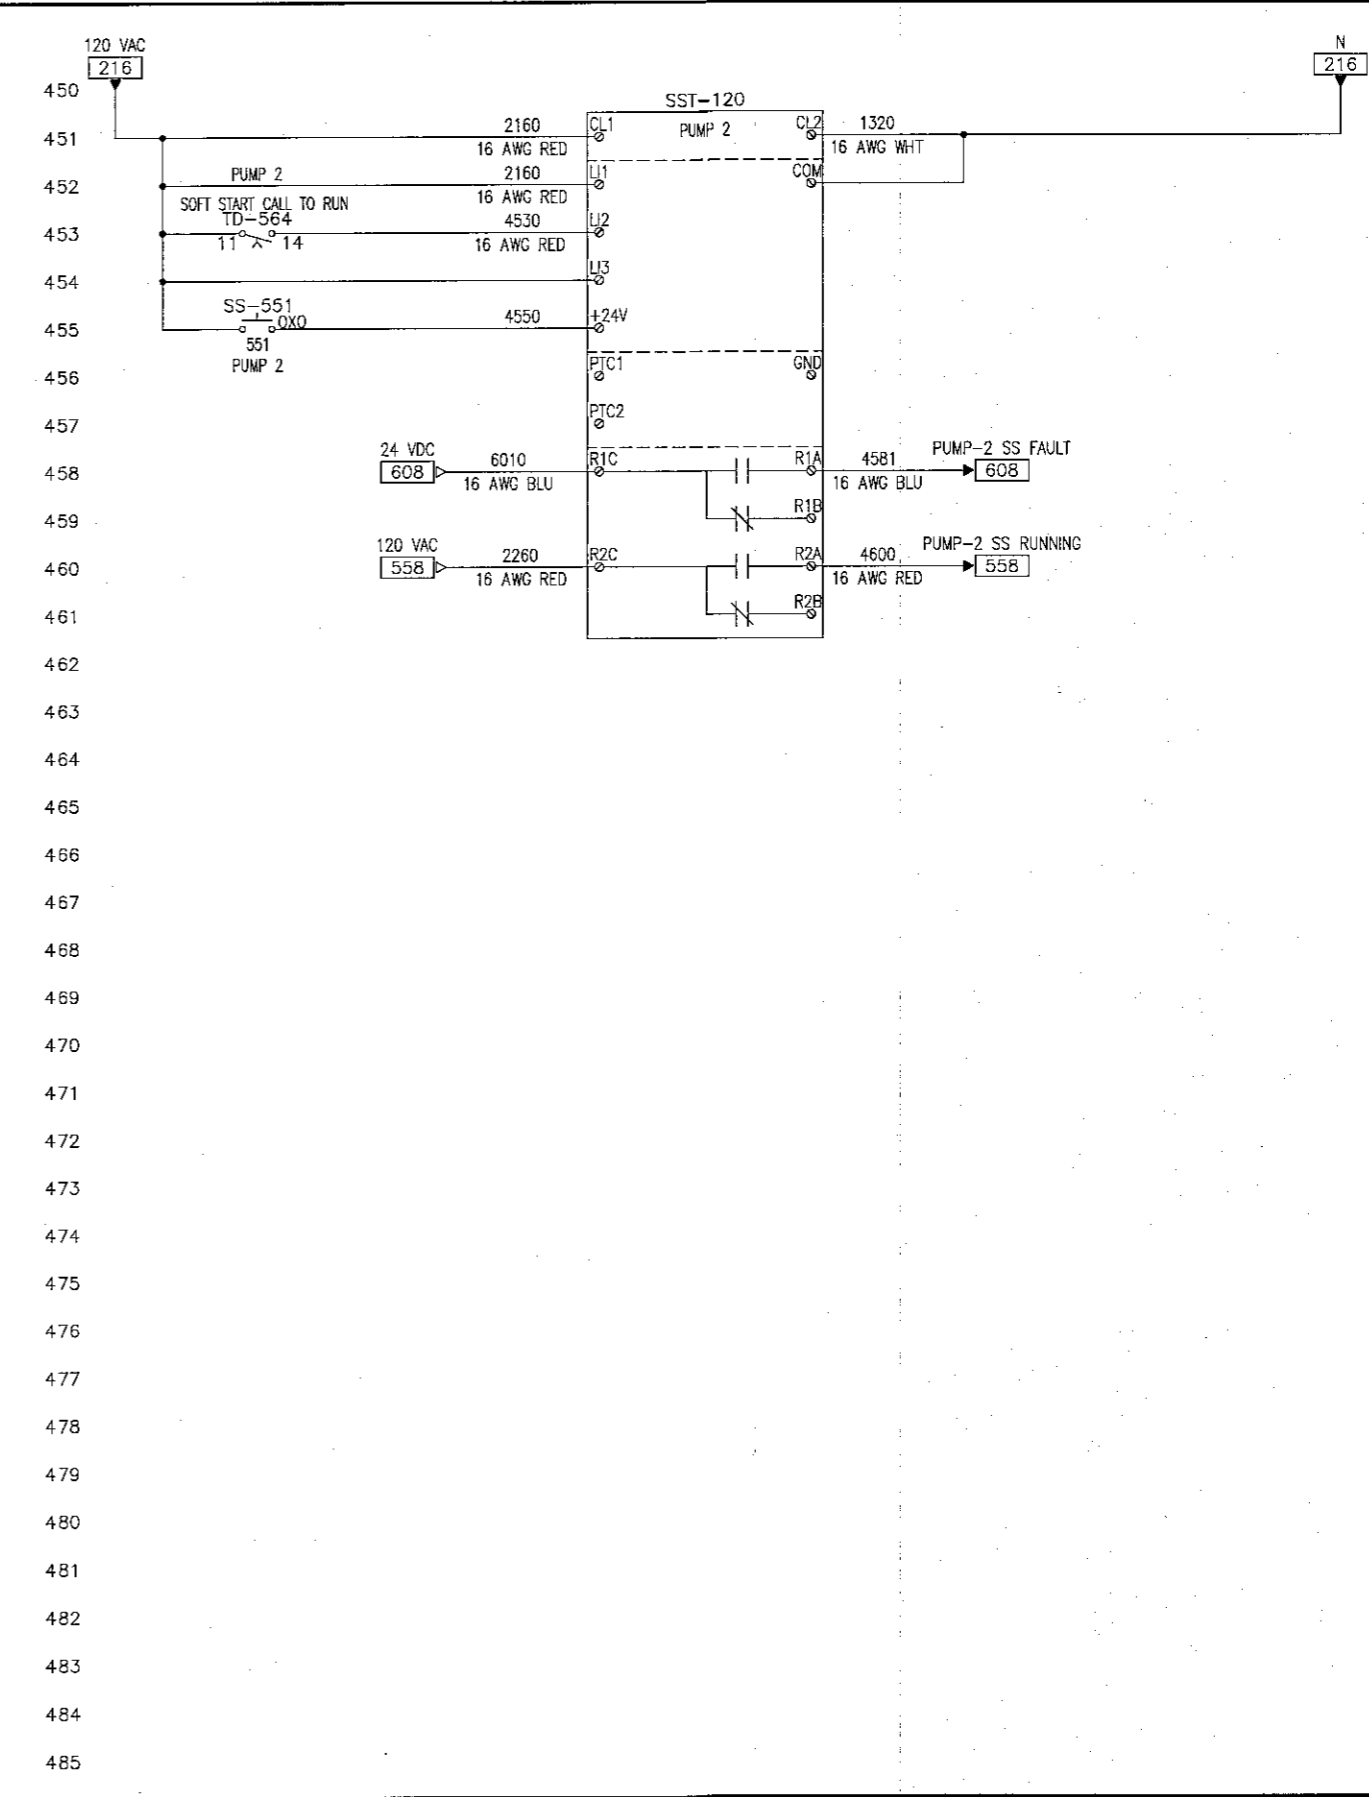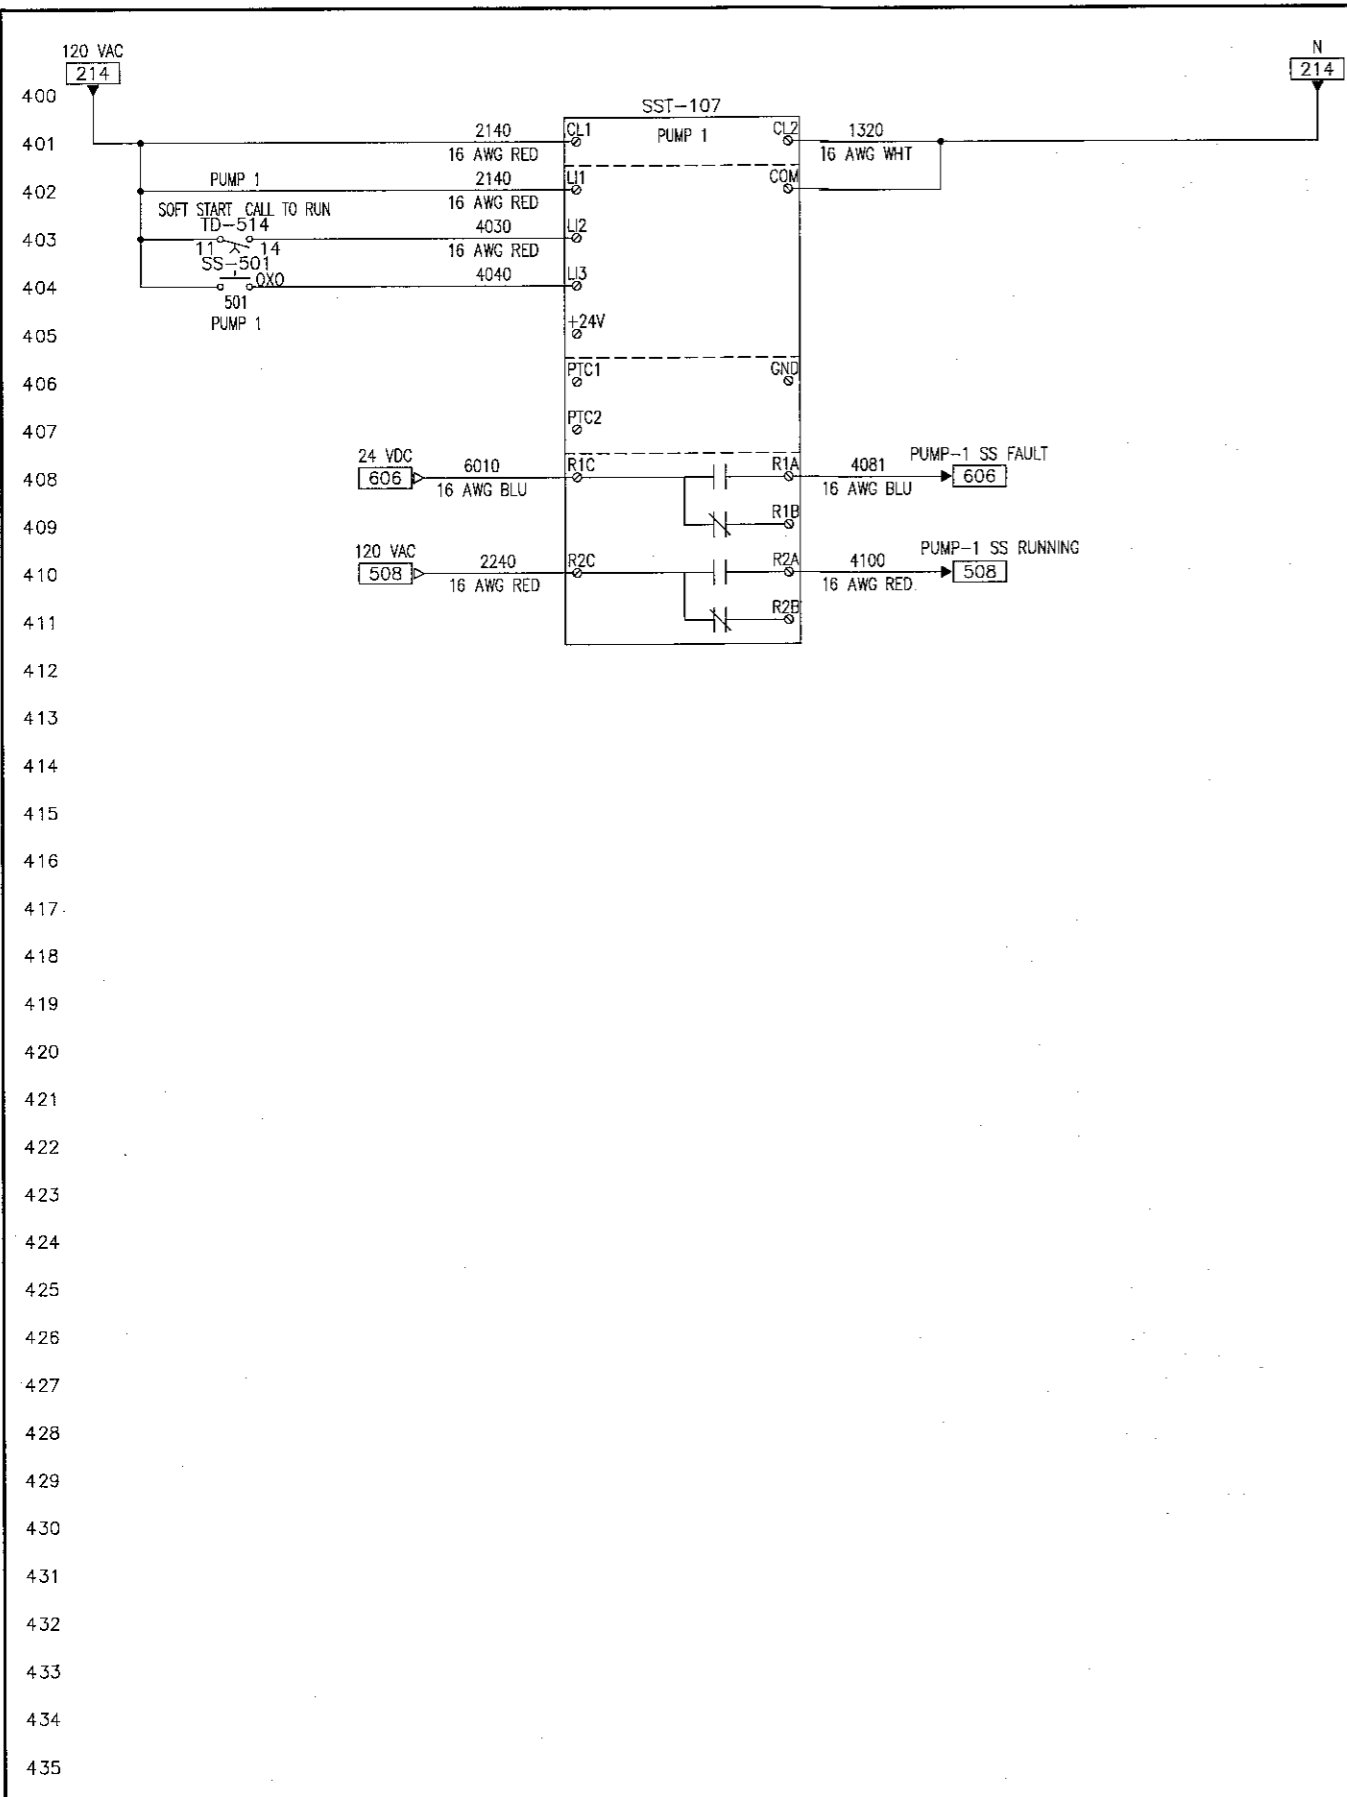


D	FIELD MODIFICATIONS	ECN-140935-0005	08-07-15
C	RECORD DRAWINGS	ECN-140935-0004	01-27-15
B	AS BUILT	ECN-140935-0003	10-23-14
A	ORIGINAL ISSUE	ECN-140935-0001	07-14-14
REV.	DESCRIPTION:	DOC. CONTROL No:	DATE:
DESIGNED ON: AUTOCAD ELECTRICAL 2012		DWG LAST SAVED ON: 08-07-2015	11:13a

THIS DRAWING OR ANY REPRODUCTION OF IT SHALL NOT BE USED FOR MANUFACTURE, PRODUCTION, OR PROCUREMENT WITHOUT THE EXPRESS WRITTEN PERMISSION OF VSGENVIRONMENT, INC. USE OR REPRODUCTION FOR USE, IN A MANNER ASSOCIATED WITH GOODS OR SERVICES FURNISHED BY VSGENVIRONMENT, INC. IS APPROVED.

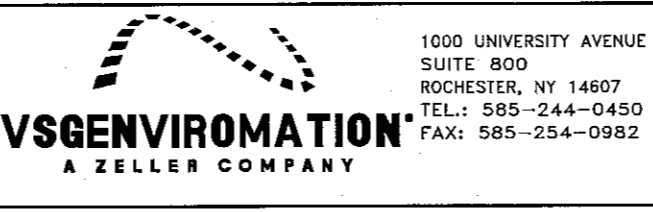


CUSTOMER: FLYGT, A XYLEM BRAND
 STREET: 600 MILE CROSSING BLVD, SUITE 3
 CITY / STATE: ROCHESTER NY 14624
 TOWN OF BETHLEHEM
 NEW SCOTLAND ROAD PUMP STATION
 DUPLEX PUMP CONTROL PANEL
 SOFT START CONTROL

DRAWN BY:	RJY	DRAWN DATE:	07-14-14	MODEL-PART NUMBER:	UL 698A LISTED CABINET
CHECKED BY:	DL	CHECKED DATE:	07-30-14	DRAWING NUMBER:	140935-SCOTLAND-SCH
FILE REFERENCE:	140935-SCOTLAND-SCH-04D	SCALE:	N/A	PAGE:	4
SERIAL/PROJECT NUMBER:	140935-0002	PAGES:	4 OF 14	REVISION:	D

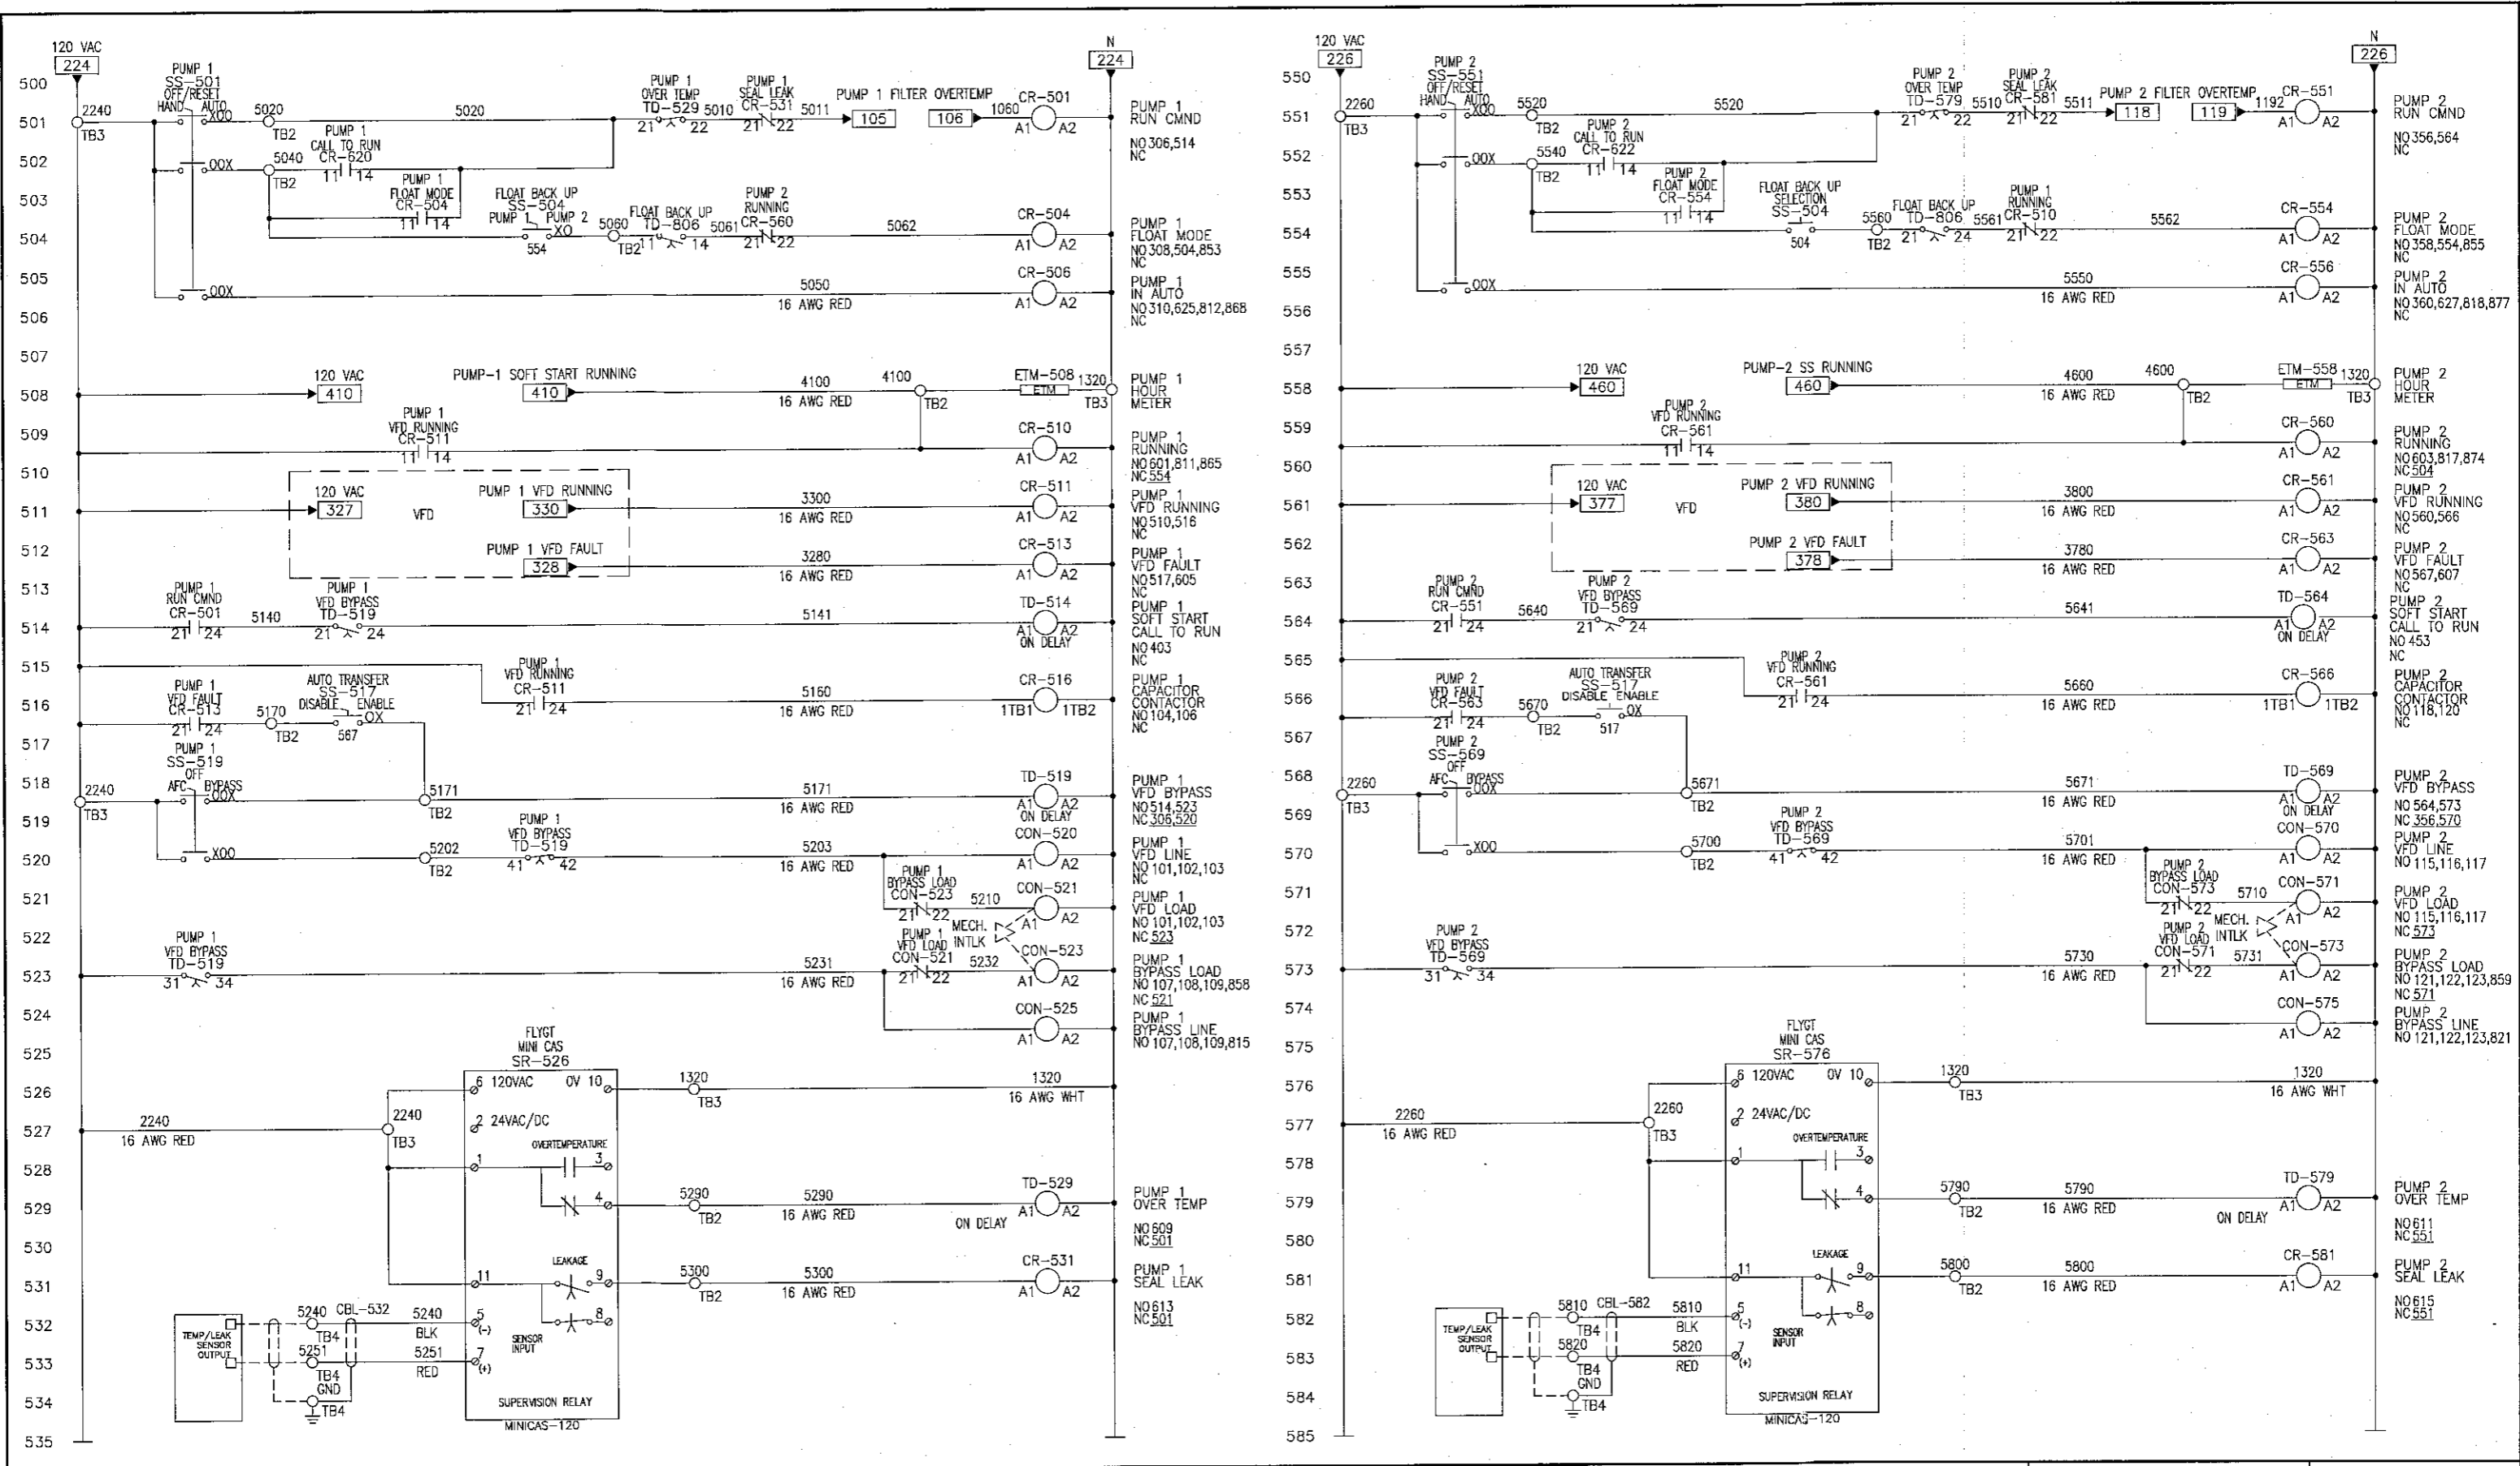

D	FIELD MODIFICATIONS	ECN-140935-0005	08-07-15
C	RECORD DRAWINGS	ECN-140935-0004	01-27-15
B	AS BUILT	ECN-140935-0003	10-23-14
A	ORIGINAL ISSUE	ECN-140935-0001	07-14-14
REV:	DESCRIPTION:	DOC. CONTROL No:	DATE:
DESIGNED ON: AUTOCAD ELECTRICAL 2012		DWG LAST SAVED ON: 08-07-2015 11:13a	


THIS DRAWING OR ANY REPRODUCTION OF IT SHALL NOT BE USED FOR MANUFACTURE, PRODUCTION, OR PROCUREMENT WITHOUT THE EXPRESS WRITTEN PERMISSION OF VSGENVIROMATION, INC. USE OR REPRODUCTION FOR USE, IN A MANNER ASSOCIATED WITH GOODS OR SERVICES FURNISHED BY VSGENVIROMATION, INC. IS APPROVED.

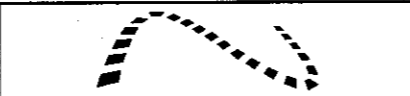
VSGENVIROMATION
 A ZELLER COMPANY

1000 UNIVERSITY AVENUE
 SUITE 800
 ROCHESTER, NY 14607
 TEL: 585-244-0450
 FAX: 585-254-0982


CUSTOMER: FLYGT, A XYLEM BRAND
 STREET: 600 MILE CROSSING BLVD, SUITE 3
 CITY / STATE: ROCHESTER NY 14624
 TOWN OF BETHLEHEM
 NEW SCOTLAND ROAD PUMP STATION
 DUPLEX PUMP CONTROL PANEL
 PUMP CONTROL WIRING

DRAWN BY:	DRAWN DATE:	MODEL-PART NUMBER:
RJY	07-14-14	UL 698A LISTED CABINET
CHECKED BY:	CHECKED DATE:	DRAWING NUMBER:
DL	07-30-14	140935-SCOTLAND-SCH
FILE REFERENCE:	SCALE:	PAGE:
140935-SCOTLAND-SCH-050	N/A	5
SERIAL/PROJECT NUMBER:	PAGES:	REVISION:
140935-0002	5 OF 14	D

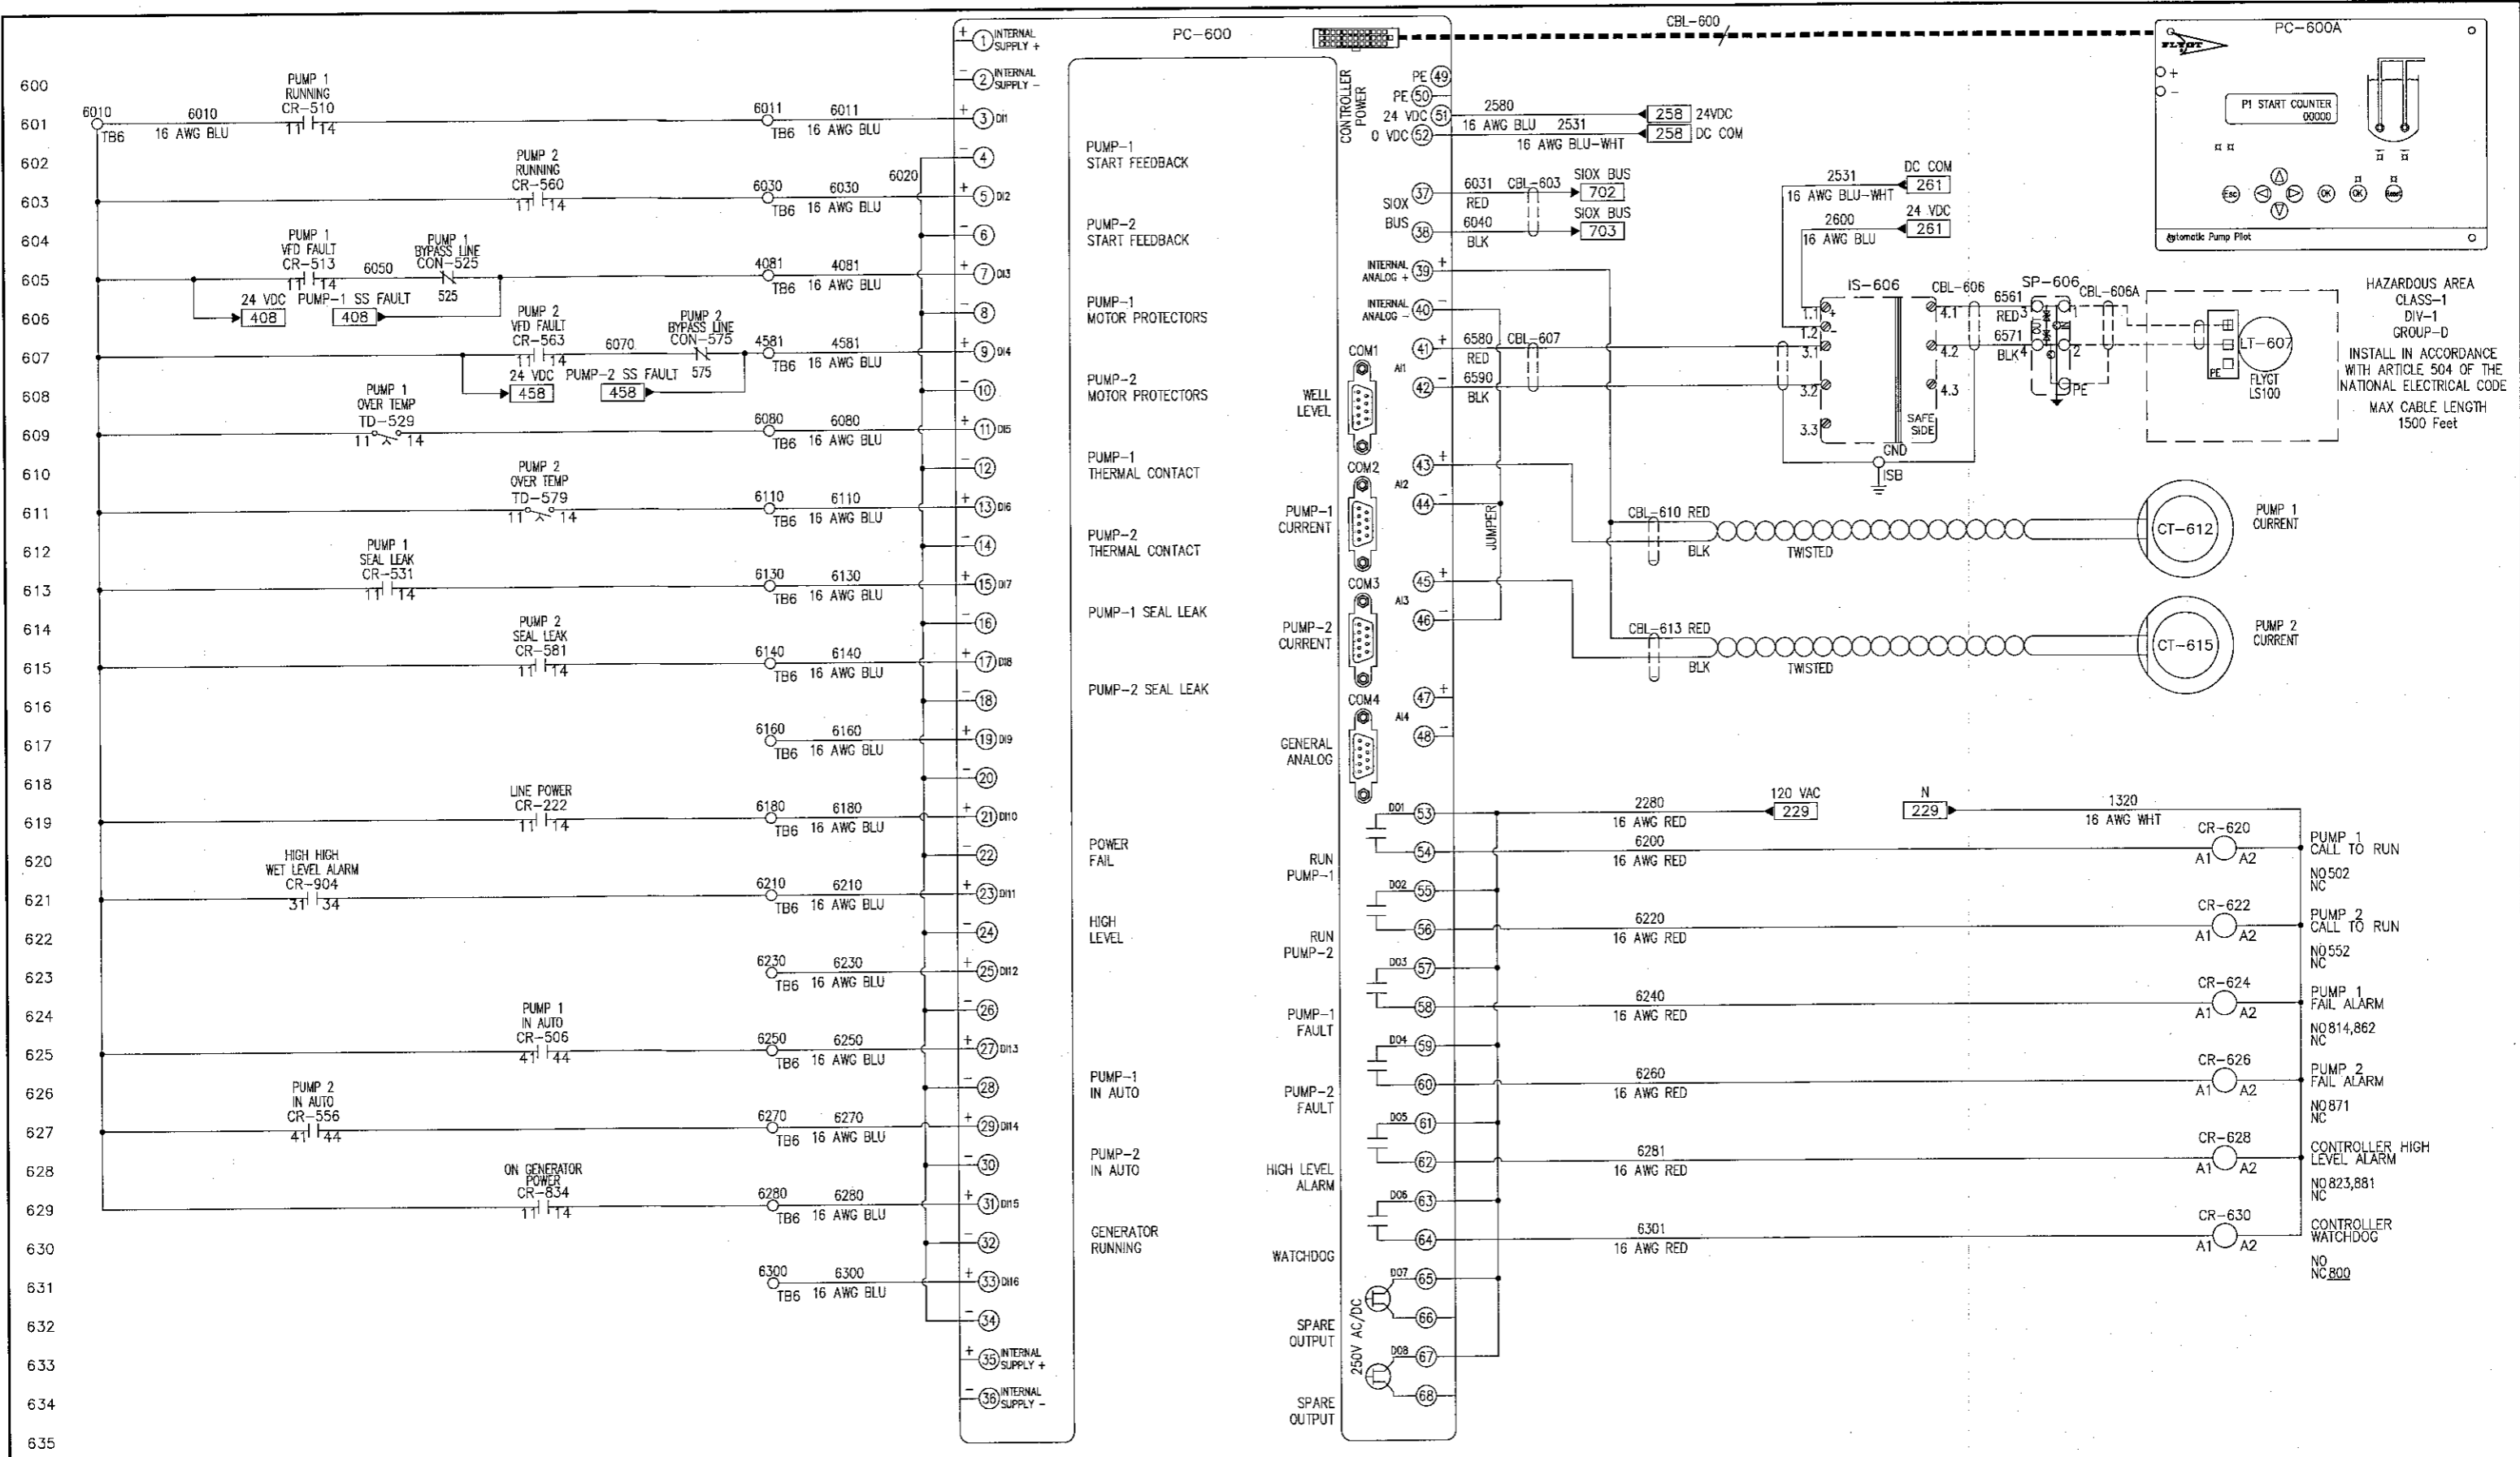

D	FIELD MODIFICATIONS	ECN-140935-0005	08-07-15
C	RECORD DRAWINGS	ECN-140935-0004	01-27-15
B	AS BUILT	ECN-140935-0003	10-23-14
A	ORIGINAL ISSUE	ECN-140935-0001	07-14-14
REV:	DESCRIPTION:	DOC. CONTROL No:	DATE:
DESIGNED ON: AUTOCAD ELECTRICAL 2012		DWG LAST SAVED ON: 08-07-2015	11:13a

THIS DRAWING OR ANY REPRODUCTION OF IT SHALL NOT BE USED FOR MANUFACTURE, PRODUCTION, OR PROCUREMENT WITHOUT THE EXPRESS WRITTEN PERMISSION OF VSGENVIRONMENTAL, INC. USE OR REPRODUCTION FOR USE, IN A MANNER ASSOCIATED WITH GOODS OR SERVICES FURNISHED BY VSGENVIRONMENTAL, INC. IS APPROVED.



VSGENVIRONMENTAL
 A ZELLER COMPANY

1000 UNIVERSITY AVENUE
 SUITE 800
 ROCHESTER, NY 14607
 TEL: 585-244-0450
 FAX: 585-254-0982

CUSTOMER: FLYGT, A XYLEM BRAND
 STREET: 600 MILE CROSSING BLVD, SUITE 3
 CITY / STATE: ROCHESTER NY 14624
 TOWN OF BETHLEHEM
 NEW SCOTLAND ROAD PUMP STATION
 DUPLEX PUMP CONTROL PANEL
 APP721 CONTROL WIRING

DRAWN BY:	RJY	DRAWN DATE:	07-14-14	MODEL-PART NUMBER:	UL 698A LISTED CABINET
CHECKED BY:	DL	CHECKED DATE:	07-30-14	DRAWING NUMBER:	140935-SCOTLAND-SCH
FILE REFERENCE:	140935-SCOTLAND-SCH-06D	SCALE:	N/A	PAGE:	6
SERIAL/PROJECT NUMBER:	140935-0002	PAGES:	6 OF 14	REVISION:	D


700
701
702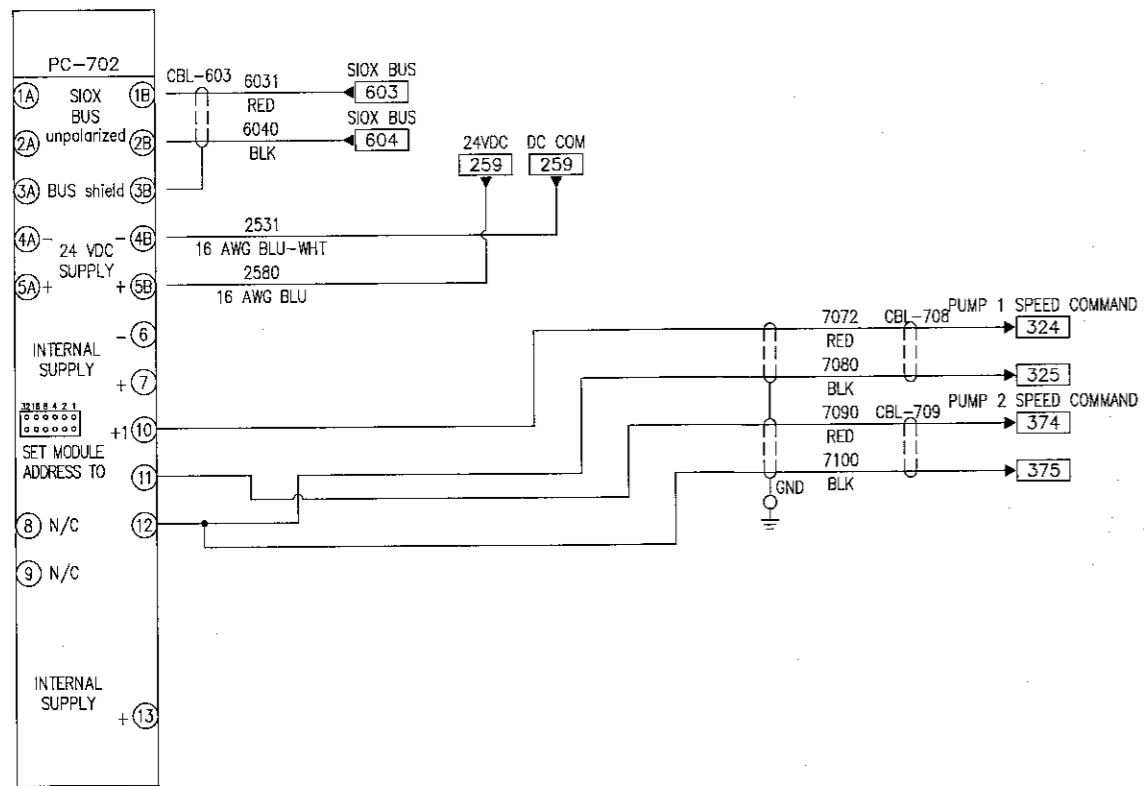
750
751
752
D	FIELD MODIFICATIONS	ECN-140935-0005	08-07-15
C	RECORD DRAWINGS	ECN-140935-0004	01-27-15
B	AS BUILT	ECN-140935-0003	10-23-14
A	ORIGINAL ISSUE	ECN-140935-0001	07-14-14
REV:	DESCRIPTION:	DOC. CONTROL No:	DATE:
DESIGNED ON: AUTOCAD ELECTRICAL 2012		DWG LAST SAVED ON: 08-07-2015 11:13a	


THIS DRAWING OR ANY REPRODUCTION OF IT SHALL NOT BE USED FOR MANUFACTURE, PRODUCTION, OR PROCUREMENT WITHOUT THE EXPRESS WRITTEN PERMISSION OF VSGENVIROMATION, INC. USE OR REPRODUCTION FOR USE, IN A MANNER ASSOCIATED WITH GOODS OR SERVICES FURNISHED BY VSGENVIROMATION, INC. IS APPROVED.


VSGENVIROMATION
 A ZELLER COMPANY

1000 UNIVERSITY AVENUE
 SUITE 800
 ROCHESTER, NY 14607
 TEL.: 585-244-0450
 FAX: 585-254-0982


CUSTOMER: FLYGT, A XYLEM BRAND
 STREET: 600 MILE CROSSING BLVD, SUITE 3
 CITY / STATE: ROCHESTER NY 14624
 TOWN OF BETHLEHEM
 NEW SCOTLAND ROAD PUMP STATION
 DUPLEX PUMP CONTROL PANEL
 ANALOG OUTPUT

DRAWN BY:	DRAWN DATE:	MODEL-PART NUMBER:
RJY	07-14-14	UL 698A LISTED CABINET
CHECKED BY:	CHECKED DATE:	DRAWING NUMBER:
DL	07-30-14	140935-SCOTLAND-SCH
FILE REFERENCE:	SCALE:	PAGE:
140935-SCOTLAND-SCH-07D	N/A	7
SERIAL/PROJECT NUMBER:	PAGES:	REVISION:
140935-0002	7 OF 14	D

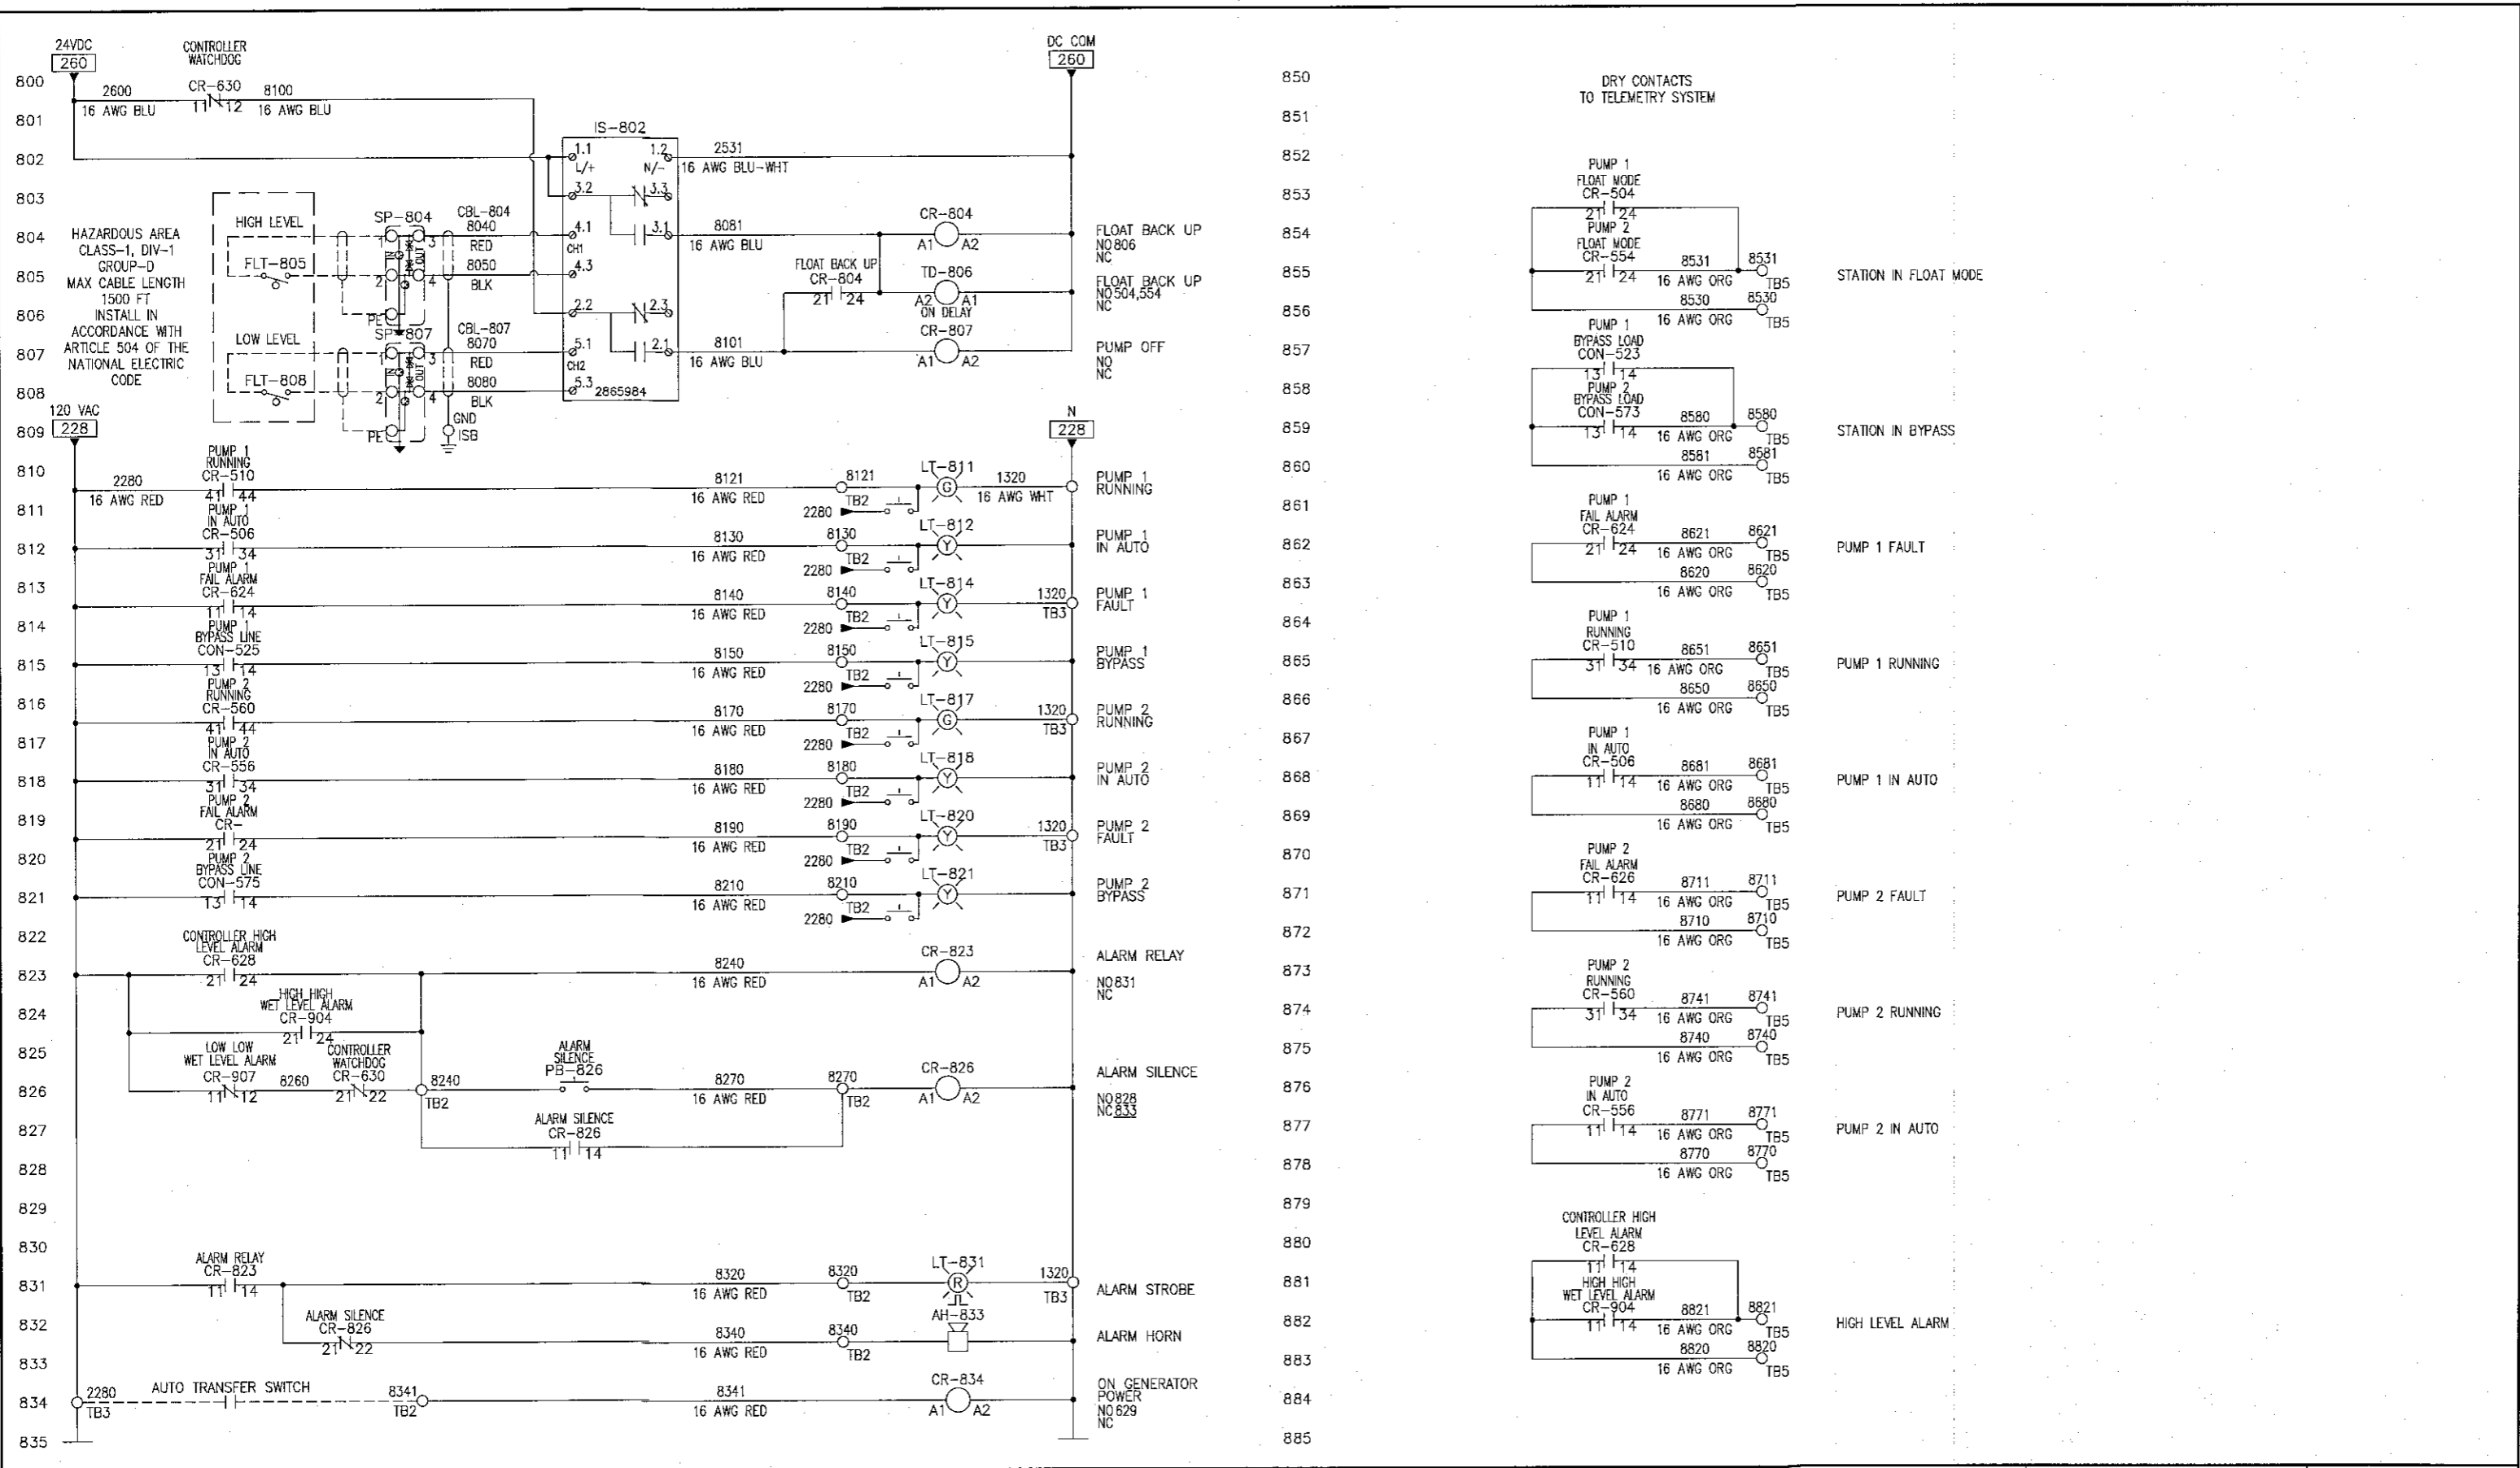

D	FIELD MODIFICATIONS	ECN-140935-0005	08-07-15
C	RECORD DRAWINGS	ECN-140935-0004	01-27-15
B	AS BUILT	ECN-140935-0003	10-23-14
A	ORIGINAL ISSUE	ECN-140935-0001	07-14-14
REV:	DESCRIPTION:	DOC. CONTROL No:	DATE:
	DESIGNED CH: AUTOCAD ELECTRICAL 2012	DWG LAST SAVED CH: 08-07-2015	11:13a

THIS DRAWING OR ANY REPRODUCTION OF IT SHALL NOT BE USED FOR MANUFACTURE, PRODUCTION, OR PROCUREMENT WITHOUT THE EXPRESS WRITTEN PERMISSION OF VSGENVIROMATION, INC. USE OR REPRODUCTION FOR USE, IN A MANNER ASSOCIATED WITH GOODS OR SERVICES FURNISHED BY VSGENVIROMATION, INC. IS APPROVED.


VSGENVIROMATION
 A ZELLER COMPANY

1000 UNIVERSITY AVENUE
 SUITE 800
 ROCHESTER, NY 14607
 TEL.: 585-244-0450
 FAX: 585-254-0982

CUSTOMER: FLYGT, A XYLEM BRAND
 STREET: 600 MILE CROSSING BLVD, SUITE 3
 CITY / STATE: ROCHESTER NY 14624

NEW SCOTLAND ROAD PUMP STATION
 DUPLEX PUMP CONTROL PANEL


FILE REFERENCE:
 140935-SCOTLAND-SCH-08D

SERIAL/PROJECT NUMBER:
 140935-0002

DRAWN BY:	DRAWN DATE:	MODEL-PART NUMBER:
RJY	07-14-14	UL 898A LISTED CABINET
CHECKED BY:	CHECKED DATE:	DRAWING NUMBER:
DL	07-30-14	140935-SCOTLAND-SCH
FILE REFERENCE:	SCALE:	PAGE:
140935-SCOTLAND-SCH-08D	N/A	8
SERIAL/PROJECT NUMBER:	PAGES:	REVISION:
140935-0002	8 OF 14	D

DRY CONTACTS TO TELEMETRY SYSTEM

FLOAT BACKUP AND ALARM OUTPUTS

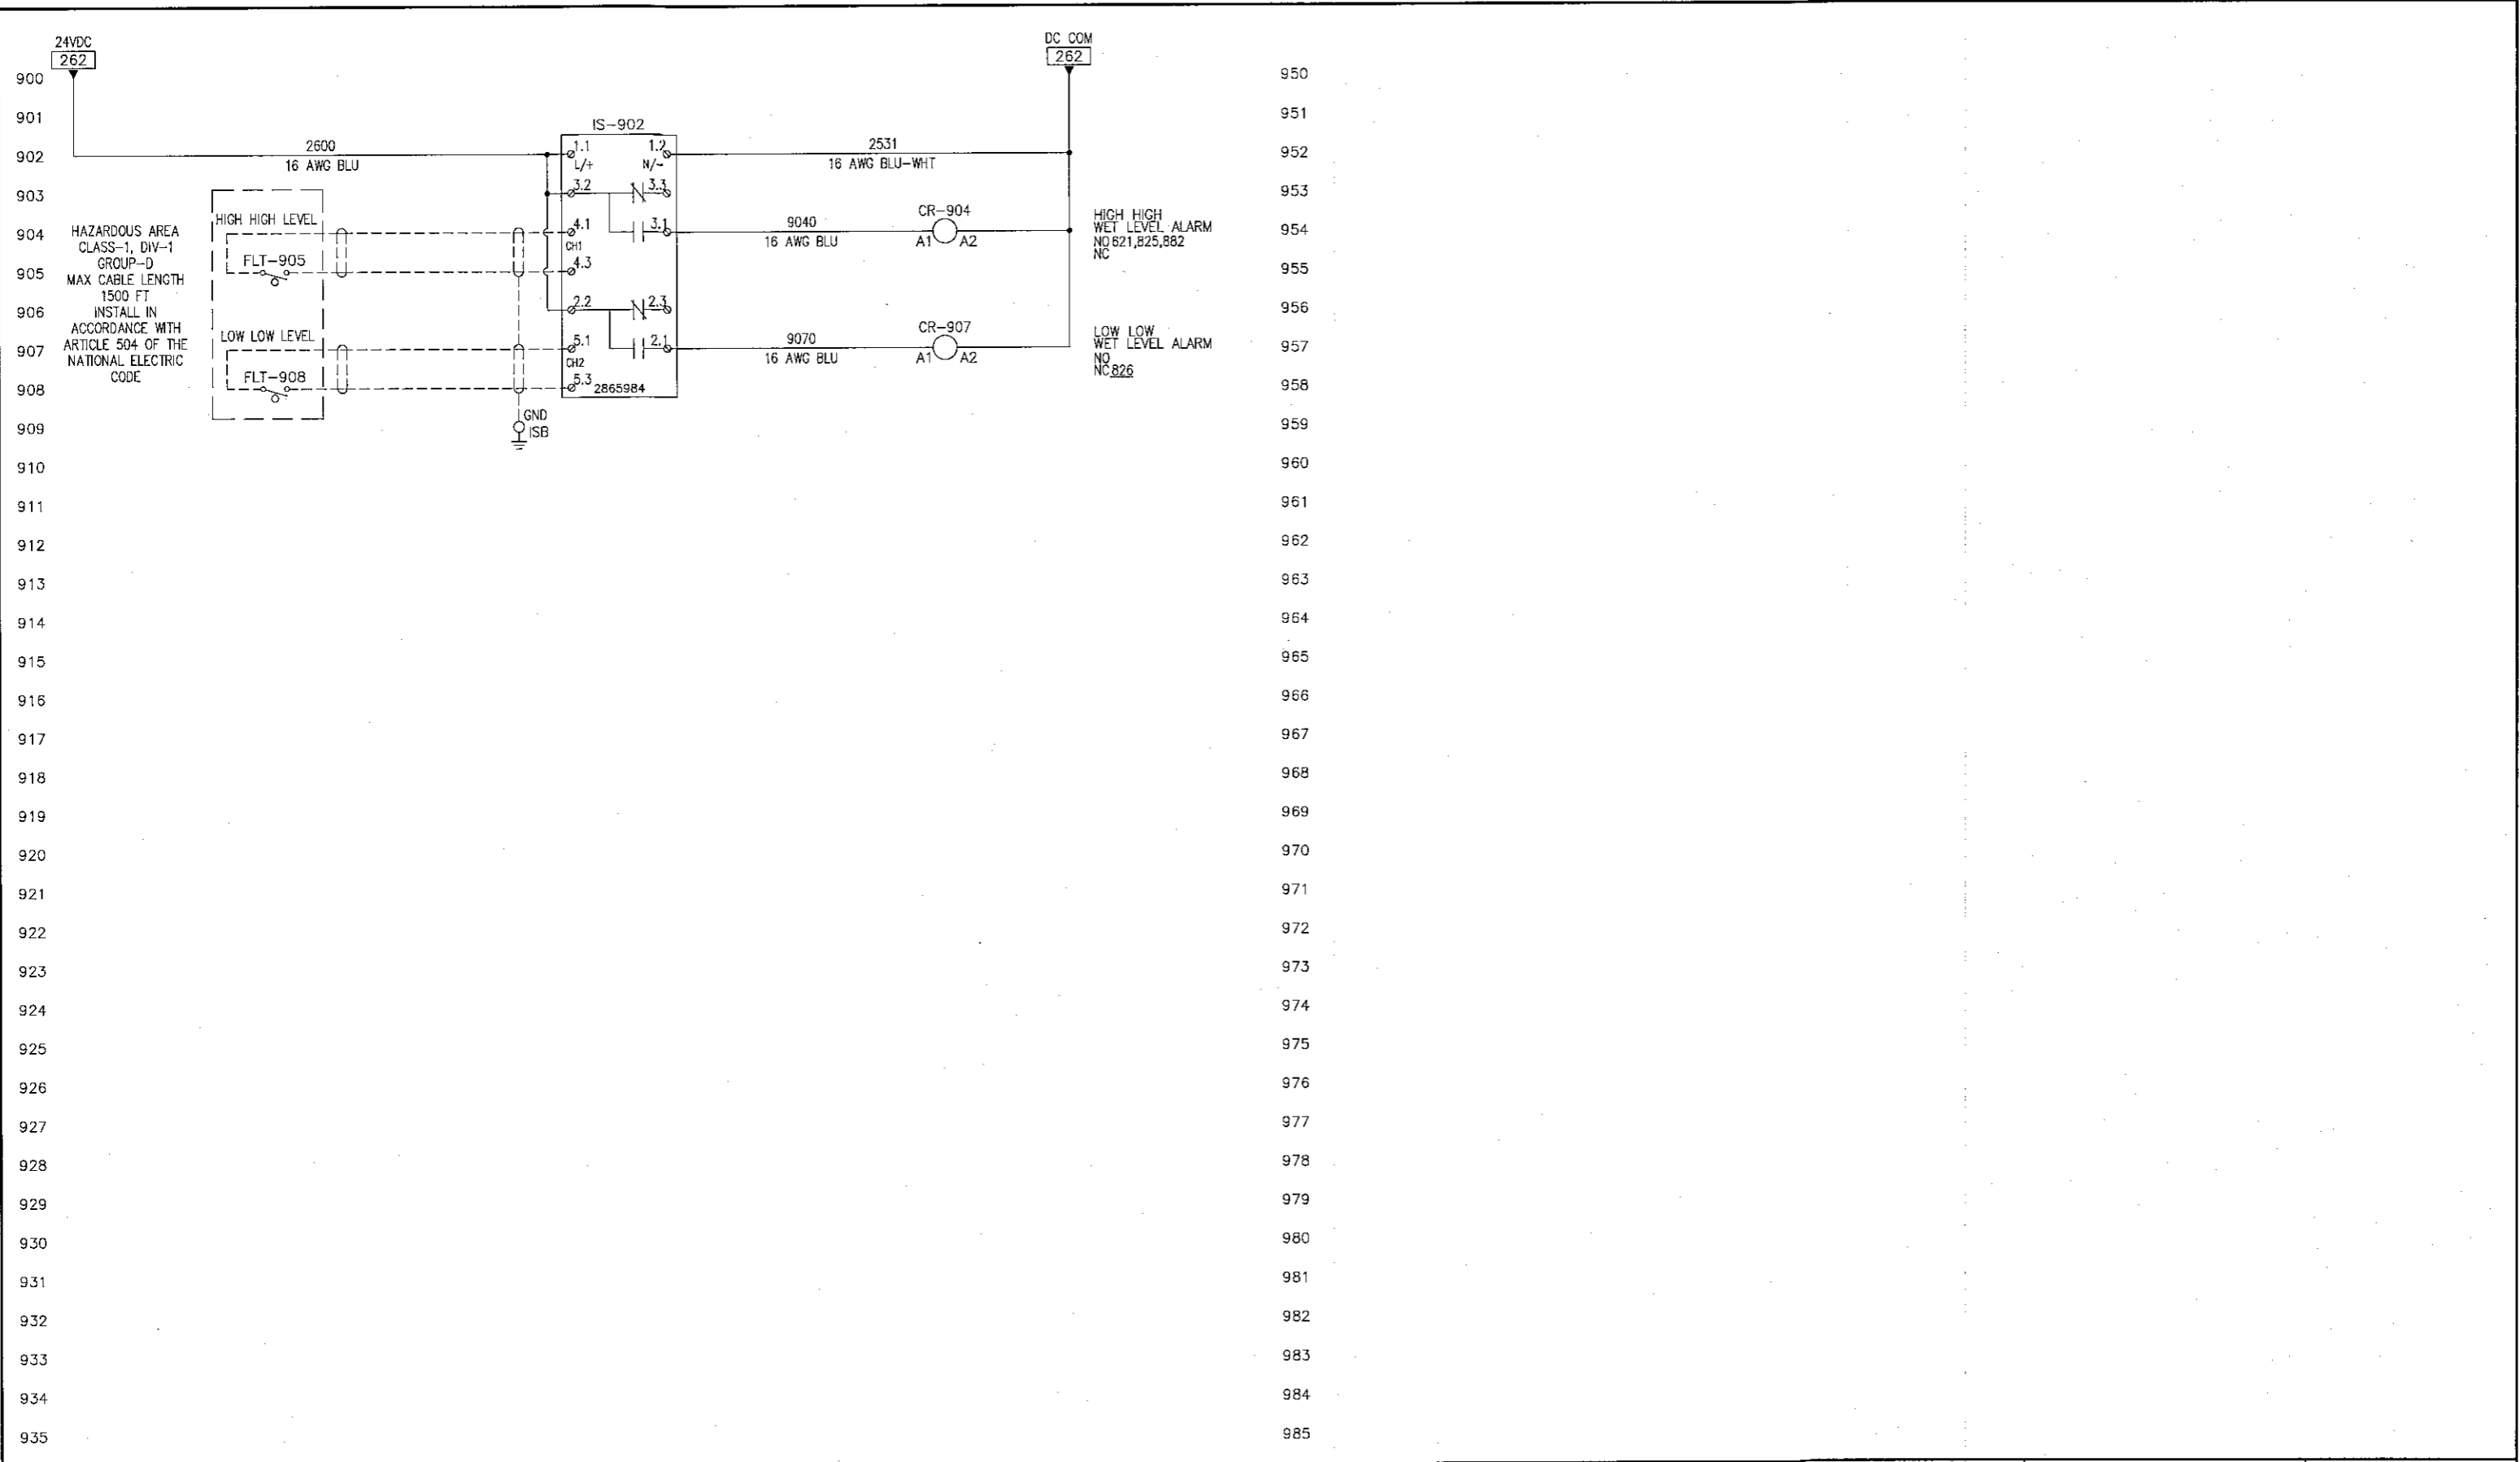

900			
901			
902			
D	FIELD MODIFICATIONS	ECN-140935-0005	08-07-13
C	RECORD DRAWINGS	ECN-140935-0004	01-27-15
B	AS BUILT	ECN-140935-0003	10-23-14
A	ORIGINAL ISSUE	ECN-140935-0001	07-14-14
REV:	DESCRIPTION:	DOC. CONTROL No:	DATE:
DESIGNED ON: AUTOCAD ELECTRICAL 2012		DWG LAST SAVED ON: 08-07-2015 11:13a	






THIS DRAWING OR ANY REPRODUCTION OF IT SHALL NOT BE USED FOR MANUFACTURE, PRODUCTION, OR PROCUREMENT WITHOUT THE EXPRESS WRITTEN PERMISSION OF VSGENVIROMATION, INC. USE OR REPRODUCTION FOR USE, IN A MANNER ASSOCIATED WITH GOODS OR SERVICES FURNISHED BY VSGENVIROMATION, INC. IS APPROVED.

VSGENVIROMATION
A ZELLER COMPANY

1000 UNIVERSITY AVENUE
SUITE 800
ROCHESTER, NY 14607
TEL.: 585-244-0450
FAX: 585-254-0982


CUSTOMER: FLYGT, A XYLEM BRAND
STREET: 600 MILE CROSSING BLVD, SUITE 3
CITY / STATE: ROCHESTER NY 14624
TOWN OF BETHLEHEM
NEW SCOTLAND ROAD PUMP STATION
DUPLEX PUMP CONTROL PANEL
SPARE

DRAWN BY: RJY	DRAWN DATE: 07-14-14	MODEL-PART NUMBER: UL 698A LISTED CABINET
CHECKED BY: DL	CHECKED DATE: 07-30-14	DRAWING NUMBER: 140935-SCOTLAND-SCH
FILE REFERENCE: 140935-SCOTLAND-SCH-09D	SERIAL/PROJECT NUMBER: 140935-0002	PAGES: 9 OF 14
SCALE: N/A	PAGE: 9	REVISION: D

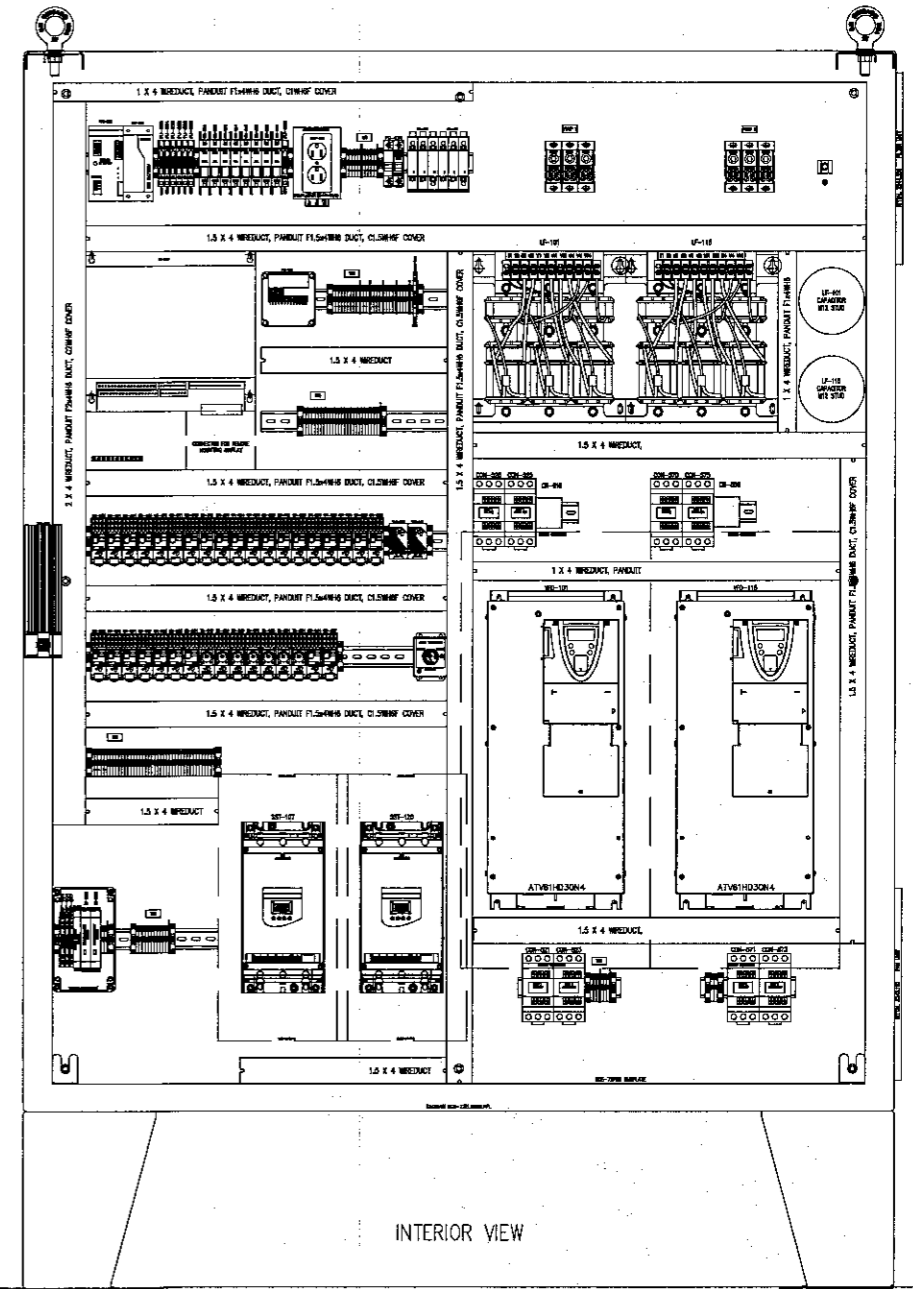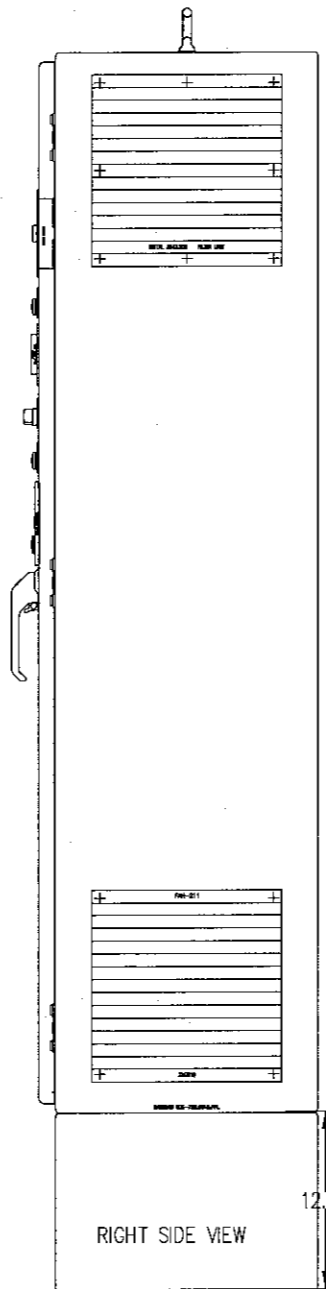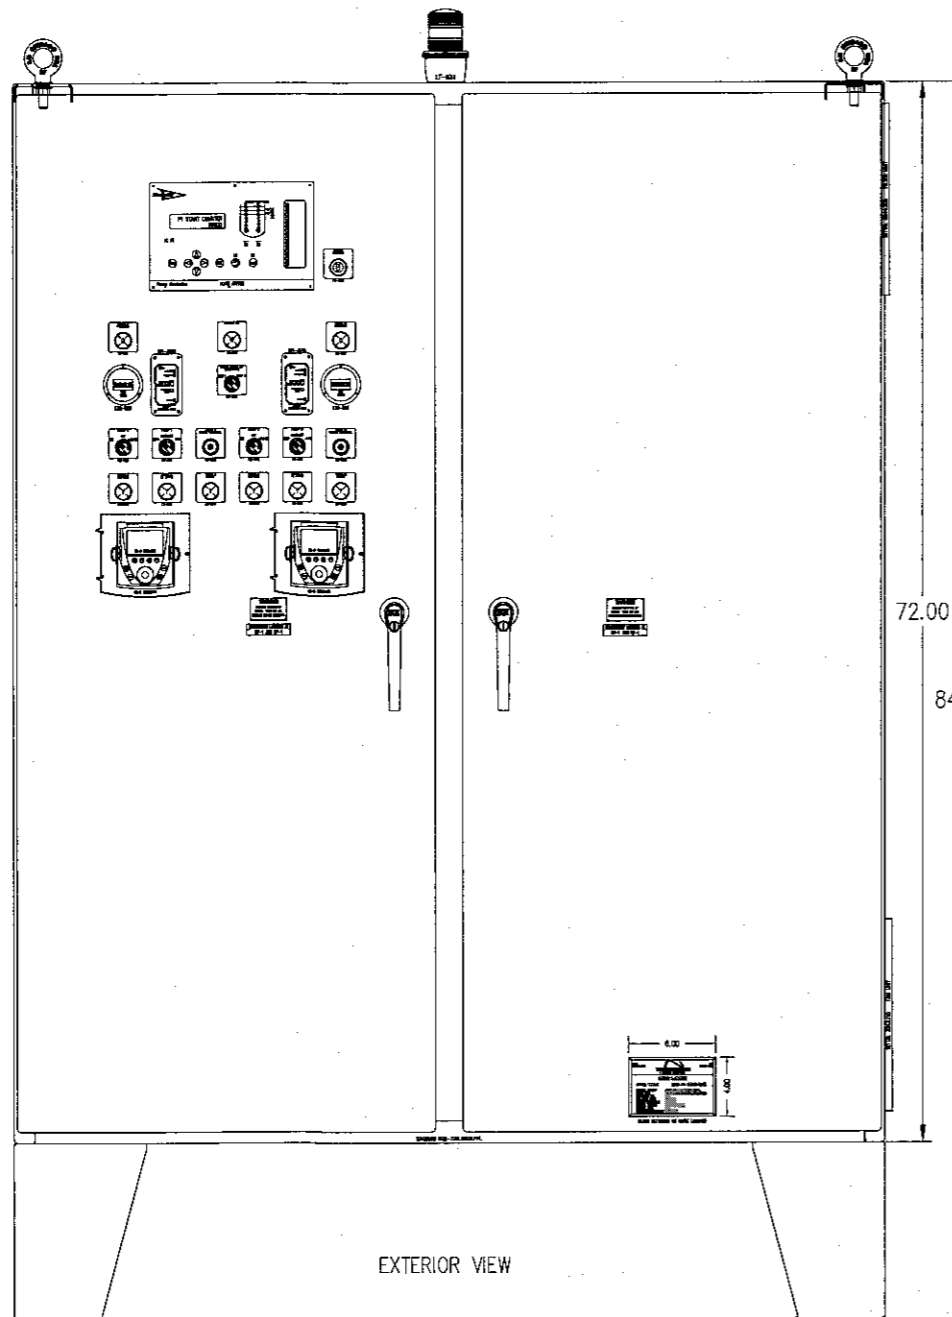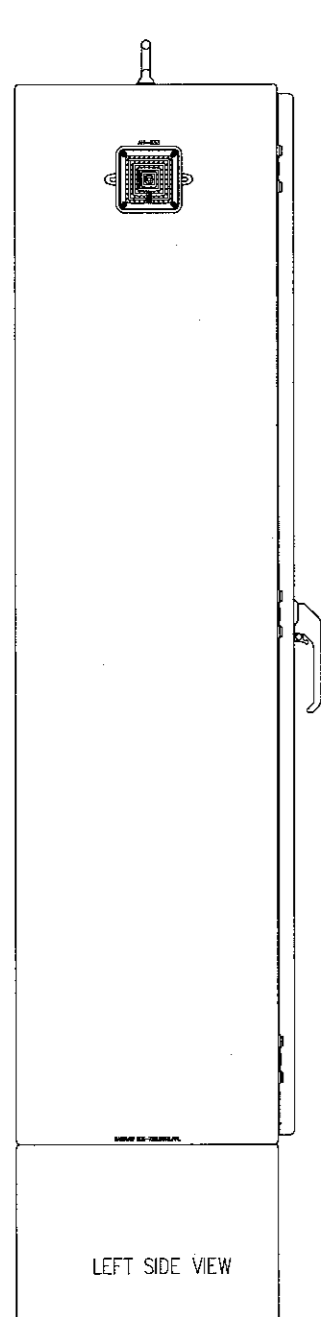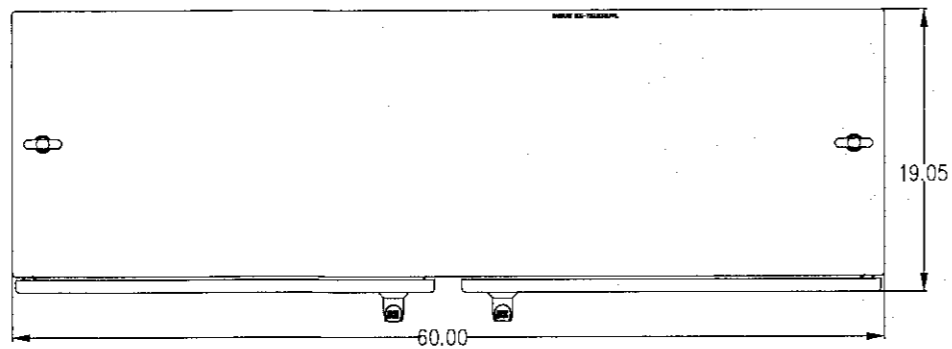

REV:	DESCRIPTION:	DOC. CONTROL No:	DATE:
D	FIELD MODIFICATIONS	ECN-140935-0005	08-07-15
C	RECORD DRAWINGS	ECN-140935-0004	01-27-15
B	AS BUILT	ECN-140935-0003	10-23-14
A	ORIGINAL ISSUE	ECN-140935-0001	07-14-14
DESIGNED ON: AUTOCAD ELECTRICAL 2012		DWG LAST SAVED ON: 08-07-2015 11:13a	




THIS DRAWING OR ANY REPRODUCTION OF IT SHALL NOT BE USED FOR MANUFACTURE, PRODUCTION, OR PROCUREMENT WITHOUT THE EXPRESS WRITTEN PERMISSION OF VSGENVIROMATION, INC. USE OR REPRODUCTION FOR USE, IN A MANNER ASSOCIATED WITH GOODS OR SERVICES FURNISHED BY VSGENVIROMATION, INC. IS APPROVED.

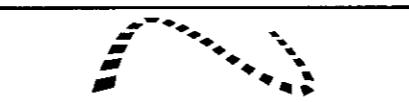
VSGENVIROMATION
 A ZELLER COMPANY

1000 UNIVERSITY AVENUE
 SUITE 800
 ROCHESTER, NY 14607
 TEL.: 585-244-0450
 FAX: 585-254-0982


CUSTOMER: FLYGT, A XYLEM BRAND
 STREET: 600 MILE CROSSING BLVD, SUITE 3
 CITY / STATE: ROCHESTER NY 14624
 TOWN OF BETHLEHEM
 NEW SCOTLAND ROAD PUMP STATION
 DUPLEX PUMP CONTROL PANEL
 EXTERIOR VIEW

DRAWN BY:	DRAWN DATE:	MODEL-PART NUMBER:
RJY	07-14-14	UL 698A LISTED CABINET
CHECKED BY:	CHECKED DATE:	DRAWING NUMBER:
DL	07-30-14	140935-SCOTLAND-SCH
FILE REFERENCE:	SCALE:	PAGE:
140935-SCOTLAND-SCH-100	N/A	10
SERIAL/PROJECT NUMBER:	PAGES:	REVISION:
140935-0002	10 OF 14	D

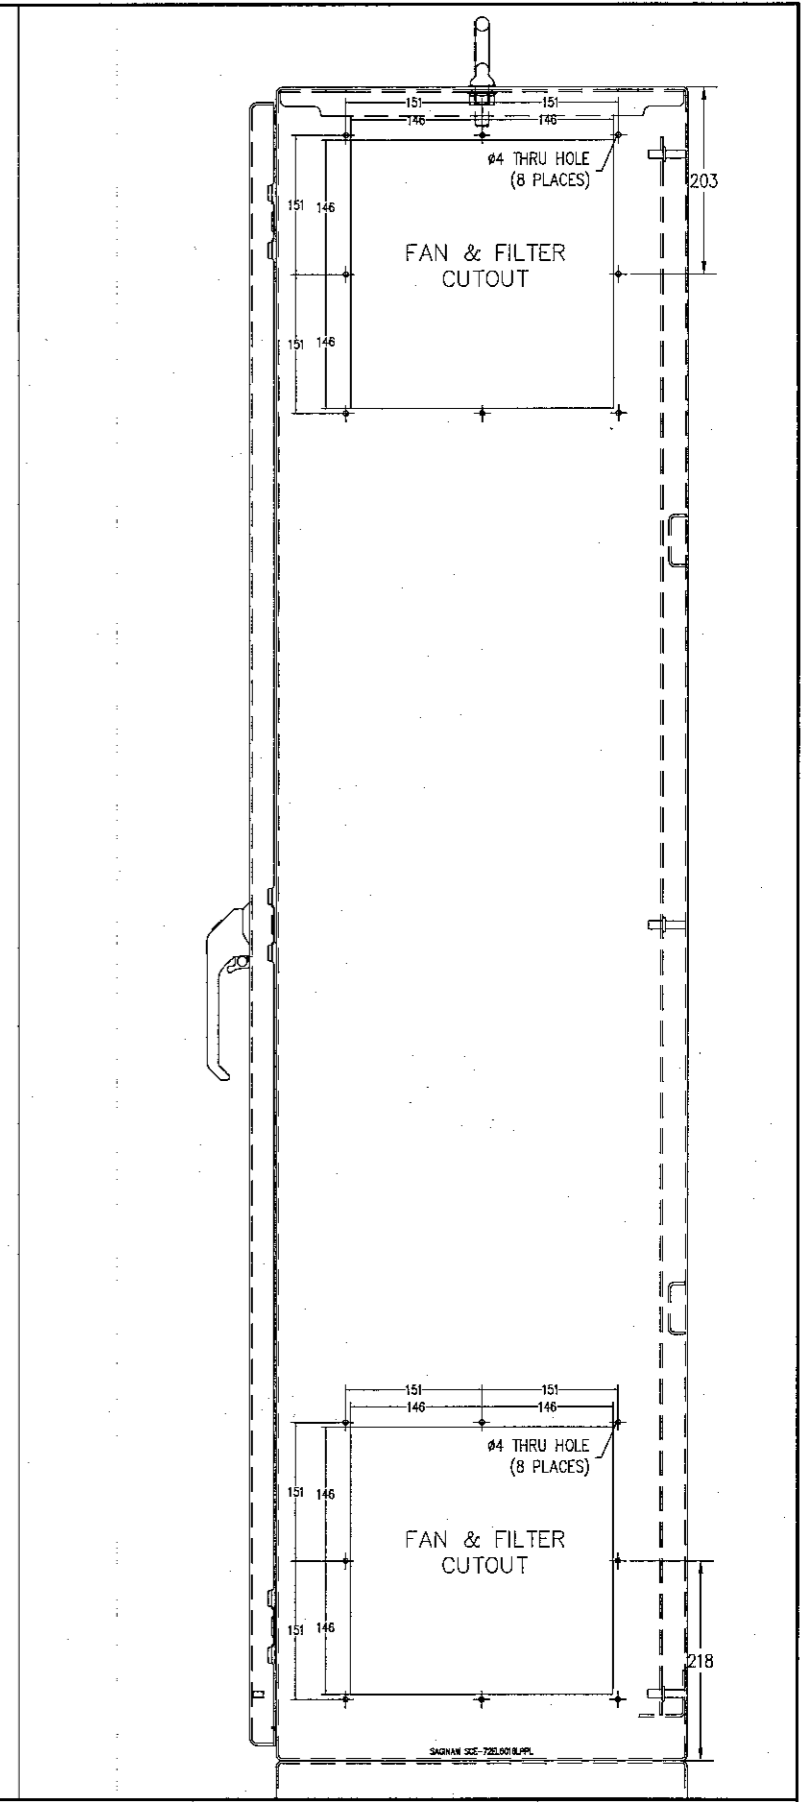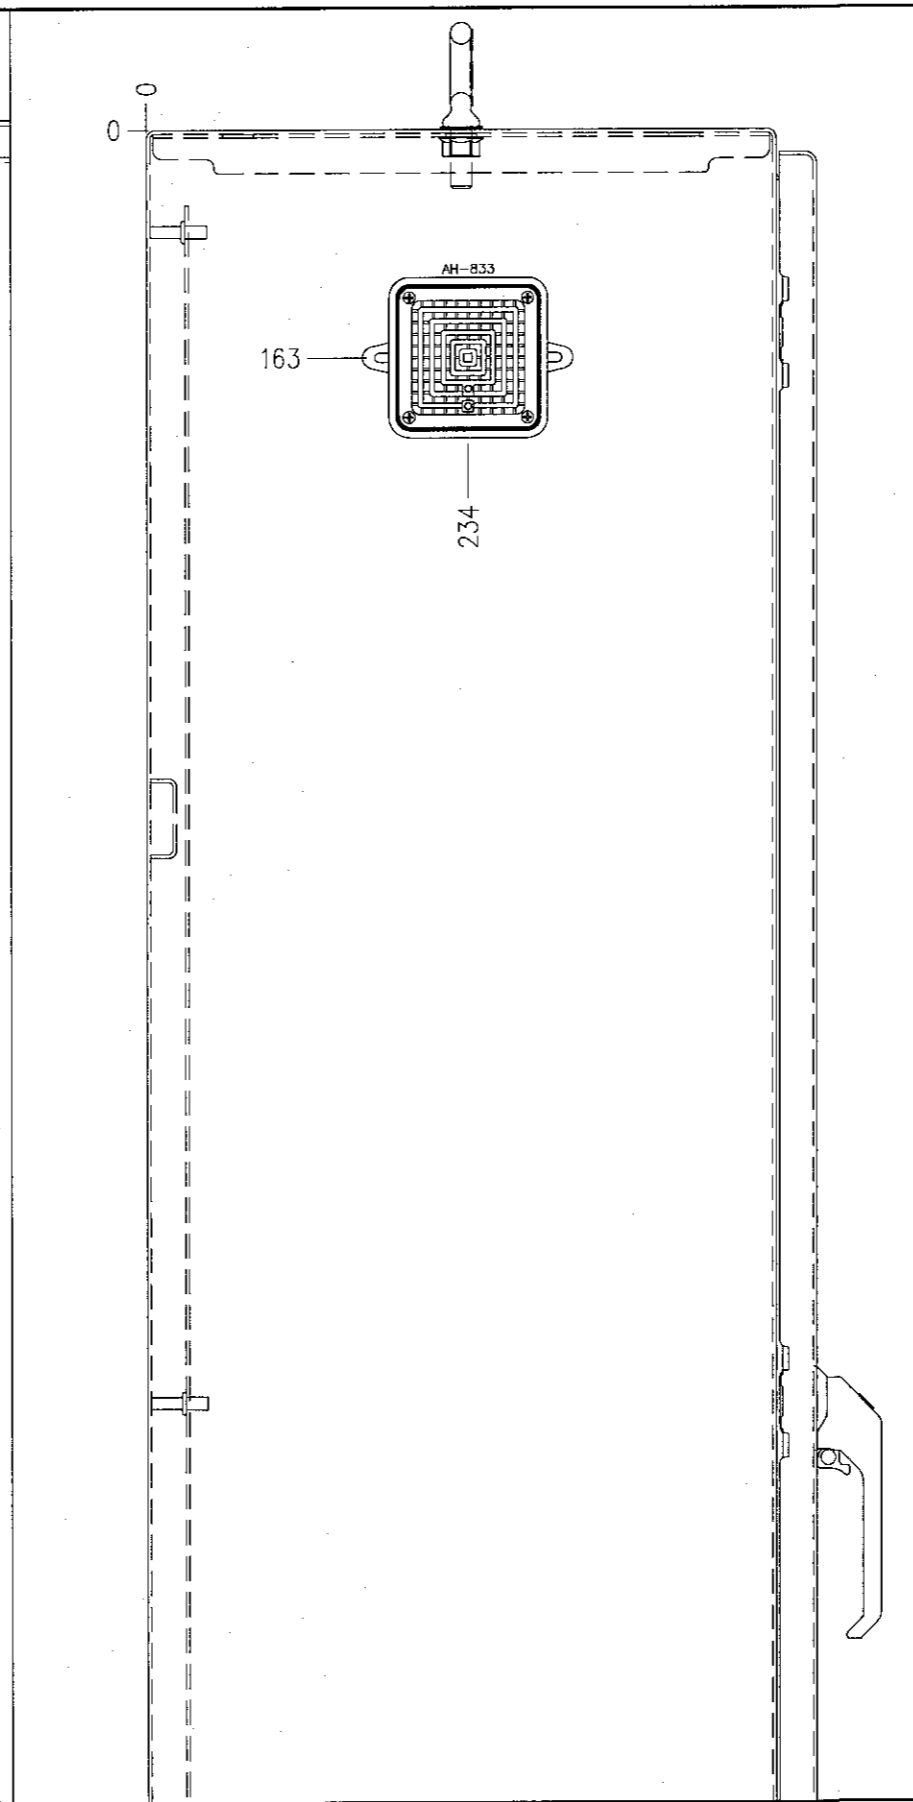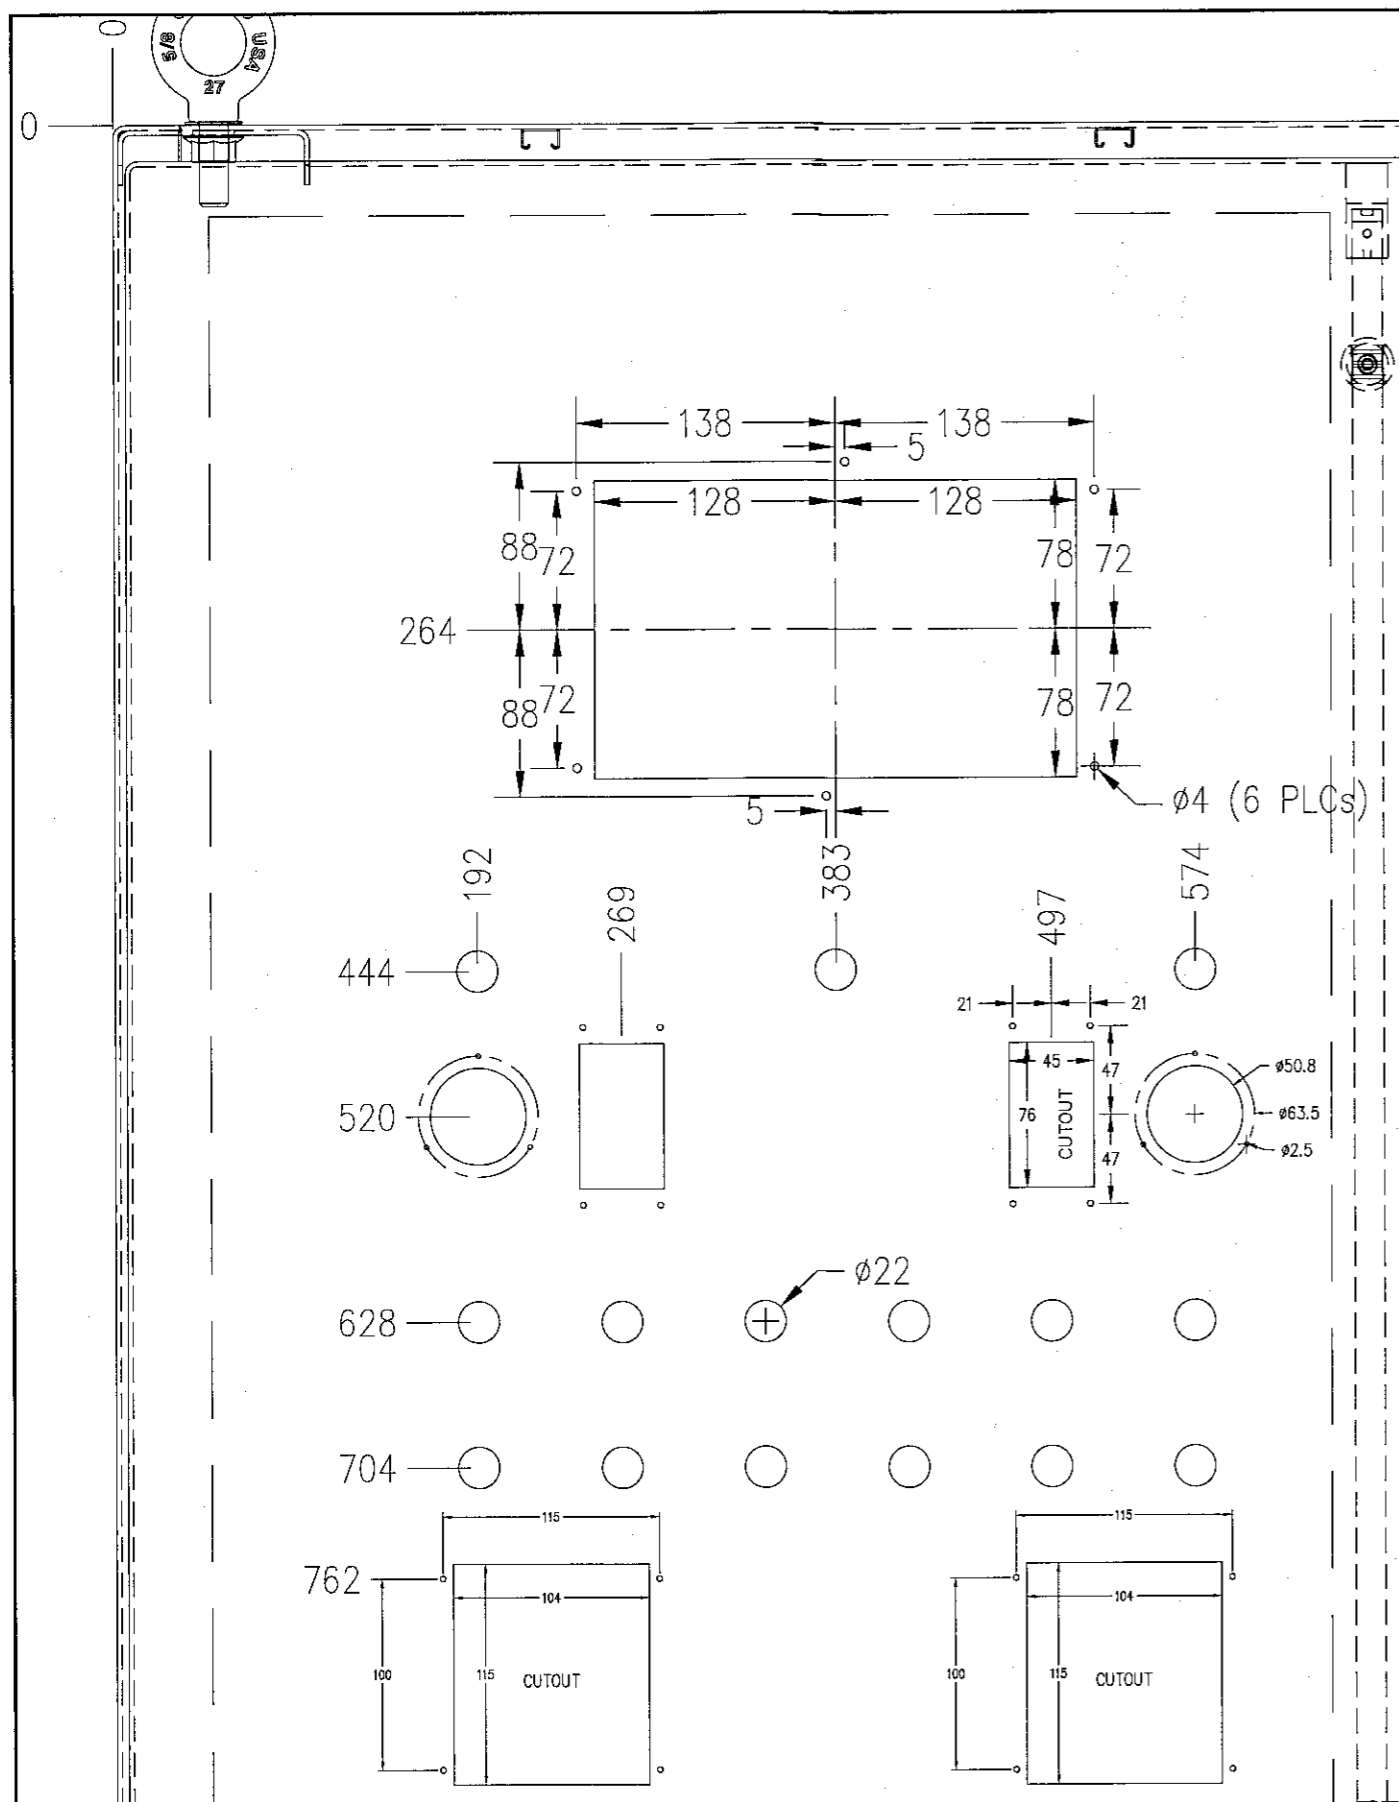

REV:	DESCRIPTION:	DOC. CONTROL No:	DATE:
A	ORIGINAL ISSUE	ECN-140935-0001	07-14-14
B	AS BUILT	ECN-140935-0003	10-23-14
C	RECORD DRAWINGS	ECN-140935-0004	01-27-15
D	FIELD MODIFICATIONS	ECN-140935-0005	08-07-15
DESIGNED ON: AUTOCAD ELECTRICAL 2012		DWG LAST SAVED ON: 08-07-2015 11:13a	


THIS DRAWING OR ANY REPRODUCTION OF IT SHALL NOT BE USED FOR MANUFACTURE, PRODUCTION, OR PROCUREMENT WITHOUT THE EXPRESS WRITTEN PERMISSION OF VSGENVIROMATION, INC. USE OR REPRODUCTION FOR USE, IN A MANNER ASSOCIATED WITH GOODS OR SERVICES FURNISHED BY VSGENVIROMATION, INC. IS APPROVED.


VSGENVIROMATION
 A ZELLER COMPANY

1000 UNIVERSITY AVENUE
 SUITE 800
 ROCHESTER, NY 14607
 TEL.: 585-244-0450
 FAX: 585-254-0982


CUSTOMER: FLYGT, A XYLEM BRAND
 STREET: 600 MILE CROSSING BLVD, SUITE 3
 CITY / STATE: ROCHESTER NY 14624
 TOWN OF BETHLEHEM
 NEW SCOTLAND ROAD PUMP STATION
 DUPLEX PUMP CONTROL PANEL
 DOOR CUTOUTS

DRAWN BY:	DRAWN DATE:	MODEL-PART NUMBER:
RJY	07-14-14	UL 698A LISTED CABINET
CHECKED BY:	CHECKED DATE:	DRAWING NUMBER:
DL	07-30-14	140935-SCOTLAND-SCH
FILE REFERENCE:	SCALE:	PAGE:
140935-SCOTLAND-SCH-100	N/A	11
SERIAL/PROJECT NUMBER:	PAGES:	REVISION:
140935-0002	11 OF 14	D

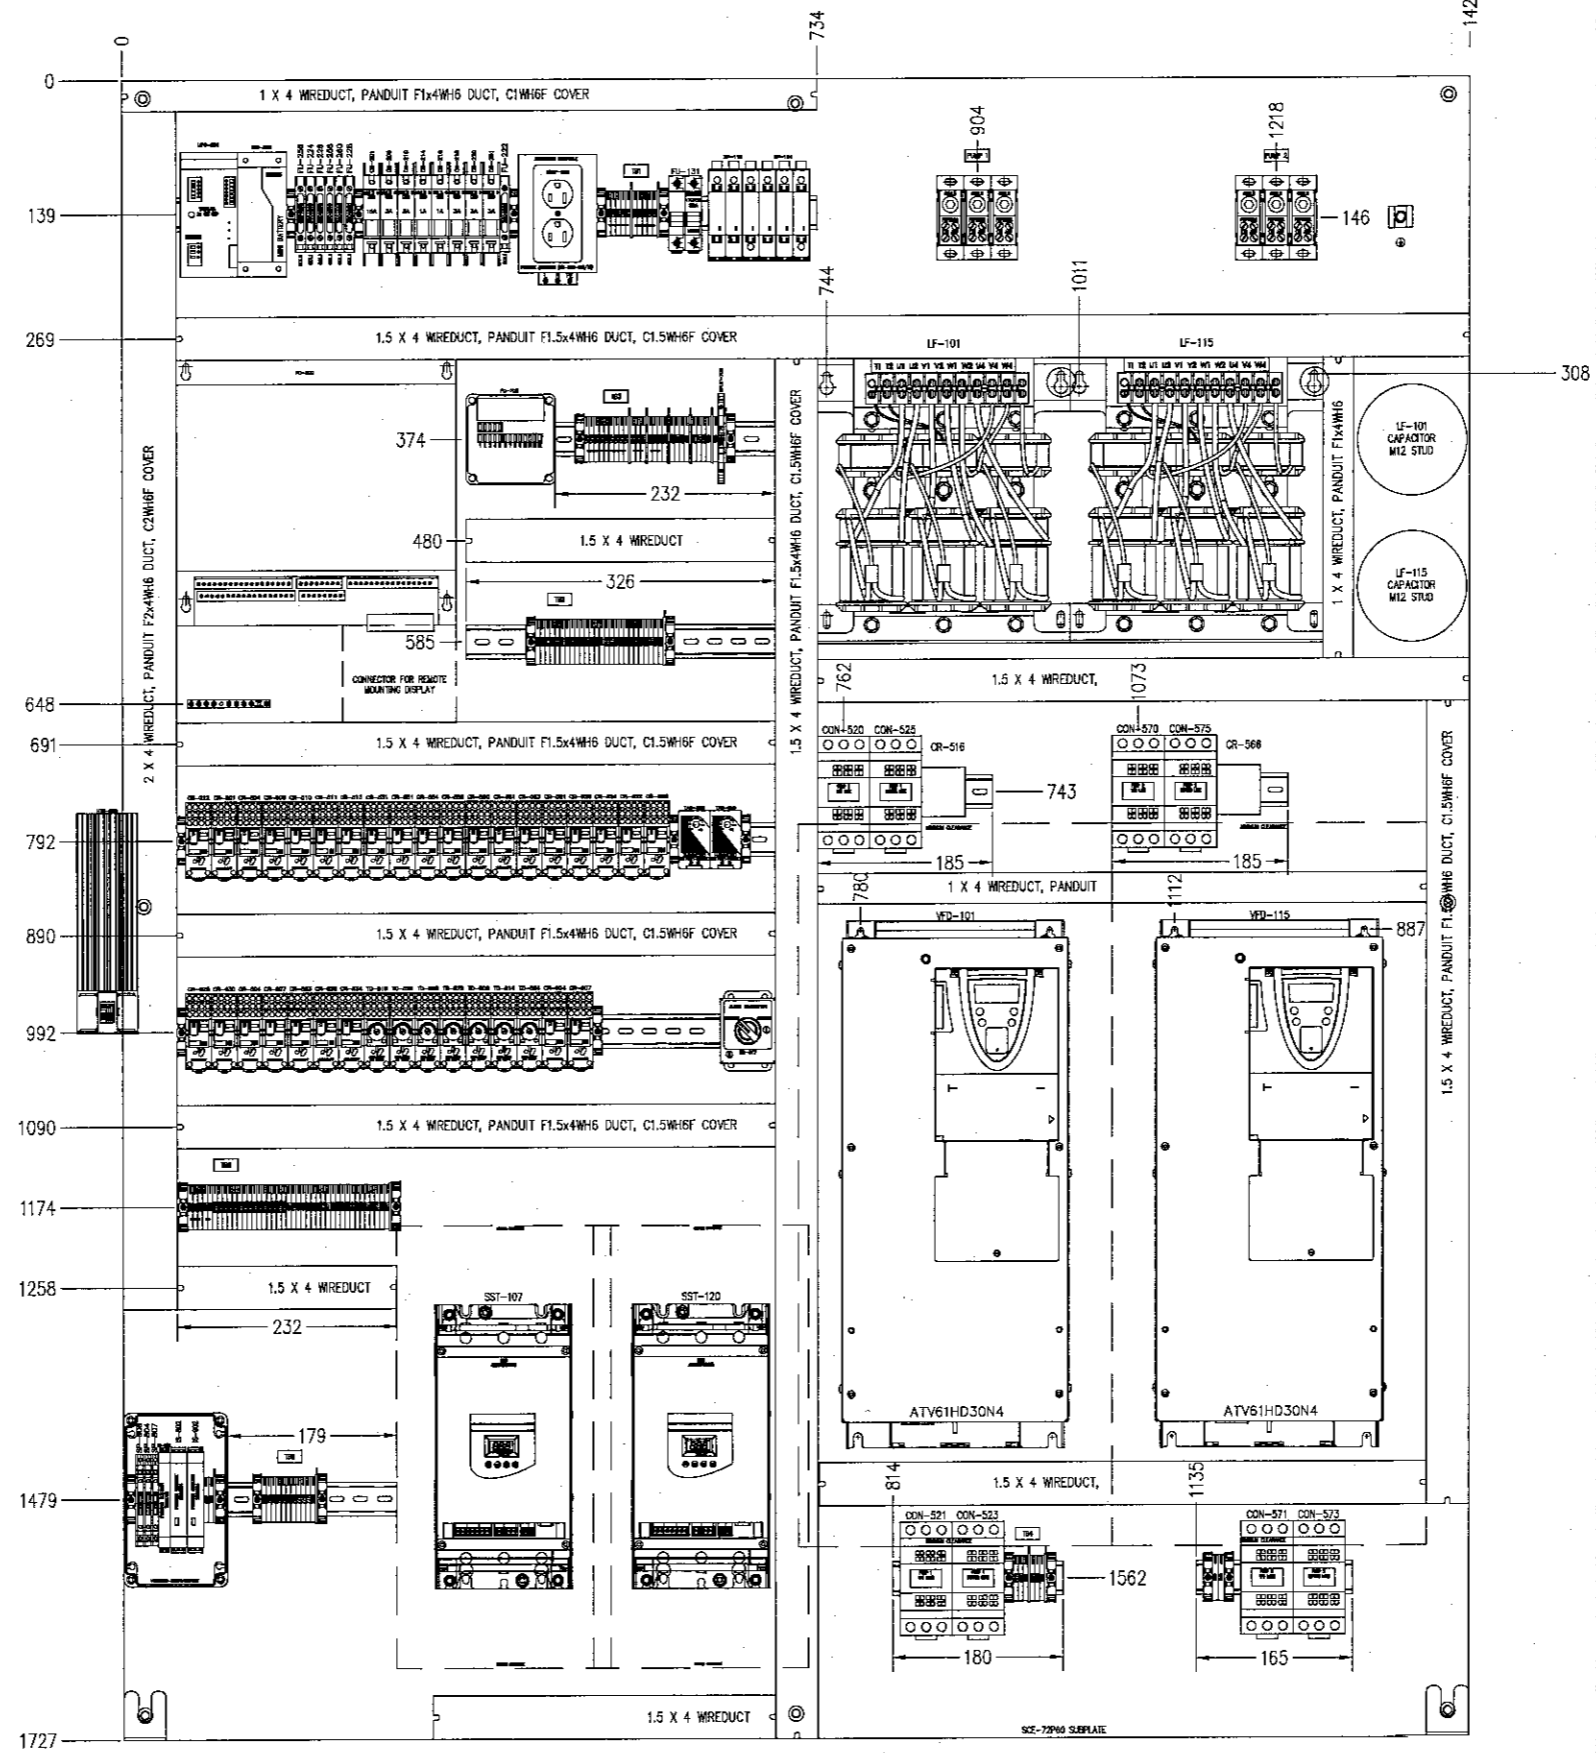

REV:	DESCRIPTION:	DOC. CONTROL No:	DATE:
D	FIELD MODIFICATIONS	ECN-140935-0005	08-07-15
C	RECORD DRAWINGS	ECN-140935-0004	01-27-15
B	AS BUILT	ECN-140935-0003	10-23-14
A	ORIGINAL ISSUE	ECN-140935-0001	07-14-14
DESIGNED BY: AUTOCAD ELECTRICAL 2012		DWG LAST SAVED ON: 08-07-2015	11:13a

THIS DRAWING OR ANY REPRODUCTION OF IT SHALL NOT BE USED FOR MANUFACTURE, PRODUCTION, OR PROCUREMENT WITHOUT THE EXPRESS WRITTEN PERMISSION OF VSGENVIROMATION, INC. USE OR REPRODUCTION FOR USE, IN A MANNER ASSOCIATED WITH GOODS OR SERVICES FURNISHED BY VSGENVIROMATION, INC. IS APPROVED.


VSGENVIROMATION
 A ZELLER COMPANY

1000 UNIVERSITY AVENUE
 SUITE 800
 ROCHESTER, NY 14607
 TEL.: 585-244-0450
 FAX: 585-254-0982

CUSTOMER: FLYGT, A XYLEM BRAND
 STREET: 600 MILE CROSSING BLVD, SUITE 3
 CITY / STATE: ROCHESTER NY 14624
 TOWN OF BETHLEHEM
 NEW SCOTLAND ROAD PUMP STATION
 DUPLEX PUMP CONTROL PANEL
 INTERIOR DIMENSIONS

DRAWN BY:	DRAWN DATE:	MODEL-PART NUMBER:
RJY	07-14-14	UL 698A LISTED CABINET
CHECKED BY:	CHECKED DATE:	DRAWING NUMBER:
DL	07-30-14	140935-SCOTLAND-SCH
FILE REFERENCE:	SCALE:	PAGE:
140935-SCOTLAND-SCH-10D	N/A	12
SERIAL/PROJECT NUMBER:	PAGES:	REVISION:
140935-0002	12 OF 14	D

6.00

4.00

PHONE 585-244-0450 FAX 585-254-4115

VSGENVIROMATION
A ZELLER COMPANY

TOWN OF BETHLEHEM

JOB No. 140935 SERIAL No. 140935-0002

CONTROL CABINET DUPLEX PUMP CONTROL PANEL
POWER FEED 480VAC, 3PH & 120VAC, 1PH, 60Hz
DISCONNECT SW. N/A
FULL LOAD AMPS 83 AMPS
LARGEST MOTOR FLA 40 AMPS
CONTROL VOLTAGE 120VAC / 24VDC
CONTROL XFMR. N/A
INTERRUPTING CAPACITY 100 K.A.I.C.











WARNING
MULTIPLE SOURCES OF
POWER. TURN OFF ALL
SOURCES BEFORE SERVICING.

DISCONNECT LOCATED IN
HP-1 AND LP-1













QTY (2)

BLACK LETTERING ON WHITE LAMICOID

FASTEN WITH STAINLESS STEEL SCREWS

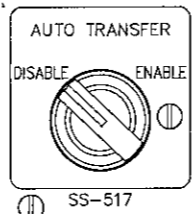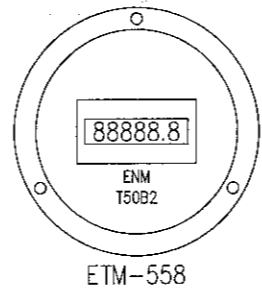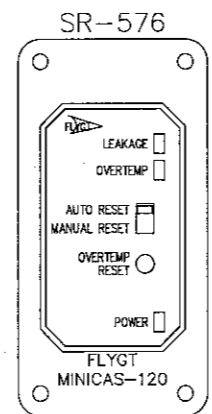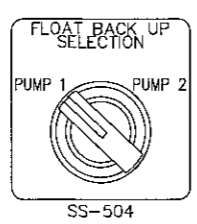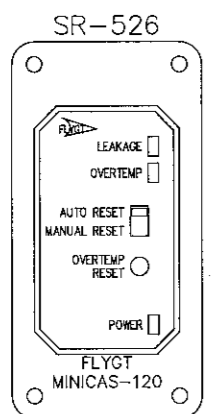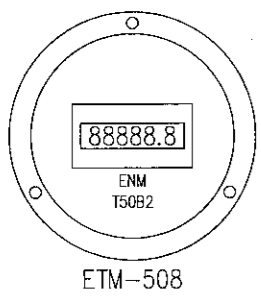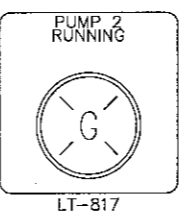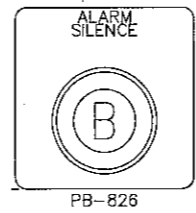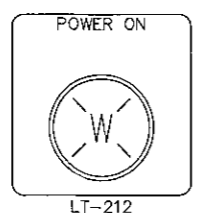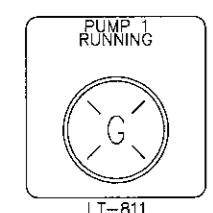

22MM OPERATORS

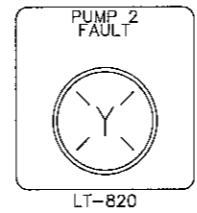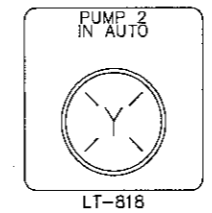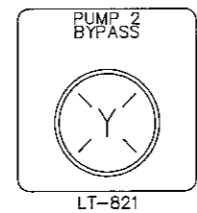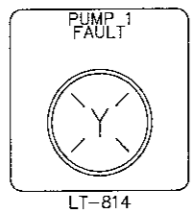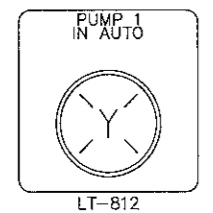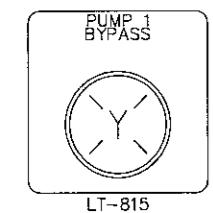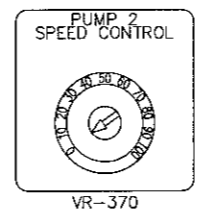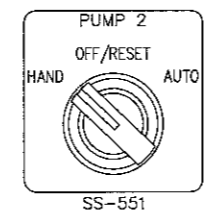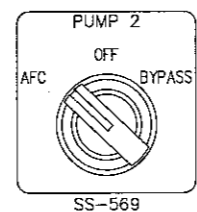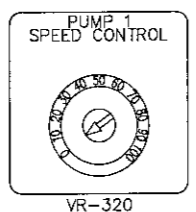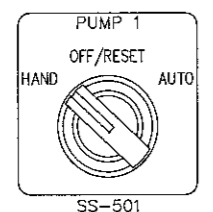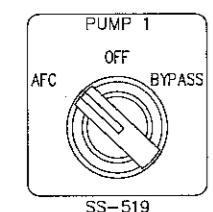

REV:	DESCRIPTION:	DOC. CONTROL No:	DATE:
D	FIELD MODIFICATIONS	ECN-140935-0005	08-07-15
C	RECORD DRAWINGS	ECN-140935-0004	01-27-15
B	AS BUILT	ECN-140935-0003	10-23-14
A	ORIGINAL ISSUE	ECN-140935-0001	07-14-14
DESIGNED ON: AUTOCAD ELECTRICAL 2012		DWG LAST SAVED ON: 08-07-2015 11:13a	

THIS DRAWING OR ANY REPRODUCTION OF IT SHALL NOT BE USED FOR MANUFACTURE, PRODUCTION, OR PROCUREMENT WITHOUT THE EXPRESS WRITTEN PERMISSION OF VSGENVIROMATION, INC. USE OR REPRODUCTION FOR USE, IN A MANNER ASSOCIATED WITH GOODS OR SERVICES FURNISHED BY VSGENVIROMATION, INC. IS APPROVED.

VSGENVIROMATION
A ZELLER COMPANY






1000 UNIVERSITY AVENUE
SUITE 800
ROCHESTER, NY 14607
TEL.: 585-244-0450
FAX: 585-254-0982

CUSTOMER: FLYGT, A XYLEM BRAND
STREET: 600 MILE CROSSING BLVD, SUITE 3
CITY / STATE: ROCHESTER NY 14624

TOWN OF BETHLEHEM
NEW SCOTLAND ROAD PUMP STATION
DUPLEX PUMP CONTROL PANEL

NAMEPLATES

DRAWN BY: RJY	DRAWN DATE: 07-14-14	MODEL-PART NUMBER: UL 698A LISTED CABINET
CHECKED BY: DL	CHECKED DATE: 07-30-14	DRAWING NUMBER: 140935-SCOTLAND-SCH
FILE REFERENCE: 140935-SCOTLAND-SCH-100	SCALE: N/A	PAGE: 13
SERIAL/PROJECT NUMBER: 140935-0002	PAGES: 13 OF 14	REVISION: D

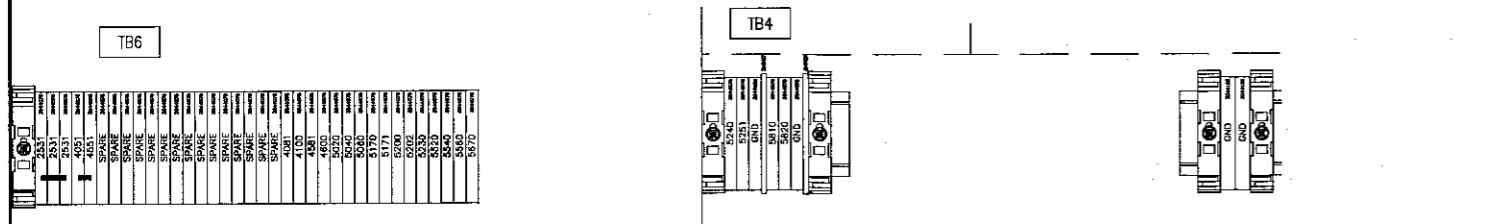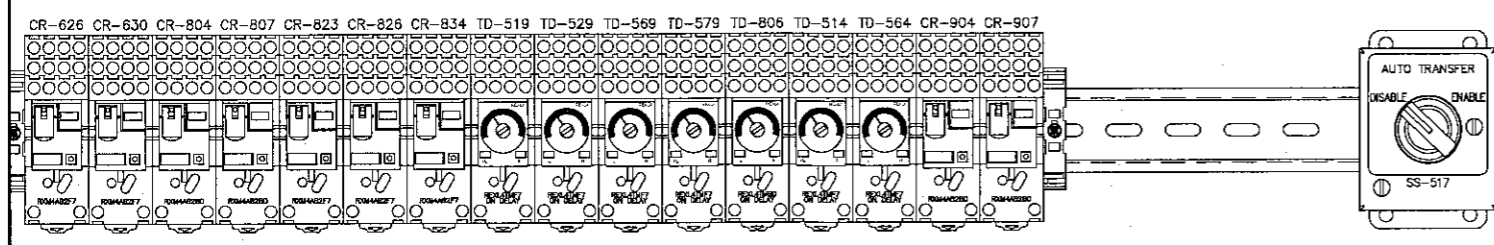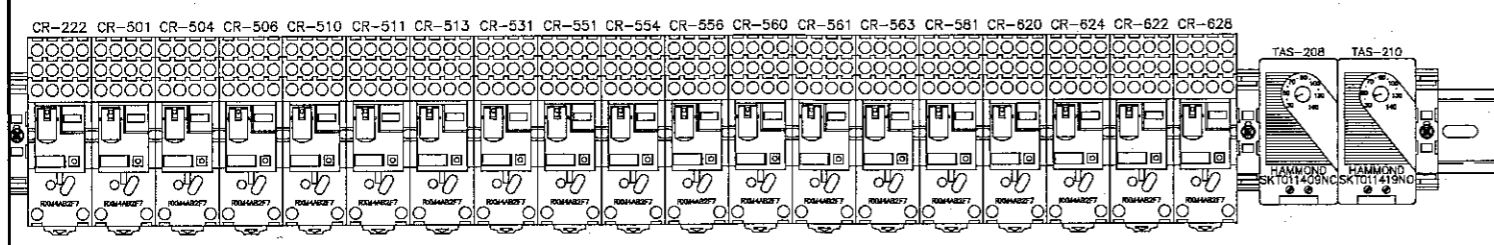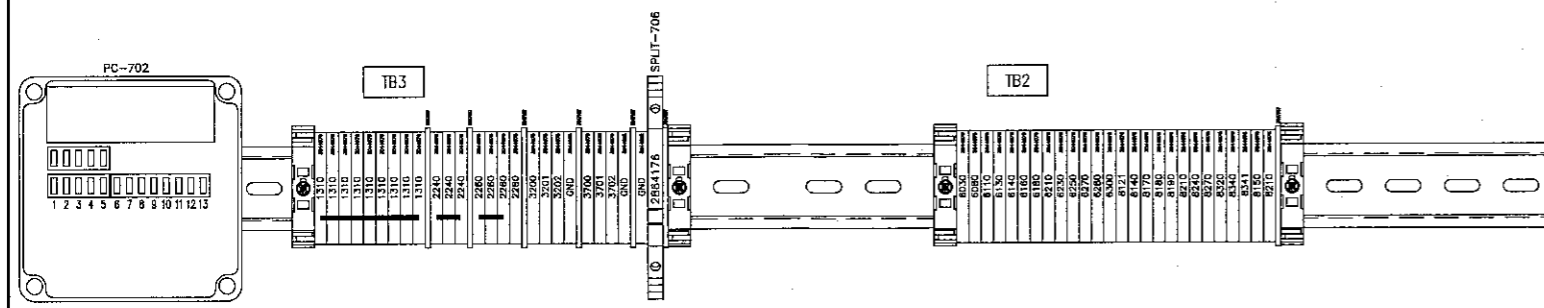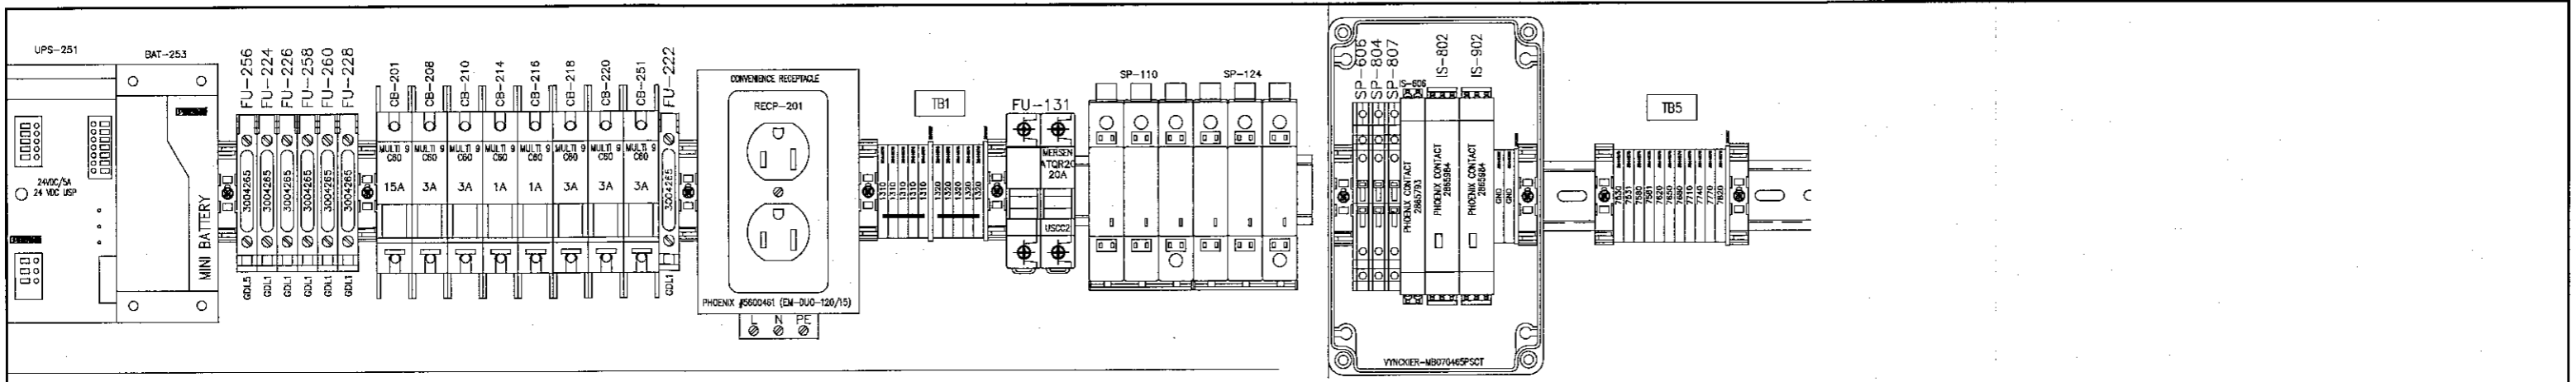

D	FIELD MODIFICATIONS	ECN-140935-0005	08-07-15
C	RECORD DRAWINGS	ECN-140935-0004	01-27-15
B	AS BUILT	ECN-140935-0003	10-23-14
A	ORIGINAL ISSUE	ECN-140935-0001	07-14-14
REV:	DESCRIPTION:	DOC. CONTROL No:	DATE:
DESIGNED CN: AUTOCAD ELECTRICAL 2012		DWG LAST SAVED ON: 08-07-2015	11:13a

THIS DRAWING OR ANY REPRODUCTION OF IT SHALL NOT BE USED FOR MANUFACTURE, PRODUCTION, OR PROCUREMENT WITHOUT THE EXPRESS WRITTEN PERMISSION OF VSGENVIROMATION, INC. USE OR REPRODUCTION FOR USE, IN A MANNER ASSOCIATED WITH GOODS OR SERVICES FURNISHED BY VSGENVIROMATION, INC. IS APPROVED.

1000 UNIVERSITY AVENUE
SUITE 800
ROCHESTER, NY 14607
TEL.: 585-244-0450
FAX: 585-254-0982

CUSTOMER: FLYGT, A XYLEM BRAND
STREET: 600 MILE CROSSING BLVD, SUITE 3
CITY / STATE: ROCHESTER NY 14624
TOWN OF BETHLEHEM
NEW SCOTLAND ROAD PUMP STATION
DUPLIX PUMP CONTROL PANEL
TERMINAL STRIPS

DRAWN BY: RJK	DRAWN DATE: 07-14-14	MODEL-PART NUMBER: UL 698A LISTED CABINET
CHECKED BY: DL	CHECKED DATE: 07-30-14	DRAWING NUMBER: 140935-SCOTLAND-SCH
FILE REFERENCE: 140935-SCOTLAND-SCH-100	SCALE: N/A	PAGE: 14
SERIAL/PROJECT NUMBER: 140935-0002	PAGES: 14 OF 14	REVISION: D